


THIS CONTRACT
TYPICAL SECTION HELENA AVENUE
SCALE 1" = 10'


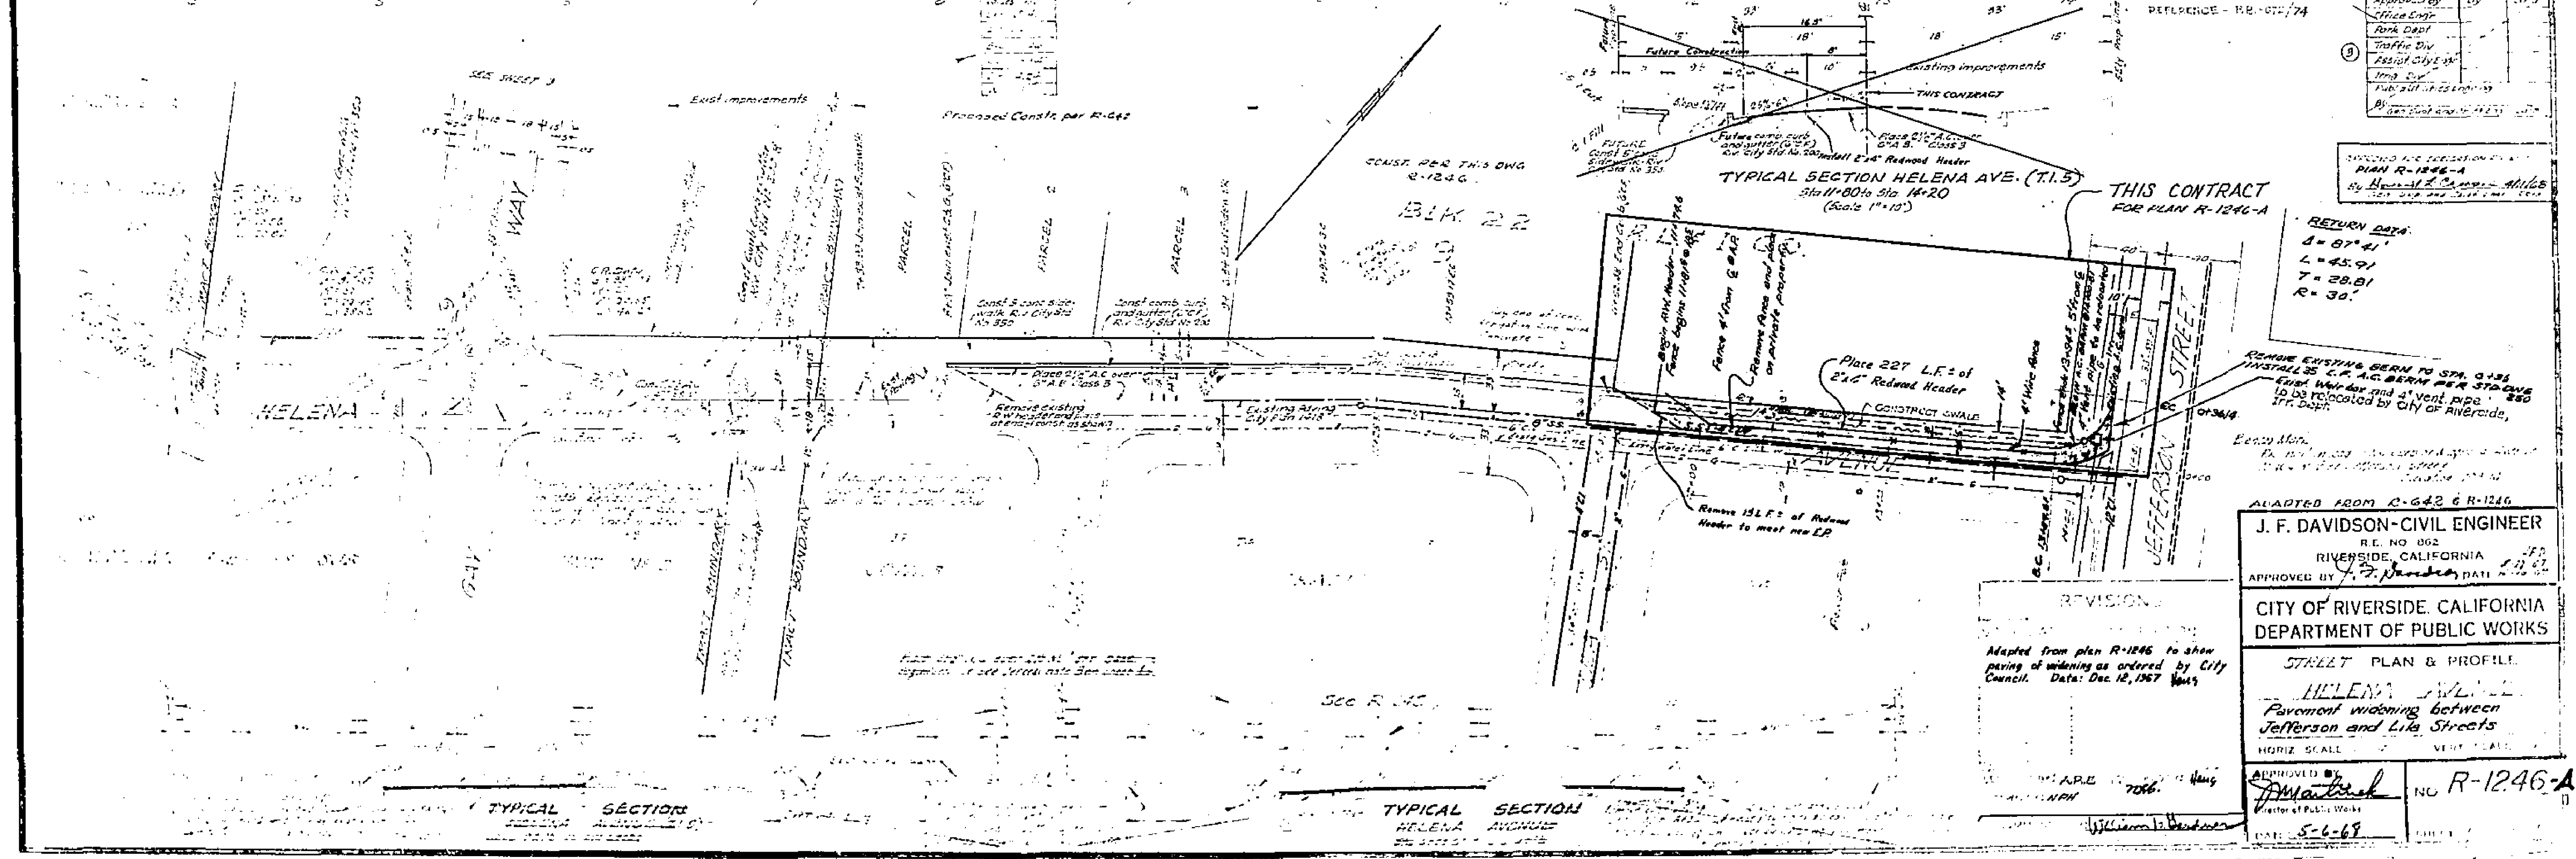

THIS CONTRACT
TYPICAL SECTION HELENA AVENUE
STA 11+80 TO STA 14+20
SCALE 1" = 10'

Approved by _____ By _____ Date _____

Office Engr
Park Dept
Traffic Div
Public Works

REFERENCE - RR-07/74

RETURN DATA
S = 67.41'
L = 45.91'
T = 28.81'
R = 30'


J. F. DAVIDSON - CIVIL ENGINEER
R.E. NO 862
RIVERSIDE, CALIFORNIA

APPROVED BY *[Signature]* DATE 5-6-68

CITY OF RIVERSIDE, CALIFORNIA
DEPARTMENT OF PUBLIC WORKS

STREET PLAN & PROFILE
HELENA AVENUE
Pavement widening between
Jefferson and Lila Streets

HORIZ. SCALE _____ VERT. SCALE _____

APPROVED BY *[Signature]* DATE 5-6-68

NO R-1246-A