


NOTES:
 1. FOR TYPICAL SECTION SEE SHEET 6
 2. FOR INTERSECTION DETAILS SEE SHEET 7

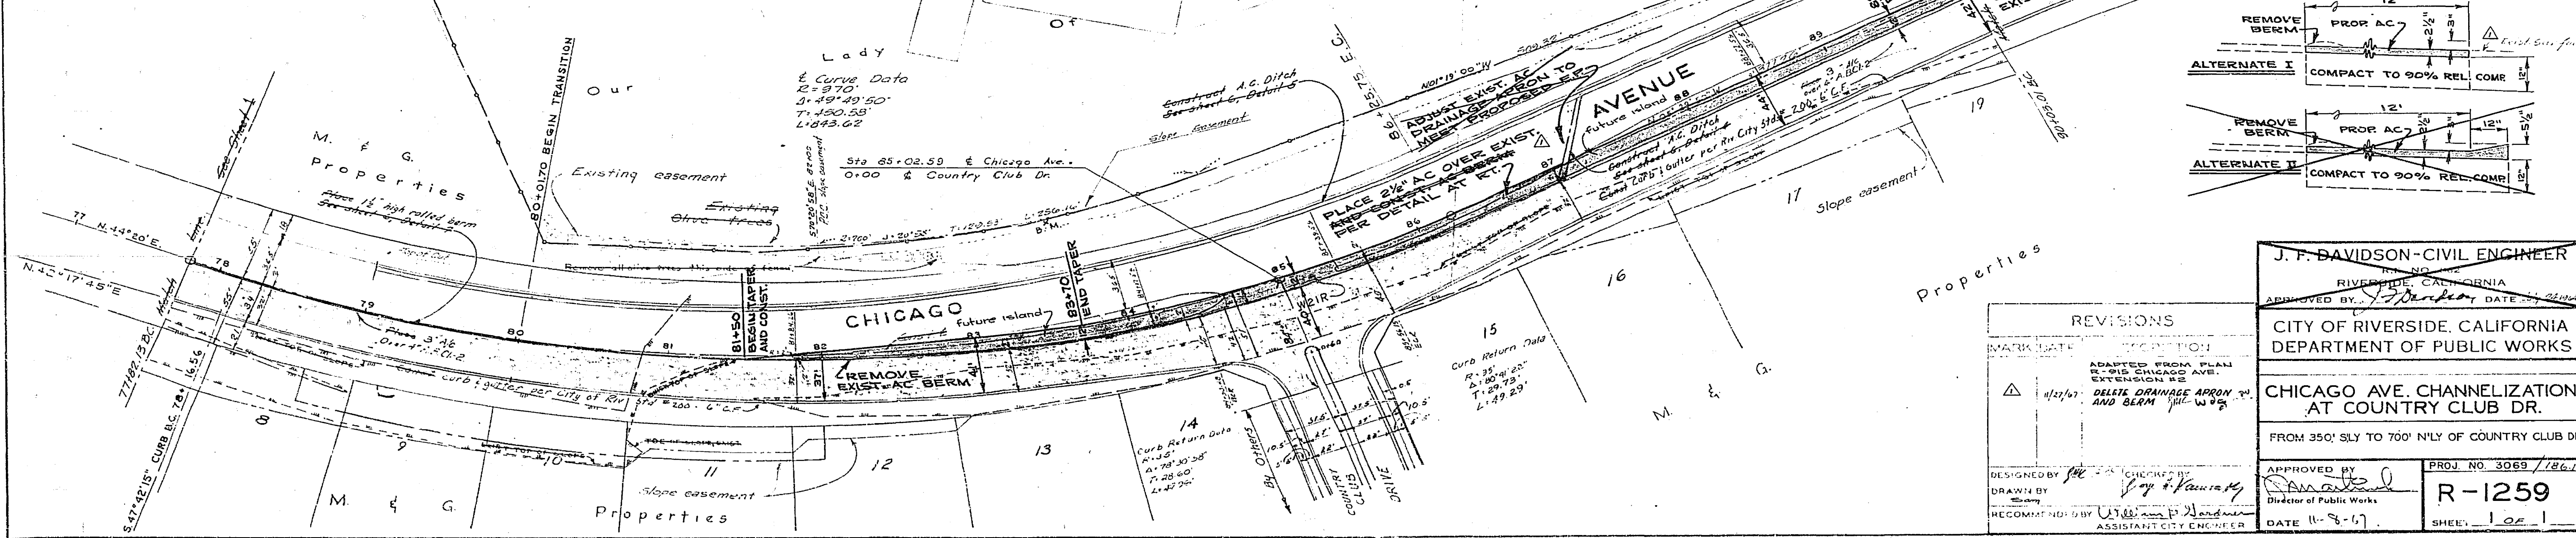

REVISIONS	DESCRIPTION

J. F. DAVIDSON - CIVIL ENGINEER
 RIVERSIDE, CALIFORNIA
 APPROVED BY: *J. Davidson* DATE: 1/12/67

CITY OF RIVERSIDE, CALIFORNIA
 DEPARTMENT OF PUBLIC WORKS

CHICAGO AVE. CHANNELIZATION AT COUNTRY CLUB DR.
 FROM 350' SLY TO 700' NLY OF COUNTRY CLUB DR

 ASSISTANT CITY ENGINEER

APPROVED BY: *J. Davidson*
 DIRECTOR OF PUBLIC WORKS

DATE: 1-8-67

PROJ. NO. 3069 / 186.1
R-1259
 SHEET: 1 OF 1


