


CURVE DATA

NO.	A	B	T	L

BENCH MARK:
 1964
 19.50' above PG&E 1964 North
 of Bluffs St. and East side of
 Railroad - Elev. 1055.4, G.M.P. 10/190

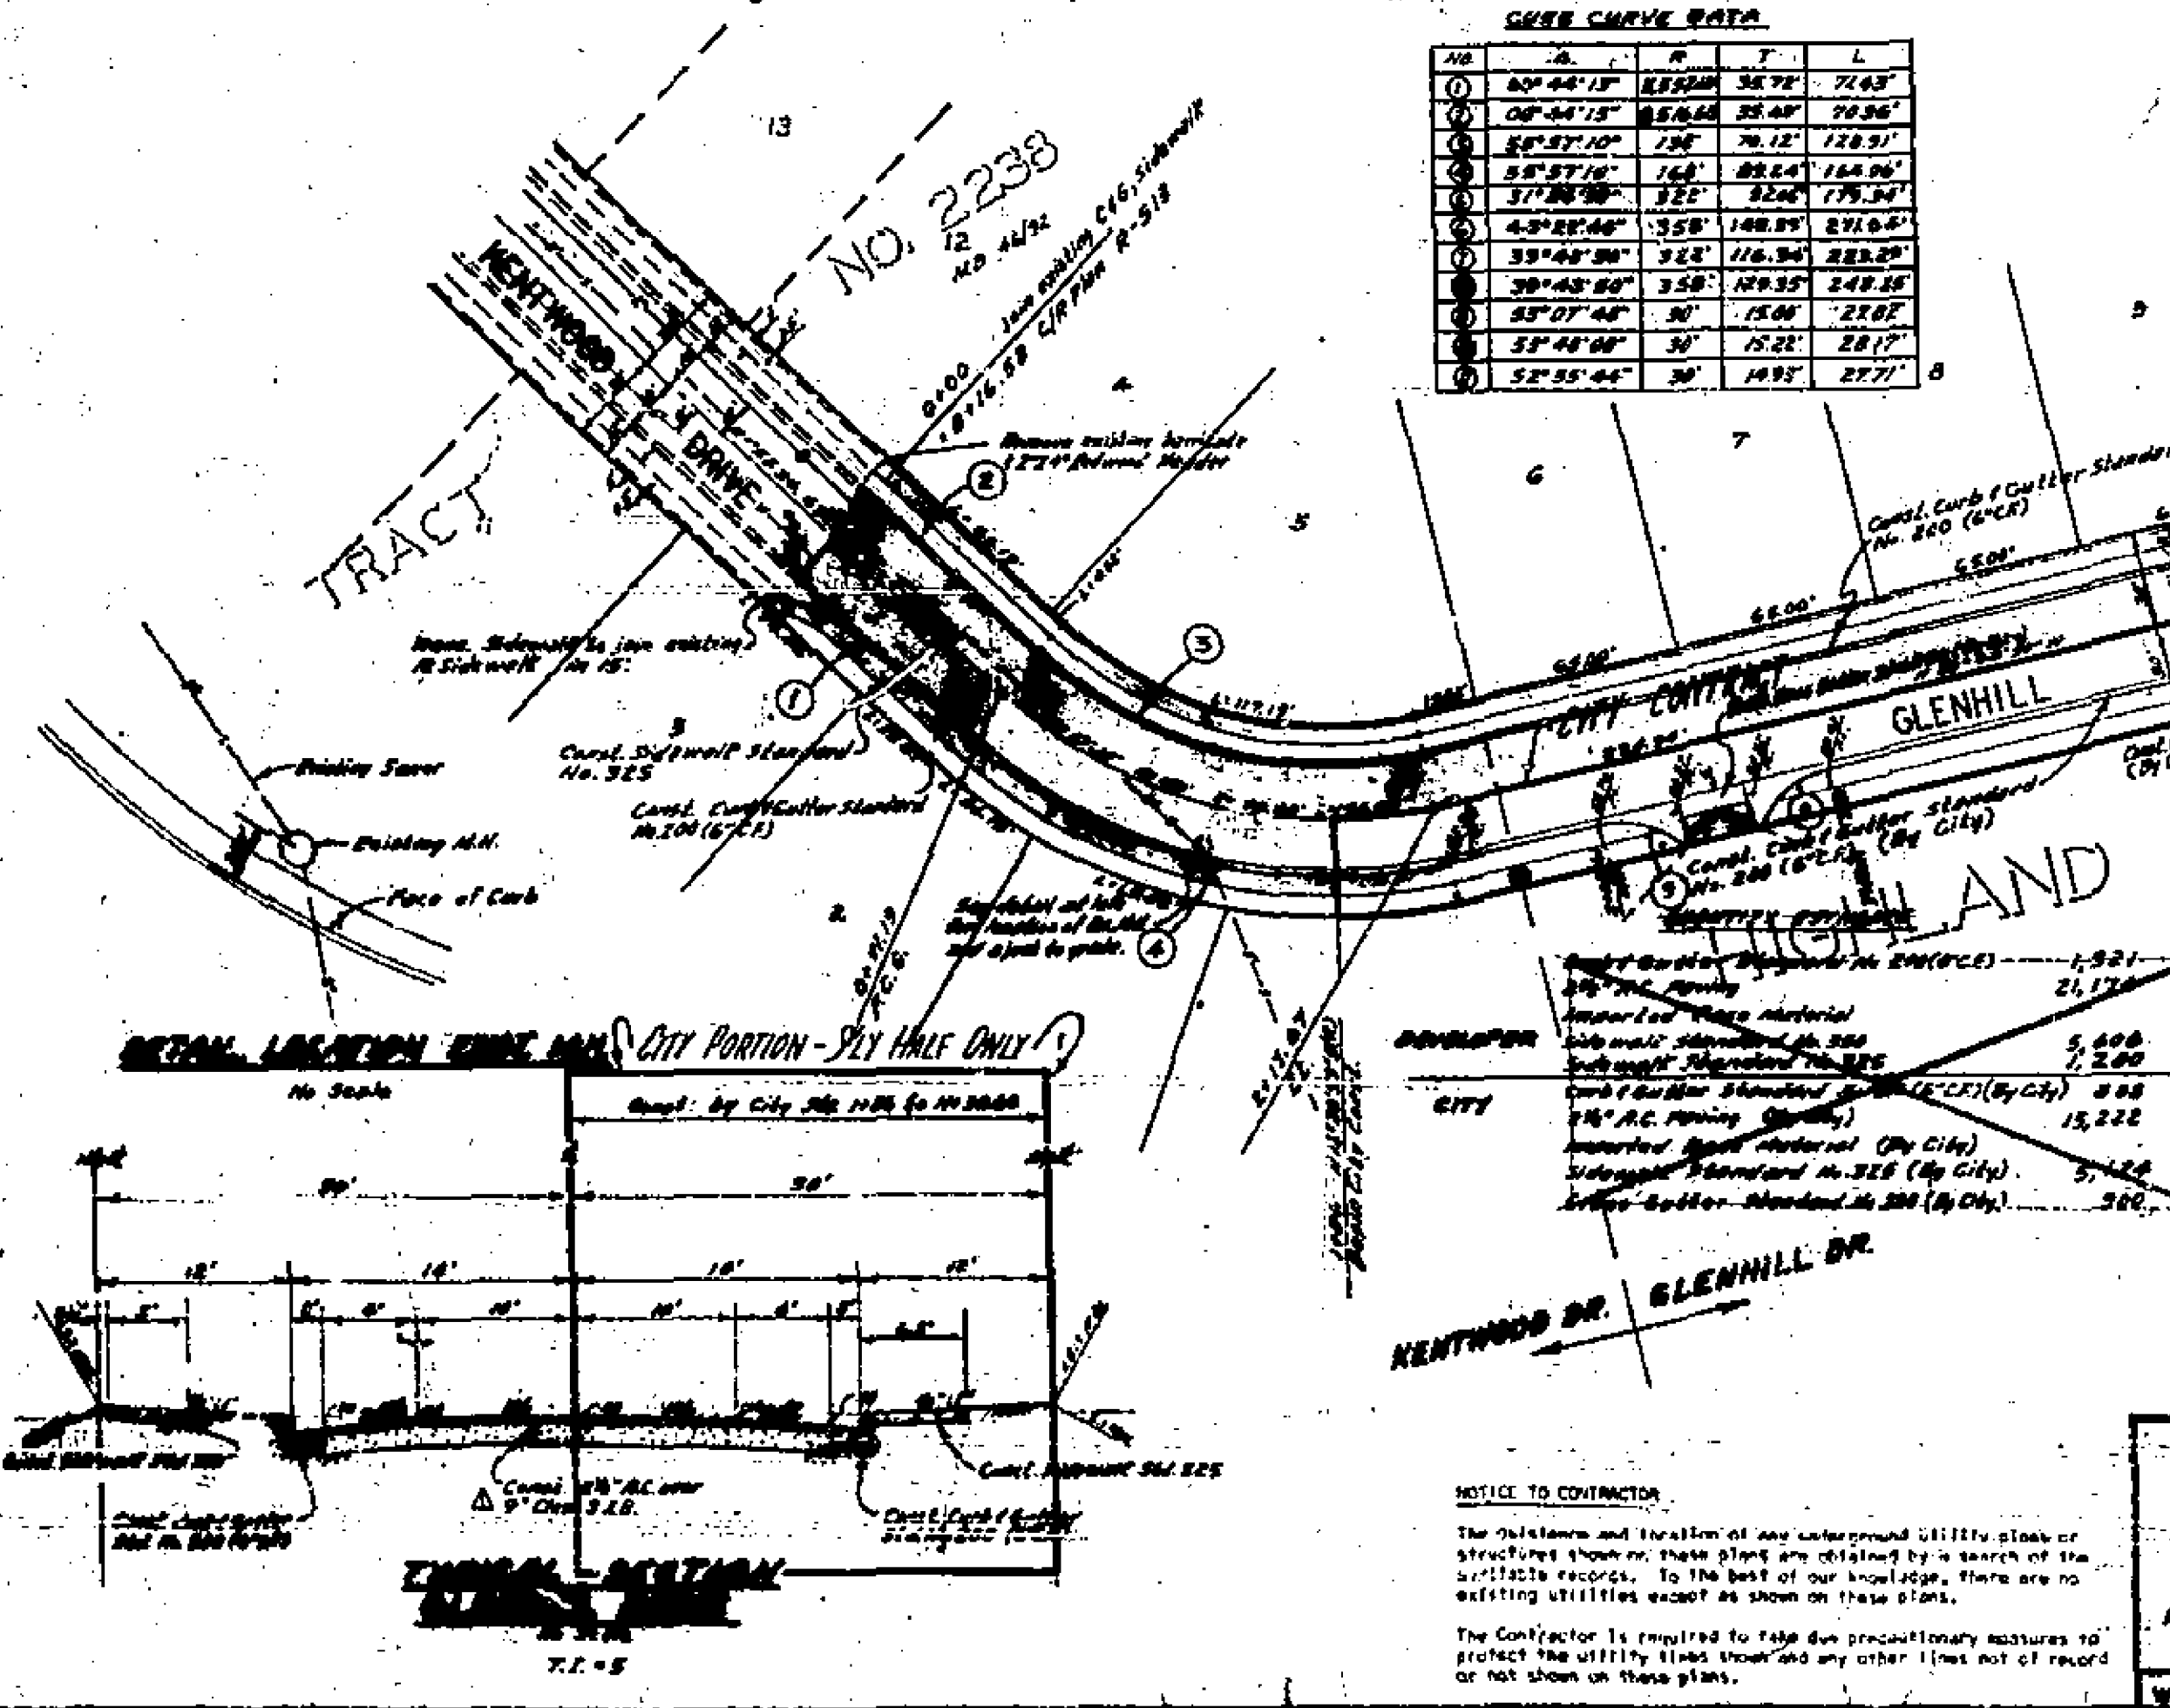

- GENERAL NOTES**
- It shall be the responsibility of the contractor to clear the right of way in accordance with the provisions of law as it affects each utility, including irrigation lines and appurtenances, and at no cost to the City of Riverside.
 - Prime coat, seal coat, and paint binder are required.
 - Grading will require a permit under Ordinance 305 for a cut or fill exceeding 100 cubic yards, or a fill over one foot in depth.
 - The contractor shall arrange for a soil test to be made by a Soil Engineer after the streets have been prepared to rough grade. Depth of base material and A.C. paving shall be determined by City of Riverside Design Standards and Test Procedures.
 - Title edge of existing pavement, show new paving joints existing pavement, to a clear, straight line. Contract match paving as shown and overlay paving as directed in the field to produce a smooth crown section.
 - Contractor shall not place rock larger than 1" within 5' of proposed sewer as per City of Riverside Plan No. 3-748.

STREET NAME SCHEDULE

1	GLENHILL DRIVE
2	KENTWOOD DRIVE

Contact Public Works Division when ordering signs. Signs to be set out prior to start of street work.

NOTICE TO CONTRACTOR

The existence and location of any underground utility lines or structures shown on these plans are obtained by a search of the available records. To the best of our knowledge, there are no existing utilities except as shown on these plans.

The Contractor is required to take any precautionary measures to protect the utility lines shown and any other lines not of record or not shown on these plans.

ALBERT A. WEBB ASSOCIATES
 CIVIL ENGINEERS
 RIVERSIDE, CALIFORNIA

APPROVED BY: *[Signature]* DATE: 3/13/68
 REG. NO. 2876

CITY OF RIVERSIDE, CALIFORNIA
 DEPARTMENT OF PUBLIC WORKS

APPROVED BY: *[Signature]* DATE: 3-25-68

STREET PLAN AND PROFILE
GLENHILL DRIVE
 BETWEEN
 KENTWOOD DR. & SUGARLOAF DR.

HORIZ. SCALE: 1" = 50'
 VERT. SCALE: 1" = 4'

PROJECT NO.
R-1338A

SHEET 1 OF 1

FILE NO. 68-348-A