


TYPICAL SECTION — BLAINE ST
NO SCALE
TI=7

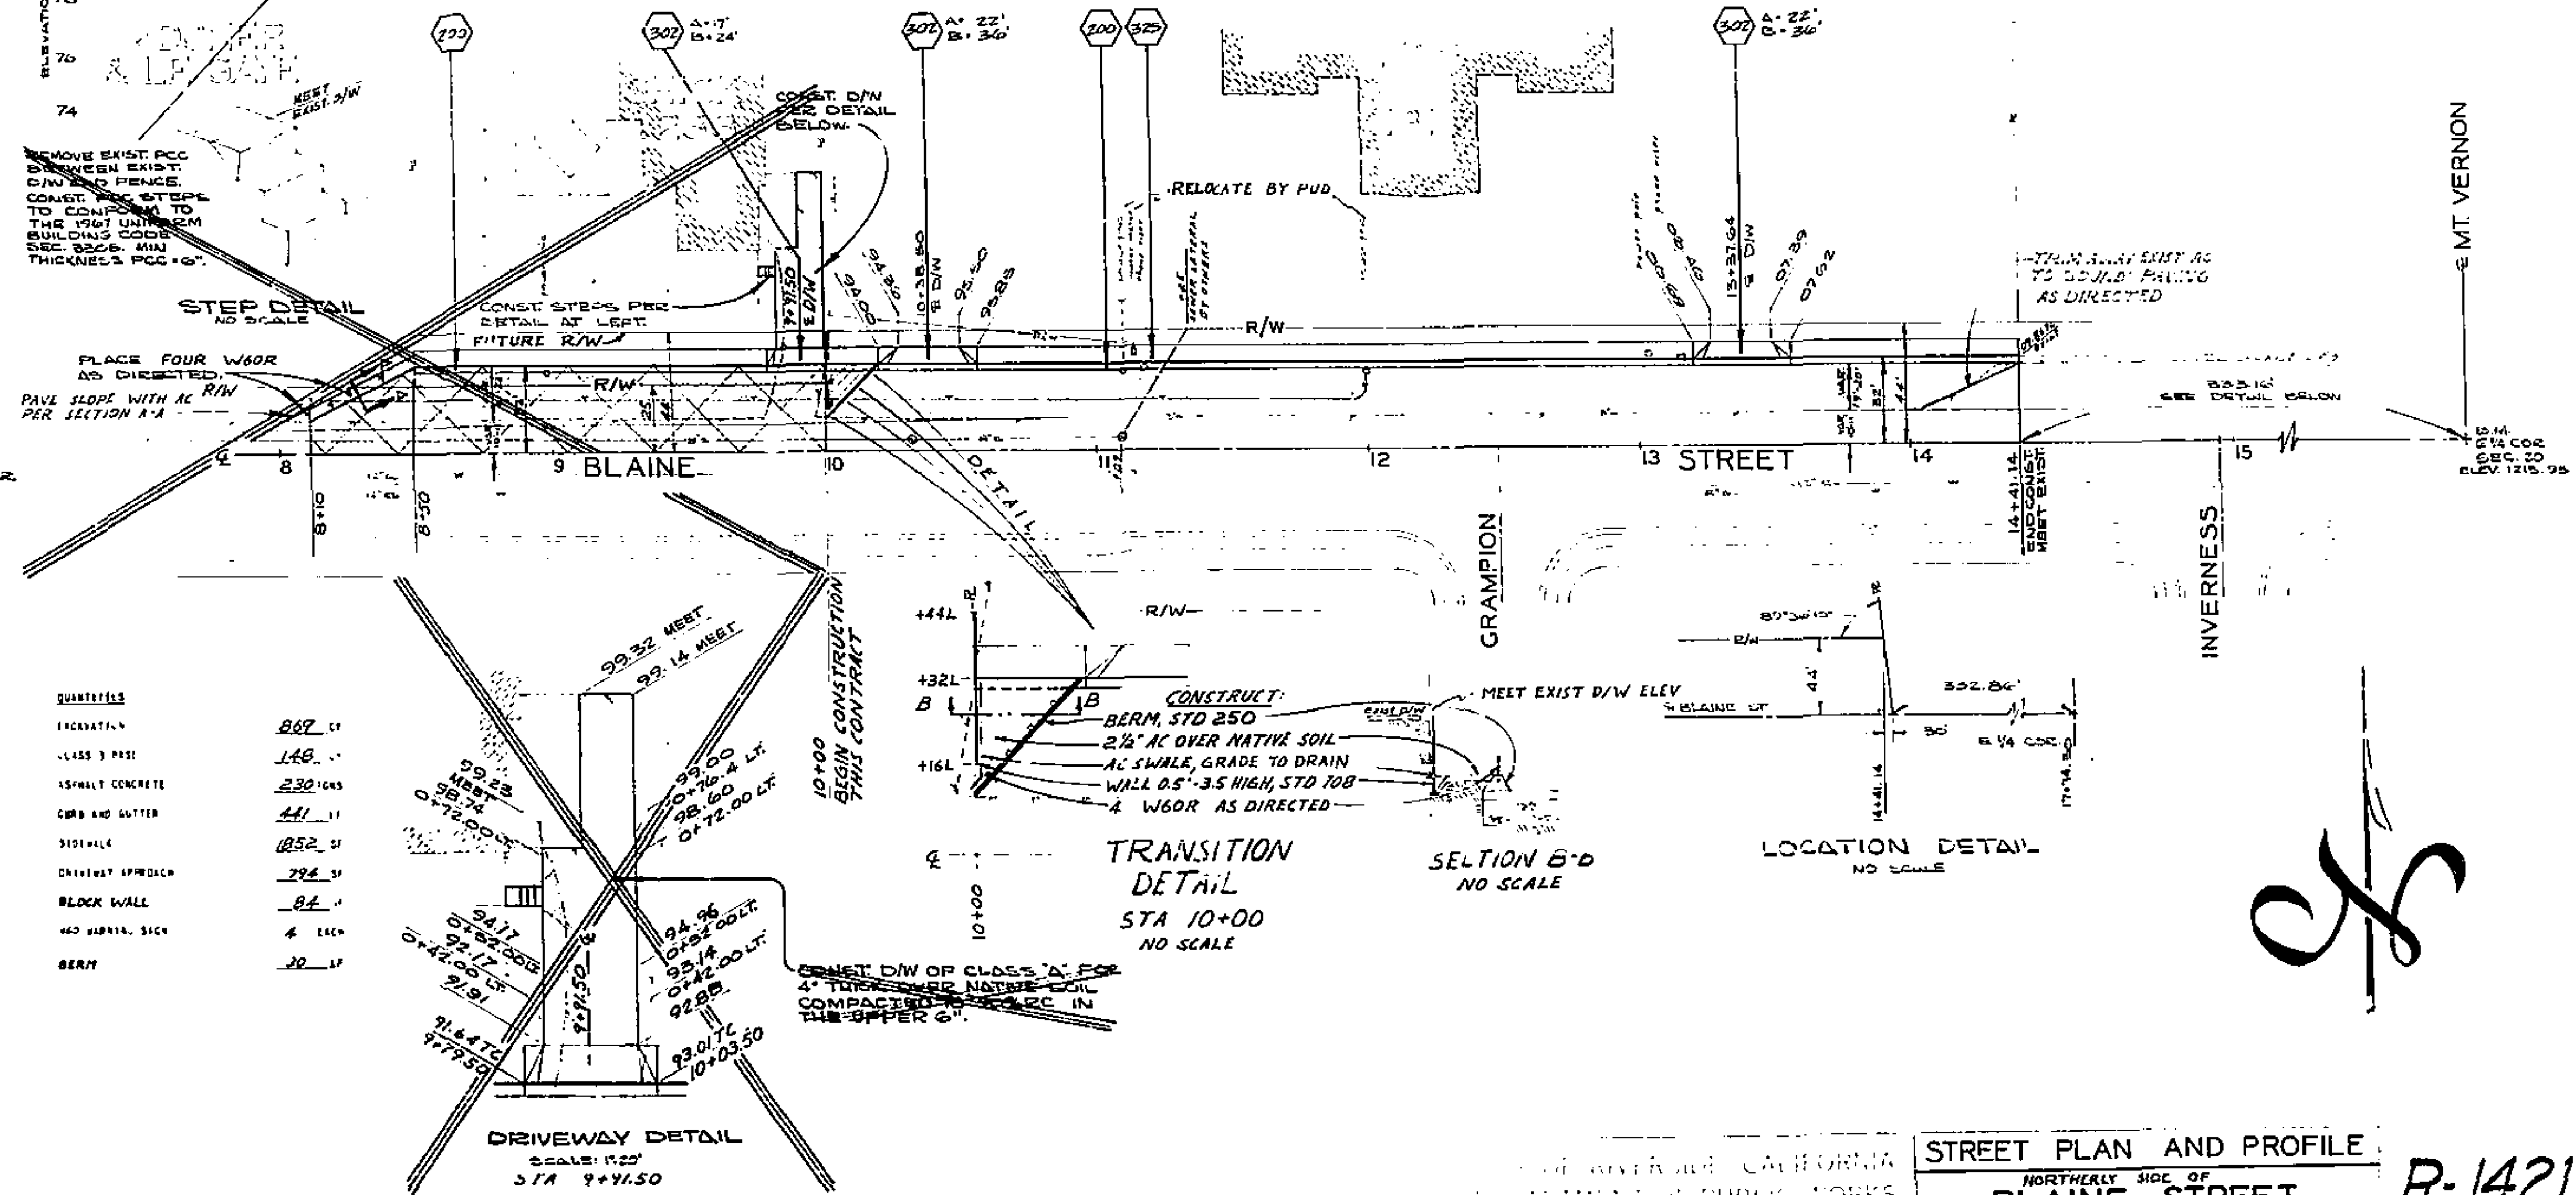

- GENERAL NOTES**
- IT SHALL BE THE RESPONSIBILITY OF THE CONTRACTOR TO CLEAR THE RIGHT OF WAY IN ACCORDANCE WITH THE PROVISIONS OF LAW AS IT APPLIES TO THE PROJECT, INCLUDING NECESSARY EASEMENTS AND EASEMENTS, AND AT NO COST TO THE CITY.
 - CONSTRUCTION SHALL BE IN ACCORDANCE WITH THE CITY OF RIVERSIDE, PUBLIC WORKS DEPARTMENT, SPECIFICATIONS NO. 401 AND STANDARD DRAWINGS.
 - PRIME COAT, PAINT BANDS, AND SEAL COAT ARE REQUIRED.
 - THE AMOUNT OF ASPHALT OVERLAY ON EXISTING PAVEMENT HAS BEEN ESTIMATED BY THE ENGINEER TO BE APPROXIMATELY 22 TONS.
 - THE WATER METER AND POWER POLLS WILL BE RELOCATED BY THE UTILITY COMPANIES.

- CONSTRUCTION NOTES AND LEGEND**
- CONSTRUCT CURB AND GUTTER PER CITY STD Dwg 200, 6" CURB FACE.
 - CONSTRUCT DRIVEWAY APPROACH PER CITY STD Dwg 102, 14" AND 18" WIDTHS AS SHOWN ON PLANS.
 - CONSTRUCT CURB SIDEWALK PER CITY STD Dwg 305.
 - CONSTRUCT ASPHALT CONCRETE OVERLAY TO CROSS SLOPES INDICATED BY THE TYPICAL SECTION ABOVE.
 - CONSTRUCT 4" ASPHALT CONCRETE OVER 4" CLASS 2 BASE PLUS 4" CLASS 1 BASE.
 - CONSTRUCT CLASS #4 (10 SACK) PCC, 3000 PSI.
 - CONSTRUCT CONCRETE CURB PER CITY STD Dwg 200.

QUANTITIES

EXCAVATION	867	CU
CLASS 3 BASE	148	CU
ASPHALT CONCRETE	230	TONS
CURB AND GUTTER	441	LF
SIDEWALK	1852	SF
DRIVEWAY APPROACH	794	SF
BLOCK WALL	84	LF
WOOD ASPHALT SIGN	4	EACH
BERM	30	LF

NOTICE TO CONTRACTOR

THE EXISTENCE AND LOCATION OF ANY UNDERGROUND UTILITY PIPES OR STRUCTURES SHOWN ON THESE PLANS ARE OBTAINED BY A SEARCH OF THE AVAILABLE RECORDS. TO THE BEST OF OUR KNOWLEDGE, THERE ARE NO OTHER UTILITIES EXCEPT AS SHOWN ON THESE PLANS.

THE CONTRACTOR IS TO VERIFY THE LOCATION AND DEPTH OF ALL UTILITIES PRIOR TO CONSTRUCTION. THE CONTRACTOR SHALL BE RESPONSIBLE FOR ANY DAMAGE TO UTILITIES CAUSED BY CONSTRUCTION.

-CAUTION-
PACIFIC TELEPHONE
 CABLES UNDERGROUND
 BEFORE EXCAVATING
 CALL COLLECT

[Signature]
 12/13/67
 RE 17519

STREET PLAN AND PROFILE
 NORTHERLY SIDE OF
BLAINE STREET
 FROM 3528' TO 924' WESTERLY
 OF MT VERNON AVE
 C.U.P. 51-089
 40'

R-1421
 1 1