


NOTE:
Public Utilities Department will install two subsurface lines prior to construction of medians.

parabolic curve data - 90' length

distance from pt. 'a'	0'	7.5'	15'	22.5'	30'	45'	60'	75'	90'
offset distance	0'	.16'	.62'	1.41'	2.50'	3.0'	7.50'	1.89'	10.0'

scale: 1" = 20'

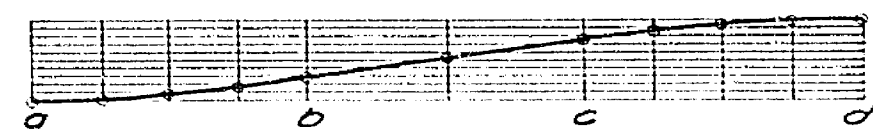

electrical legend

- pedestrian button and post } by others
 - pull box
- after backfill material is in place the traffic electrical contractor shall install electrical units at grade.

△ indicates construction that is not a part of this contract and shall be done by others

BENCH MARK

1. 2'

typical section - medians

1" = 2'

Monsanto Astro turf - G14 - or approved equal.

Deleted median per C.O. #1, 2, 1000	CITY OF RIVERSIDE, CALIFORNIA DEPARTMENT OF PUBLIC WORKS APPROVED BY: <i>[Signature]</i> DATE: 7-8-70	TYLER STREET MEDIANS AT MAGNOLIA AVENUE	PROJECT NO. 121130 SHEET 1 OF 1 FILE NO.
	HORIZ. SCALE: 1" = 20' VERT. SCALE: 1" = 4'	BENCH MARK	