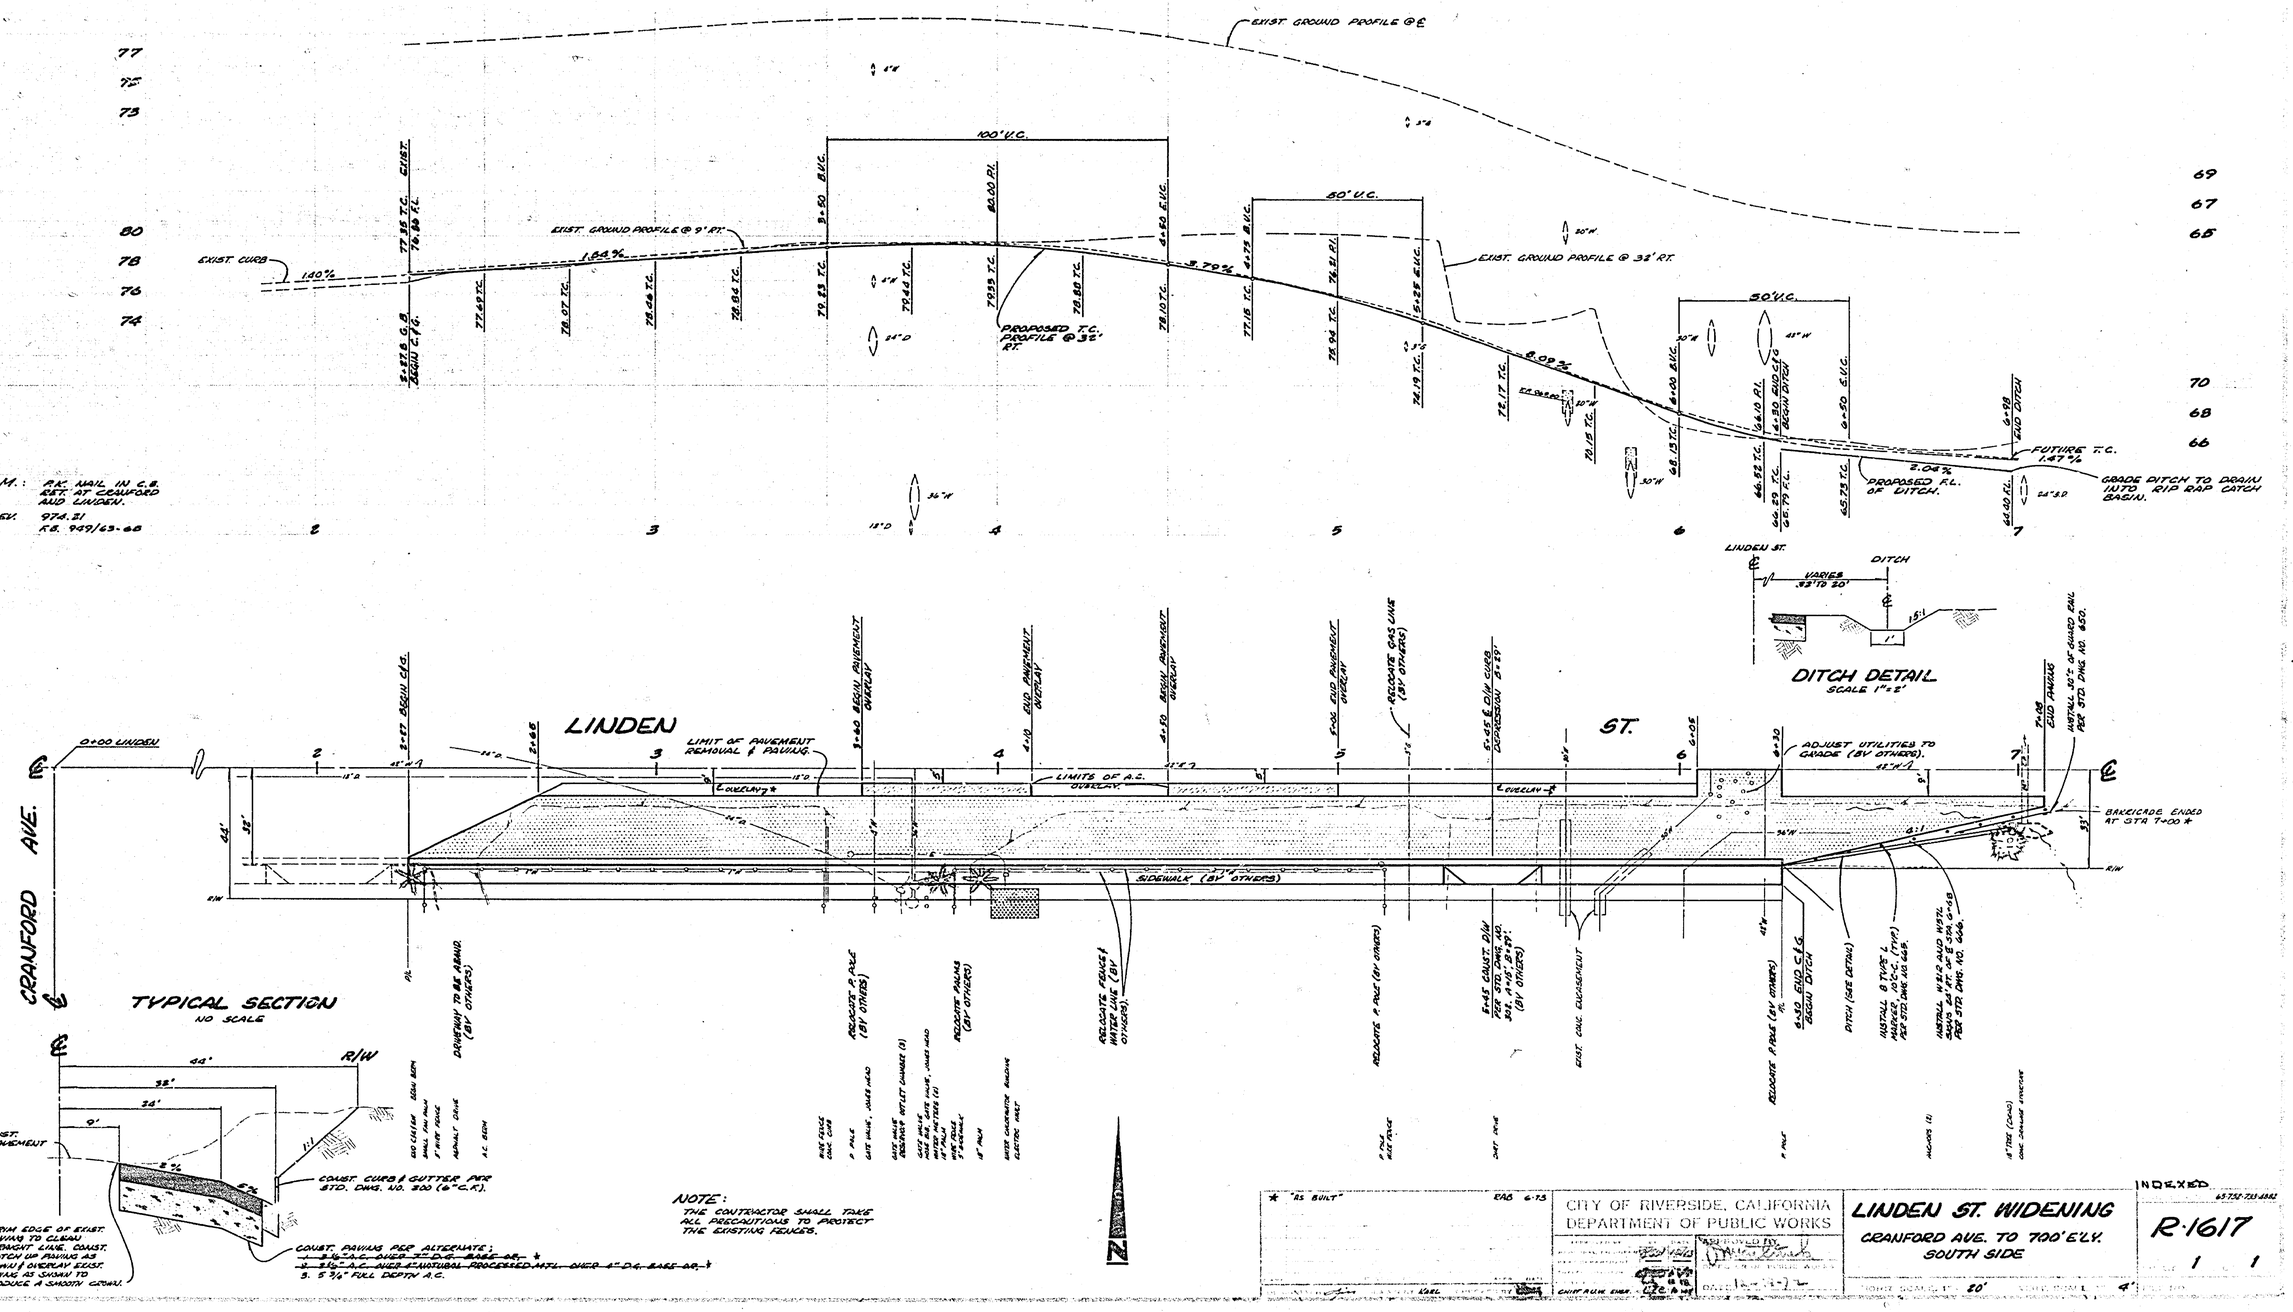

★ "AS BUILT" EAS 6-73

CITY OF RIVERSIDE, CALIFORNIA
DEPARTMENT OF PUBLIC WORKS

APPROVED BY

LINDEN ST. WIDENING
CRANFORD AVE. TO 700' E'LY.
SOUTH SIDE

HORIZ. SCALE 1" = 20' VERT. SCALE 1" = 4'

INDEXED 65751-713-4382

R-1617

1 1