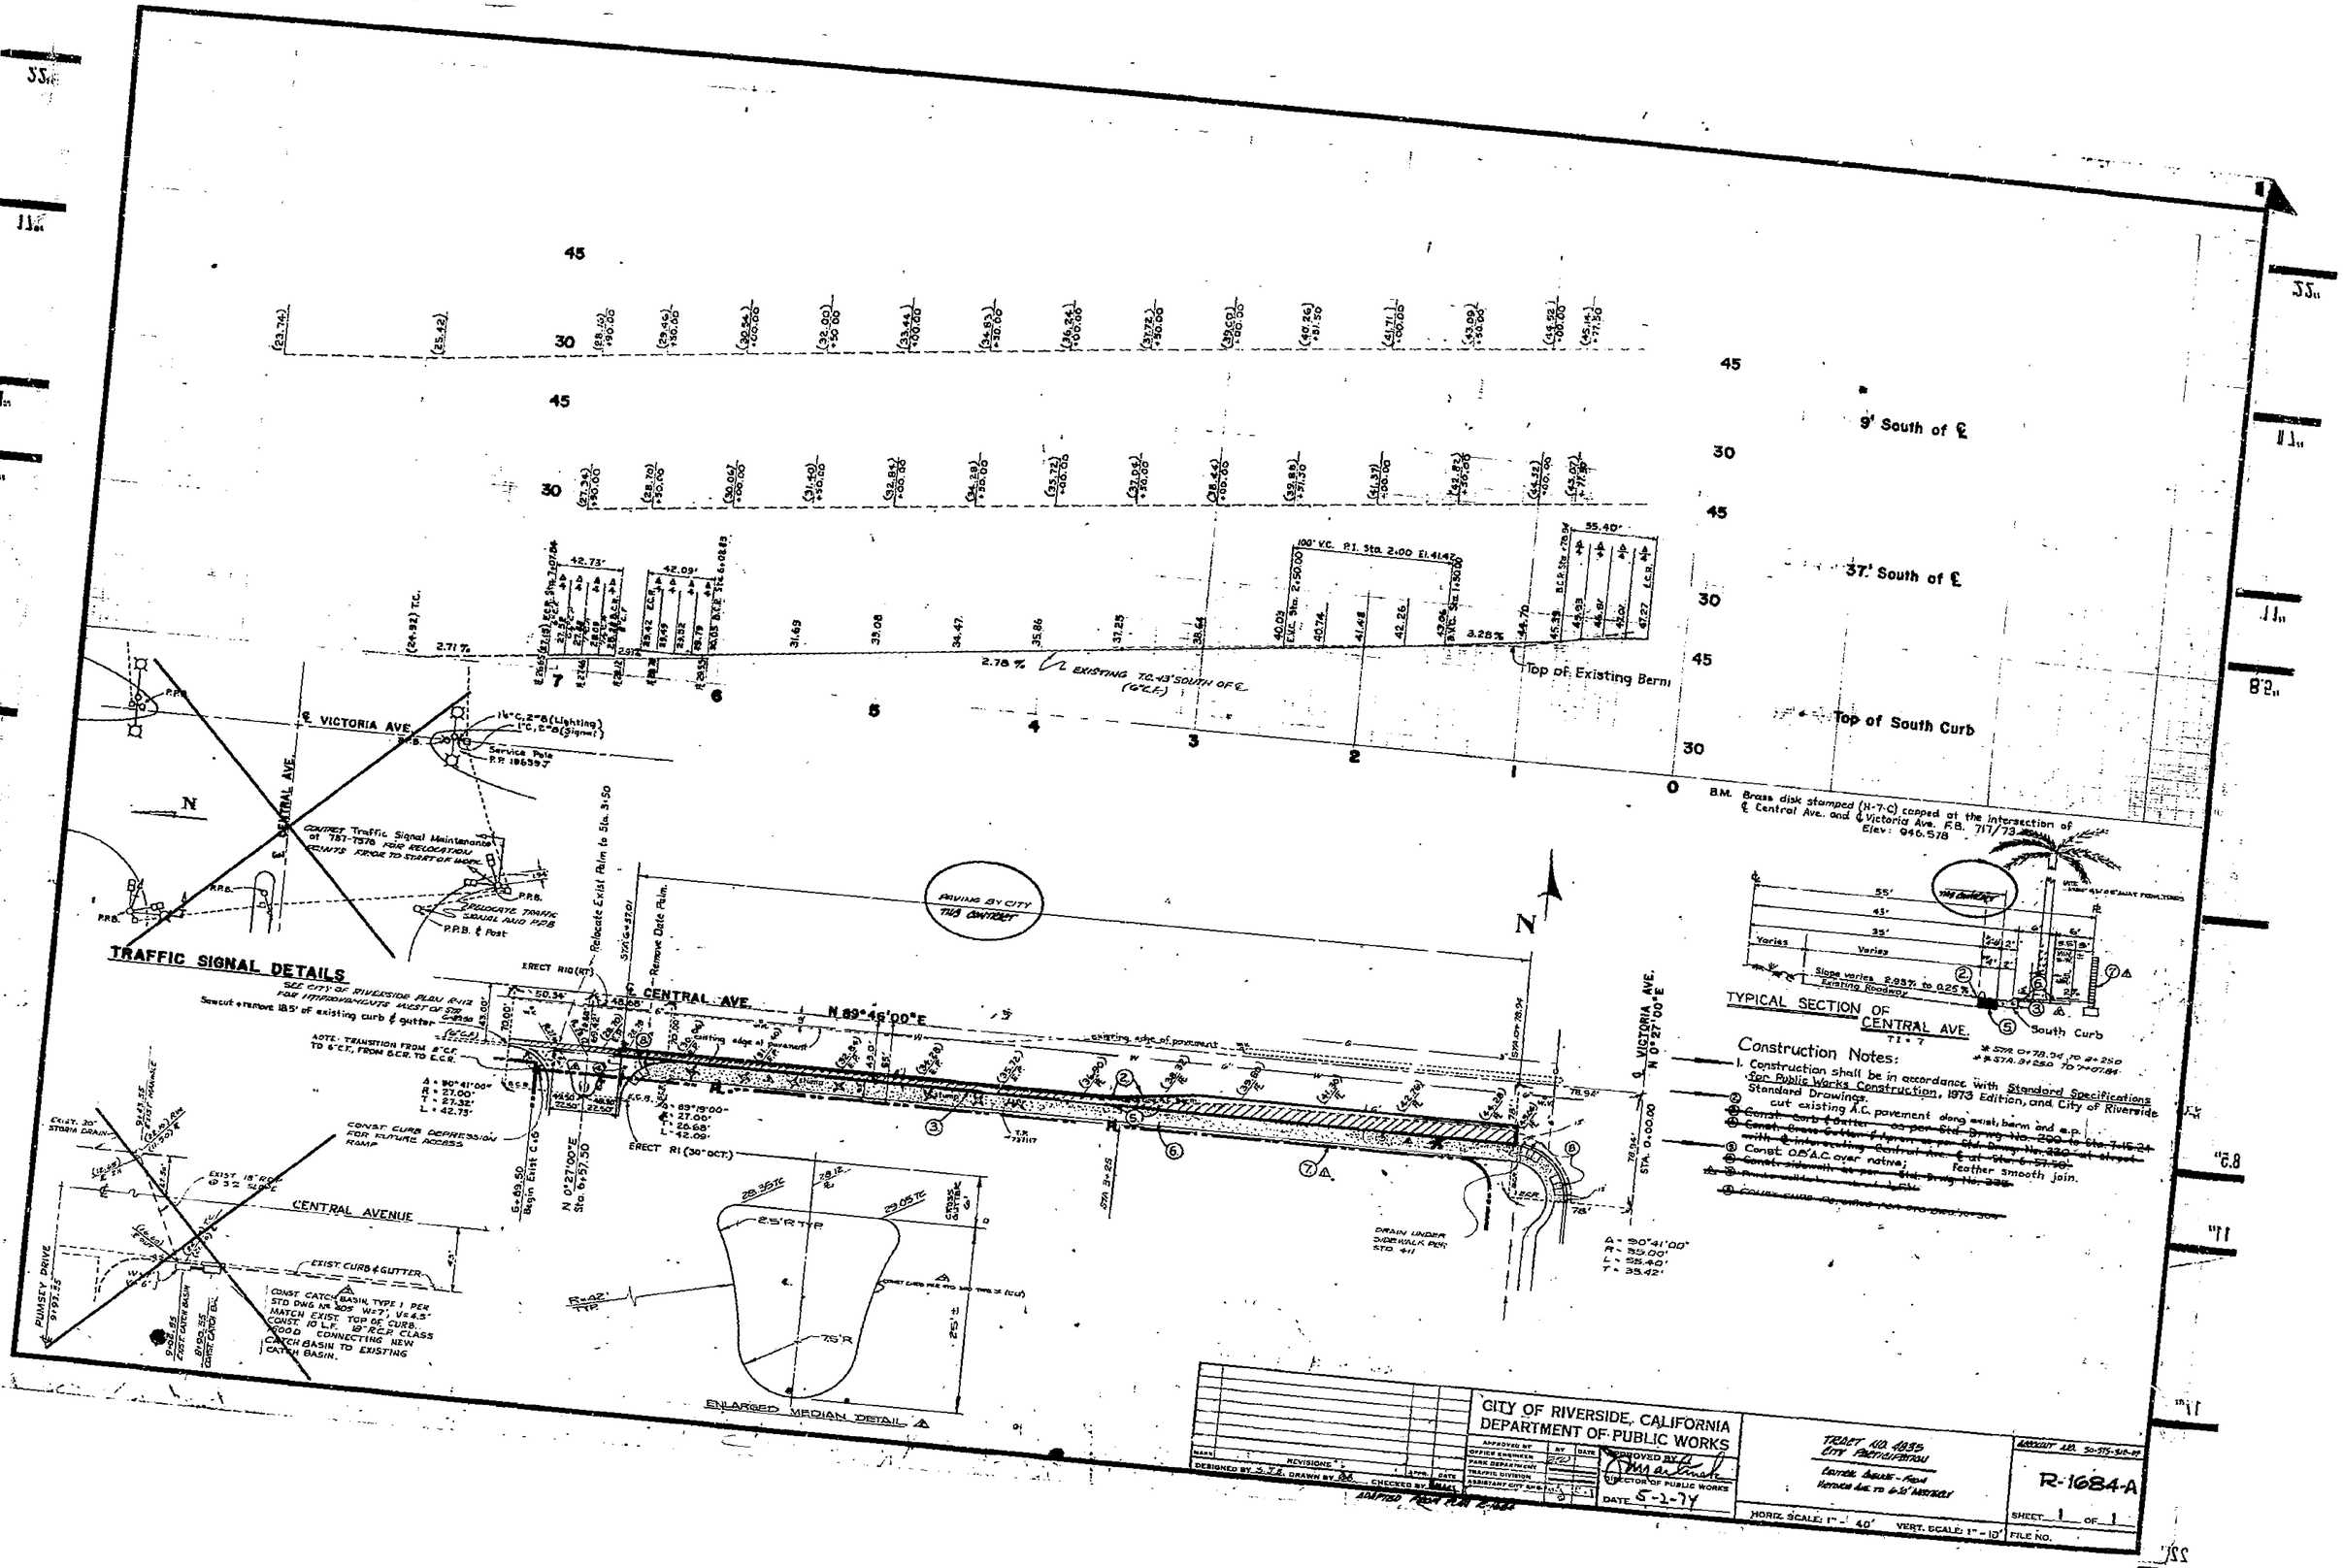

TRAFFIC SIGNAL DETAILS
℄ VICTORIA AVE.
℄ CENTRAL AVE.
N 89°46'00"E
N 0°27'00"E
CENTRAL AVENUE
PUMSEY DRIVE
9' South of ℄
37' South of ℄
Top of South Curb
Top of Existing Berm
EXISTING T.C. 43' SOUTH OF ℄ (6" C.F.)
PAVING BY CITY THIS CONTRACT
Relocate Exist Palm to Sta. 3+50
Remove Date Palm
ERECT R10 (RT)
ERECT R1 (30" OCT.)
CONST. CURB DEPRESSION FOR FUTURE ACCESS RAMP
CONST. CATCH BASIN, TYPE 1 PER STD DWG No. 405 W=7', V=4.5' MATCH EXIST. TOP OF CURB. CONST. 10 L.F. 18" R.C.P. CLASS 1000 CONNECTING NEW CATCH BASIN TO EXISTING CATCH BASIN.
EXIST. CURB & GUTTER
EXIST. 18" R.C.P. @ 3% SLOPE
EXIST. 30" STORM DRAIN
DRAIN UNDER SIDEWALK PER STD. 411
ENLARGED MEDIAN DETAIL
B.M. Brass disk stamped (N-7-C) capped at the intersection of ℄ Central Ave. and ℄ Victoria Ave. F.B. 717/73 Elev: 946.578
TYPICAL SECTION OF CENTRAL AVE.
South Curb
Slope varies 2.93% to 0.25% Existing Roadway
Construction Notes:
1. Construction shall be in accordance with Standard Specifications for Public Works Construction, 1973 Edition, and City of Riverside Standard Drawings.
② cut existing A.C. pavement along exist. berm and e.p.
③ Const. Curb & Gutter as per Std. Drwg. No. 200 to Sta. 7+15.24
④ Const. Brass Gutter & Apron as per Std. Drwg. No. 220 at street with ℄ intersecting Central Ave. ℄ at Sta. 6+57.50
⑤ Const. 0.8' A.C. over native; feather smooth join.
⑥ Const. sidewalk as per Std. Drwg. No. 238
⑦ Const. curb depression for ...
CITY OF RIVERSIDE, CALIFORNIA
DEPARTMENT OF PUBLIC WORKS
DATE 5-2-74
TRACT NO. 4835
CITY PARTICIPATION
R-1684-A
SHEET 1 OF 1
HORIZ. SCALE: 1" = 40'
VERT. SCALE: 1" = 10'
FILE NO.