



CONSTRUCTION NOTES

- CONSTRUCTION TO BE IN ACCORDANCE WITH STANDARD SPECIFICATIONS FOR PUBLIC WORKS CONSTRUCTION, 1975 EDITION.
- CURB AND GUTTER, STD. DWG. NO. 600, 6" C.F.
- CONSTRUCT S/W AS PER STD. DWG. NO. 323
- CONSTRUCT D/W APPROACHES AS PER STD. DWG. NO. 302
- INDICATES CONST. VARIABLE THICKNESS A.C. OVERLAY
- CONSTRUCT 0.45" FULL DEPTH A.C.
- EDGE FINISH TO NEW GRADE
- CONSTRUCT 2" THICK A.C. DRIVEWAYS TO MATCH
- REMOVE EXISTING STREET IMPROVEMENTS, WHERE NECESSARY
- REMOVE EXISTING STREET IMPROVEMENTS, WHERE NECESSARY

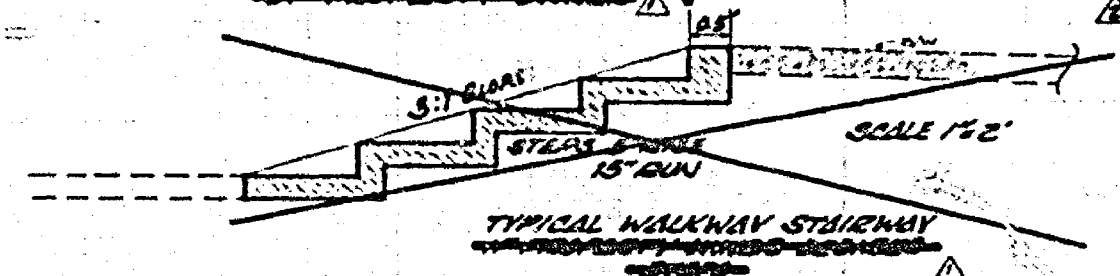


CONTROL FUNCTION	CONDUCTOR	CONDUIT	FOUNDATION	EQUIPMENT
1	14	1 1/2"	12"	12"
2	14	1 1/2"	12"	12"
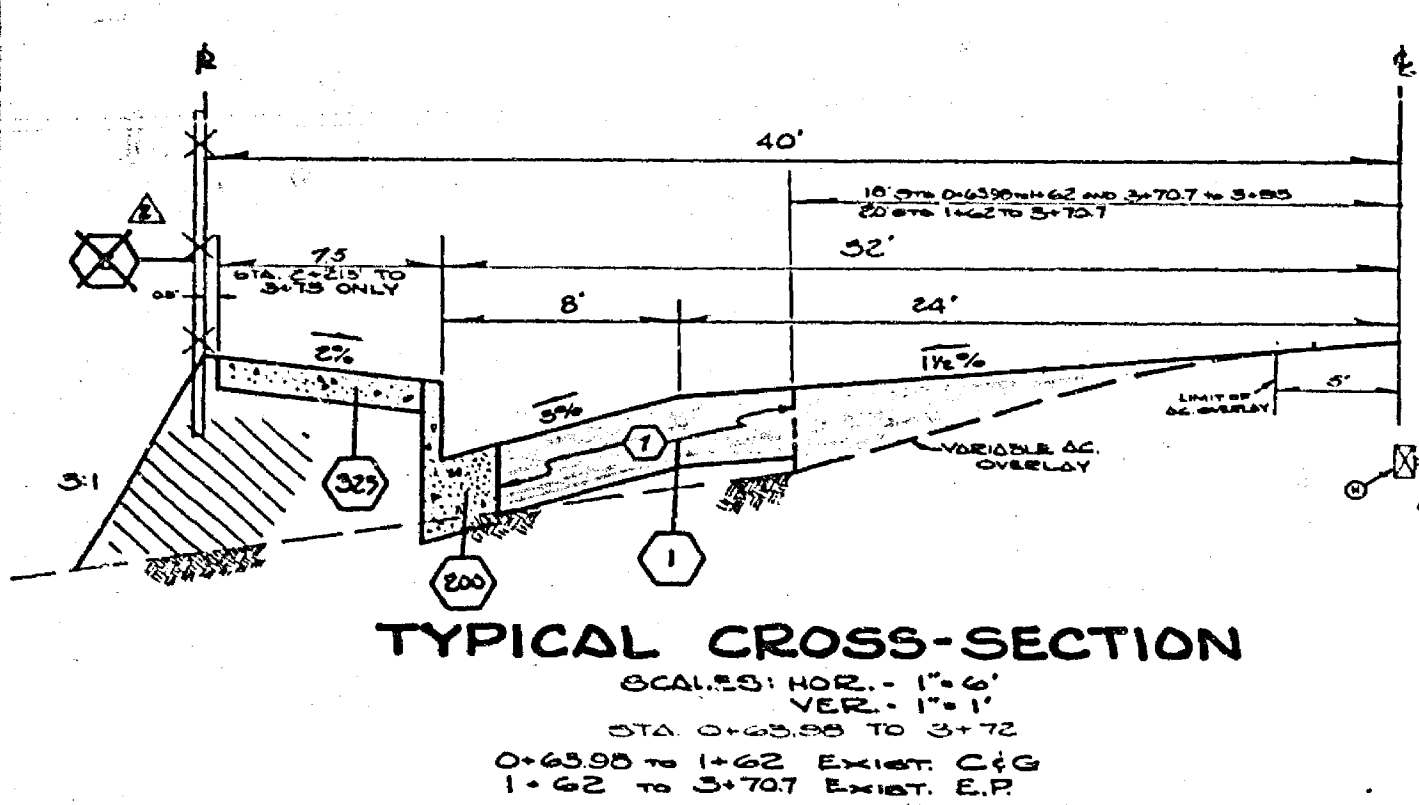

TRAFFIC SIGNAL CONSTRUCTION NOTES

- NOTIFY TRAFFIC ENG. REPRESENTATIVE 3 787-7576 48 HOURS PRIOR TO START OF SIGNAL WORK.
- INSTALL DETECTOR LOOPS AS DIRECTED BY TRAFFIC ENG. REPRESENTATIVE.
- INSTALL NEW CONDUCTORS FROM CONTROLLER TO STDS. AT LOC. 1, 2, 3, 4, AND 2 ADDITIONAL A₃ LEAD IN CABLES TO LOC. 3 ("WEST")
- INTERCEPT EXIST. 2" CONDUIT, EXTEND AS SHOWN.
- INSTALL SALVAGED TYPE XXII STD. AND EQUIP. ON NEW FOUNDATION AND CONDUIT.
- INSTALL SALVAGED TYPE I STD. AND EQUIP. ON NEW FOUNDATION AND CONDUIT.
- INSTALL NEW #6 RB.
- INSTALL NEW #5 RB.
- SALVAGE AND RELOCATE EXIST. STDS. REMOVE FOOTINGS, PULL BOXES AND CONDUIT.
- INSTALL 2 1/2" CONDUIT.
- MODIFY CONTROLLER FOR 2 ADDITIONAL A₃ SENSOR UNITS.

ALL WORK SHALL BE DONE IN ACCORDANCE WITH SECTION 65 "SIGNALS & LIGHTING" OF THE STANDARD SPECIFICATIONS, DATED JANUARY 1975 OF THE STATE OF CALIFORNIA, DEPT. OF TRANSPORTATION AND APPLICABLE CITY OF RIVERSIDE STANDARD SPECIFICATIONS AND SPECIAL PROVISIONS.

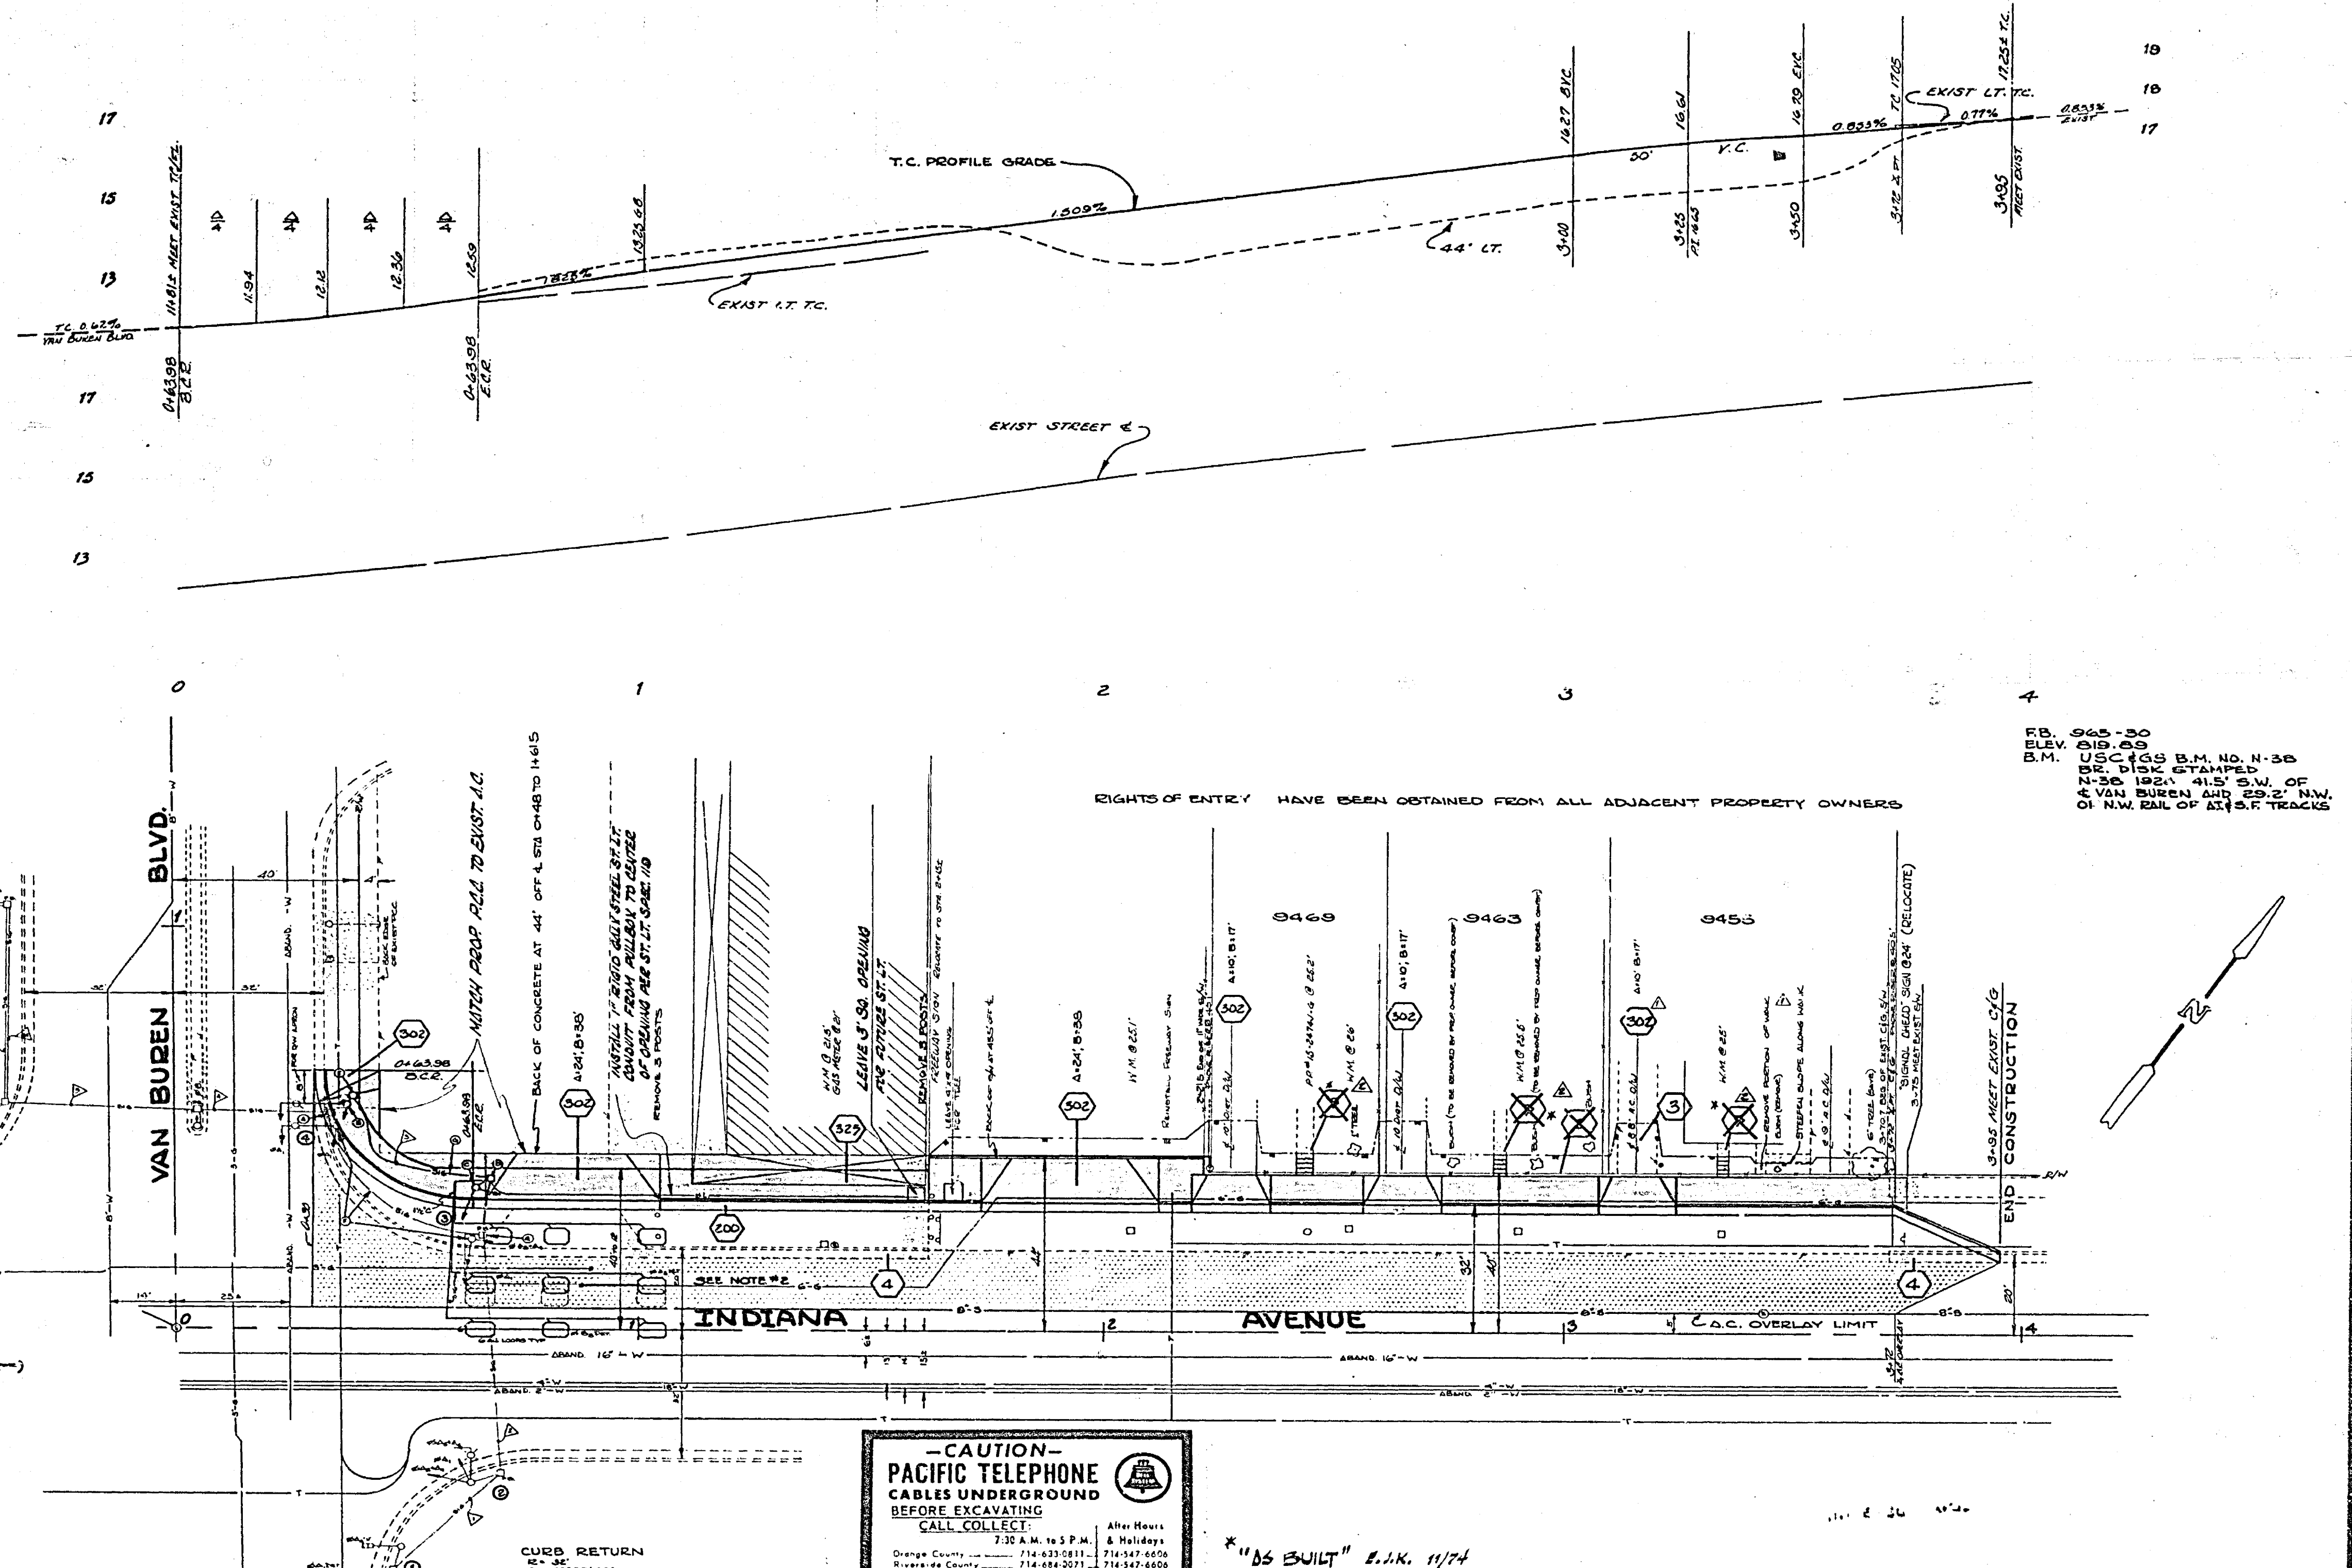

OF N.W. RAIL OF A.T.&P.F. TRACKS

CAUTION - PACIFIC TELEPHONE CABLES UNDERGROUND BEFORE EXCAVATING

CALL COLLECT: 730 A.M. to 5 P.M. After Hours
Orange County: 714-633-0811 714-547-6656
Riverside County: 714-684-2071 714-547-6656

CITY OF RIVERSIDE PUBLIC WORKS DEPARTMENT

INDIANA AVENUE WIDENING

NORTHWESTERLY SIDE, FROM VAN BUREN BLVD TO 370 FEET NORTHEASTERLY.

ACCOUNT NO. 31-35-14.7
R-1701
SHEET 1 OF 1
FILE NO.

DESIGNED BY: [Signature] DRAWN BY: [Signature] CHECKED BY: [Signature]
DATE: 11-14-73

HORIZ. SCALE: 1" = 20' VERT. SCALE: 1" = 2'