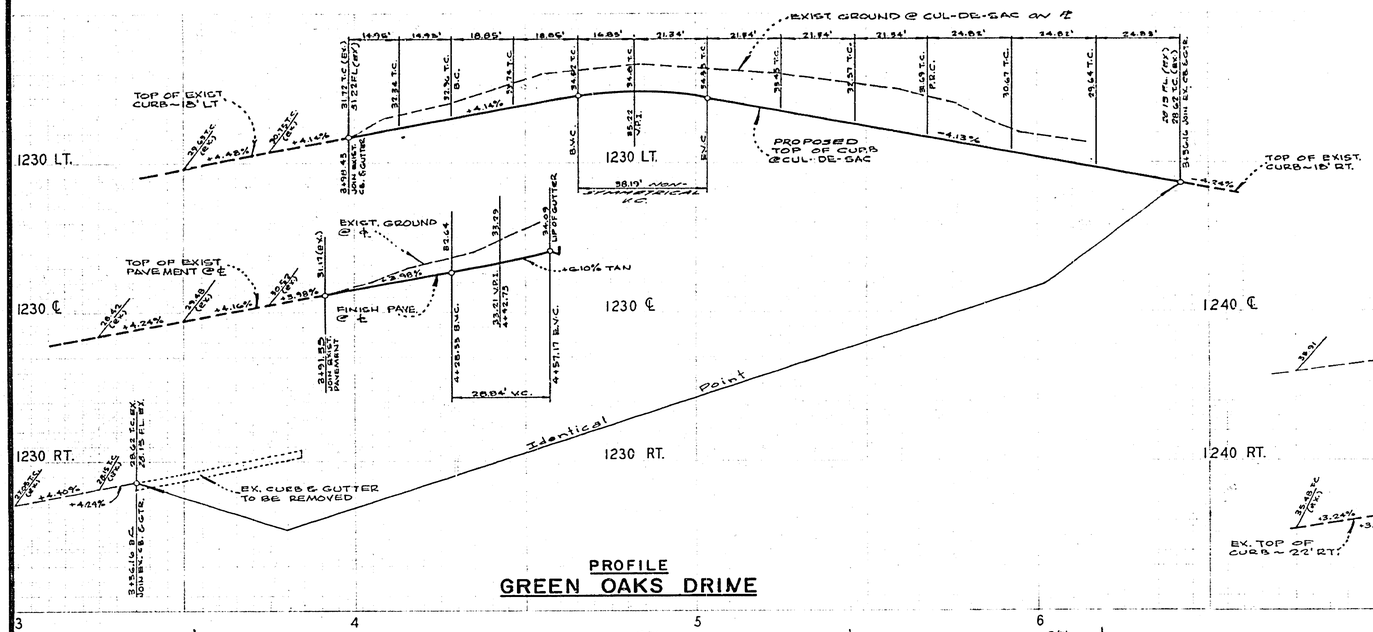

PROFILE
GREEN OAKS DRIVE

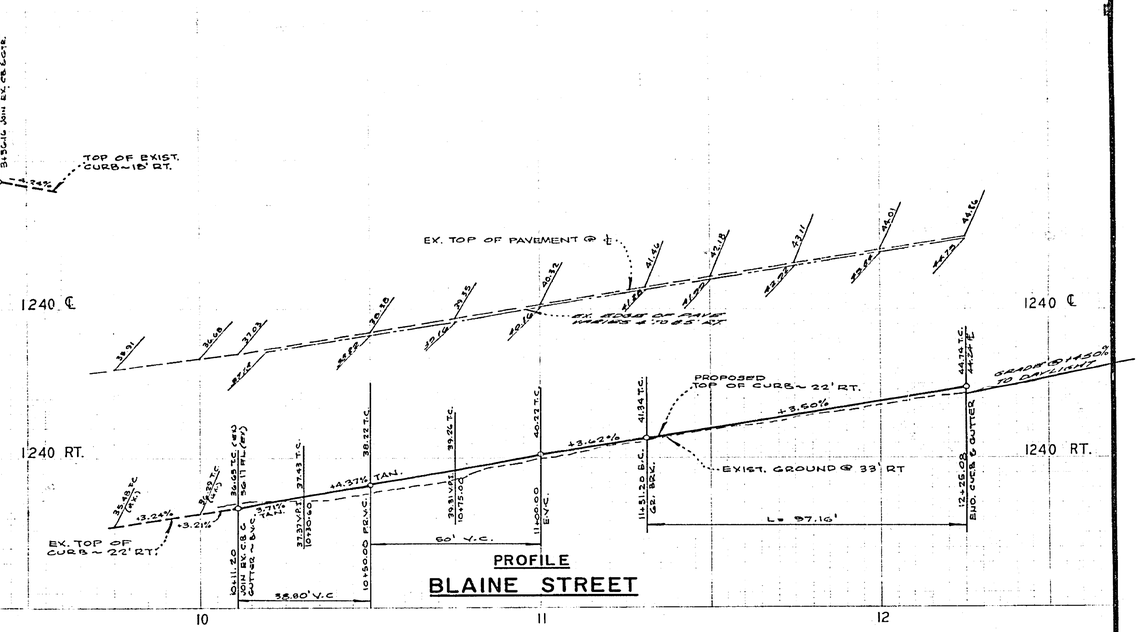

PROFILE
BLAINE STREET

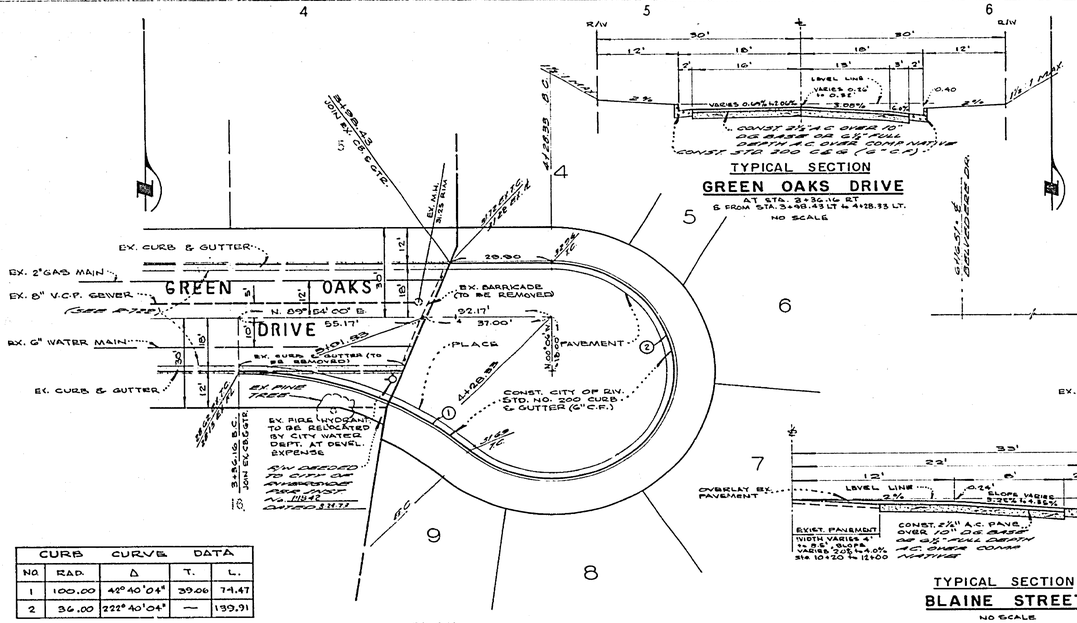

PLAN
GREEN OAKS DRIVE

CURB CURVE DATA				
NO.	RAD.	Δ	T.	L.
1	100.00	42°40'04"	39.06	74.47
2	36.00	222°40'04"	—	139.91

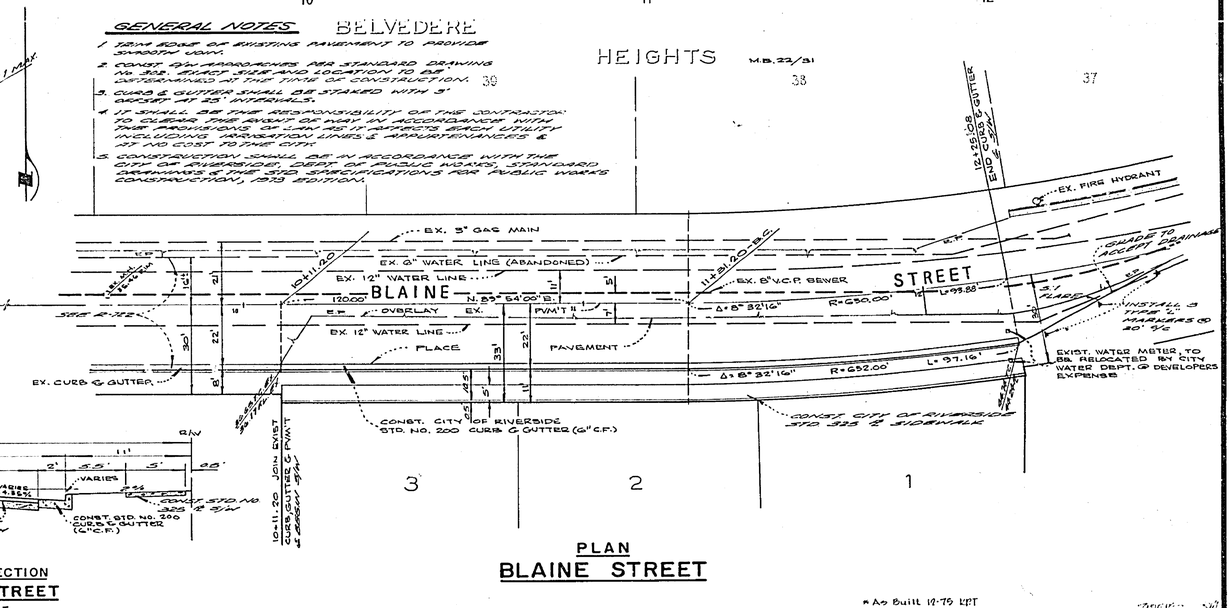

PLAN
BLAINE STREET

Bench Mark

P.K. NAIL AT WEST E.C.R. OF S.W. CURB RETURN AT BLAINE STREET & MARICOPA DRIVE
(RS M-1/72)
ELEV: 1214.77

GENERAL NOTES

3. CURB & GUTTER SHALL BE STAKED WITH 3' ABOVE AT 25' INTERVALS.
5. CONSTRUCTION SHALL BE IN ACCORDANCE WITH THE CITY OF RIVERSIDE, DEPT OF PUBLIC WORKS, STANDARD SPECIFICATIONS & THE LATEST STANDARD SPECIFICATIONS FOR PUBLIC WORKS CONSTRUCTION, 1973 EDITION.

BELVEDERE HEIGHTS M.B. 22/31

ALBERT A. WEBB ASSOCIATES CIVIL ENGINEERS RIVERSIDE, CALIFORNIA APPROVED BY [illegible] DATE 8-20-73 R.E. No. 19066 W.O. 72-283 FOR: GEORGE WRIDE	F.B. 1023	MARK	REVISIONS	APPR.	DATE
			DESIGNED BY P.U. DRAWN BY W.J.K. CHECKED BY S.M.		

CITY OF RIVERSIDE, CALIFORNIA
PUBLIC WORKS DEPARTMENT

APPROVED BY	BY	DATE
PRINCIPAL ENGINEER	[illegible]	9-12
PARK DEPARTMENT	[illegible]	9-12
TRAFFIC DIVISION	[illegible]	9-12
CHIEF PUB. WKS. ENGR.	[illegible]	9-12

APPROVED BY [illegible]
DIRECTOR OF PUBLIC WORKS
DATE 9-14-73

TRACT NO. 4783
STREET PLAN AND PROFILE
GREEN OAKS DRIVE
BLAINE STREET
SCALES: 1"=20' HORIZ.; 1"=4' VERT.

ACCOUNT No. 72-283
DRAWING NUMBER
R-1712
SHEET 1 OF 1
72-283-A

*As Built 12-75 LPT