
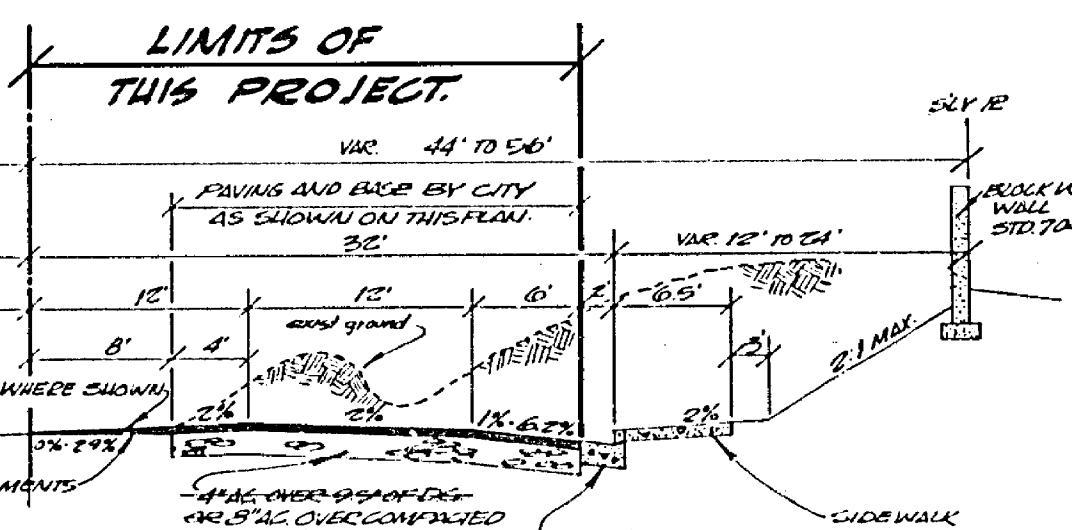


930 E

E 930

930 RT.

RT. 930

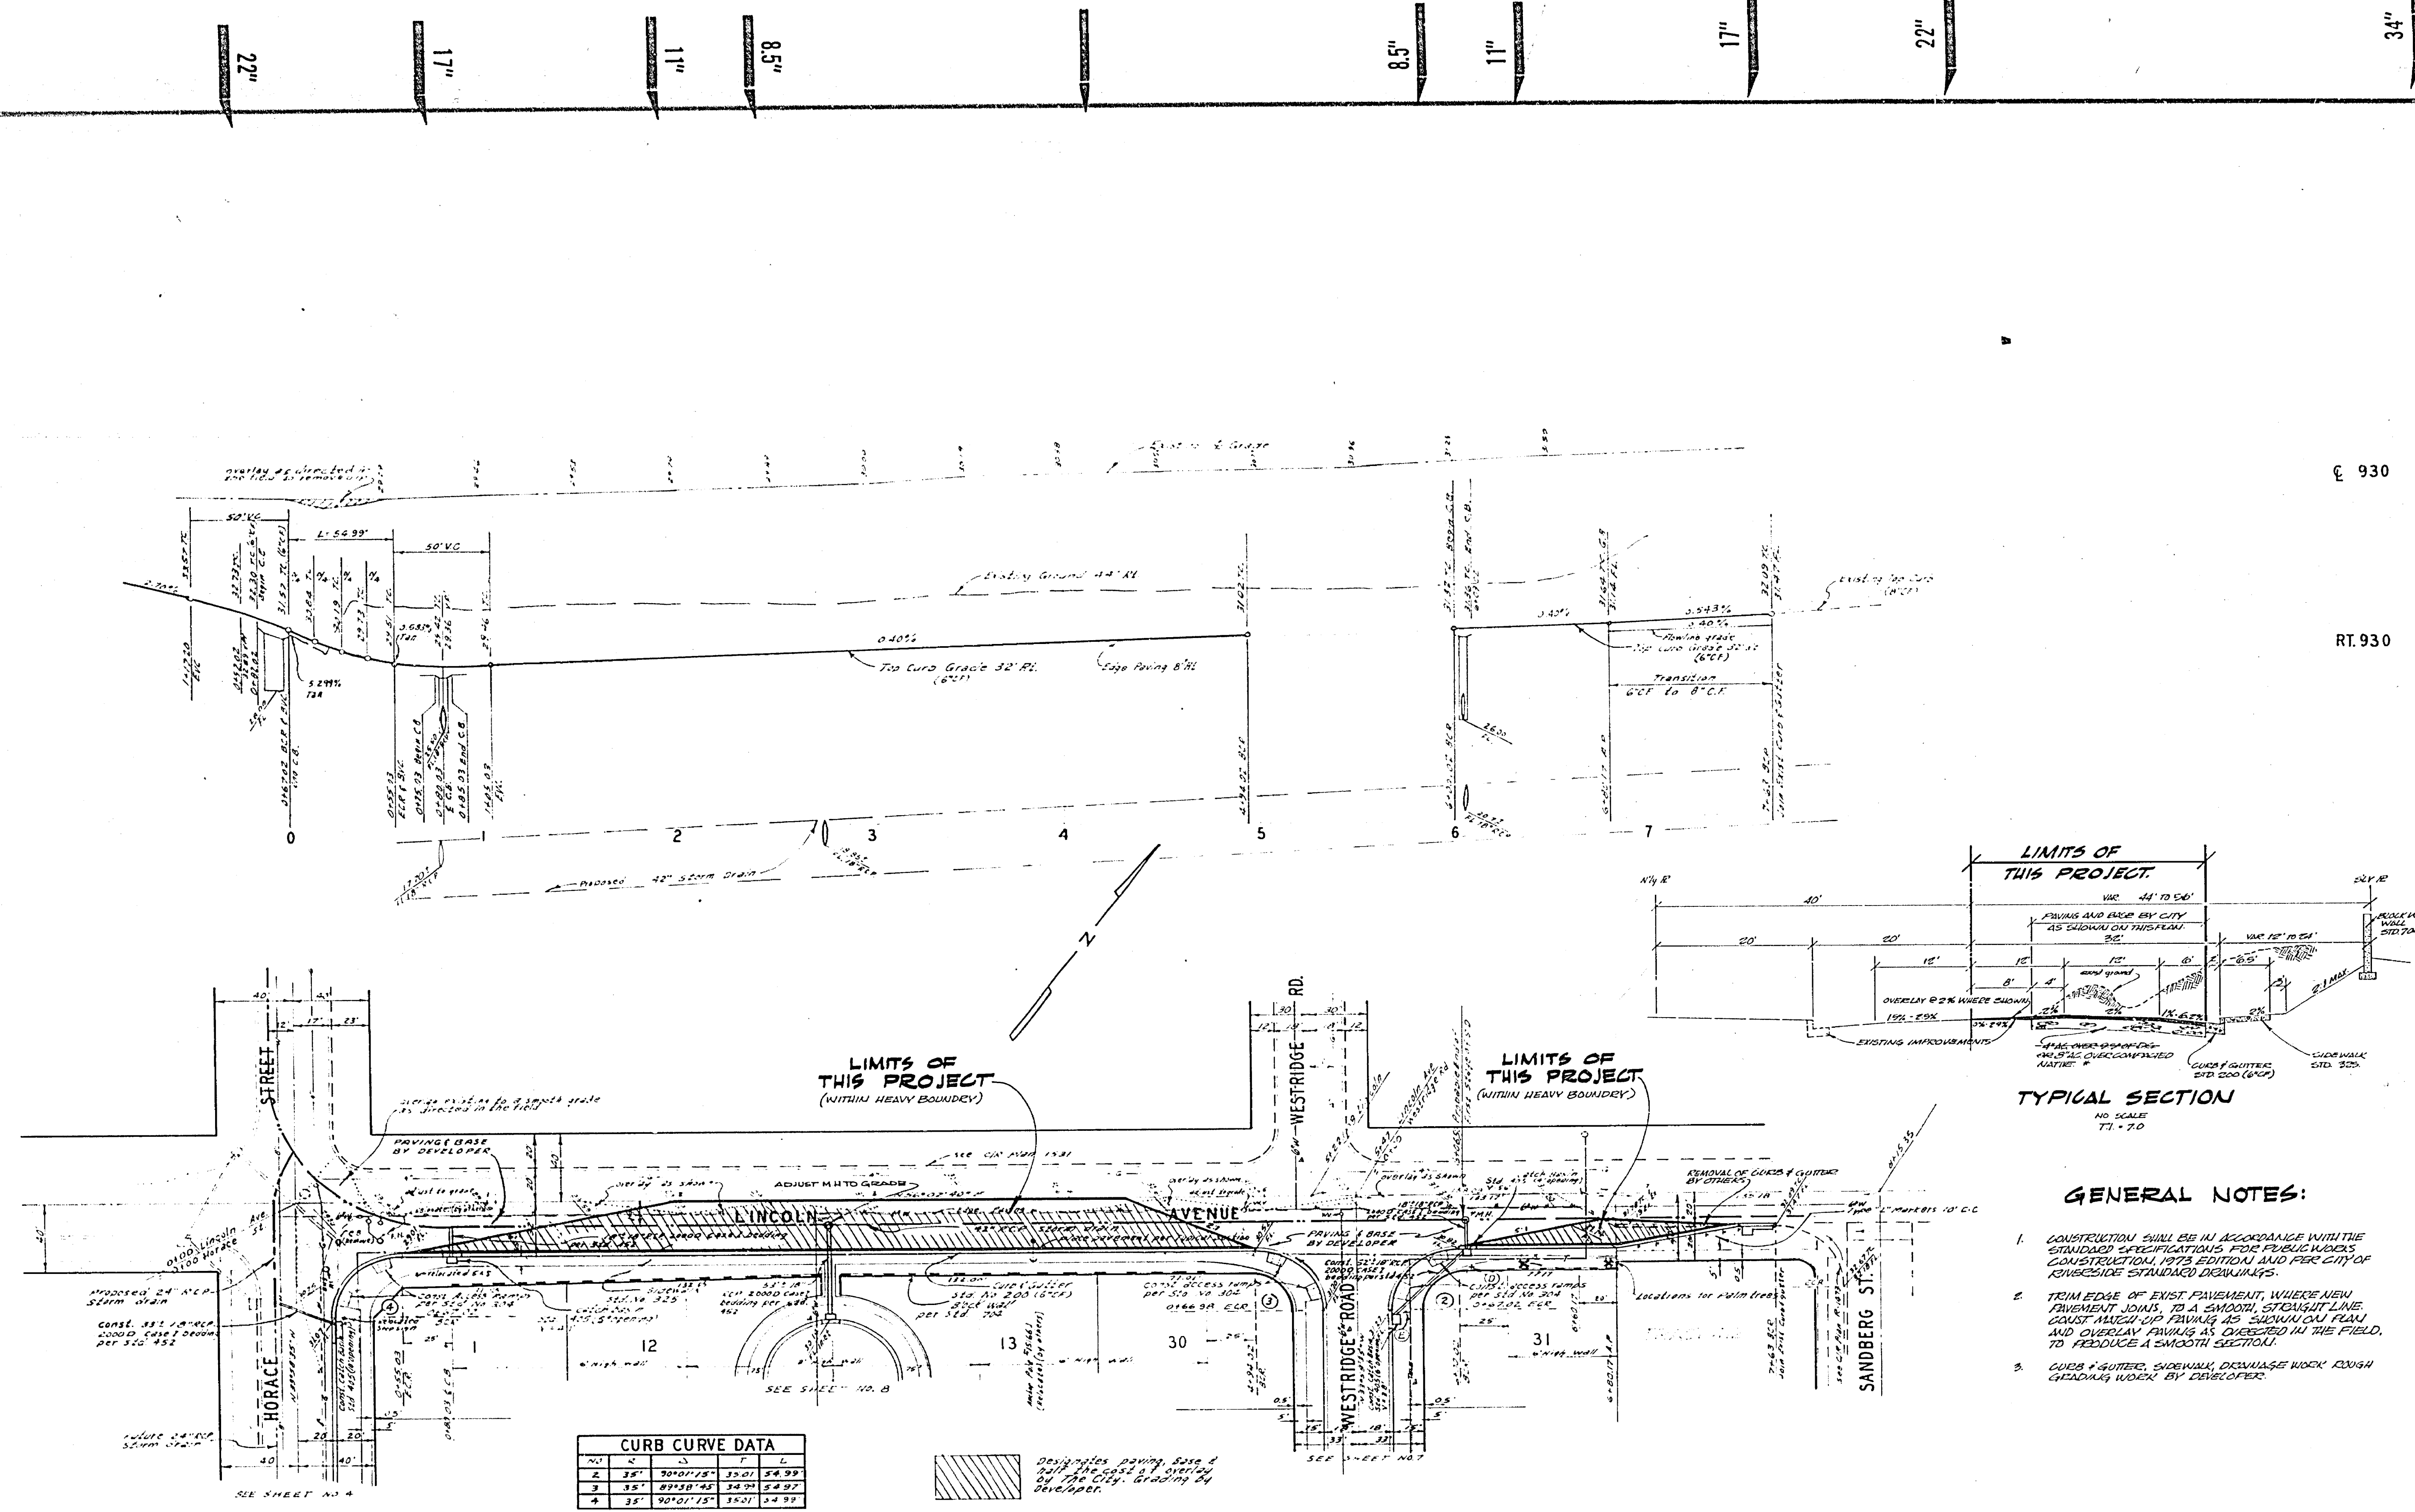

TYPICAL SECTION
NO SCALE
71-70

GENERAL NOTES:

- CONSTRUCTION SHALL BE IN ACCORDANCE WITH THE STANDARD SPECIFICATIONS FOR PUBLIC WORKS CONSTRUCTION, 1973 EDITION AND PER CITY OF RIVERSIDE STANDARD DRAWINGS.
- TOE EDGE OF EXIST PAVEMENT, WHERE NEW PAVEMENT JOINS, TO A SMOOTH, STRAIGHT LINE. CURB MATCH-UP PAVING AS SHOWN ON PLAN AND OVERLAY PAVING AS OVERLAY IN THE FIELD TO PRODUCE A SMOOTH SECTION.
- CURB & GUTTER, SIDEWALK, DRAINAGE WORK, DRAIN GRADING WORK BY DEVELOPER.

CURB CURVE DATA				
NO.	R	Δ	T	L

Designates paving base & shall the case of overlay by the City. Grading by Developer.

NOTE: Construction of improvements in Lincoln Ave. including 24" storm drain, 12" water main, and 12" gas main on Westridge Road shall be deferred until such time as the 24" water main storm drain is under construction or completed.

ALBERT A. WEBB ASSOCIATES CIVIL ENGINEERS RIVERSIDE, CALIFORNIA APPROVED BY: [Signature] DATE: 1/17/76 R.E. No. 9876	CITY OF RIVERSIDE, CALIFORNIA PUBLIC WORKS DEPARTMENT	TRACT 5487 CITY PARTICIPATION LINCOLN AVE. N.E. OF HORACE ST.	ACCOUNT NO. 90-975-364-07 DRAWING NUMBER R1753-A SHEET 1 OF 1
	APPROVED BY: [Signature] DATE: 1/17/76 R.E. No. 9876	APPROVED BY: [Signature] DATE: 1/17/76 PRINCIPAL ENGINEER PARK DEPARTMENT TRAFFIC DIVISION EQUIPMENT DIVISION	APPROVED BY: [Signature] DATE: 1/17/76 DIRECTOR OF PUBLIC WORKS