
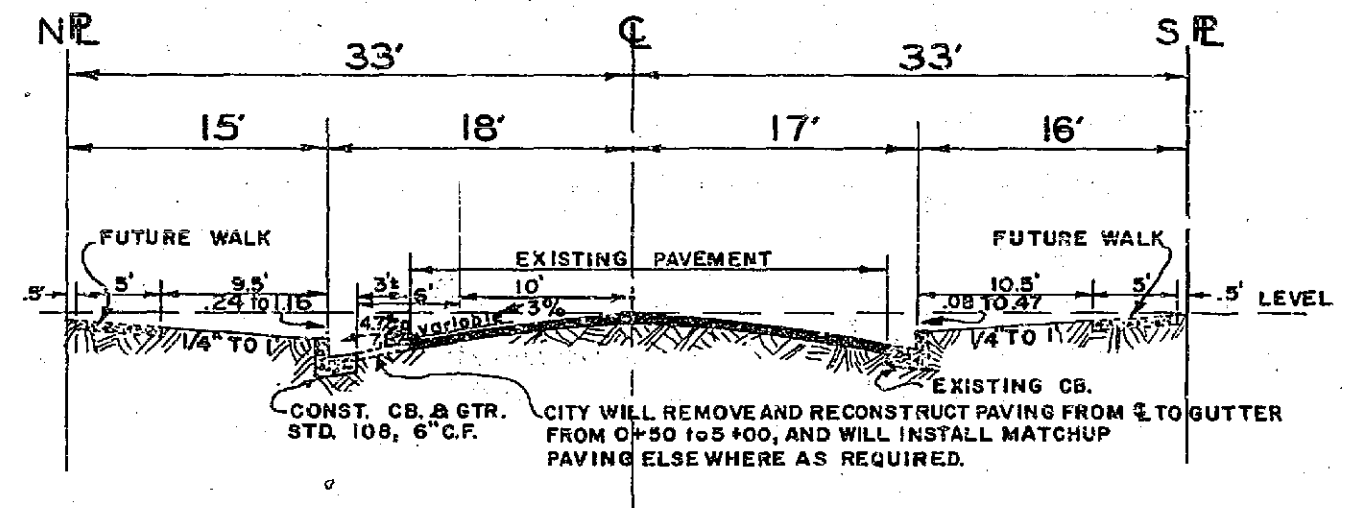


BM. ELEV. 910.73 S&L IN W BOX SW COR. HIGH & COTTAGE.
 F.B. 613/52-59
 SCALE: HOR. 1"=50'
 VERT. 1"=5'


SCALE: 1"=50'

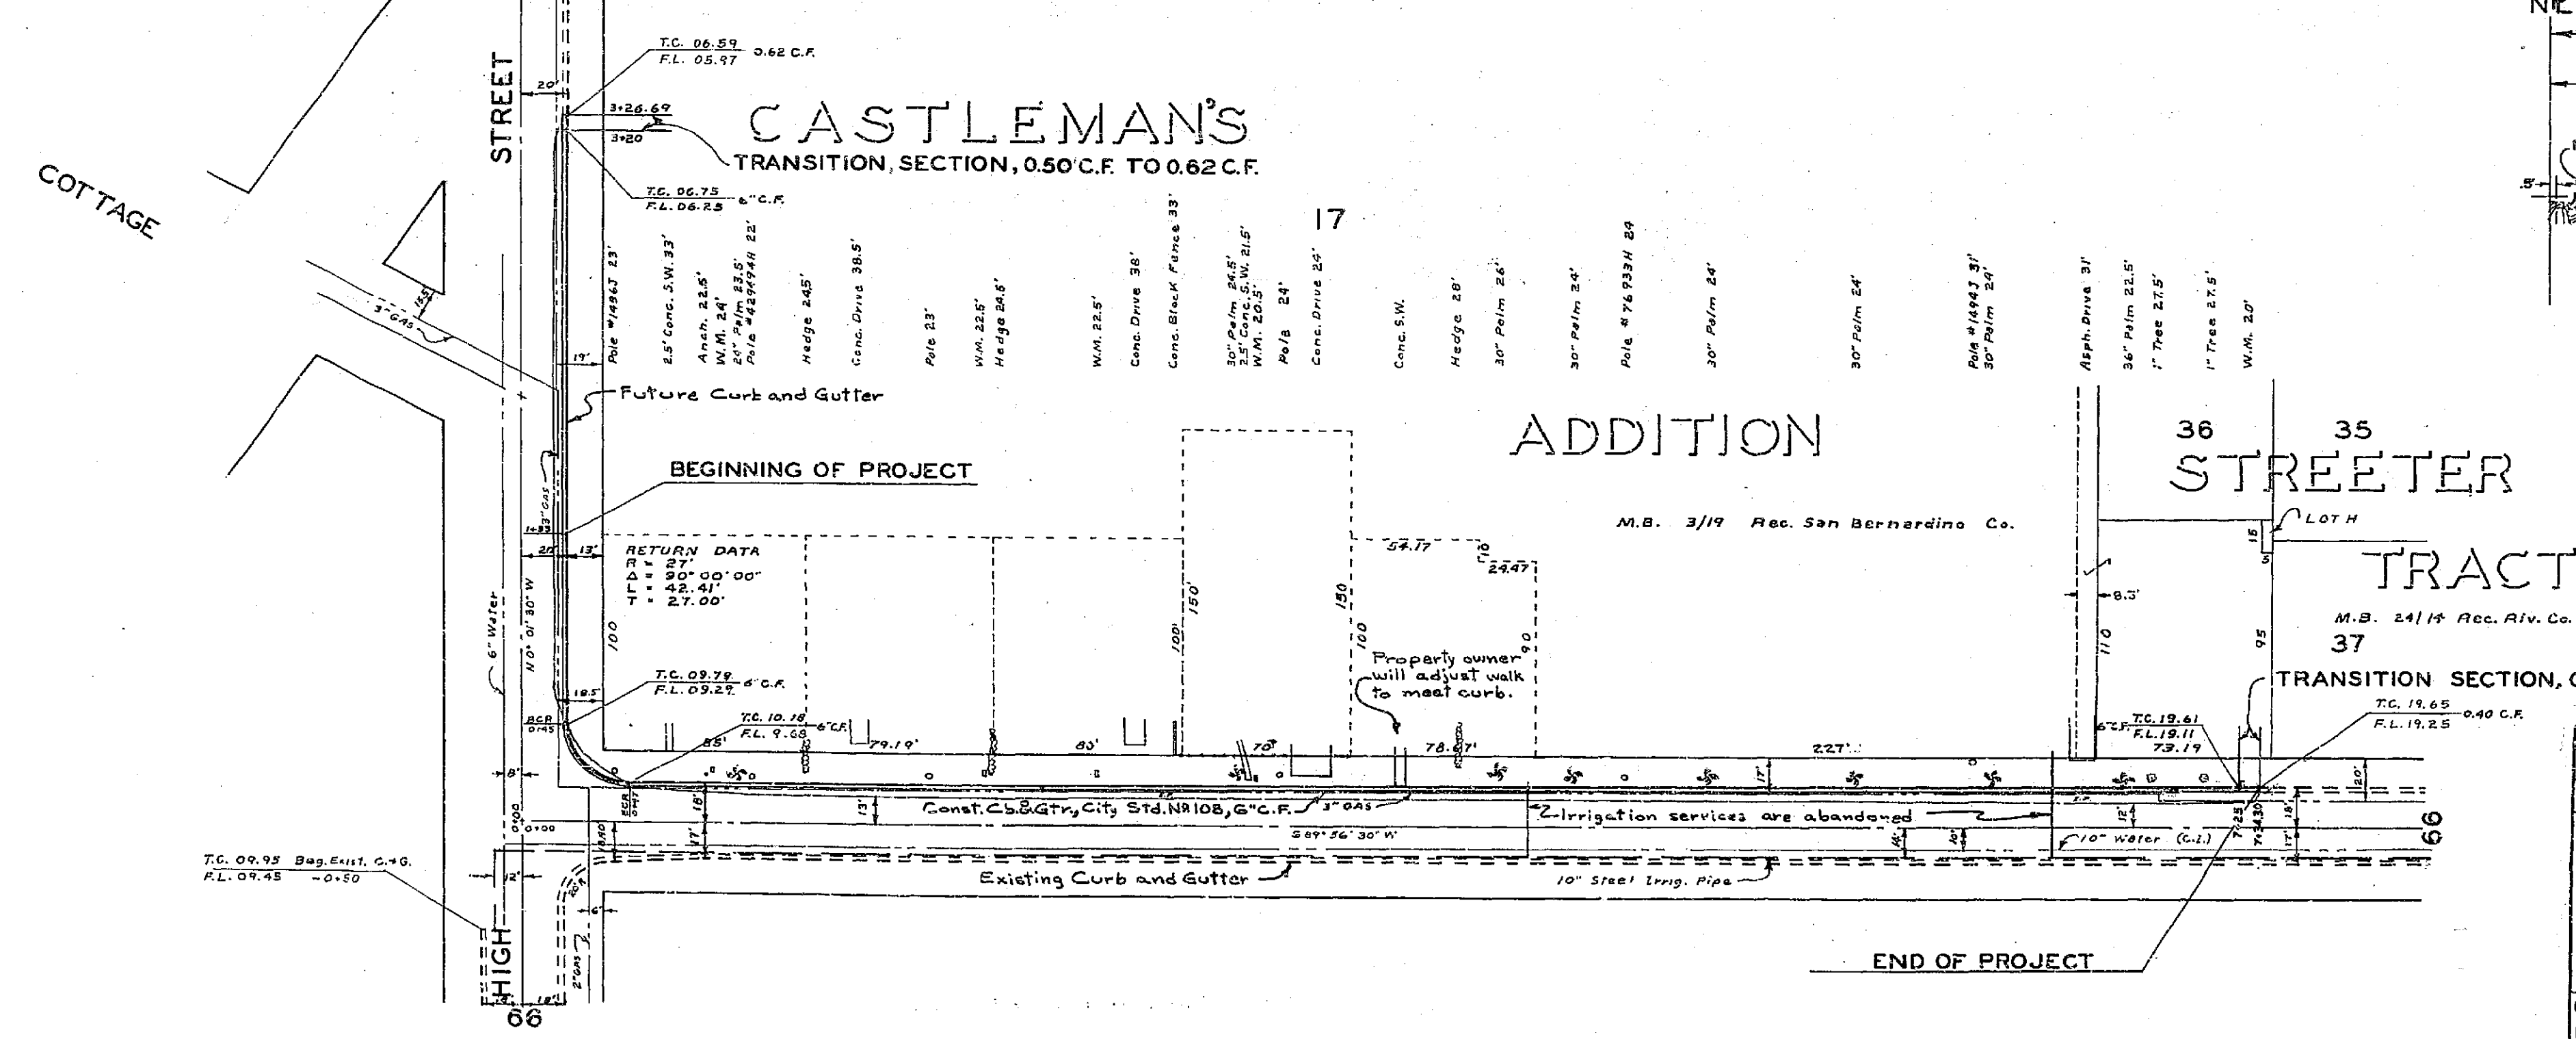

TYPICAL SECTION
 SCALE: HOR. 1"=10'
 VERT. 1"=4'
 Street Dept. to resurface entire width to this section 10/27/18 wdg


| REVISIONS | | | CITY OF RIVERSIDE CALIFORNIA DEPARTMENT OF PUBLIC WORKS |
|-----------|--------|------------------------|--|
| MARK | DATE | DESCRIPTION | |
| | 6/5/58 | Removed R.S. 19/44 wdg | PENNSYLVANIA AVENUE IMPROVEMENT DIST. CURB & GUTTER EAST OF HIGH STREET 1911 ACT |
| | | | |

DESIGNED BY W.D.G. CHECKED BY J.L.B. APPROVED BY J.L.B.
 DRAWN BY E.L. DIRECTOR OF PUBLIC WORKS
 RECOMMENDED BY J.L.B. ASSISTANT CITY ENGINEER DATE Nov 20 1918 SHEET 1 OF 1

