
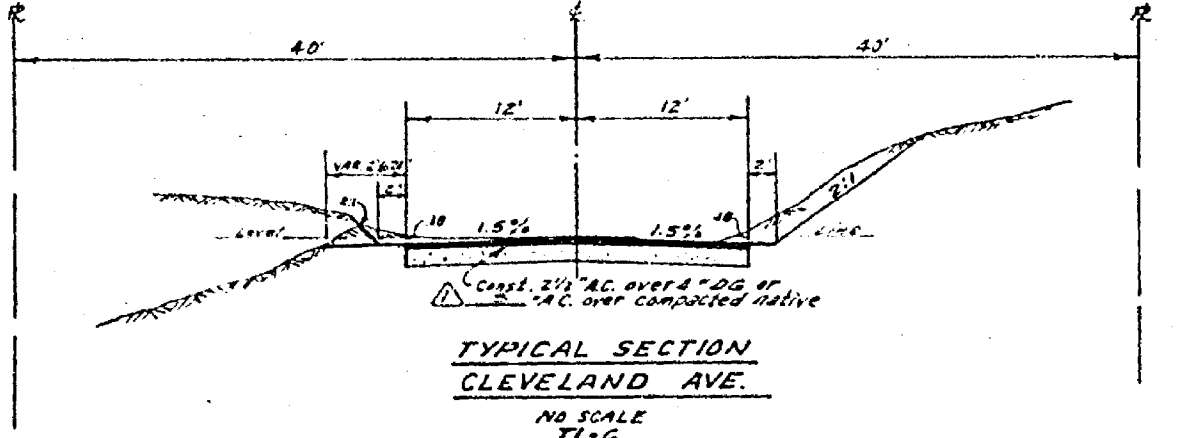


BENCH MARK: Elev. 874.12
 1/2" = 1' HORIZ. 1" = 10' VERT.

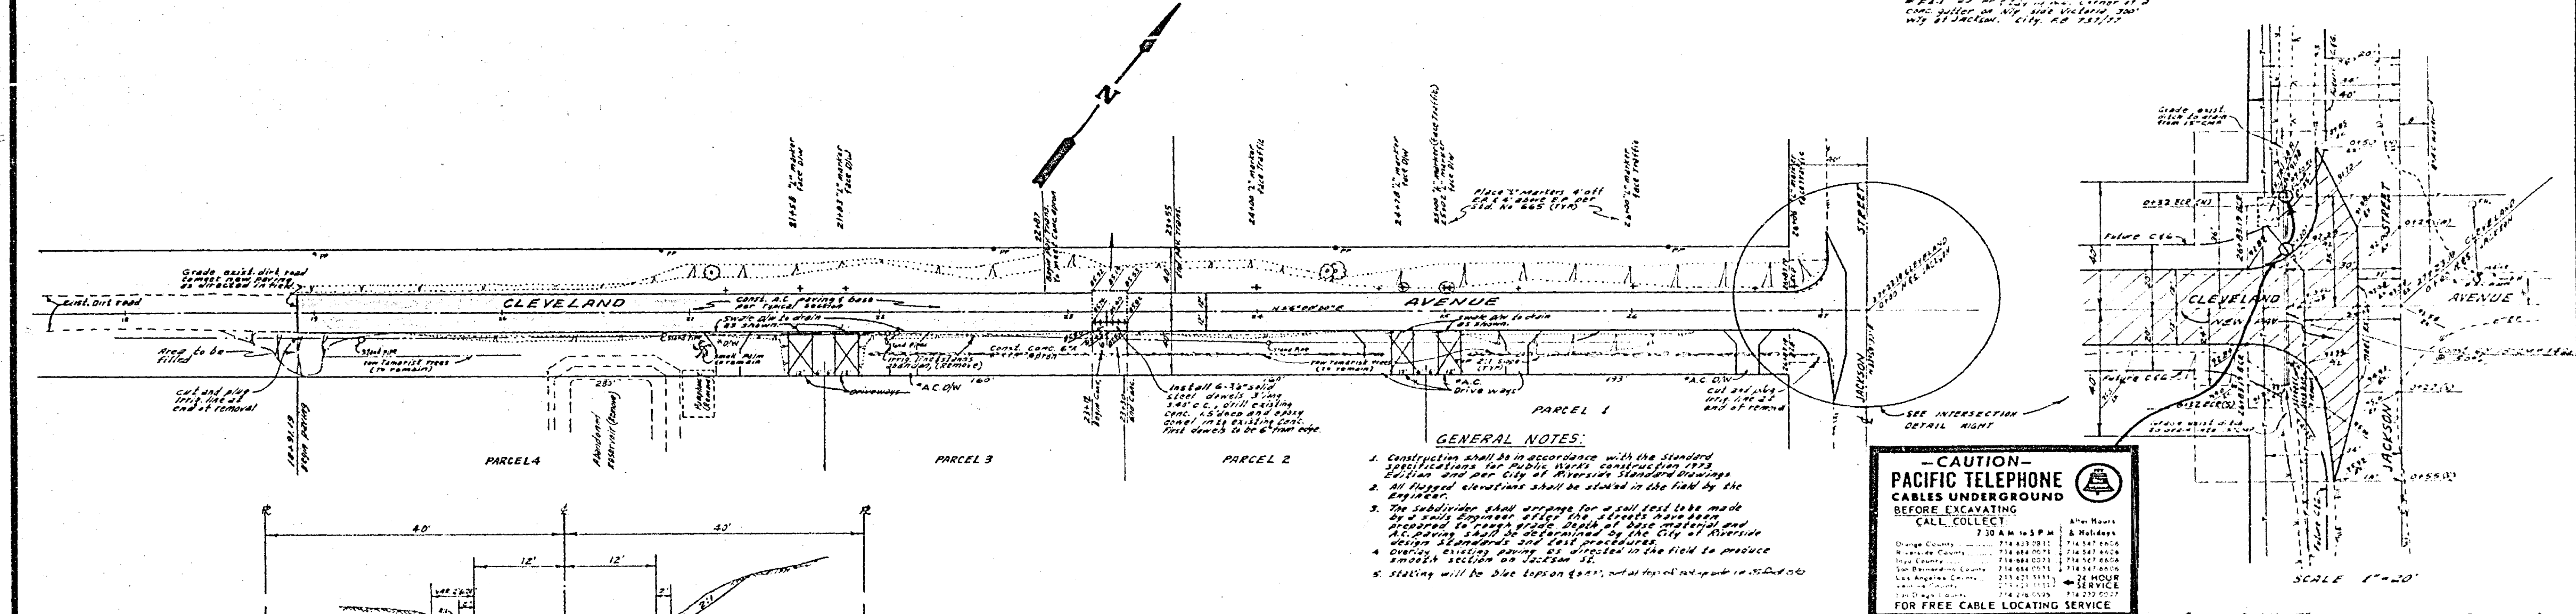

- GENERAL NOTES:**
1. Construction shall be in accordance with the Standard Specifications for Public Works Construction, 1975 Edition and per City of Riverside Standard Drawings.

- CAUTION -
PACIFIC TELEPHONE
CABLES UNDERGROUND
 BEFORE EXCAVATING
 CALL COLLECT

7:30 AM - 5:30 PM
 For Free Cable Locating Service

ALBERT A. WEBB ASSOCIATES CIVIL ENGINEERS RIVERSIDE, CALIFORNIA APPROVED BY: <i>P. Webb</i> DATE: 7/10/75 R.E. No. 2876 No. 74-198 FOR B.I.R. CASE G. P.B. 1975		CITY OF RIVERSIDE, CALIFORNIA PUBLIC WORKS DEPARTMENT APPROVED BY: <i>D. H. ...</i> DIRECTOR OF PUBLIC WORKS DATE: 11/12/75		STREET PLAN AND PROFILE CLEVELAND AVENUE P.M. 203 SCALE: 1" = 40' HORIZ. 1" = 10' VERT.		ACCOUNT NO. DRAWING NUMBER R-1845 SHEET 1 OF 1 72-128-A	
---	--	--	--	--	--	--	--