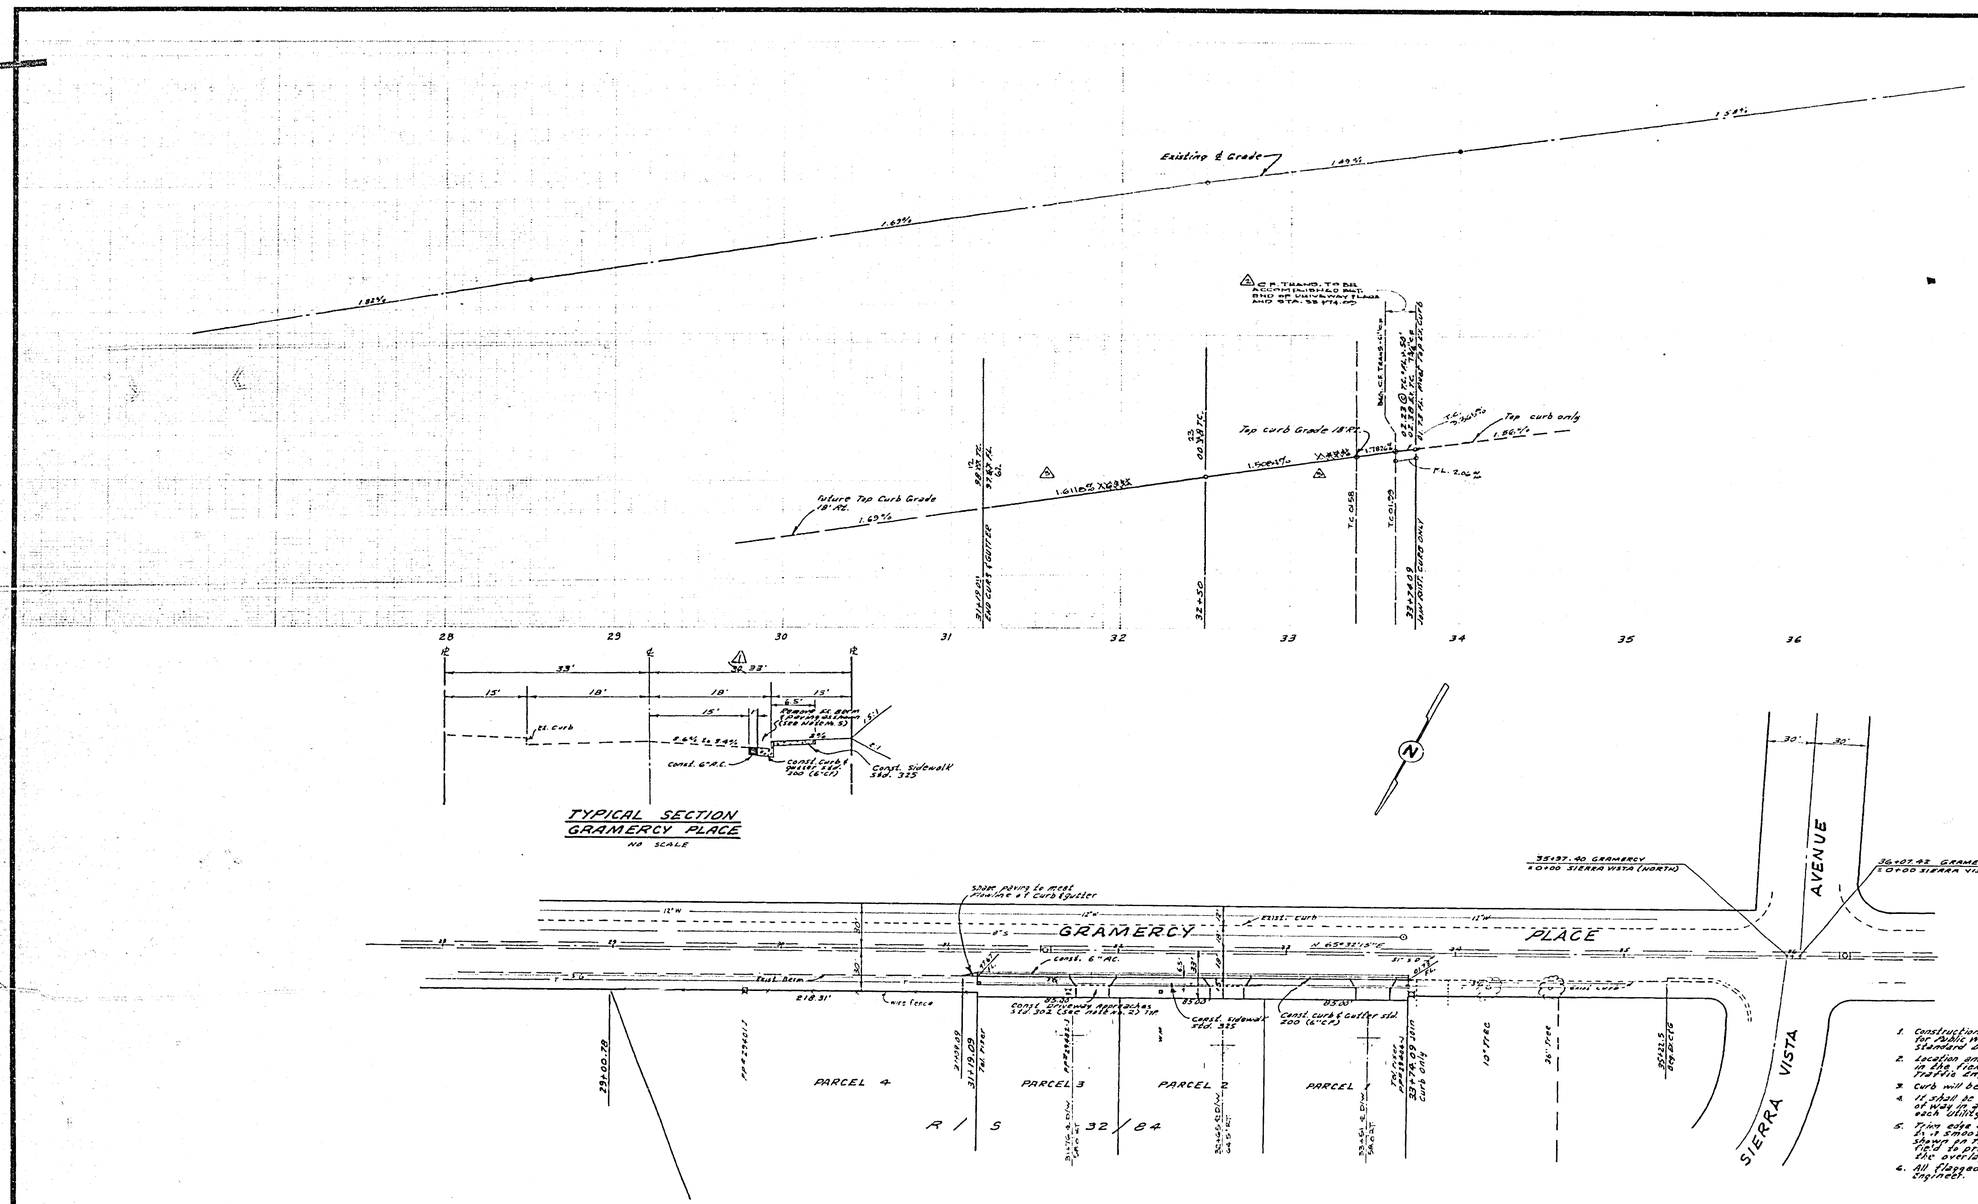
Existing ℄ Grade
1.69%
1.82%
1.59%
Top curb Grade 18'AE.
Top curb only
1.86%
Future Top Curb Grade 18'AE.
1.69%
1.61106% XG33X
1.66106%
1.78106%
F.L. 2.04
Tc 0.58
TC 01.29
32+50
33+71.09
END CURB & GUTTER
