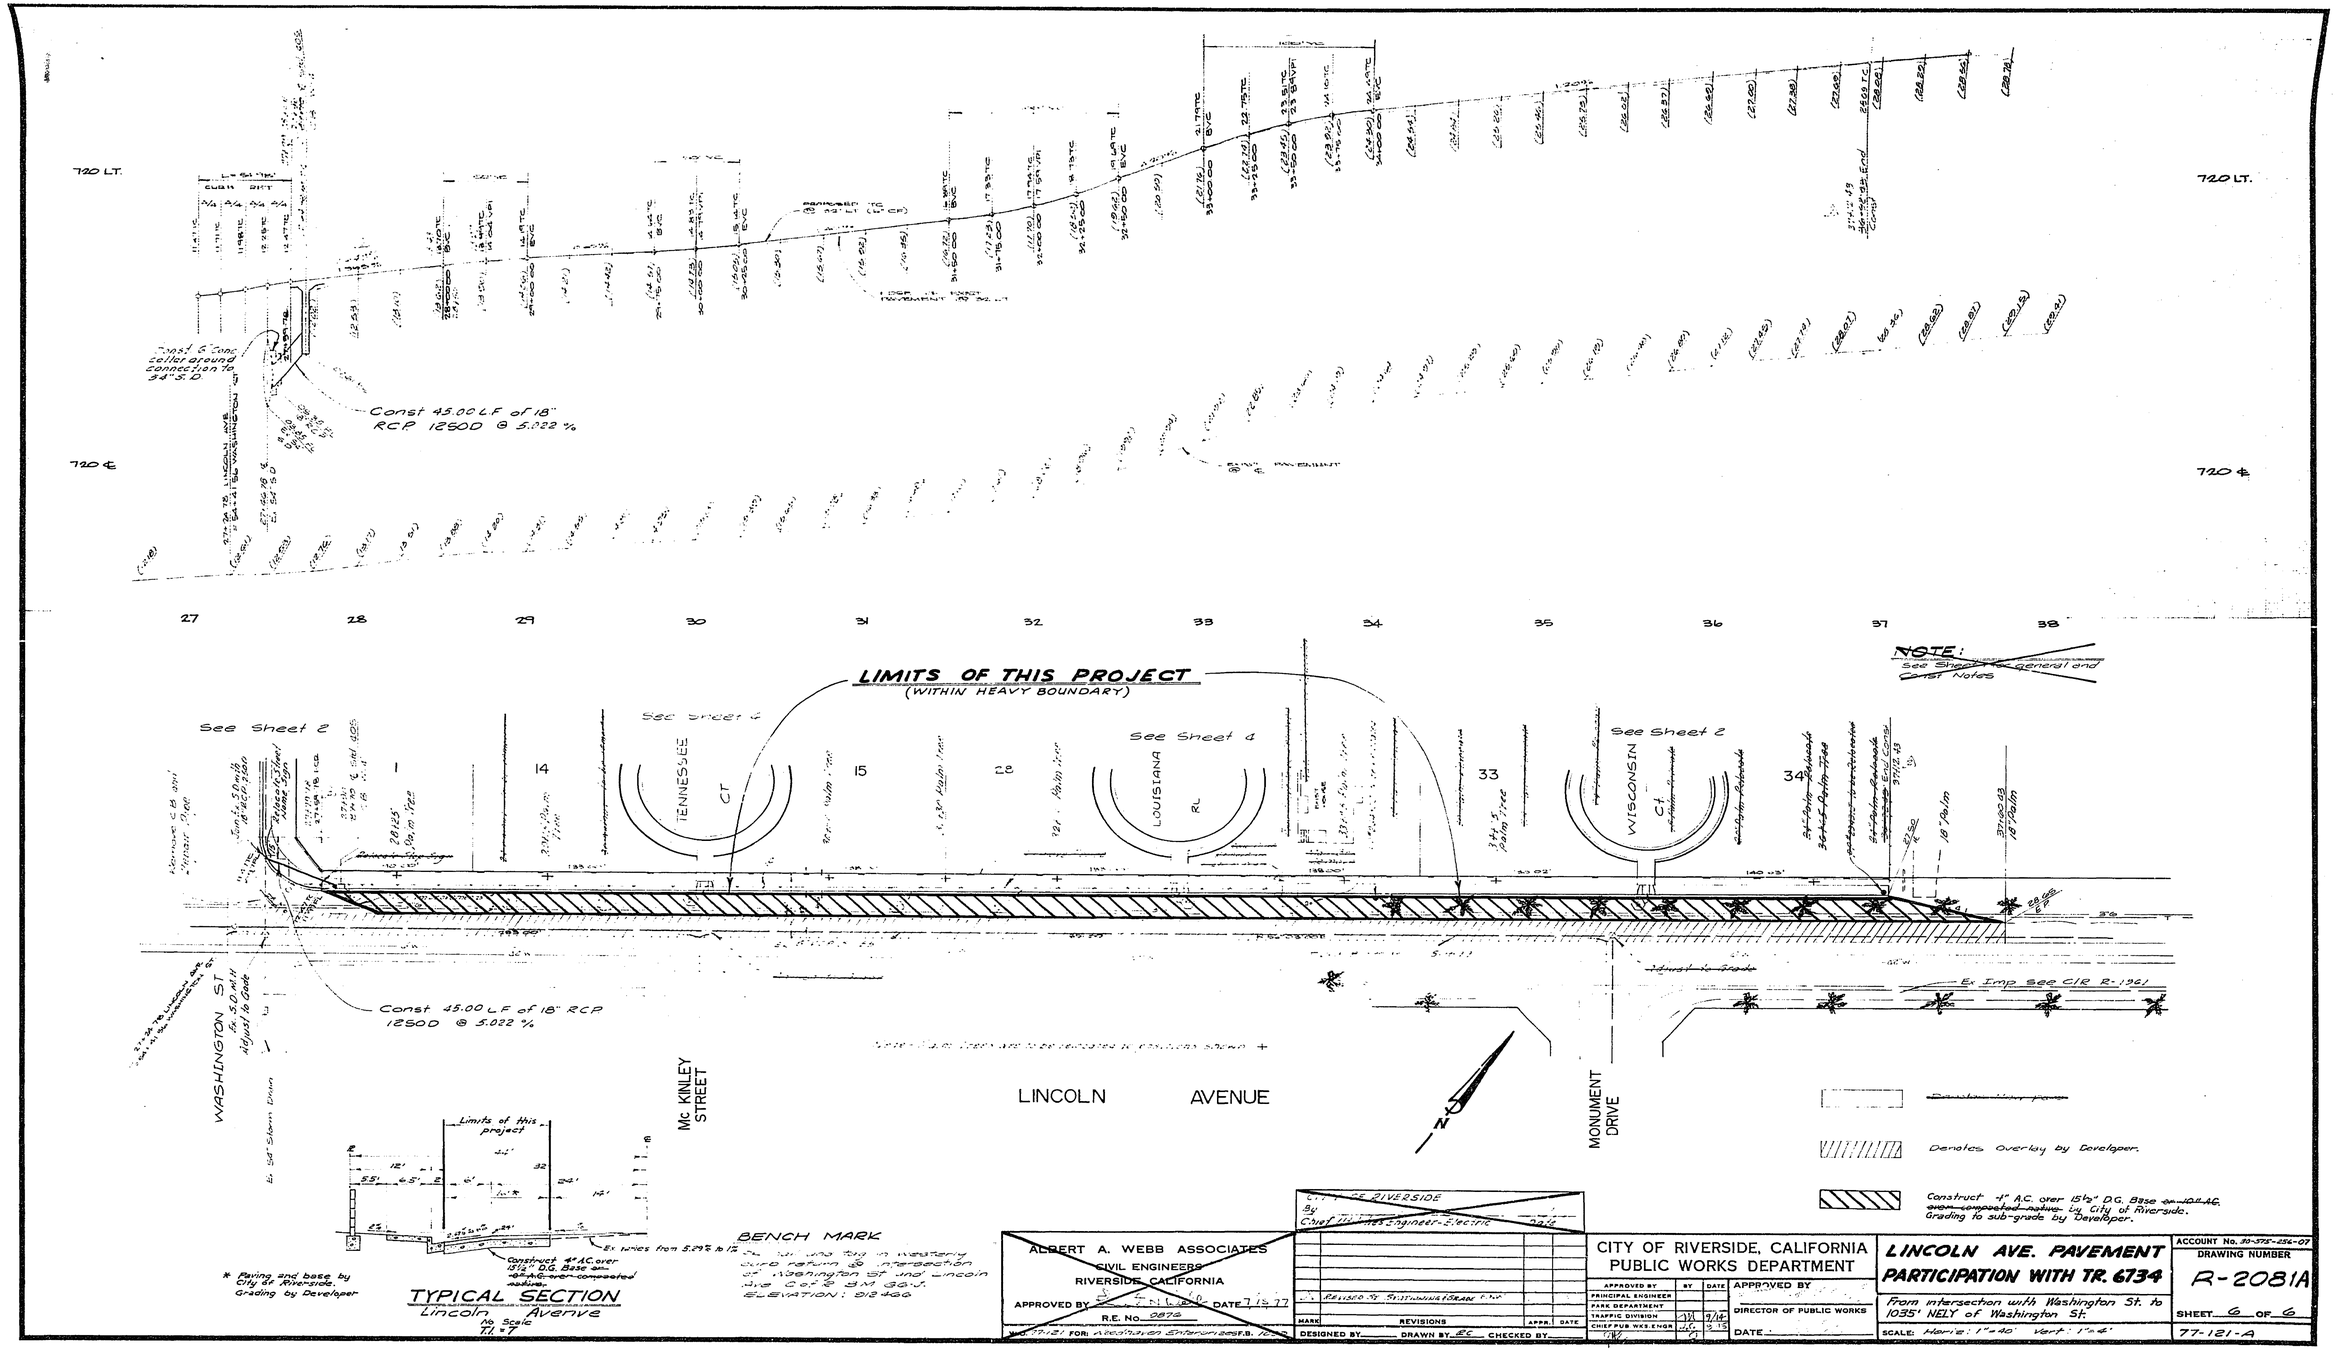

ALBERT A. WEBB ASSOCIATES
CIVIL ENGINEERS
RIVERSIDE, CALIFORNIA
APPROVED BY [signature] DATE 7/15/77
R.E. No. 9876
W.O. 77-121 FOR: Woodhaven Enterprises F.B. 10-[illegible]

CITY OF RIVERSIDE
By
Chief Utilities Engineer-Electric Date

MARK	REVISIONS	APPR.	DATE
	Revised St. Stationing & Grade Fwy		

DESIGNED BY ____ DRAWN BY EC CHECKED BY ____

CITY OF RIVERSIDE, CALIFORNIA
PUBLIC WORKS DEPARTMENT

APPROVED BY	BY	DATE
PRINCIPAL ENGINEER		
PARK DEPARTMENT		
TRAFFIC DIVISION	[illegible]	9/14
CHIEF PUB WKS. ENGR.	[illegible]	9/15

APPROVED BY
DIRECTOR OF PUBLIC WORKS
DATE

LINCOLN AVE. PAVEMENT PARTICIPATION WITH TR. 6734

From intersection with Washington St. to 1035' NELY of Washington St.

SCALE: Horiz: 1"=40' Vert: 1"=4'

ACCOUNT No. 30-575-256-07
DRAWING NUMBER
R-2081A
SHEET 6 OF 6
77-121-A