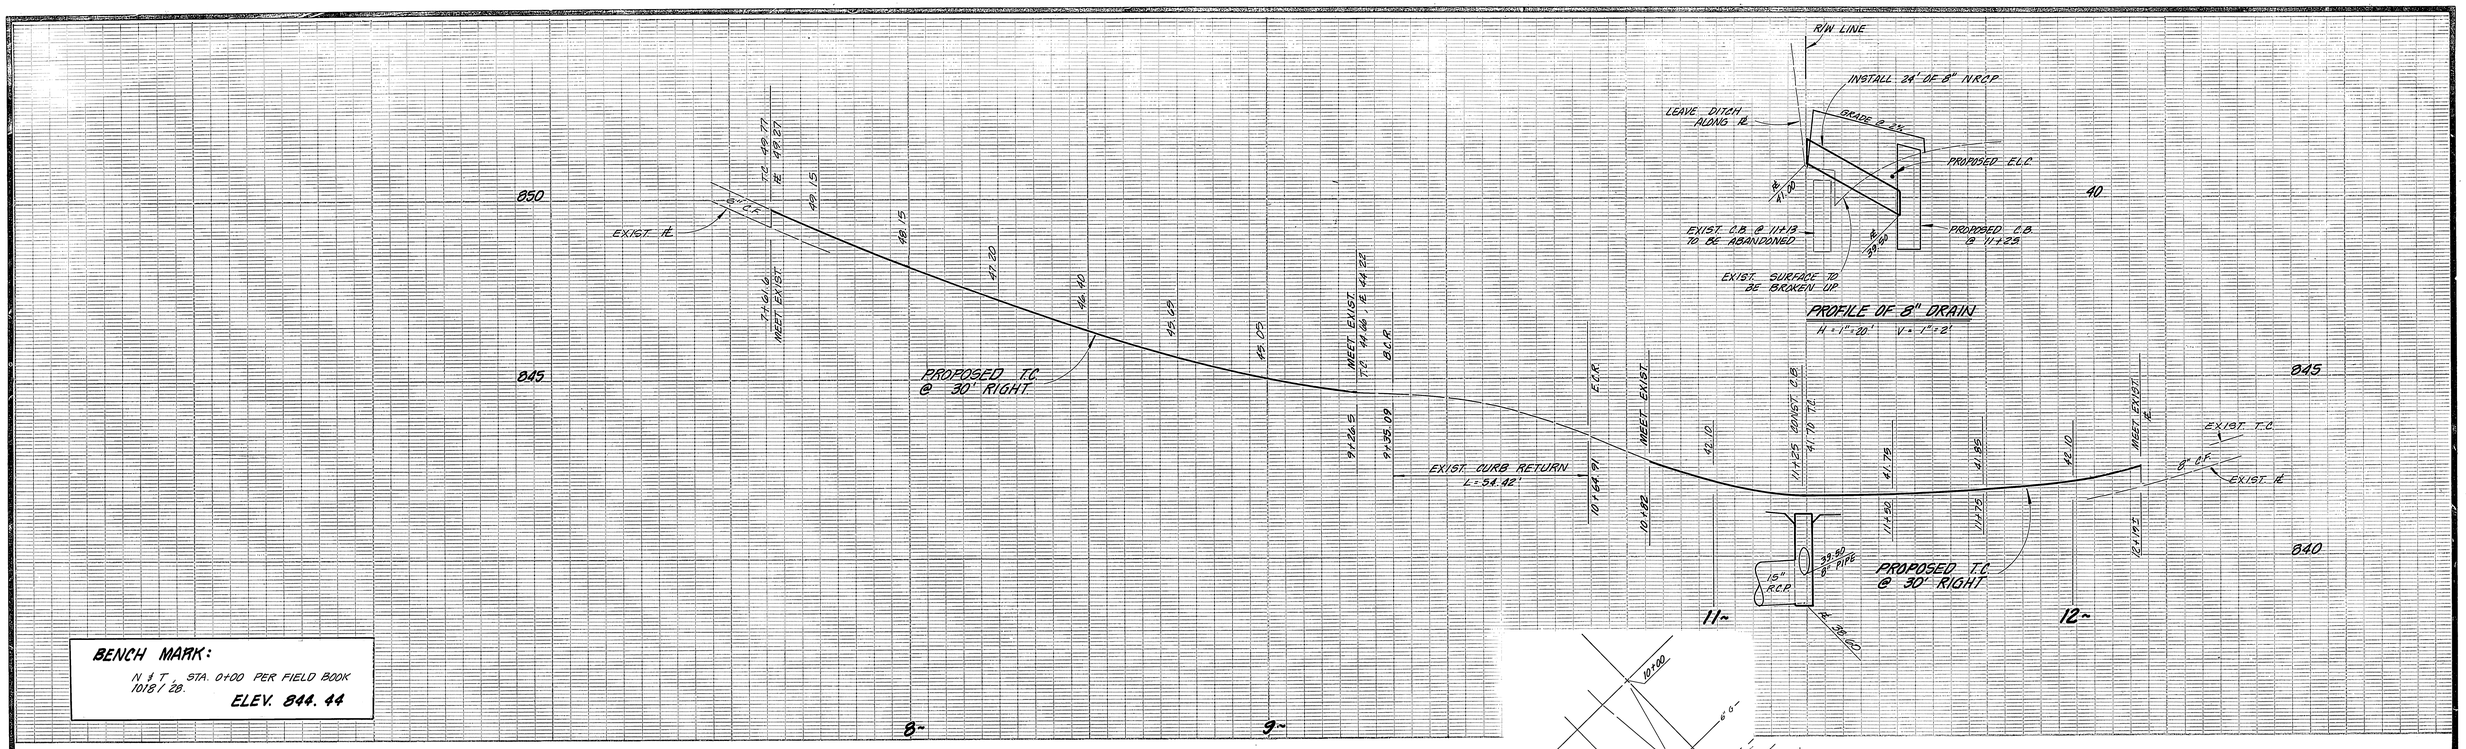

BENCH MARK:

N & T STA. 0+00 PER FIELD BOOK 1018 / '20.

ELEV. 844.44

GENERAL NOTES:

1. CONSTRUCTION SHALL BE IN ACCORDANCE WITH THE CITY OF RIVERSIDE, STANDARD DRAWINGS & STANDARD SPECIFICATIONS FOR PUBLIC WORKS CONSTRUCTION, 1982 EDITION.
2. INSTALL & RELOCATE STREET LIGHT FACILITIES AS SHOWN & IN CONFORMANCE WITH ST. LT. SPEC. 119 & STANDARD DRAWINGS.

CONSTRUCTION NOTES:

(200) – CONSTRUCT CURB & GUTTER PER STD. DWG. NO. 200, 6" C.F.

(302) – CONSTRUCT DWY. APPROACH PER STD. DWG. NO. 302, MODIFIED ON PLAN.

(325) – CONSTRUCT CONCRETE SIDEWALK PER STD. DWG. NO. 325.

(405) – CONSTRUCT CATCH BASIN PER STD. DWG. NO. 405. V = 3', N = 4'

(SL 1) – INSTALL 1" RIGID GALVANIZED STEEL ST. LT. CONDUIT W/ 2 #8 C.U. 600 V CABLES.

(SL 2) – INSTALL ST. LT. PULLBOX PER ITEM P1. OF UGS.-800.

(SL 3) – RELOCATE ST. LT. TO NEW FOUNDATION SIMILAR TO ITEM S-4 OF UGS-801. FIELD DETERMINE BOLT CIRCLE DIMENSIONS.

(SL 4) – ABAND. EXIST. ST. LT. FACILITIES NOT UTILIZED BETWEEN NEW PULLBOXES.

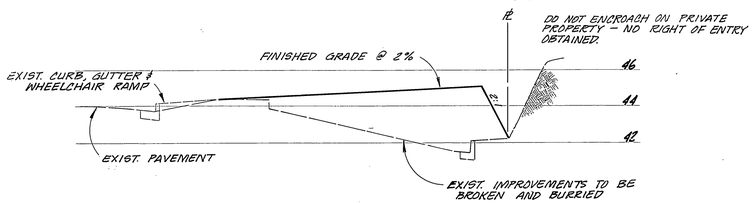

SECTION A-A

SCALE: H-1" = 10', V-1" = 2'

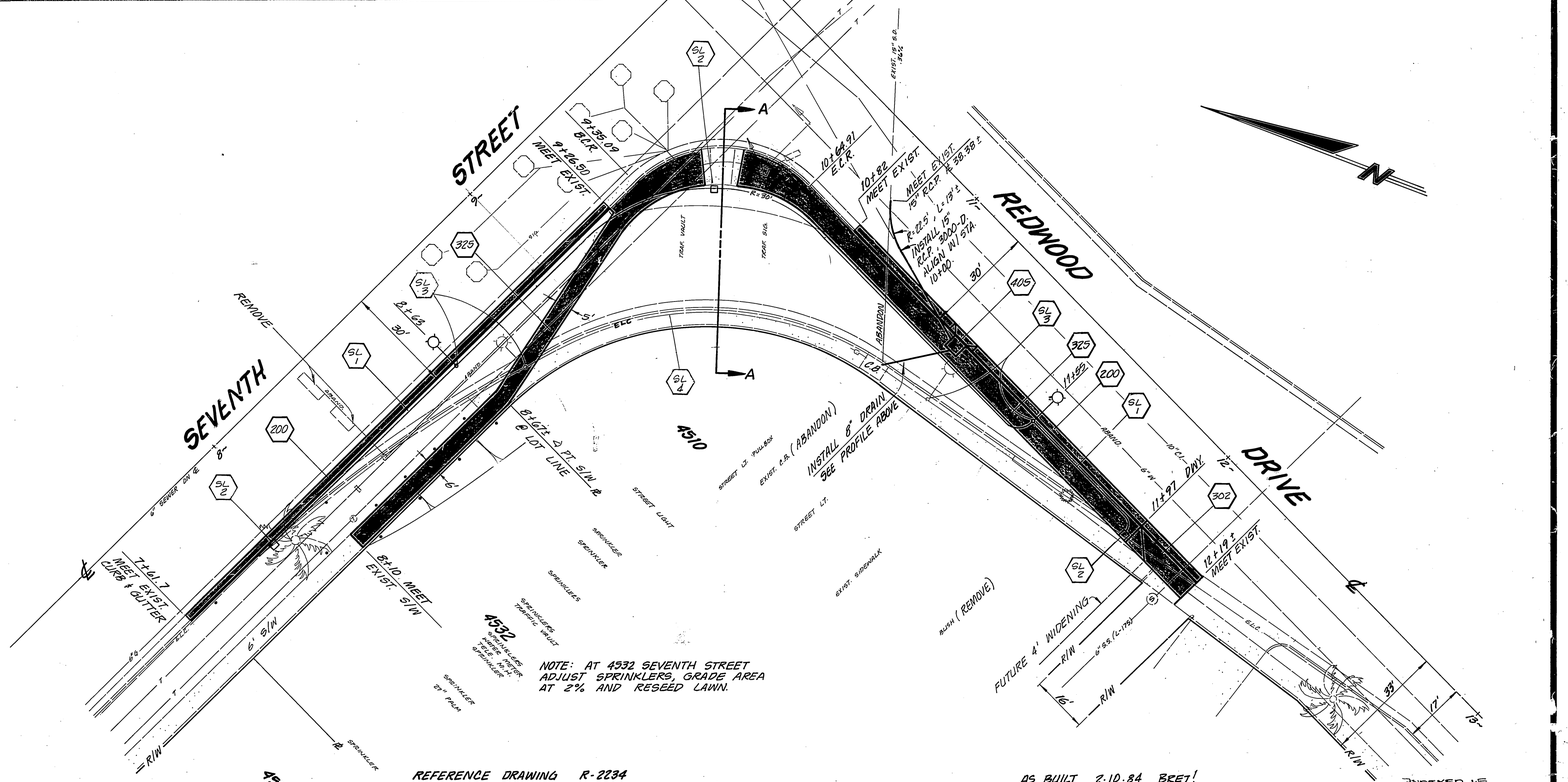

REFERENCE DRAWING R-2234

AS BUILT 2.10.84 BRET!

INDEXED W

CITY OF RIVERSIDE
OVERHEAD & UNDERGROUND
CHIEF UTILITIES ENG. - ELECTRIC
12/7/82 DATE

MARK	REVISIONS	APPR.	DATE

DESIGNED BY [illegible] DRAWN BY BRET! CHECKED BY

CITY OF RIVERSIDE
PUBLIC WORKS DEPARTMENT

	APPROVED BY	DATE	BY
PRINCIPAL ENGINEER		11/17/82	
PUB ELECTRIC		11/16/82	
TRAFFIC DIVISION		11/17/82	
CHIEF P. W. ENGINEER		11/18/82	

APPROVED BY
William D. Bradshaw
CITY PUBLIC WORKS DIRECTOR
DATE 11-30-82

REDWOOD & SEVENTH STREETS
PERMANENT ELIMINATION OF THE RIGHT TURN LANE

S. W'LY CORNER OF REDWOOD DRIVE AND SEVENTH STREET.

HORIZ. SCALE: 1" = 20' VERT. SCALE: 1" = 2'

ACCOUNT NO. 30-575-201-07

R-2480

SHEET 1 OF 1

ORFB: LL.# PGS. 1-4