


PROPERTY OF CITY OF RIVERSIDE DEPT. OF PUBLIC WORKS ENGINEERING DIVISION

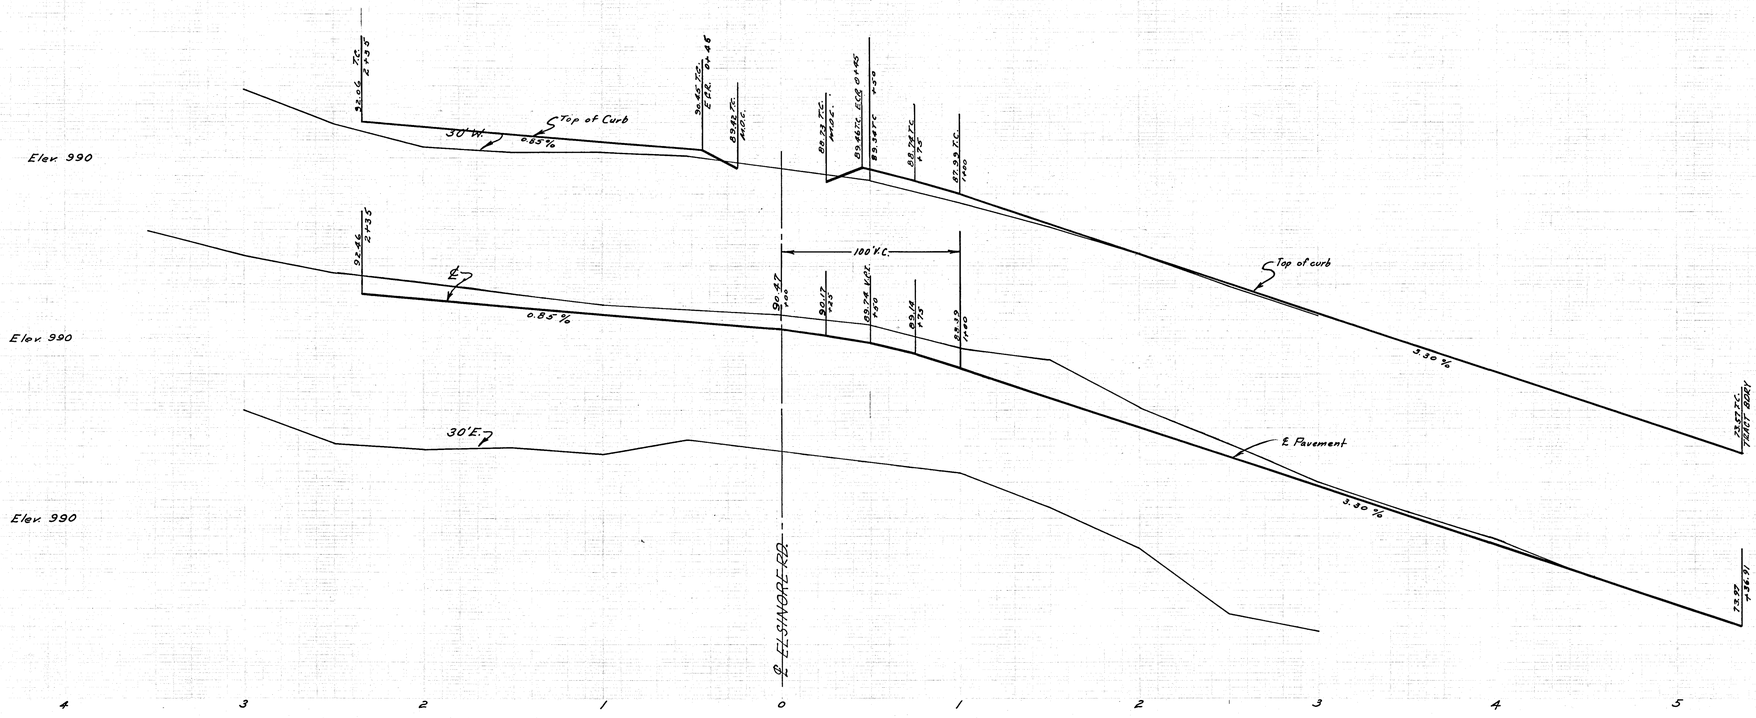


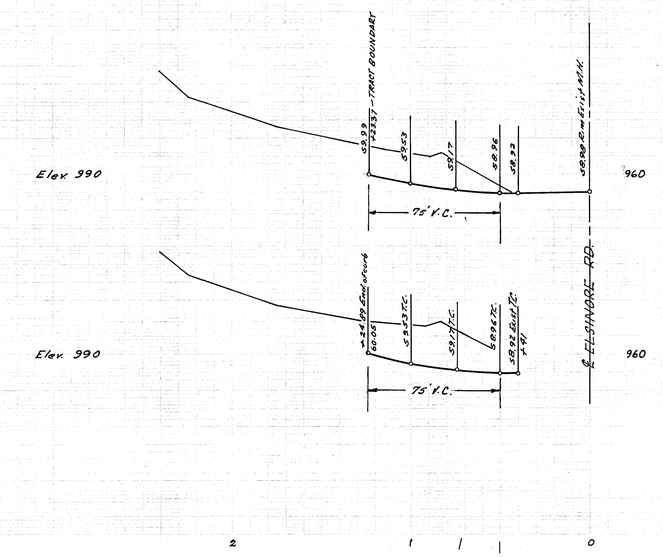


BENCH MARKS

City B.M.	Lead & Spk. in W. side Victoria Bridge at South end.	El. 903.03	FB - 540-13 504-77
T.B.M. (4)	Spike in P.Pole No. 17-136.26 J at Station 25+28 Elsinore Road.	El. 960.95	
T.B.M.	Top of Weir, 7' Ely. Station 01+47.69 on Flintridge Court.	El. 984.61	
T.B.M.	R.R. Spk. in P.Pole No. 1947 J on S.E. Cor. Kansas & Arroyo Dr.	El. 978.35	

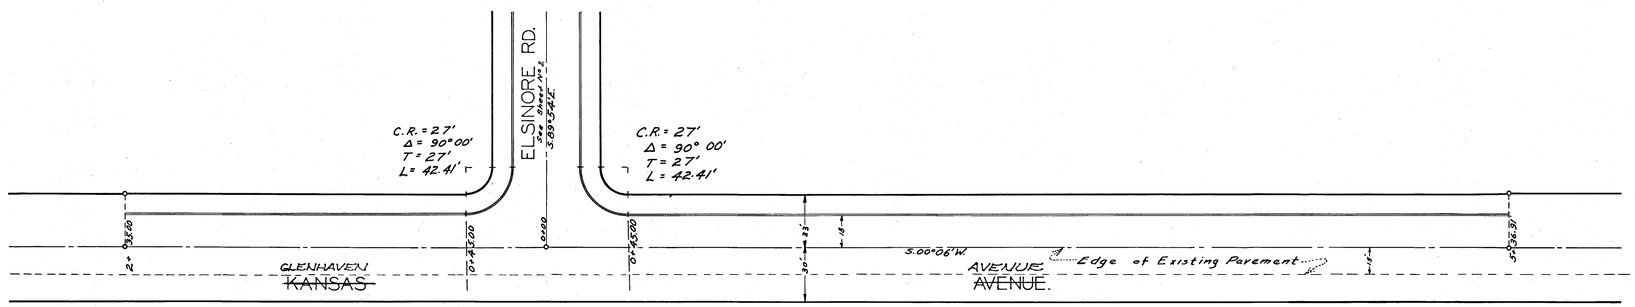

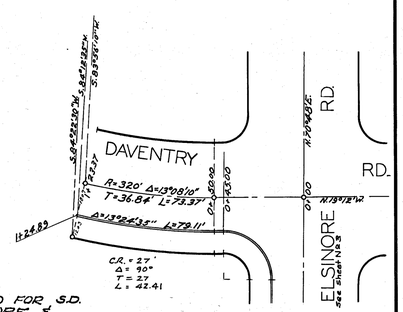

SEE D-150 FOR S.D. ON ELSINORE & GLENHAVEN

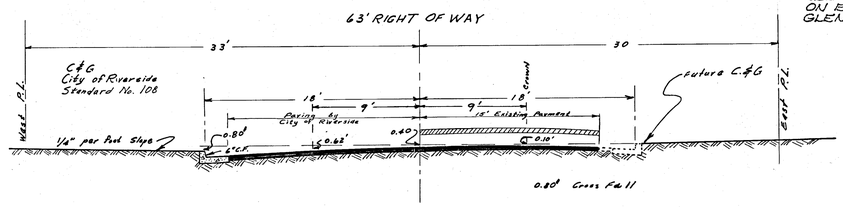

TYPICAL ROAD SECTION FOR KANSAS AVE.
SCALE: 1" = 6'-0"

J.F. DAVIDSON - CIVIL ENGINEER
R.E. No. 862
RIVERSIDE, CALIFORNIA
APPROVED BY J.F. Davidson 2-8-56

CITY OF RIVERSIDE, CALIFORNIA
DEPARTMENT OF PUBLIC WORKS

STREET PLAN & PROFILE
GLENHAVEN ~~KANSAS~~ AVE & DAVENTRY ROAD

VICTORIA GROVES #7

HORIZ. SCALE 1"=40' VERT. SCALE 1"=4'

J.F. Martinek
Director of Public Works
DATE 3-6-56

NO. R-31
SHEET 1 OF 4

PROPERTY OF CITY OF RIVERSIDE DEPT. OF PUBLIC WORKS ENGINEERING DIVISION


PROPERTY OF CITY OF RIVERSIDE DEPT. OF PUBLIC WORKS ENGINEERING DIVISION


INDEXED 1956

PROPERTY OF
CITY OF RIVERSIDE
DEPT. OF PUBLIC WORKS
ENGINEERING DIVISION

R-31

PROPERTY OF
CITY OF RIVERSIDE
DEPT. OF PUBLIC WORKS
ENGINEERING DIVISION

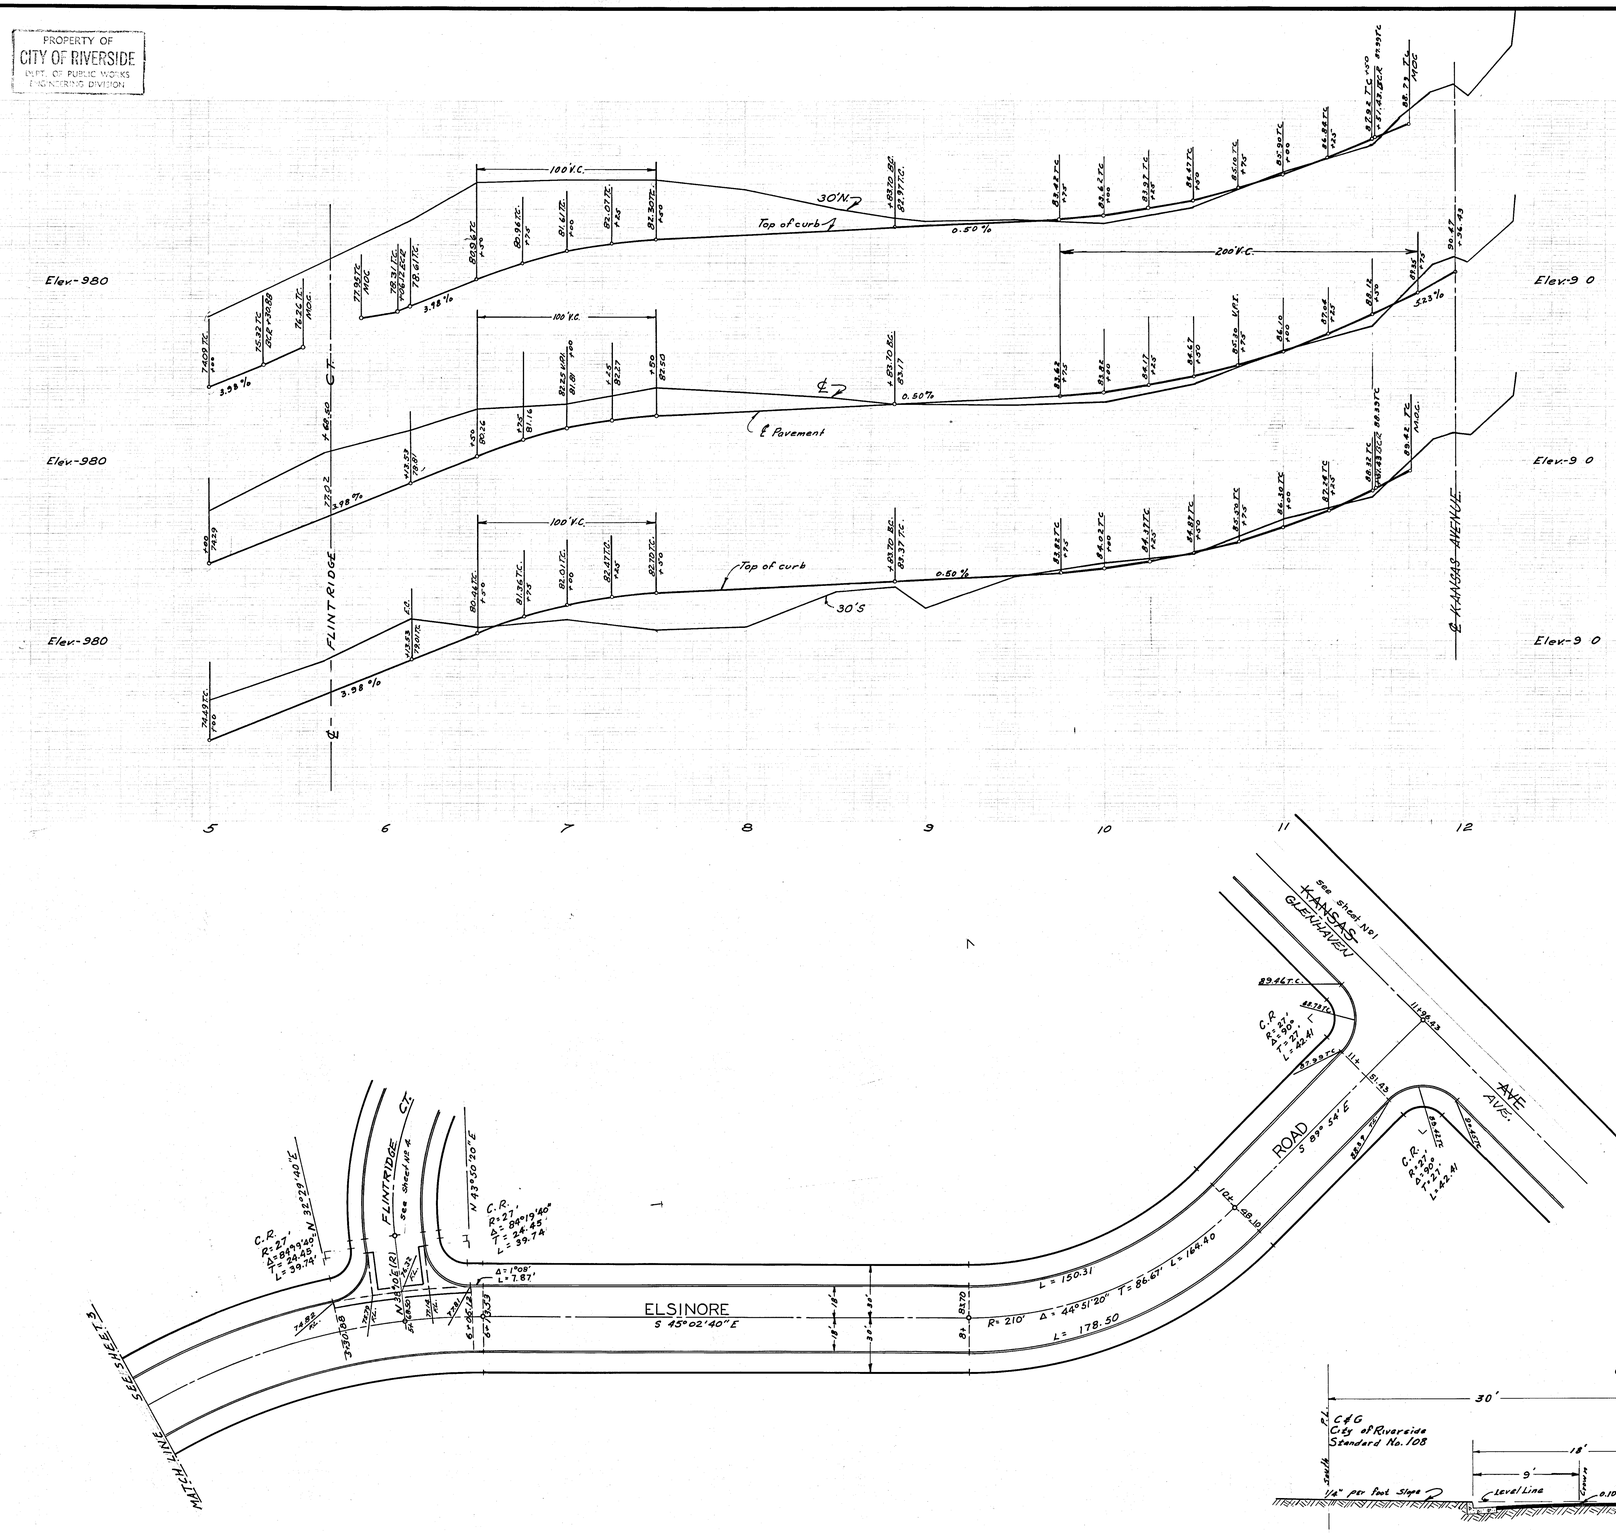

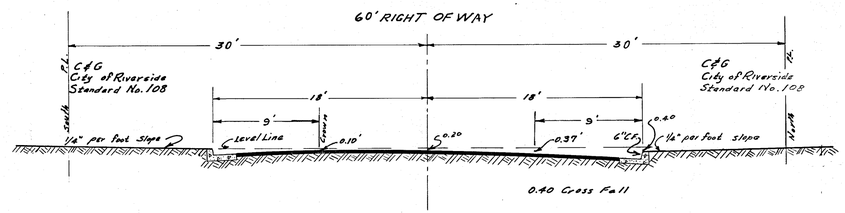

TYPICAL ROAD SECTION
FOR ELSINORE ROAD
SCALE: 1"= 6'-0"

SEE D-150 FOR S.D. ALONG ELSINORE RD. & GLENHAVEN

PROPERTY OF
CITY OF RIVERSIDE
DEPT. OF PUBLIC WORKS
ENGINEERING DIVISION

PROPERTY OF
CITY OF RIVERSIDE
DEPT. OF PUBLIC WORKS
ENGINEERING DIVISION

J.F. DAVIDSON-CIVIL ENGINEER
R.E. No. 962
RIVERSIDE, CALIFORNIA
APPROVED BY J.F. Davidson DATE 2-8-56

CITY OF RIVERSIDE, CALIFORNIA
DEPARTMENT OF PUBLIC WORKS
STREET PLAN & PROFILE
ELSINORE ROAD
VICTORIA GROVES #7
HORIZ. SCALE 1"=40' VERT. SCALE 1"=4'
ACTING CITY ENGINEER J.F. Mattinek
DIRECTOR OF PUBLIC WORKS
DATE 3-6-56
NO. R-31
SHEET 2 OF 4

INDEXED 1956


R-31

R-31

PROPERTY OF
CITY OF RIVERSIDE
DEPT. OF PUBLIC WORKS
ENGINEERING DIVISION

R-31


PROPERTY OF
CITY OF RIVERSIDE
DEPT. OF PUBLIC WORKS
ENGINEERING DIVISION

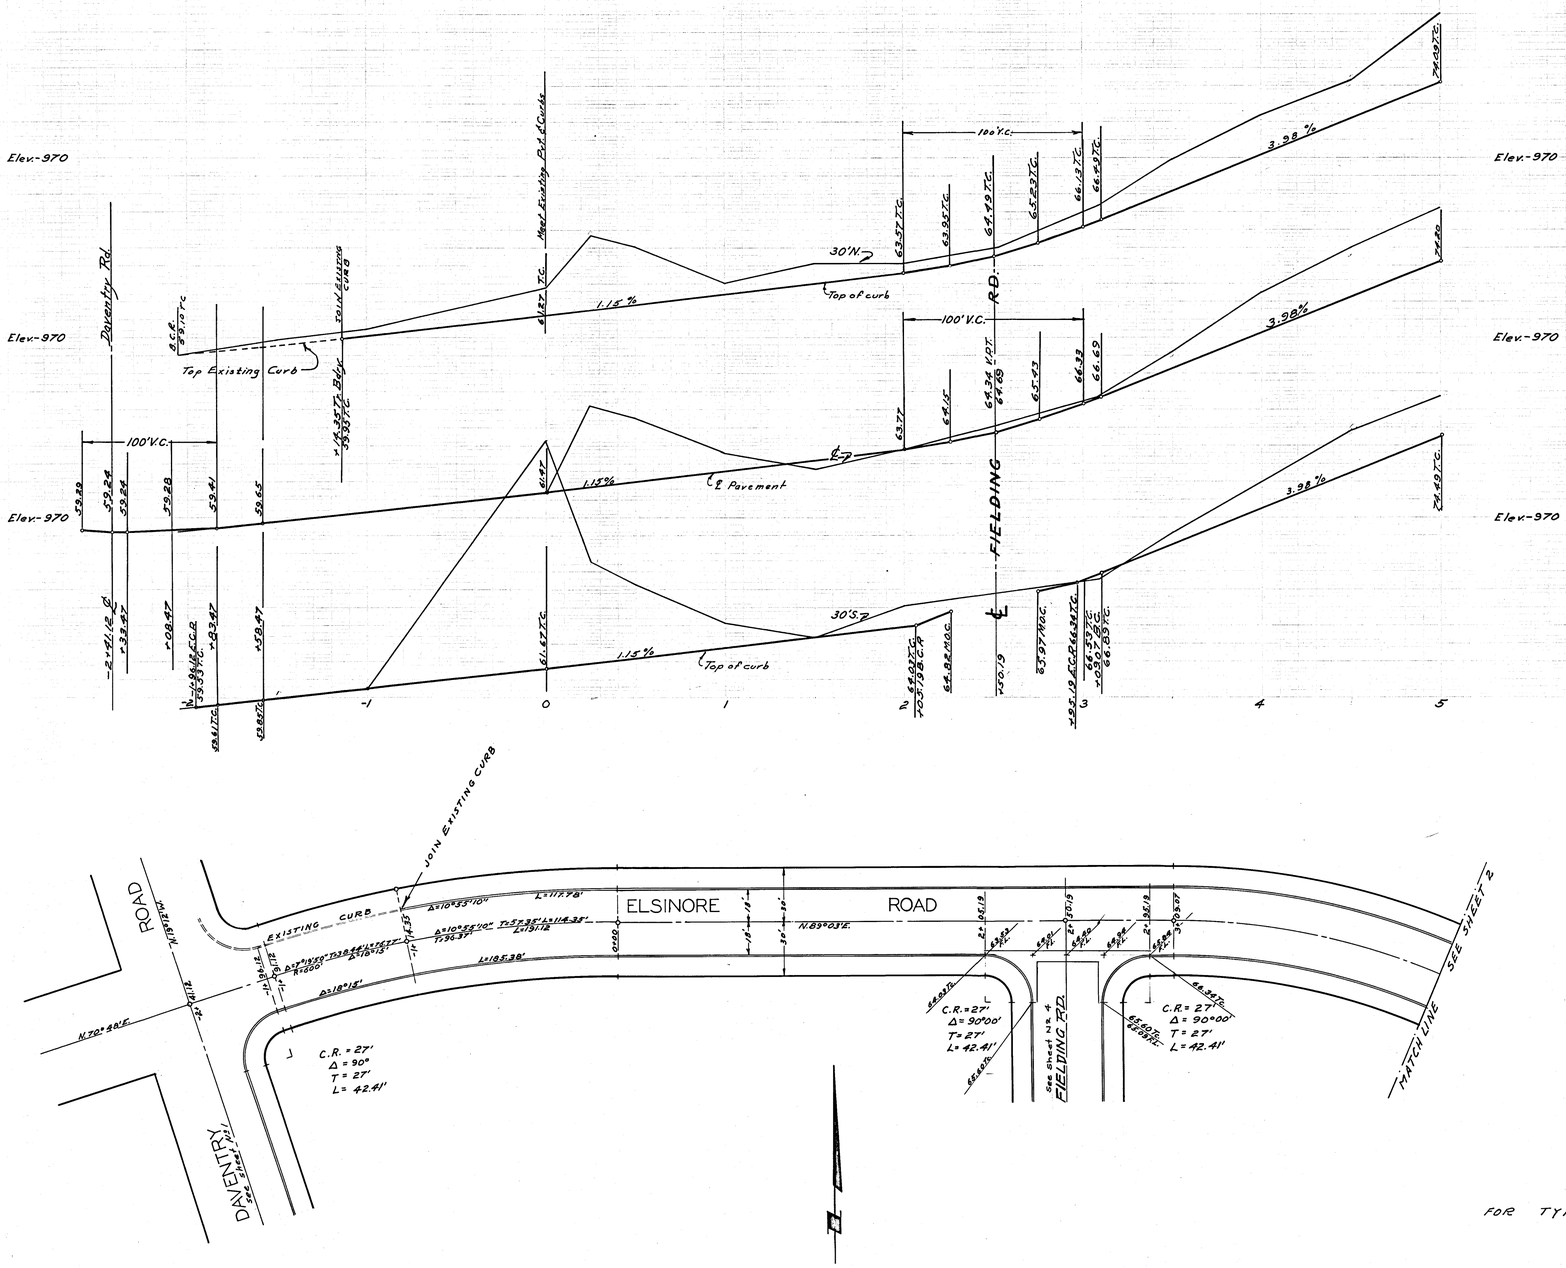

Elev-970
Elev-970
Elev-970
Elev-970
Elev-970
Elev-970
Daventry Rd.
Meet Existing Pvt. of Curbs
Top Existing Curb
14.35' T.C. Bldg.
100' V.C.
100' V.C.
30'N.
Top of curb
R.P.
1.15 %
3.98 %
3.98 %
3.98 %
1.15 %
1.15 %
1.15 %
℄ Pavement
30'S.
Top of curb
FIELDING
63.57 T.G.
63.85 T.G.
64.49 T.G.
65.29 T.G.
66.13 T.G.
66.49 T.G.
64.34
64.48
65.43
66.38
66.69
63.77
64.15
61.87
61.67
61.67 T.G.
64.02 T.G.
64.82 M.G.
63.97 M.G.
66.39 T.G.
66.78 T.G.
66.78 P.C.
59.88
59.24
59.24
59.28
59.41
59.65
58.47
58.47
58.47

PROPERTY OF
CITY OF RIVERSIDE
DEPT. OF PUBLIC WORKS
ENGINEERING DIVISION

R-31

PROPERTY OF
CITY OF RIVERSIDE
DEPT. OF PUBLIC WORKS
ENGINEERING DIVISION

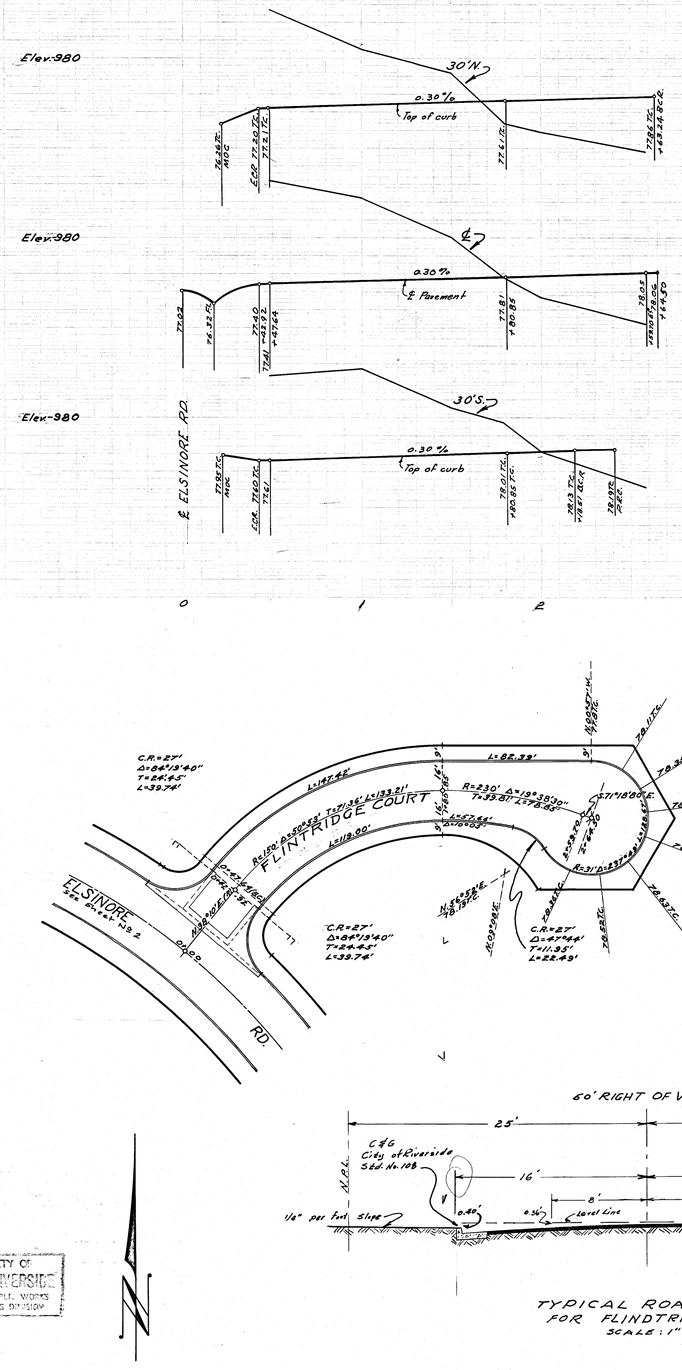


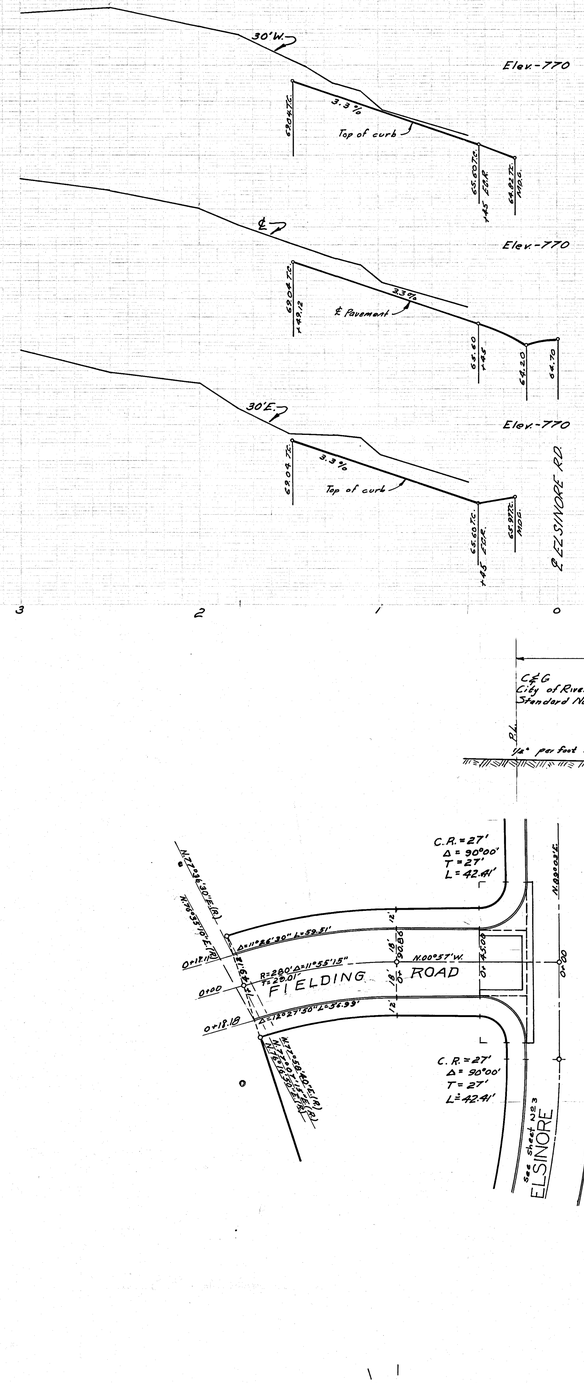

0 1 2 3 3 2 1 0

F.B. 504-72

TYPICAL ROAD SECTION
FOR FLINDTRIDGE COURT
SCALE: 1"=6'-0"

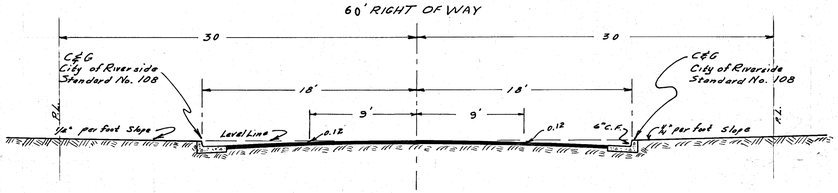

TYPICAL ROAD SECTION
FOR FIELDING ROAD
SCALE 1"=6'-0"

SEE D-150 FOR S.D. ALONG
ELSINORE RD.

J.F. DAVIDSON-CIVIL ENGINEER
REG. No. 862
RIVERSIDE, CALIFORNIA
APPROVED BY J.F. Davidson DATE 2-8-56

CITY OF RIVERSIDE, CALIFORNIA
DEPARTMENT OF PUBLIC WORKS

STREET PLANS PROFILE

FLINTRIDGE COURT &
FIELDING ROAD
VICTORIA GROVES #7

HORIZ. SCALE 1"= 40' VERT. SCALE 1"= 4'

Director of Public Works
DATE 3-6-56

NO. R-31
SHEET 4 OF 4

PROPERTY OF
CITY OF RIVERSIDE
DEPT. OF PUBLIC WORKS
ENGINEERING DIVISION

PROPERTY OF
CITY OF RIVERSIDE
DEPT. OF PUBLIC WORKS
ENGINEERING DIVISION

INDEXED 1956

R-31