
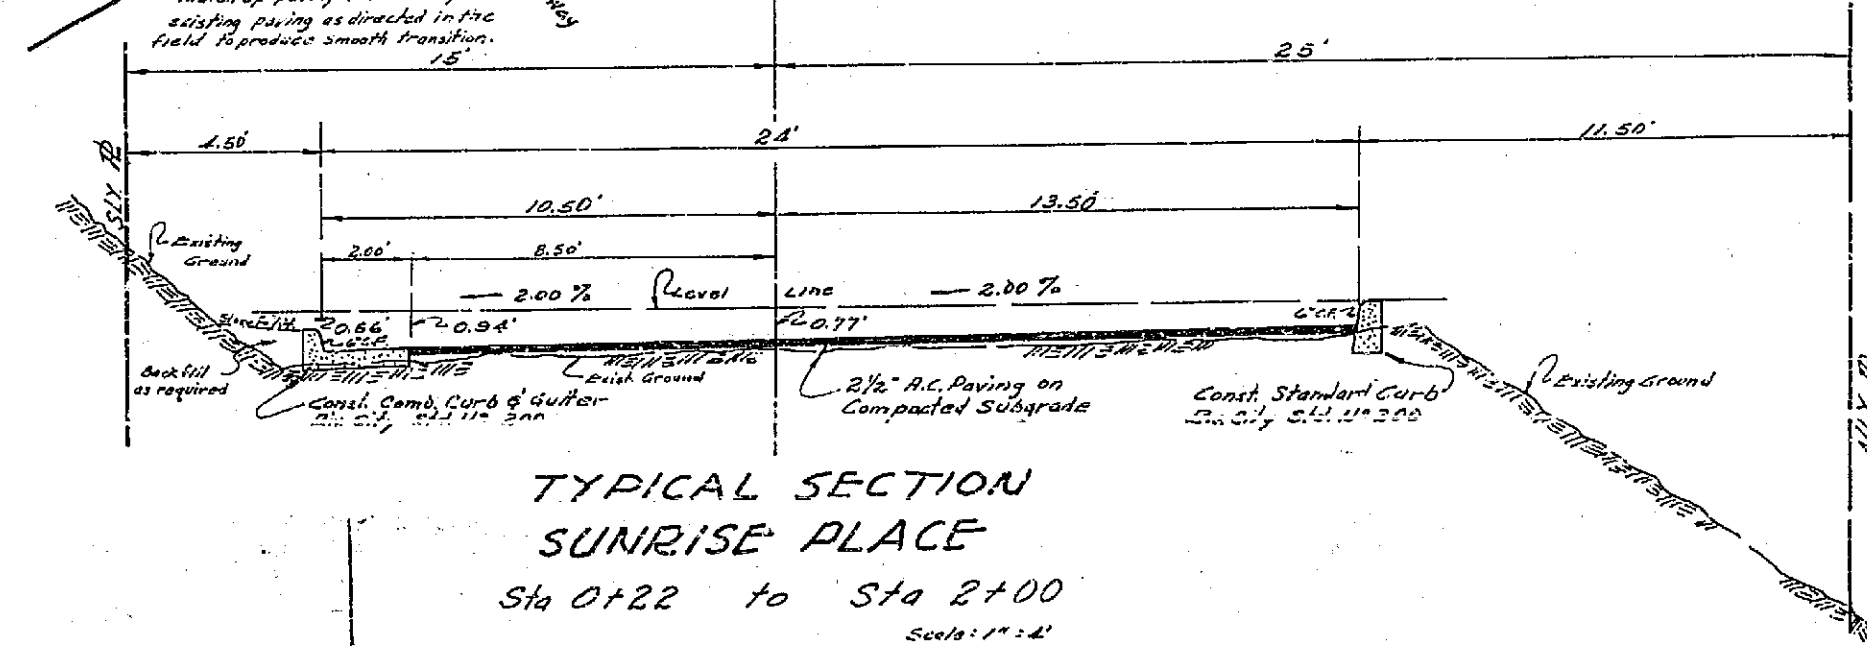


- GENERAL NOTES**
- All construction shall be in accordance with Standards and Specifications No. 461 of the City of Riverside Department of Public Works.
 - It shall be the responsibility of the Contractor to clear the Right of Way in accordance with the provisions of law as it affects each utility including irrigation lines and appurtenances, and at no extra cost to the City of Riverside.
 - The City of Riverside will take a soil test to determine the imported base material thickness after the street has been rough graded.
- BENCH MARK:**
 T.B.M. "B" (Elev. City Plan "R-341")
 4" Top NIS Plunge on the hydrant on Sunset Drive Near Ely and Parcel 2, R.S. 28/55
 Elev. 1043.43
 T.B.M. Top 3/4" of South Easly Corner Parcel 5, R.S. 28/55.
 Elev. 1113.22

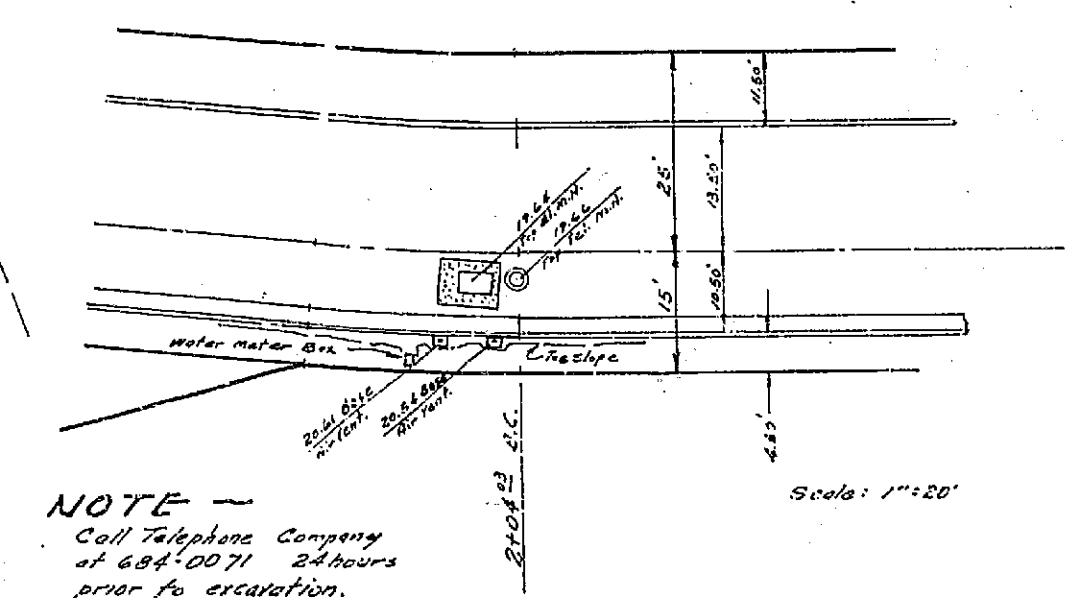

REVISIONS	
MARK	DATE
①	6-8-68
	Increase both curbs from 12" to 18" in height. Approved by Director of Public Works.

J. F. DAVIDSON - CIVIL ENGINEER
 R.E. NO. 862
 RIVERSIDE, CALIFORNIA
 APPROVED BY *J. F. Davidson* DATE 7-6-67

CITY OF RIVERSIDE, CALIFORNIA
 DEPARTMENT OF PUBLIC WORKS

STREET PLAN & PROFILE
SUNRISE PLACE
 RECORD OF SURVEY 28/55
 SCALE: AS SHOWN

DESIGNED BY
 DRAWN BY
 RECOMMENDED BY

CHECKED BY *Ron*
 100 V.O.S.

APPROVED BY *J. F. Davidson*
 Director of Public Works

DATE 1-14-63

NO. **R-650**
 SHEET 1 OF 1