

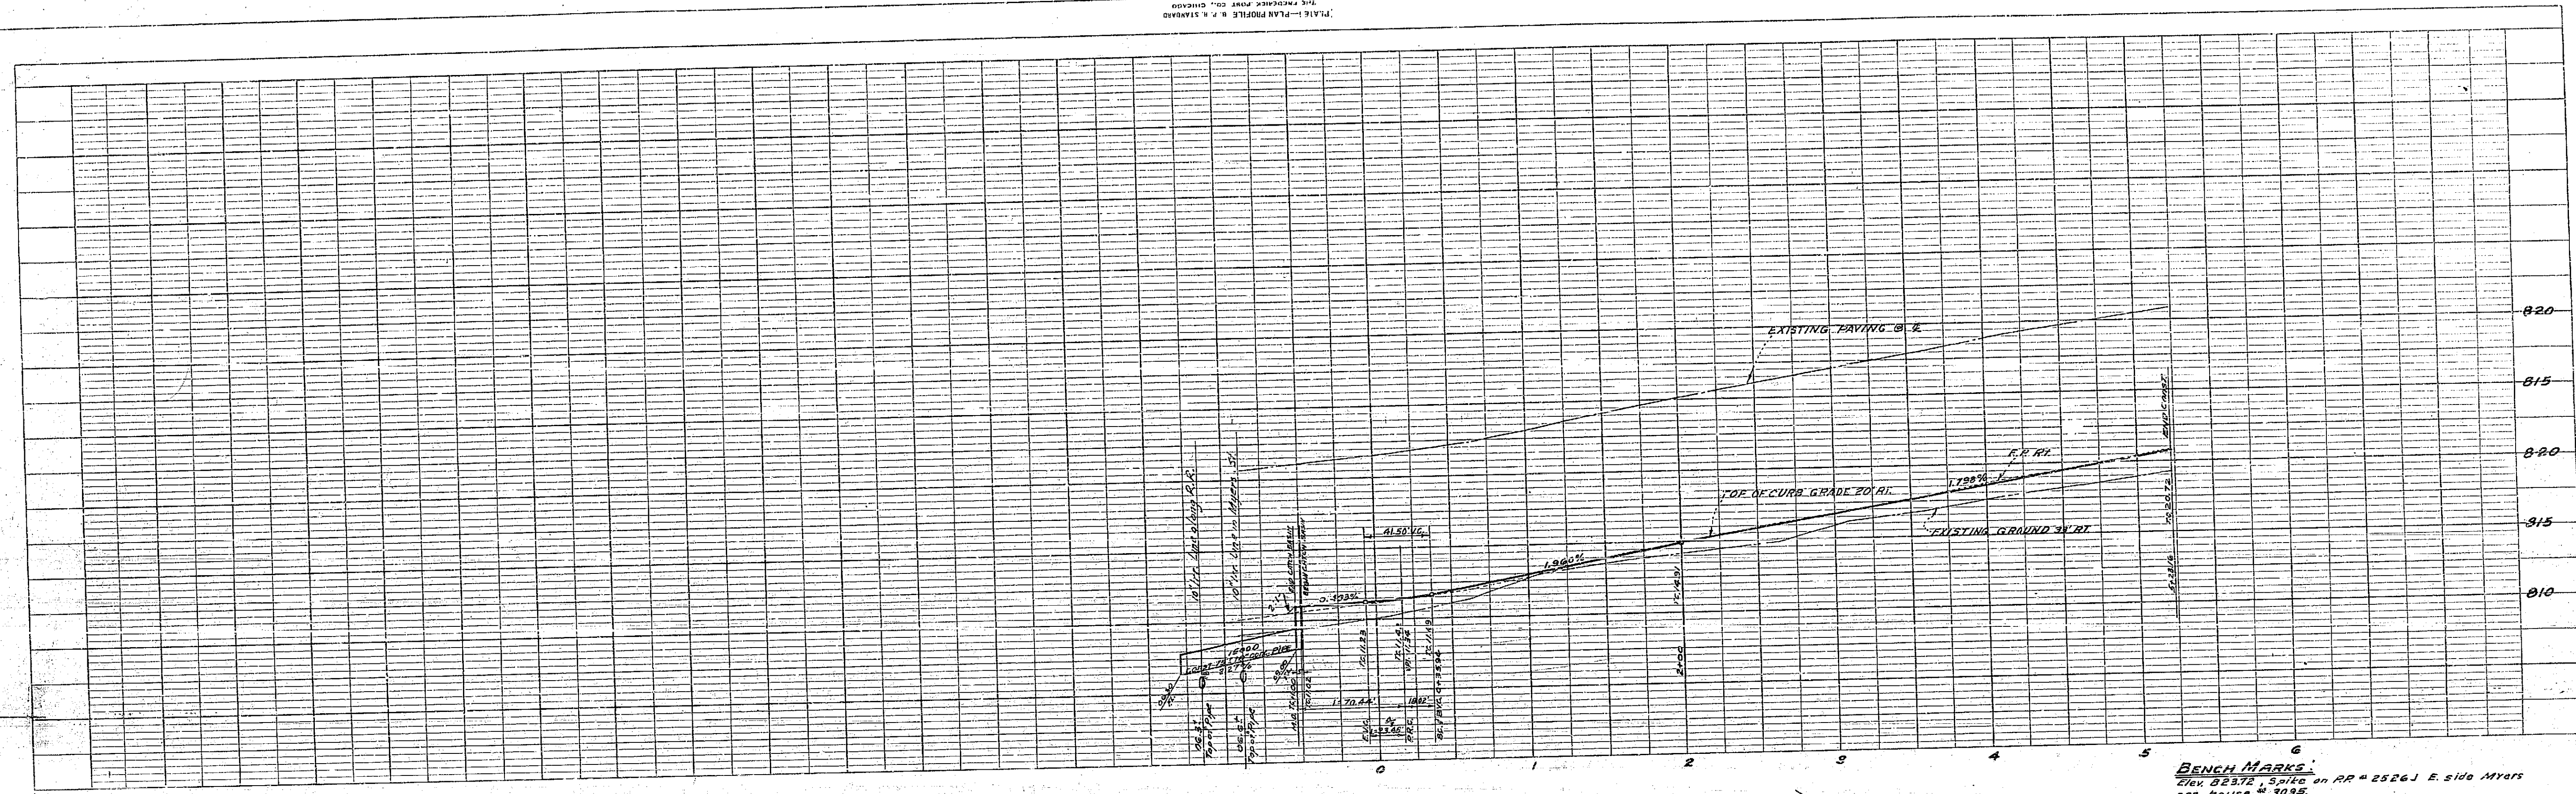


PROFILE	DATE


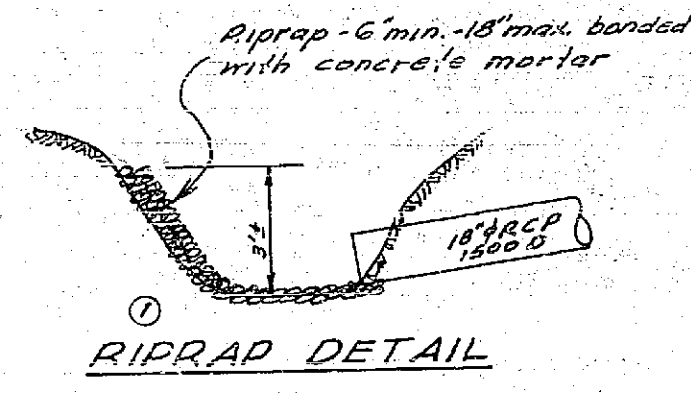


BENCH MARKS
Elev. 823.72, Spike on RR # 2526 J. E. side Myers
opp. House # 3035.
Elev. 821.67, Top of 3/4" I.R. North Cor. of Prop.

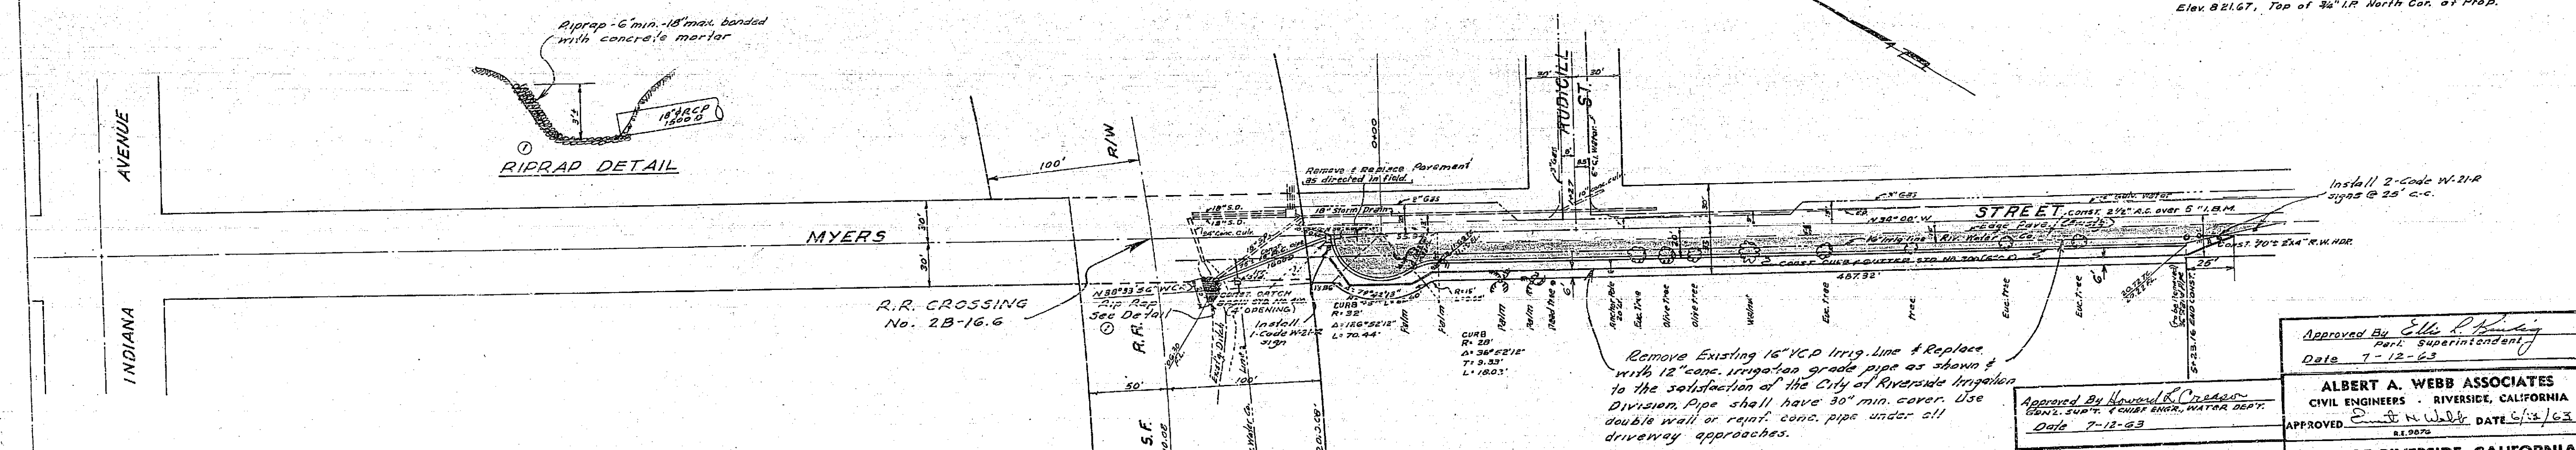

QUANTITY ESTIMATE

Standard 200 Curb & Gutter (C.C.R)	487 L.F.
2 1/2" AC Paving & Seal Coat	7676 S.F.
5" Imported Base Material	119 C.Y.
Standard 400 Catch Basin (4' Opening)	1 EA.
16" R.C.P. 15000	75' L.F.
2"x4" R.W. Hd.	10 EA.
Tree Removal	300' S.F.
Pavement Removal	3
W-21-R signs	605 L.F.
12" conc. irrig. grade pipe	

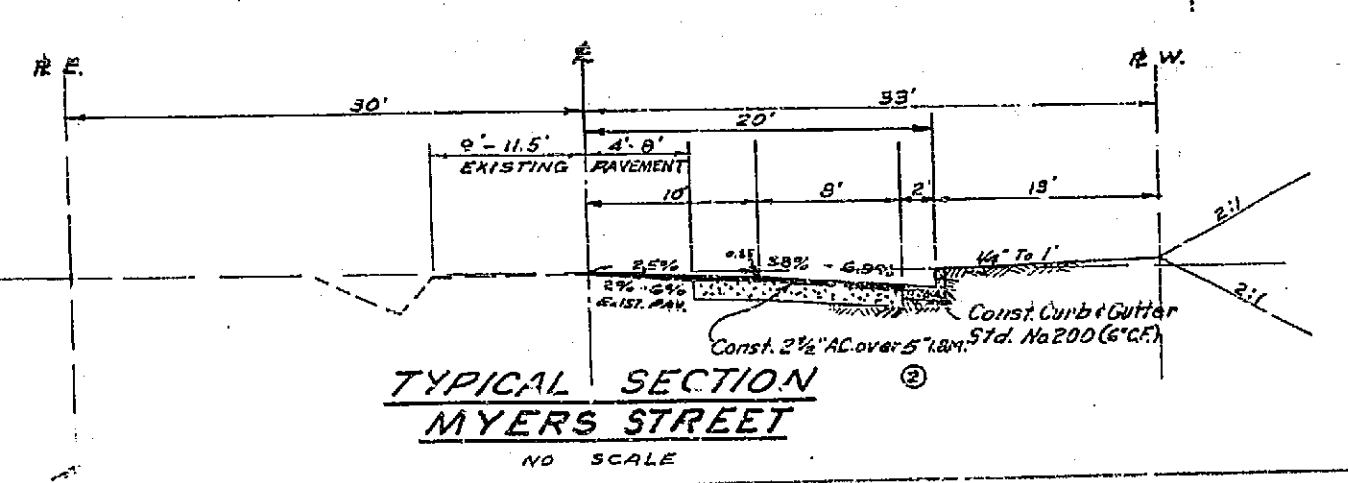

- GENERAL NOTES:**
1. It shall be the responsibility of the Contractor to clear the right of way in accordance with the provisions of law as it pertains to each utility, including irrigation lines and appurtenances and at no cost to the City.
 2. Construction shall be in accordance with the City of Riverside Department of Public Works Specifications No. 461 and Standard Drawings.
 3. Trim edge of existing paving where new paving joins existing pavement to clean straight line. Construct match-up paving as shown and overlay paving as directed in field to produce smooth crown section.
 4. Prime coat and paint binder are required.
 5. The City of Riverside will make a soil test to determine the requirement on imported base material after the streets have been prepared to rough grade.
 6. All trees in right of way to be removed.

Approved By *Howard B. Creager*
Gen'l. Supt. & Chief Engr., WATER DEPT.
Date 7-12-63

Approved By *Elli P. King*
Perk. Superintendent
Date 7-12-63

ALBERT A. WEBB ASSOCIATES
CIVIL ENGINEERS - RIVERSIDE, CALIFORNIA
APPROVED *Albert A. Webb* DATE 6/12/63
E.E. 0276

CITY OF RIVERSIDE, CALIFORNIA
DEPARTMENT OF PUBLIC WORKS

STREET PLAN & PROFILE

MYERS STREET
ZONING CASE R-65-622

REVISION	
MARK	DESCRIPTION
①	12-13-63 Curbs Added E.N.W. 133' @ 2'
②	7-2-68 Base Thickness Added E.N.W. 10' @ 2'

DATE	MAY 1963	SCALE	1" = 50'
DRAWN	B.E.L.	W.D.	63-117
CHECKED	Kon	P.B.	500/35-48

APPROVED BY *Albert A. Webb*
DIRECTOR OF PUBLIC WORKS
DATE 12-24-63
NO. R-709
SHEET 1 OF 1