
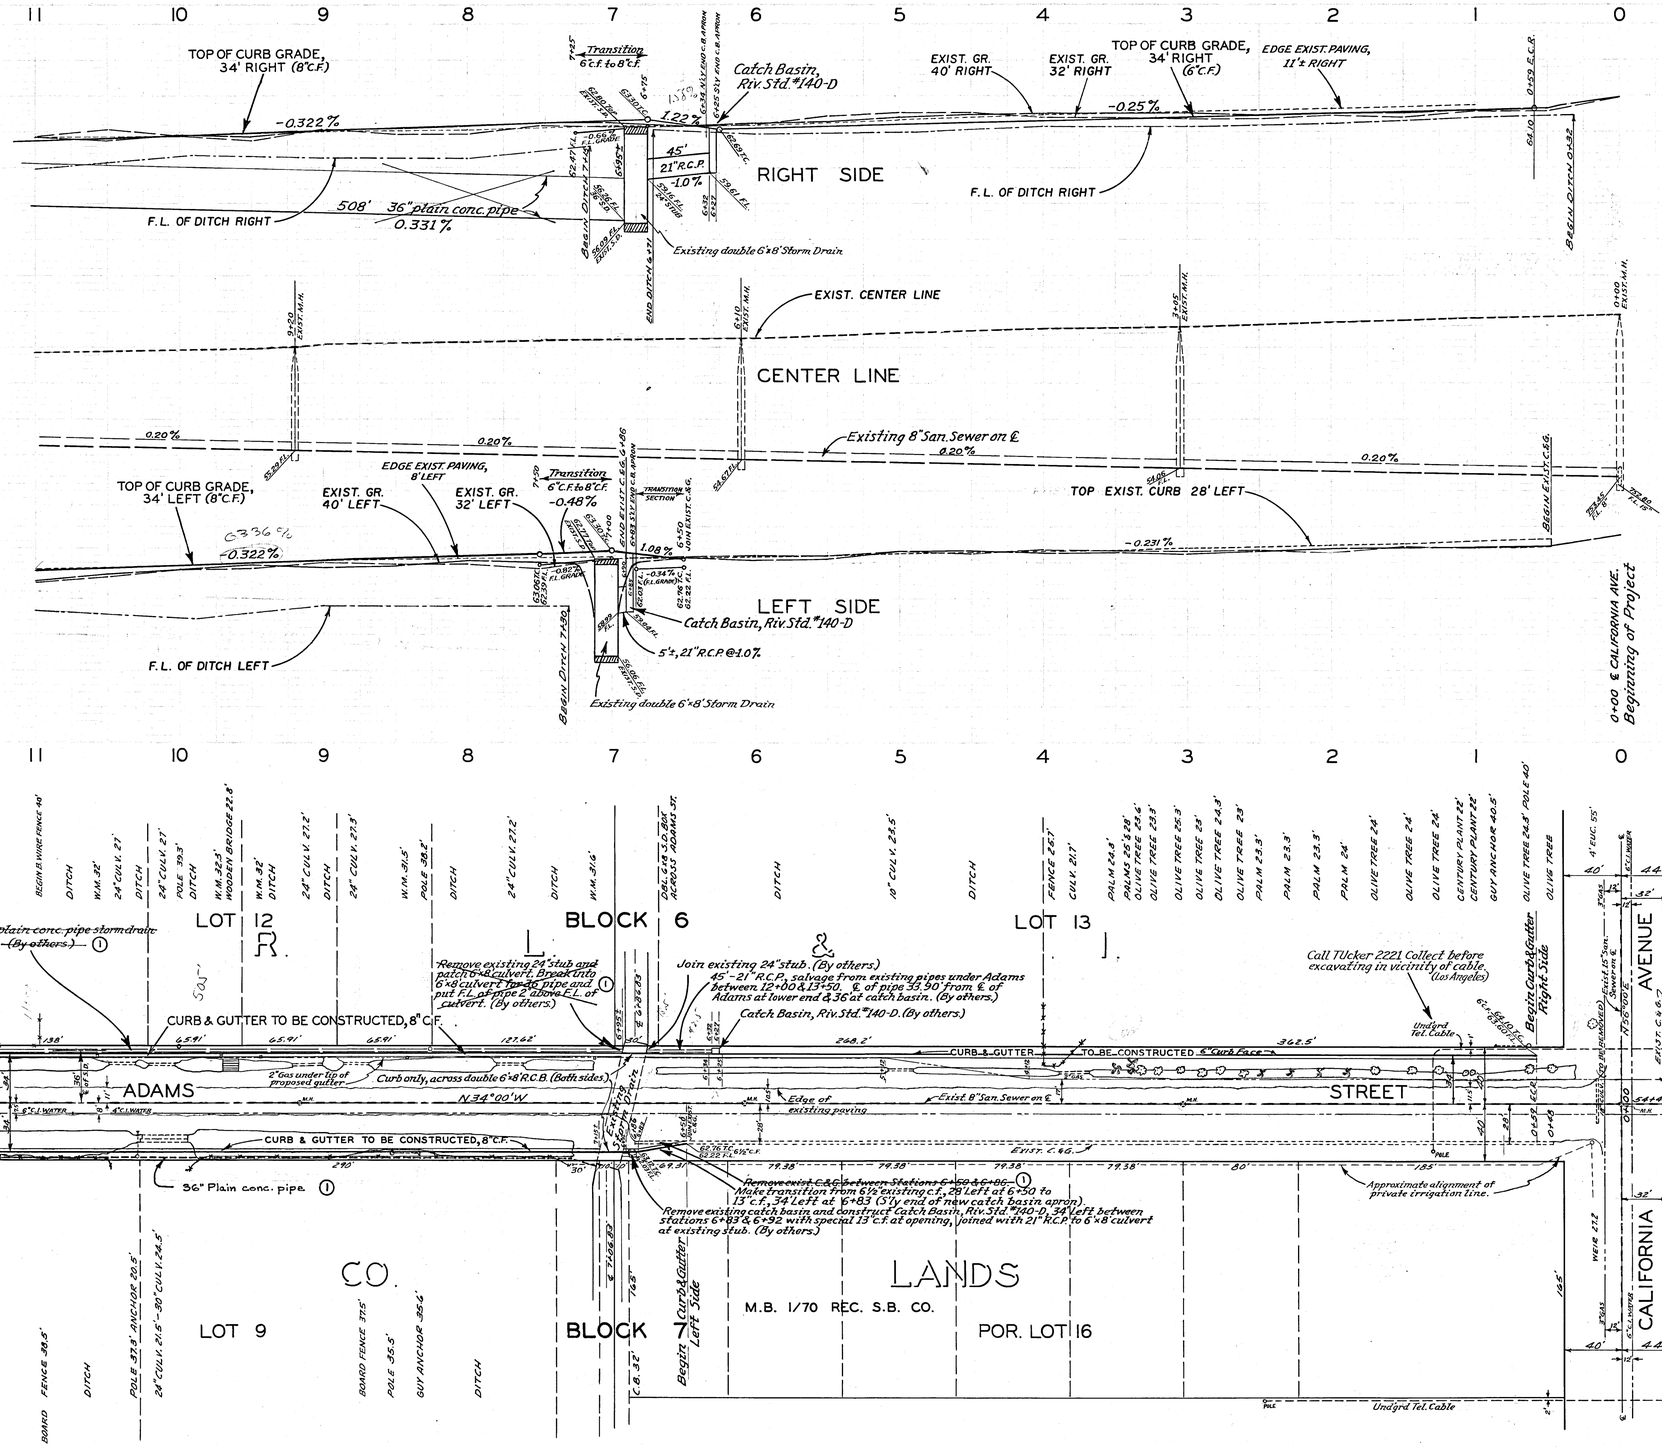



B.M. ELEV. 764.115 R.R. SPIKE IN POLE 10497J 688' NLY. OF C/L OF CALIF. B.M. ELEV. 766.21 X ON BOLT TOP F.H. S.W. COR. CALIF. & ADAMS.	
F.B. 407-40, 574-40, 607-47	
SCALES:	HOR. 1"=50' VERT. 1"=5'

TYPICAL SECTION
0+59 TO 6+25
Scale: 1"=10'

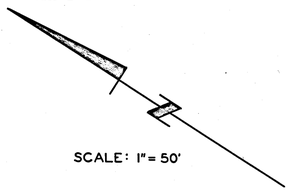

DESCRIPTION	CITY OF RIVERSIDE, CALIFORNIA DEPARTMENT OF PUBLIC WORKS
12-16-57 Storm Drain moved to E'ly side M.B. ① 2-17-58 Storm Drain As-Built w.o.	ADAMS STREET IMPROVEMENT DISTRICT #2 BETWEEN CALIF. AVE. AND NLY. END MAGNOLIA VILLAGE TRACT
W.D.G. J.L.B. C.N., H.Ball Francis L. Tybbe	ENGINEER OF WORKS Nov. 29, 1957
	R-85 SHEET 1 OF 2

INDEXED 1957

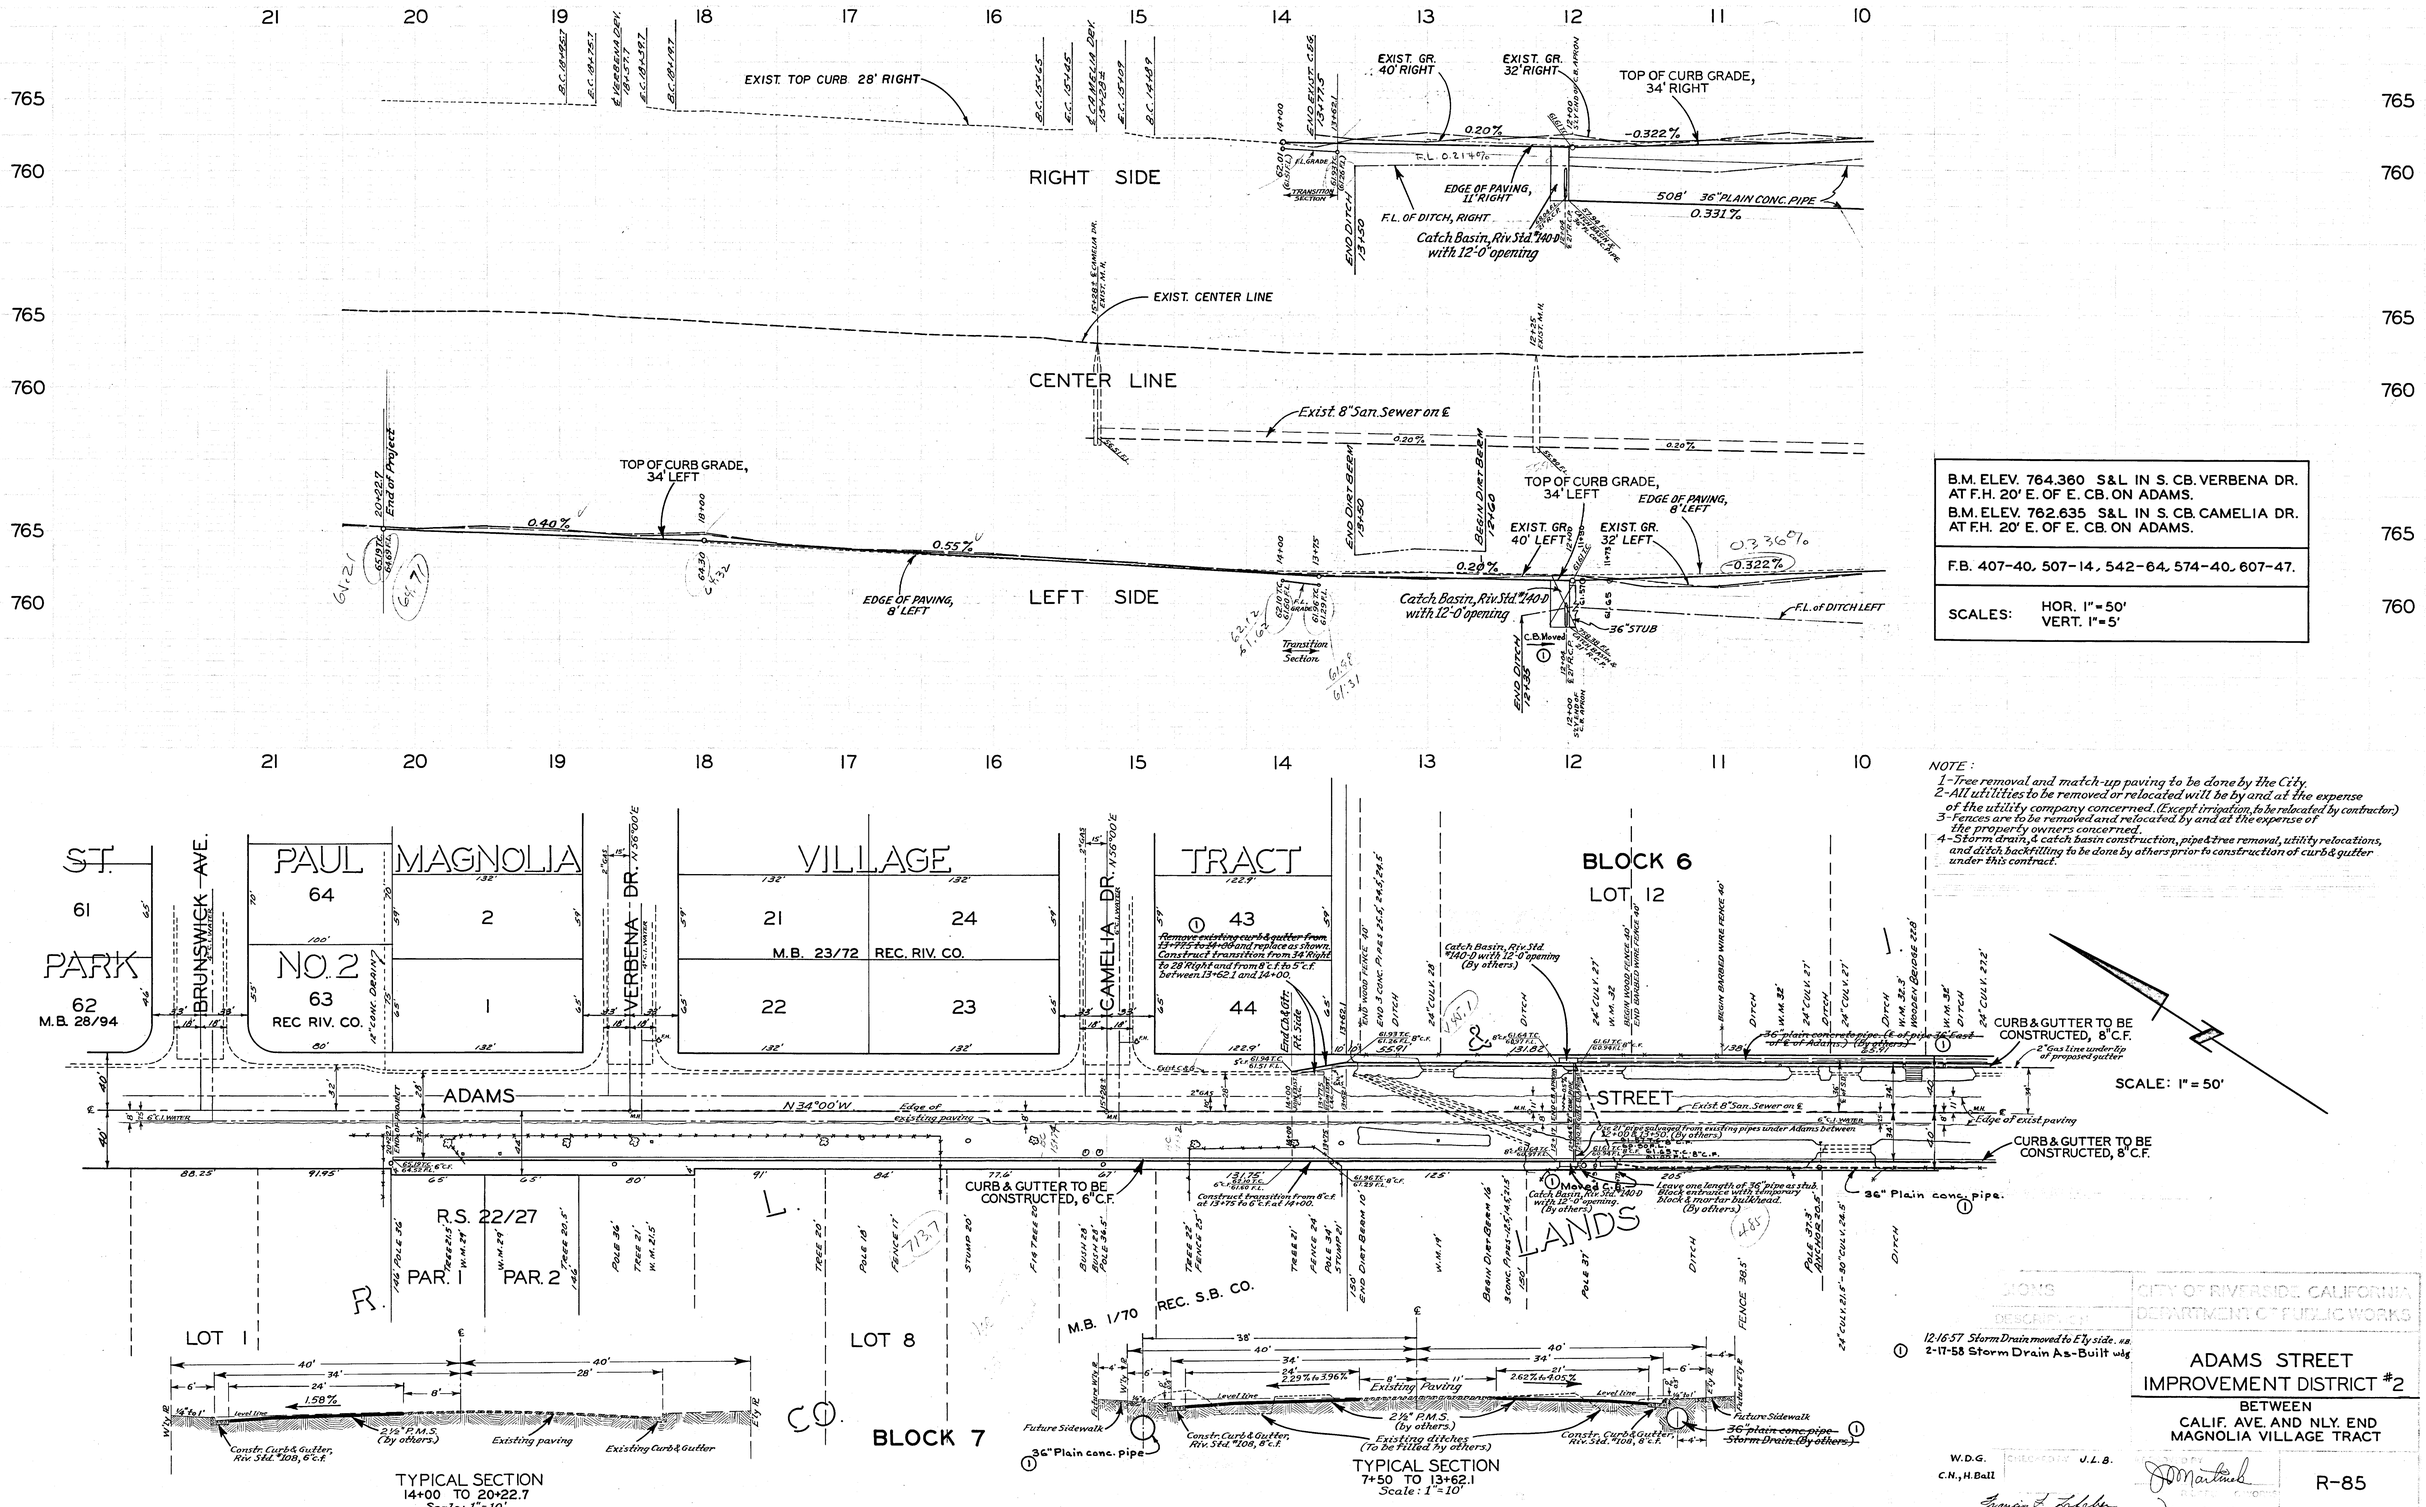

B.M. ELEV. 764.360 S&L IN S. CB. VERBENA DR. AT F.H. 20' E. OF E. CB. ON ADAMS.
B.M. ELEV. 762.635 S&L IN S. CB. CAMELIA DR. AT F.H. 20' E. OF E. CB. ON ADAMS.

F.B. 407-40, 507-14, 542-64, 574-40, 607-47.

SCALES: HOR. 1" = 50'
VERT. 1" = 5'

NOTE:
1-Tree removal and match-up paving to be done by the City.
2-All utilities to be removed or relocated will be by and at the expense of the utility company concerned. (Except irrigation, to be relocated by contractor)
3-Fences are to be removed and relocated by and at the expense of the property owners concerned.
4-Storm drain, & catch basin construction, pipe & tree removal, utility relocations, and ditch backfilling to be done by others prior to construction of curb & gutter under this contract.

TYPICAL SECTION
14+00 TO 20+22.7
Scale: 1" = 10'

TYPICAL SECTION
7+50 TO 13+62.1
Scale: 1" = 10'

① 12-16-57 Storm Drain moved to E'ly side, as.
① 2-17-58 Storm Drain As-Built w&g

DESIGNS	CITY OF RIVERSIDE, CALIFORNIA
DESCRIPTION	DEPARTMENT OF PUBLIC WORKS

ADAMS STREET IMPROVEMENT DISTRICT #2

BETWEEN
CALIF. AVE. AND NLY. END MAGNOLIA VILLAGE TRACT

W.D.G.	SUBMITTED J.L.B.	
C.N., H.Ball	RECOMMENDED J. M. Martinek	R-85
	APPROVED Francis E. Lafeber	Nov. 29, 1957
		SHEET 2 OF 2

INDEXED 1957