


STRIPING AND MARKING LEGEND

- (A) PAINT 4" WIDE DOUBLE YELLOW STRIPE WITH TYPE D MARKERS PER DETAIL 22
- (B) PAINT 4" WIDE SINGLE YELLOW STRIPE (SOLID) WITH TYPE H MARKERS PER DETAIL 25
- (C) PAINT 4" WIDE DASHED WHITE STRIPE (12' STRIPE, 36" GAP) WITH TYPE G MARKERS PER DETAIL 12
- (D) PAINT 4" WIDE SINGLE WHITE STRIPE (SOLID) WITH TYPE G MARKERS AT 24' SPACING
- (E) PAINT 8" WIDE SINGLE WHITE STRIPE (SOLID) WITH TYPE G MARKERS PER DETAIL 3B
- (F) PAINT 12" WIDE SINGLE WHITE STRIPE (SOLID)
- (G) PAINT WHITE TURN ARROW PAVEMENT MARKING
- (J) PAINT 6" WIDE SINGLE WHITE STRIPE (SOLID)
- (K) PAINT 6" WIDE SINGLE WHITE STRIPE (4' STRIPE, 8' GAP)
- (L) PAINT WHITE "BIKE LANE" & ARROW PAVEMENT MARKING

NOTE: SEE CALTRANS STANDARD PLANS A20A, A20B & A20D FOR STRIPING DETAILS.

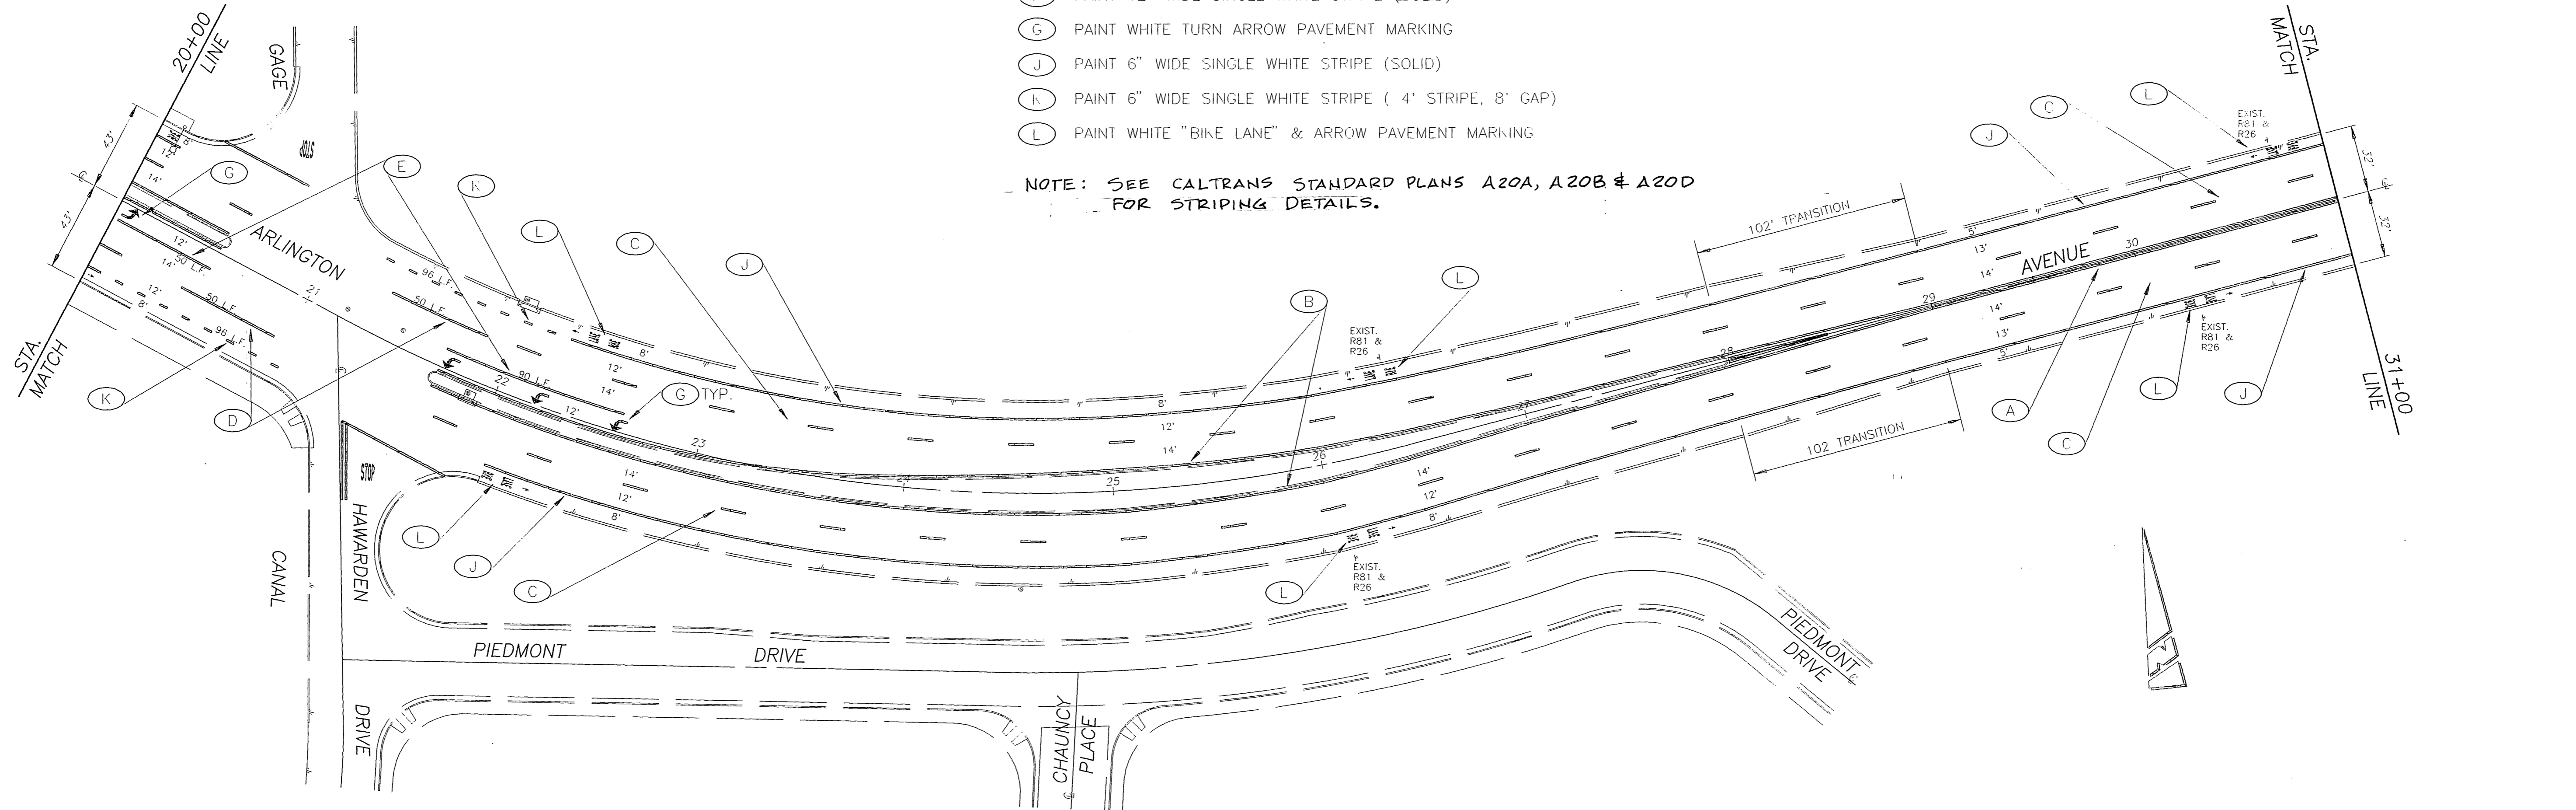

ENGINEER IN RESPONSIBLE CHARGE
 FRAN R. DUNAJSKI
 T.R. No. 1569 expires 6/30/99
 DATE 5/18/96



MARK	REVISIONS	APPR.	DATE
▲	ADDED RAISED MARKERS		5/18/96

CITY OF RIVERSIDE, CALIFORNIA
 PUBLIC WORKS DEPARTMENT
 APPROVED BY: [Signature]
 DEPUTY P.W. DIRECTOR
 PRINCIPAL ENGINEER
 CHIEF P.W. INSPECTOR
 TRAFFIC DIVISION
 SUPERVISOR
 STREET SERVICES
 PARKS DEPARTMENT

REHAB. OF ARTERIAL STREETS 95-96
 STRIPING PLAN
 ARLINGTON AVENUE
 VICTORIA AVENUE TO ALESSANDRO BOULEVARD
 SCALE: 1" = 40'

ACCT. NO. 430-541500-440301-30037
 XL-375
 SHEET 1 OF 2
 FILE NO. XL375.DWG


INDEXED 10/2/96 lfh

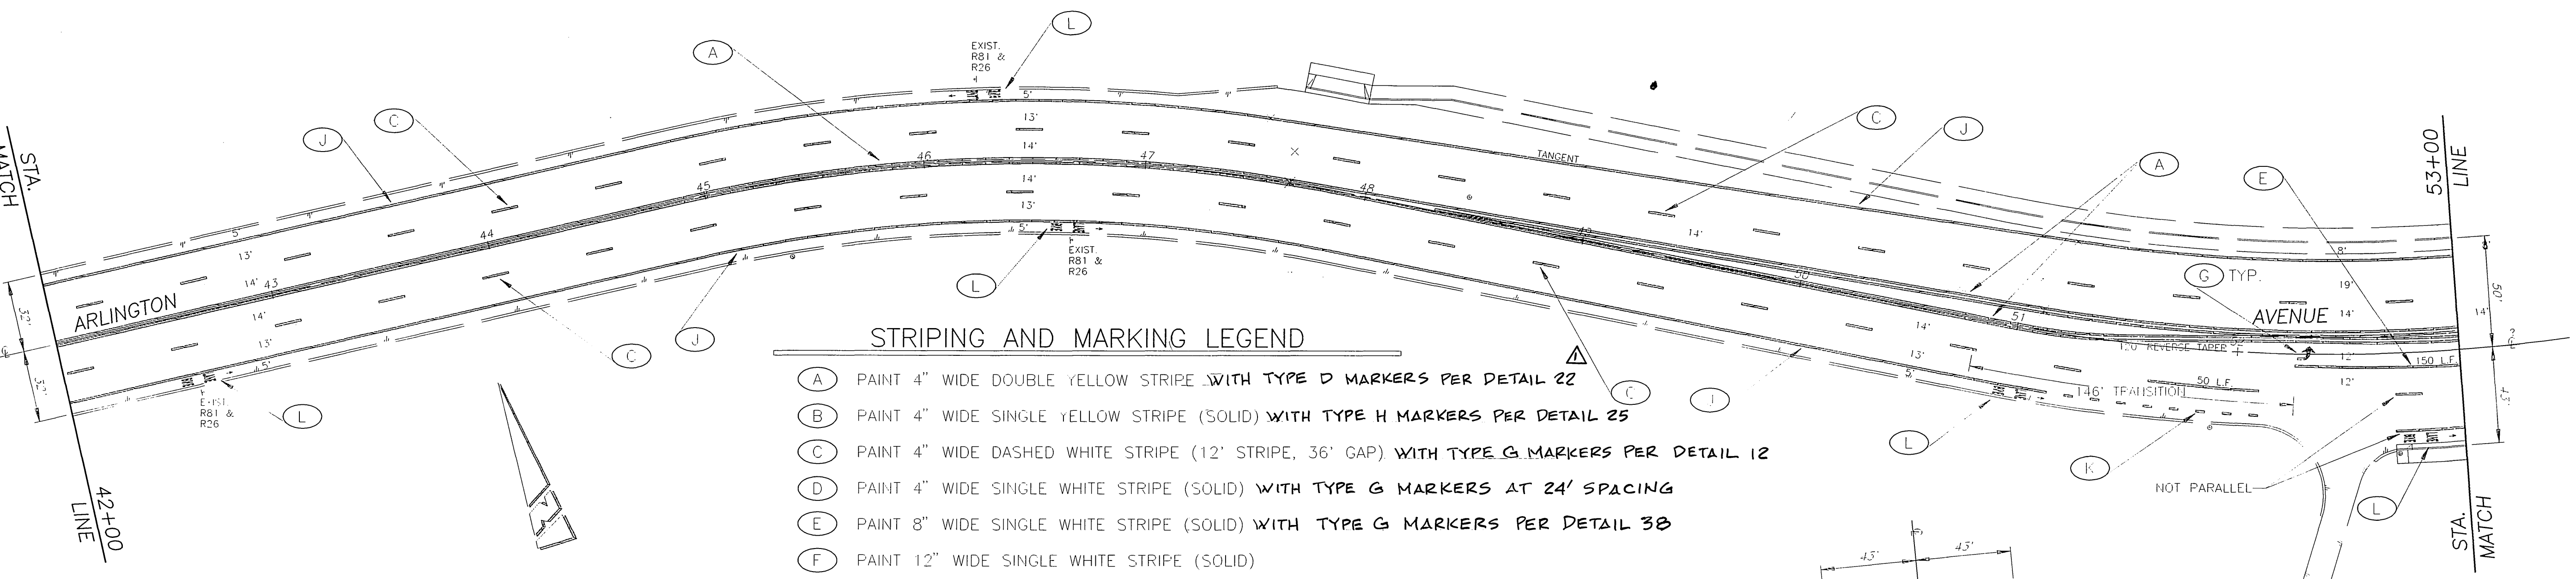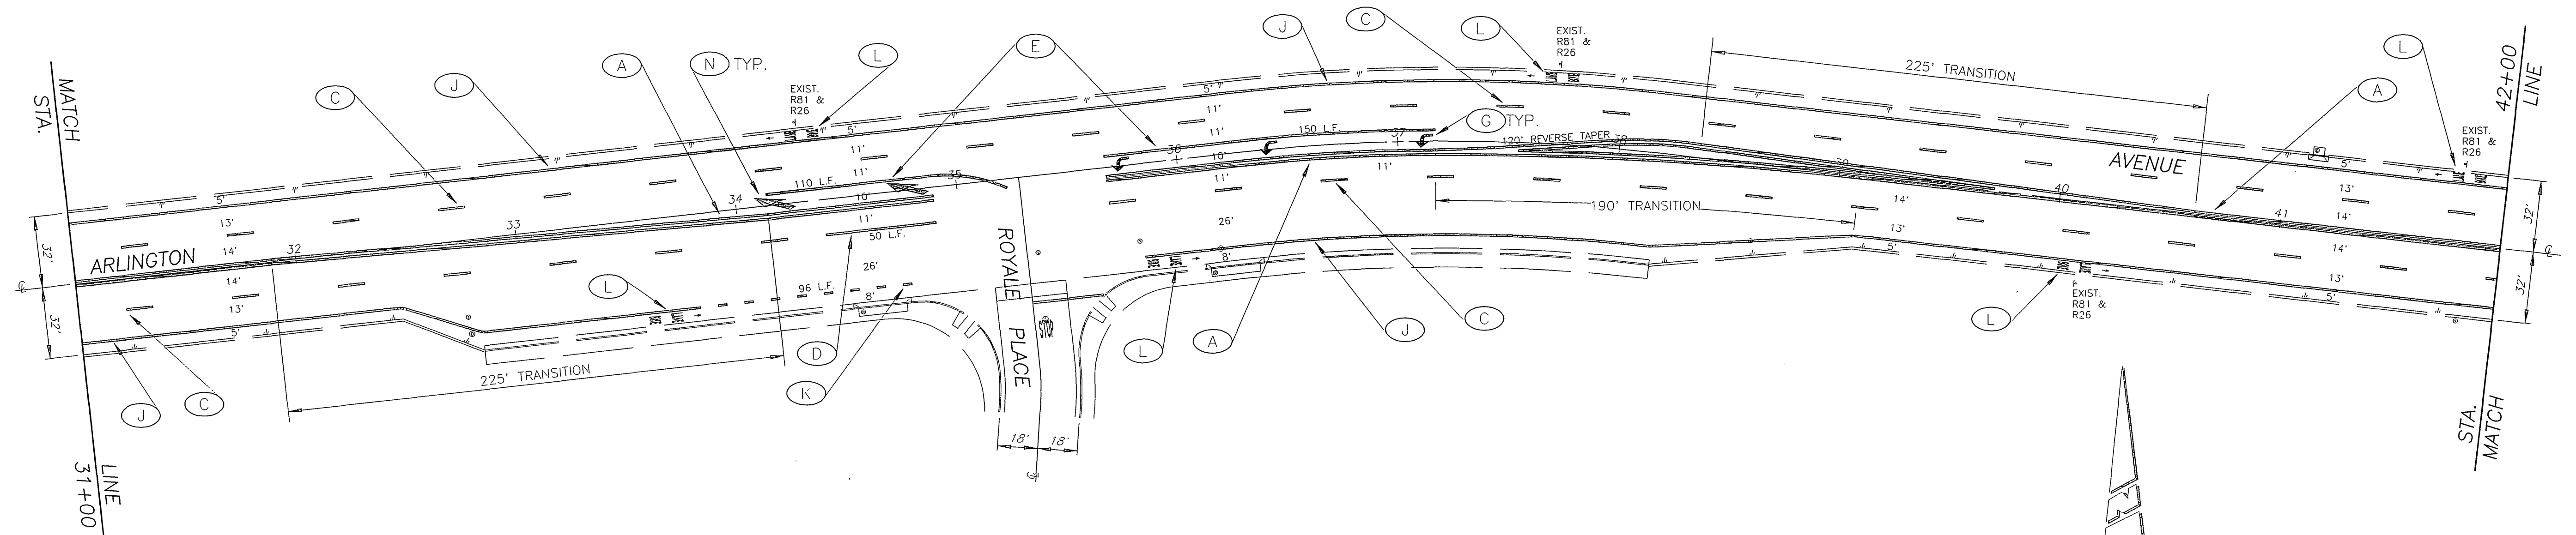

STRIPING AND MARKING LEGEND

- (A) PAINT 4" WIDE DOUBLE YELLOW STRIPE WITH TYPE D MARKERS PER DETAIL 22
- (B) PAINT 4" WIDE SINGLE YELLOW STRIPE (SOLID) WITH TYPE H MARKERS PER DETAIL 25
- (C) PAINT 4" WIDE DASHED WHITE STRIPE (12' STRIPE, 36' GAP) WITH TYPE G MARKERS PER DETAIL 12
- (D) PAINT 4" WIDE SINGLE WHITE STRIPE (SOLID) WITH TYPE G MARKERS AT 24' SPACING
- (E) PAINT 8" WIDE SINGLE WHITE STRIPE (SOLID) WITH TYPE G MARKERS PER DETAIL 3B
- (F) PAINT 12" WIDE SINGLE WHITE STRIPE (SOLID)
- (G) PAINT WHITE TURN ARROW PAVEMENT MARKING
- (J) PAINT 6" WIDE SINGLE WHITE STRIPE (SOLID)
- (K) PAINT 6" WIDE SINGLE WHITE STRIPE (4' STRIPE, 8' GAP)
- (L) PAINT WHITE "BIKE LANE" & ARROW PAVEMENT MARKING
- (N) PAINT WHITE LANE DROP ARROW PAVEMENT MARKING

NOTE: SEE CALTRANS STANDARD PLANS A20A, A20B & A20D FOR STRIPING DETAILS.

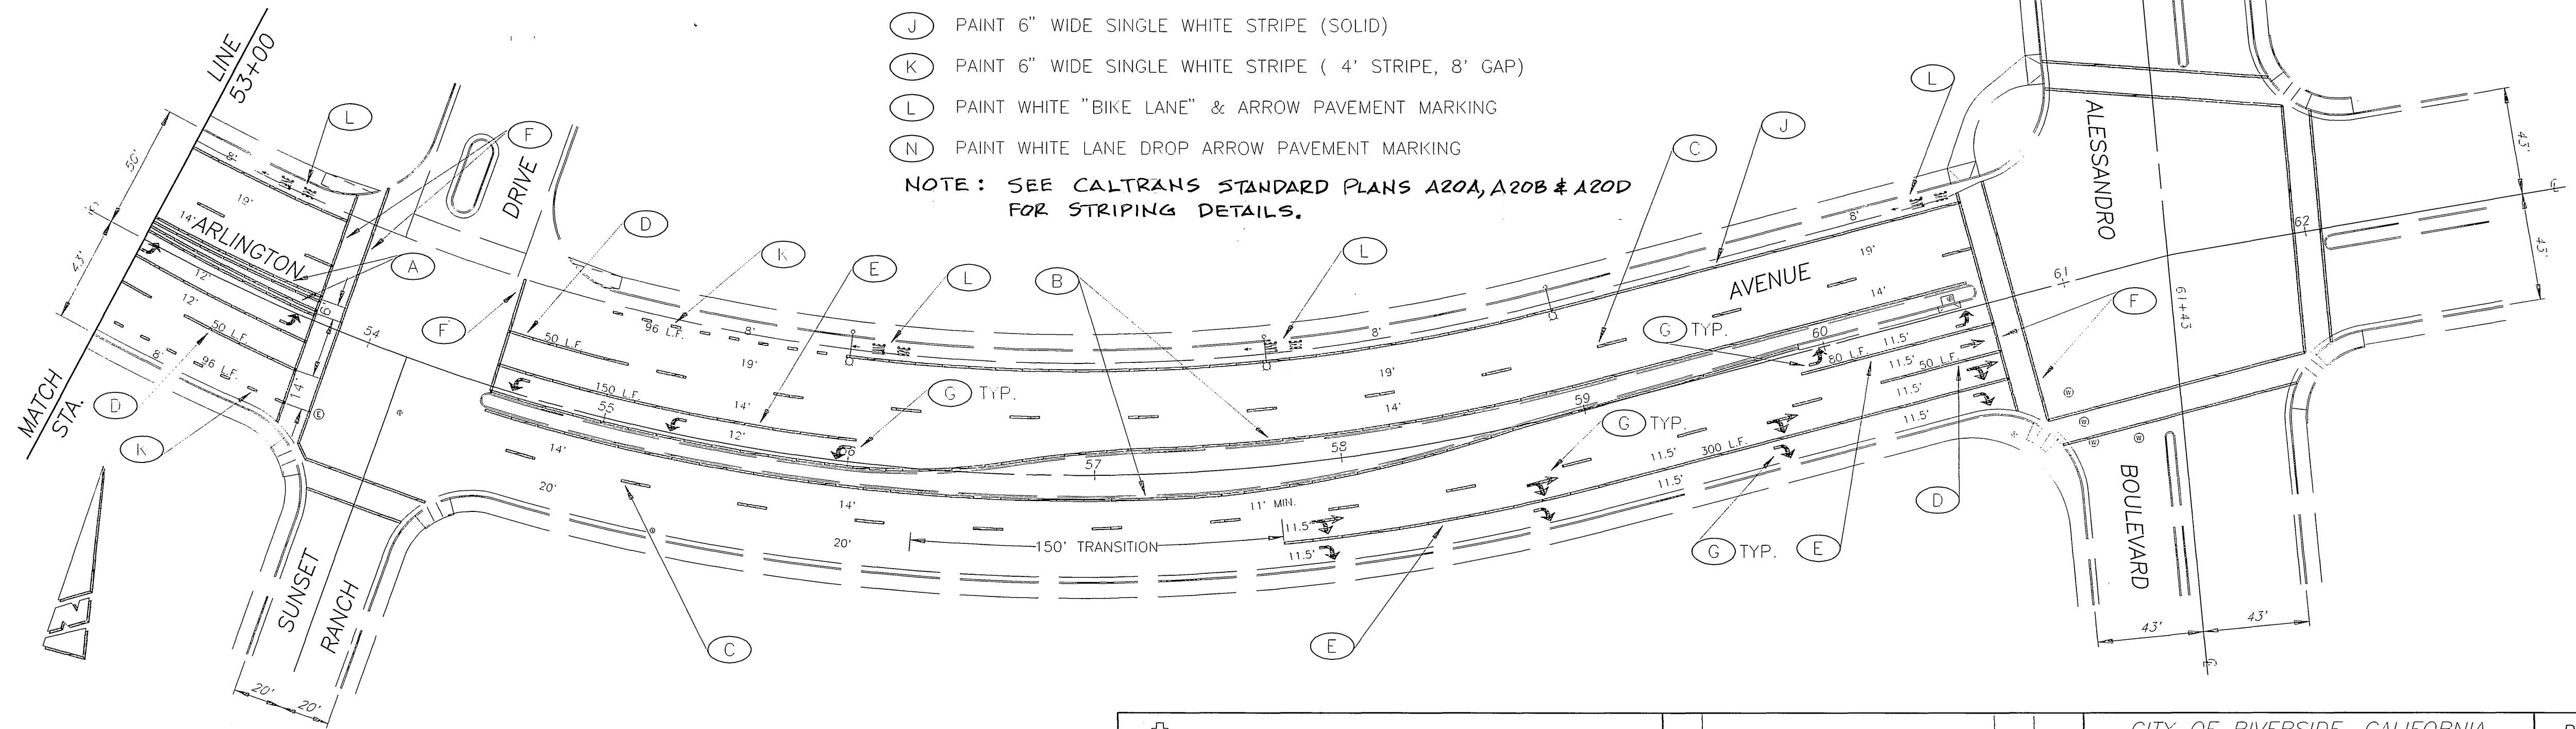

ENGINEER IN RESPONSIBLE CHARGE
 FRANK R. DONAJSKI
 T.R. No. 1569 expires 6/30/99
 DATE 5/18/96

APPROVED BY: [Signature]
 DEPUTY P.W. DIRECTOR
 PRINCIPAL ENGINEER
 CHIEF P.W. INSPECTOR
 TRAFFIC DIVISION SUPERVISOR
 STREET SERVICES DIVISION

CITY OF RIVERSIDE, CALIFORNIA
 PUBLIC WORKS DEPARTMENT
 APPROVED BY: [Signature]
 DATE 5/18/96

REHAB. OF ARTERIAL STREETS 95-96
 STRIPING PLAN
 ARLINGTON AVENUE
 VICTORIA AVENUE TO ALESSANDRO BOULEVARD
 SCALE: 1" = 40'

ACCT. NO. 430-541500-440301-30037
 XL-375
 SHEET 2 OF 2
 FILE NO. XL375.DWG