



DETAIL "A"

STRIPING LEGEND

- (A) 4" DASHED WHITE STRIPE (STD. PLAN A20A, DETAIL 9)
- (B) 8" SOLID WHITE STRIPE (STD. PLAN A20D, DETAIL 38B)
- (C) 8" SOLID WHITE STRIPE (STD. PLAN A20D, DETAIL 38)
- (D) 12" SOLID WHITE STRIPE (STD. PLAN A24E)
- (E) SOLID WHITE ARROW (STD. PLAN A24A, TYPE IV)
- (F) DOUBLE YELLOW STRIPE (STD. PLAN A20A, DETAIL 22)
- (G) DOUBLE YELLOW MEDIAN ISLAND STRIPE (STD. PLAN A20B, DETAIL 29)
- (H) LANE DROP AT INTERSECTION STRIPE (STD. PLAN A20C, DETAIL 37B)
- (I) YELLOW LEFT EDGELINE STRIPE (STD. PLAN A20B, DETAIL 25A)
- (J) LANE LINE EXTENSION THROUGH INTERSECTION (STD. PLAN A20D, DETAIL 40)
- (K) SOLID WHITE "STOP" LEGEND (STD. PLAN A24D)
- (L) SOLID WHITE ARROW (STD. PLAN A24A, TYPE VIII)

PAVEMENT DELINEATION

- INDICATES STRIPING AND PAVEMENT MARKINGS TO BE INSTALLED.
- — — — INDICATES STRIPING AND PAVEMENT MARKINGS TO REMAIN.
- INDICATES STRIPING AND PAVEMENT MARKINGS TO BE REMOVED.

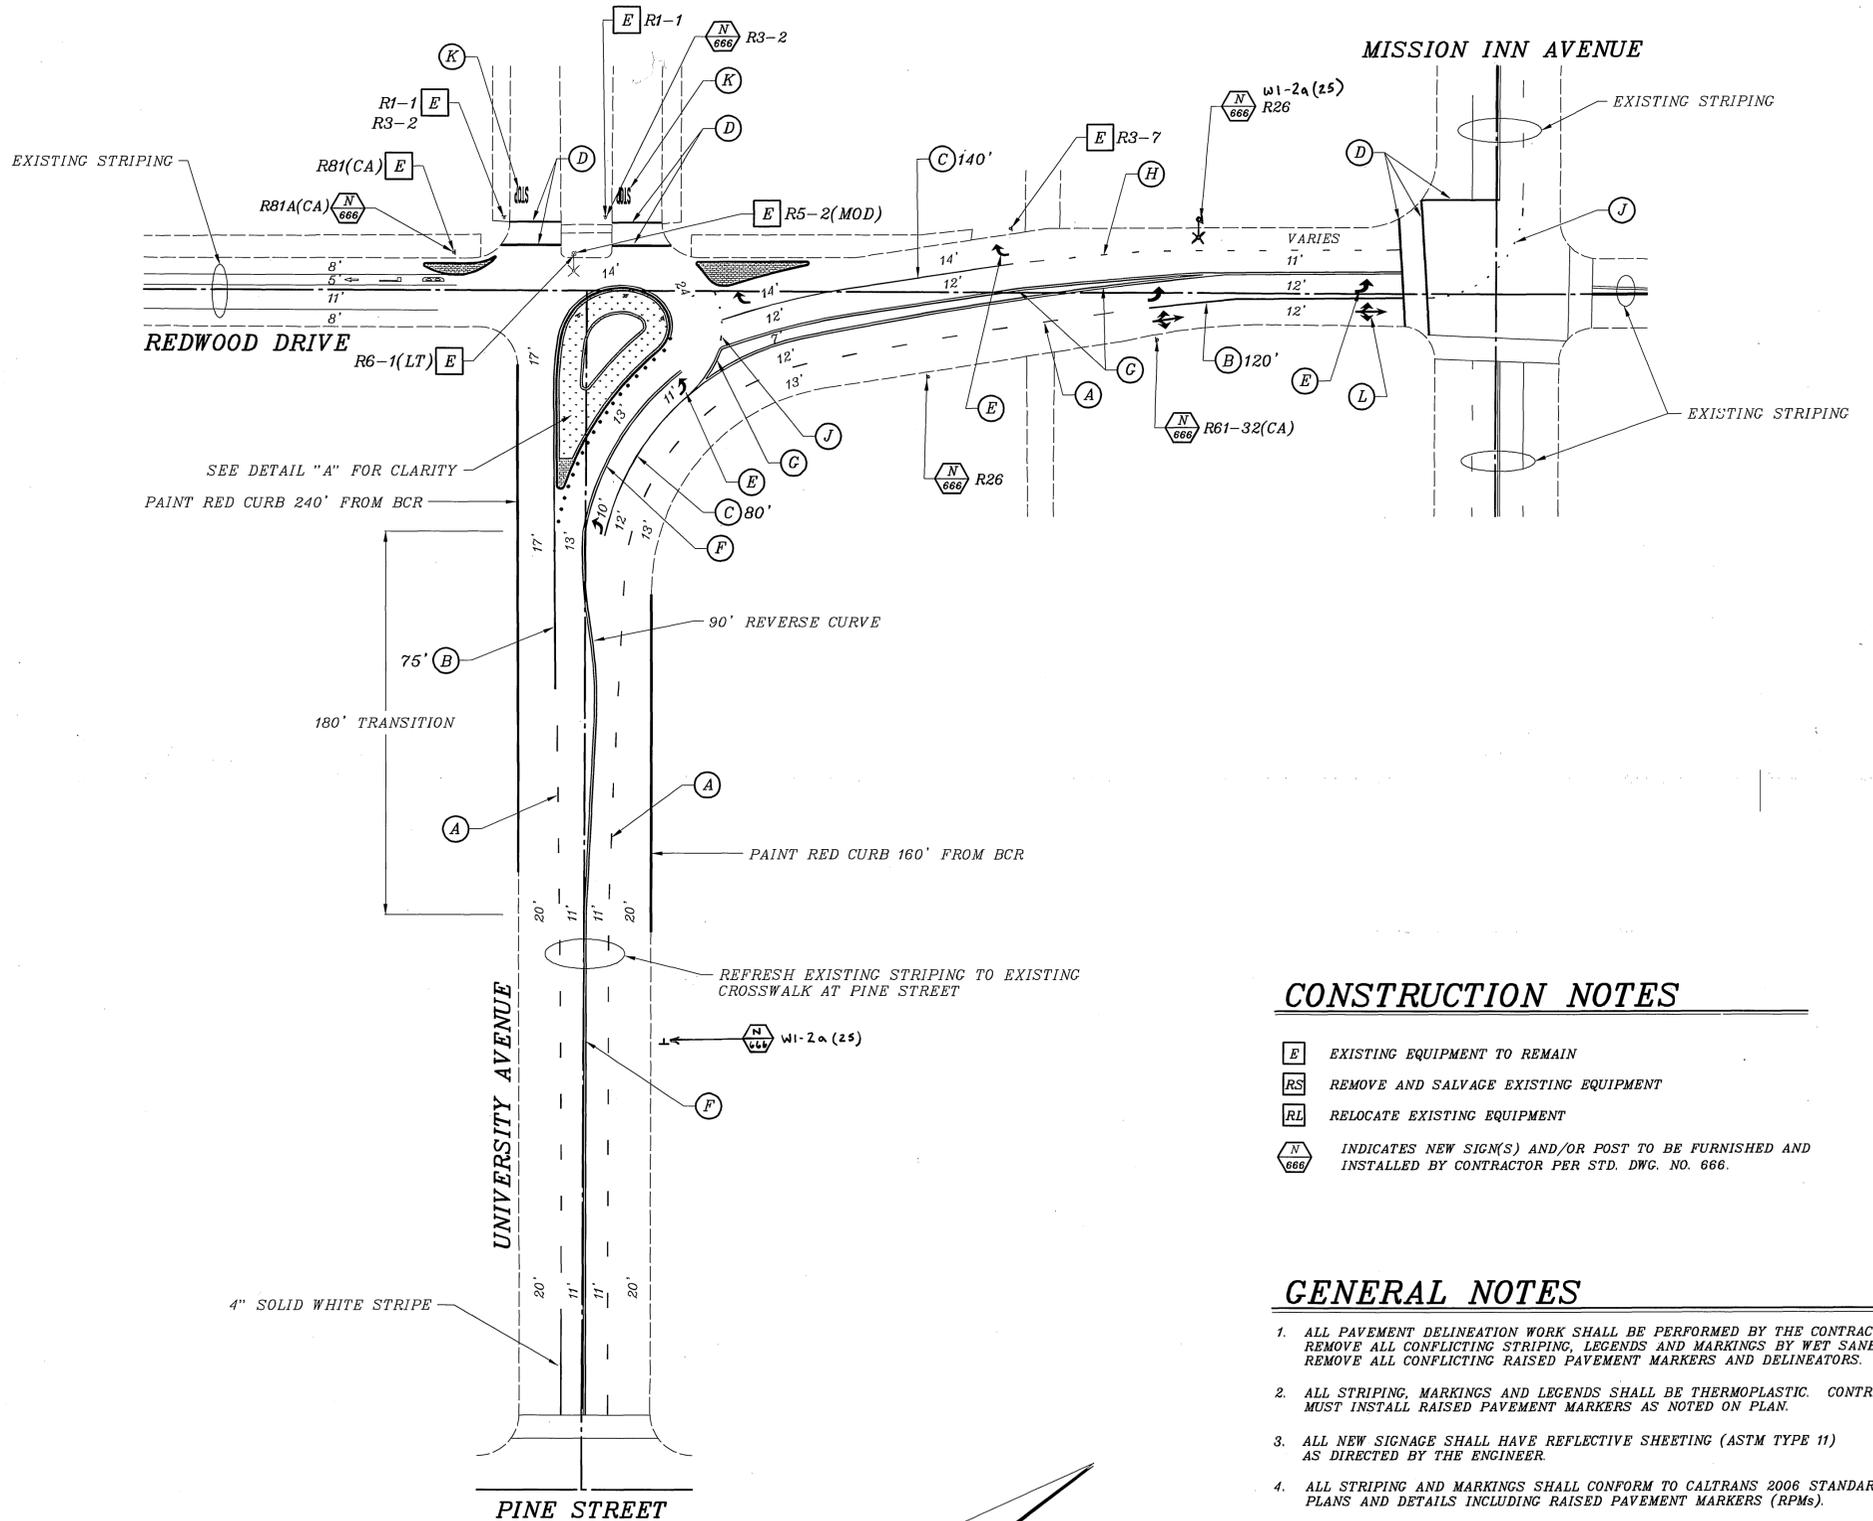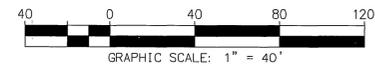

CONSTRUCTION NOTES

- (E) EXISTING EQUIPMENT TO REMAIN
- (RS) REMOVE AND SALVAGE EXISTING EQUIPMENT
- (RL) RELOCATE EXISTING EQUIPMENT
- (N 666) INDICATES NEW SIGN(S) AND/OR POST TO BE FURNISHED AND INSTALLED BY CONTRACTOR PER STD. DWG. NO. 666.

GENERAL NOTES

1. ALL PAVEMENT DELINEATION WORK SHALL BE PERFORMED BY THE CONTRACTOR REMOVE ALL CONFLICTING STRIPING, LEGENDS AND MARKINGS BY WET SANBLASTING. REMOVE ALL CONFLICTING RAISED PAVEMENT MARKERS AND DELINEATORS.
2. ALL STRIPING, MARKINGS AND LEGENDS SHALL BE THERMOPLASTIC. CONTRACTOR MUST INSTALL RAISED PAVEMENT MARKERS AS NOTED ON PLAN.
3. ALL NEW SIGNAGE SHALL HAVE REFLECTIVE SHEETING (ASTM TYPE 11) AS DIRECTED BY THE ENGINEER.
4. ALL STRIPING AND MARKINGS SHALL CONFORM TO CALTRANS 2006 STANDARD PLANS AND DETAILS INCLUDING RAISED PAVEMENT MARKERS (RPMs).
5. ALL EQUIPMENT TO BE REMOVED AND SALVAGED MUST BE RETURNED TO THE CITY OF RIVERSIDE YARD.
6. SEE PLAN R-4023 FOR ALL RAISED MEDIAN IMPROVEMENTS.

ENGINEER IN RESPONSIBLE CHARGE
 GILBERT M. HERNANDEZ
 R.C.E. No. 69170 expires 6-30-08
 DATE 4-17-07

MARK	REVISIONS	APPR	DATE

CITY OF RIVERSIDE, CALIFORNIA
DEPARTMENT OF PUBLIC WORKS

APPROVED BY	BY	DATE	APPROVED BY
PRINCIPAL ENGINEER			
ENGINEERING MANAGER		4/17/07	
TRAFFIC DIVISION		4/17/07	

DATE 4/18/07

STRIPING PLAN
UNIVERSITY AVENUE
REDWOOD DRIVE

SCALE: 1" = 40'

ACCT. NO. **XL-548**
 SHEET **1** OF **1**
 FILE NAME: XL548.DWG