

ENCROACHMENT PERMIT

Pursuant to Resolution No. 11065 of the City of Riverside, permission is hereby granted to

Donald D. Ray and Ruth E. Ray

2287 Knob Hill Drive

Riverside, CA 92506

their heirs and assigns, hereinafter referred to as "Permittee" to use and occupy the following described property. All that portion of Sunset Drive and Royal Hill Drive (formerly Central Avenue) as shown by Record of Survey, filed in Book 23, Page 63 of Records of Survey, adjacent to Parcel 2 of said R.S. 23/63, Records of Riverside County, California,

in accordance with the terms hereof.

1. Permittee shall use and occupy the described property only in the manner and for the purposes as follows: To install and maintain a 4" sewer lateral, encroaching into said Royal Hill Drive and Sunset Drive as shown on attached Exhibit "A" made a part hereof by this reference.

1a. Permittee's contractor shall obtain construction and/or street opening permit prior to beginning job.

1b. It shall be the responsibility of permittee's contractor to contact the Water and Electric Division of Public Utility Department for the location of their facilities prior to beginning job.

1c. It shall be the responsibility of permittee's contractor to repair and/or cause to be replaced, Water and Electric facilities as they presently exist, should damage occur.

2. Permittee, by acceptance of the benefits hereunder, acknowledges title to the property to be in the City of Riverside and waives any right to contest the validity of the dedication or grant.

3. Permittee acknowledges that the described property is the site of a proposed or planned public improvement and that, accordingly, all rights and privileges of use permitted shall cease and expire upon notice of revocation by the City. Upon the expiration or revocation, Permittee shall, within the time prescribed by the City, remove all improvements or obstructions placed, constructed or maintained by the Permittee. If the Permittee fails to abide by the removal order of the City within the time prescribed, the City shall have the right to remove and destroy the improvements without reimbursement to the Permittee and the cost of such removal shall be paid by the Permittee to the City of Riverside and shall constitute a debt owed to the City of Riverside.

4. Permittee, by acceptance hereof, waives the right of claim, loss, damage or action against the City of Riverside arising out of or resulting from revocation, termination, removal of the improvements or any action of the City of Riverside, its officers, agents or employees taken in accordance with the terms hereof.

5. Finding and determination by the City Council of the City of Riverside that the Permittee, or his heirs and assigns or successors in interest, are in default of the terms hereunder shall be cause for revocation.

6. Permittee herewith agrees to hold the City of Riverside harmless from and against all claims, demands, costs, losses, damages, injuries, action for damages and/or injuries, and liability growing or arising out of or in connection with the construction, encroachment, and/or maintenance to be done by Permittee or his agents, employees or contractors within the described property.

DATED: May 8, 1978

CITY OF RIVERSIDE, a municipal corporation

By Al Brown Mayor

Attest Alice A. Hens City Clerk

The foregoing is accepted by:

Donald A. Laeg
(Signature(s) of Permittee)

APPROVED AS TO CONTENT

[Signature]
Department Head

APPROVED AS TO CONTENT

Don Campbell 5/3/78
Department Head

APPROVED AS TO CONTENT

[Signature]
Department Head


APPROVED AS TO FORM

John Woodhead
City Attorney

CITY MANAGER APPROVAL

Joseph P. Suzzetta
City Manager

EXHIBIT 'A'

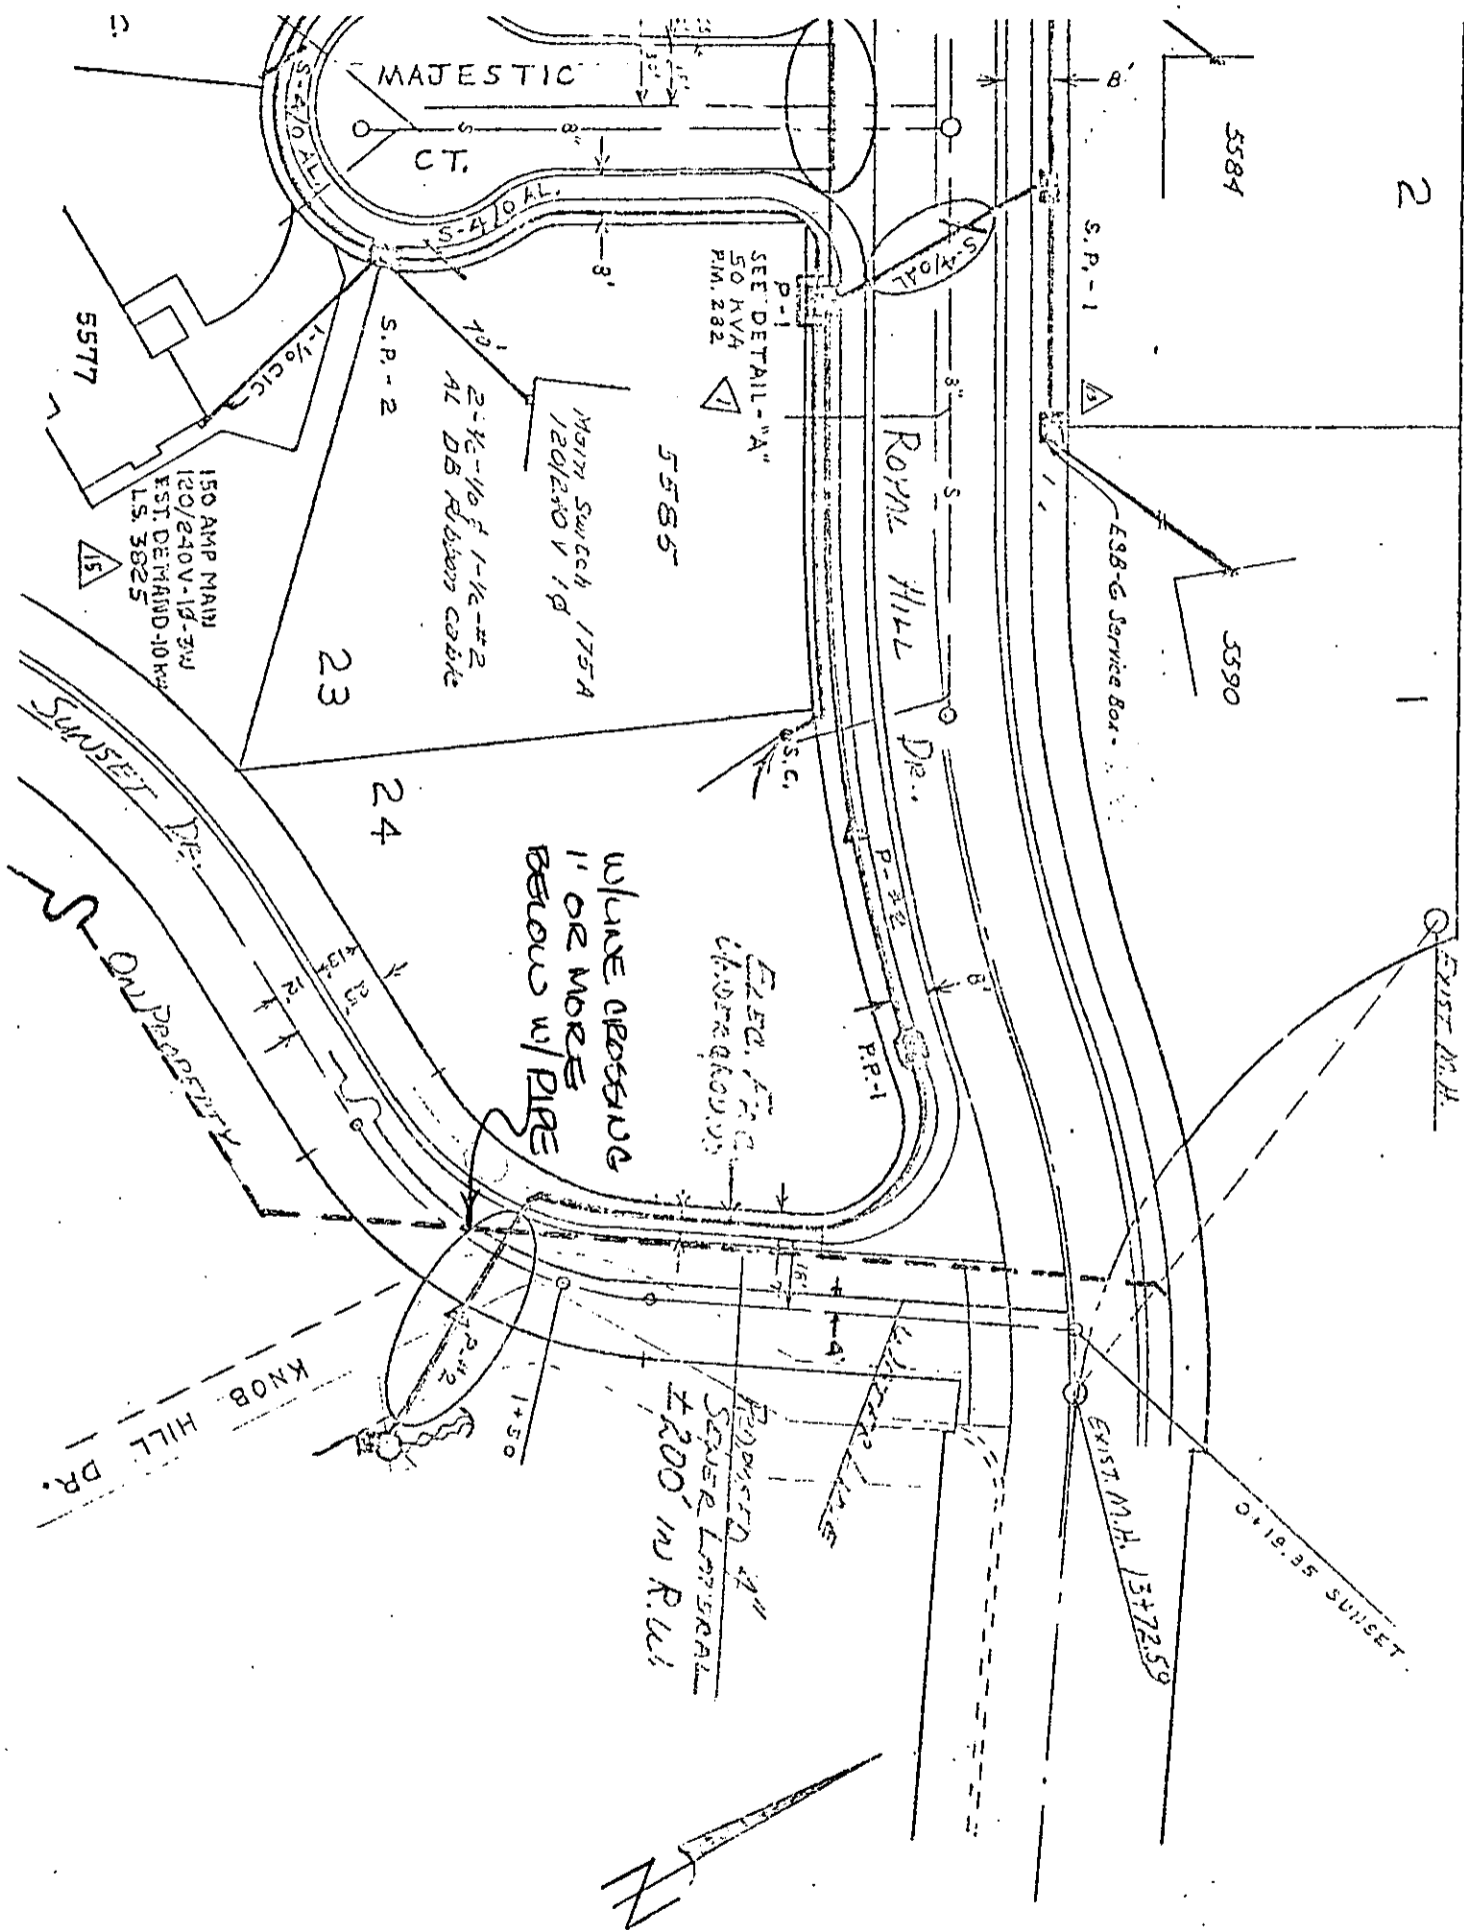

• CITY OF RIVERSIDE, CALIFORNIA •

SHEET 1 OF 1

4-40-3

SCALE: 1" = 50'

DRAWN BY: [Signature] DATE: 5/3/78

SUBJECT: Encroachment Permit - 2287 KNOB HILL DR