

ENCROACHMENT PERMIT

Pursuant to Resolution No. 11065 of the City of Riverside, permission is hereby granted to Bill E. & Vernice A. Crowe
2807 Gratton Street
Riverside, CA 92504

their heirs and assigns, hereinafter referred to as "Permittee" to use and occupy the following described property. That portion of the public street rights of way of Gratton Street and Williamburg Place lying adjacent to Lot 18 of Tract 8726, as shown by map on file in Book 93 of Maps, at Pages 62-63 thereof, records of Riverside County, California, as shown by attached Exhibit "A",

in accordance with the terms hereof.

1. Permittee shall use and occupy the described property only in the manner and for the purposes as follows: Construction and maintenance of a 4' high stone and wrought iron garden wall encroaching into the public street right of way a maximum of 0.5' on Gratton Street and 5.5' on Williamburg Place as shown by attached Exhibit "A".

2. Permittee, by acceptance of the benefits hereunder, acknowledges title to the property to be in the City of Riverside and waives any right to contest the validity of the dedication or grant.

3. Permittee acknowledges that the described property is the site of a proposed or planned public improvement and that, accordingly, all rights and privileges of use permitted shall cease and expire upon notice of revocation by the City. Upon the expiration or revocation, Permittee shall, within the time prescribed by the City, remove all improvements or obstructions placed, constructed or maintained by the Permittee. If the Permittee fails to abide by the removal order of the City within the time prescribed, the City shall have the right to remove and destroy the improvements without reimbursement to the Permittee and the cost of such removal shall be paid by the Permittee to the City of Riverside and shall constitute a debt owed to the City of Riverside.

4. Permittee, by acceptance hereof, waives the right of claim, loss, damage or action against the City of Riverside arising out of or resulting from revocation, termination, removal of the improvements or any action of the City of Riverside, its officers, agents or employees taken in accordance with the terms hereof.

5. Finding and determination by the City Council of the City of Riverside that the Permittee, or his heirs and assigns or successors in interest, are in default of the terms hereunder shall be cause for revocation.

6. Permittee herewith agrees to hold the City of Riverside harmless from and against all claims, demands, costs, losses, damages, injuries, action for damages and/or injuries, and liability growing or arising out of or in connection with the construction, encroachment, and/or maintenance to be done by Permittee or his agents, employees or contractors within the described property.

DATED: Aug 21, 1985

CITY OF RIVERSIDE, a municipal corporation

By [Signature] Mayor

Attest [Signature] City Clerk

The foregoing is accepted by:

(Signature(s) of Permittee)

Bill E. Crowe

Vernice A. Crowe

APPROVED AS TO CONTENT

William D. Gardner
Department Head

APPROVED AS TO FORM

John Woodhead
City Attorney


CITY MANAGER APPROVAL

Robert E. Fremont
City Manager


LINCOLN

AVENUE

814 95

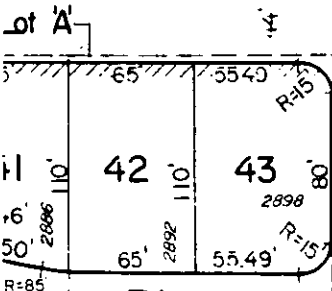


Place 42 43

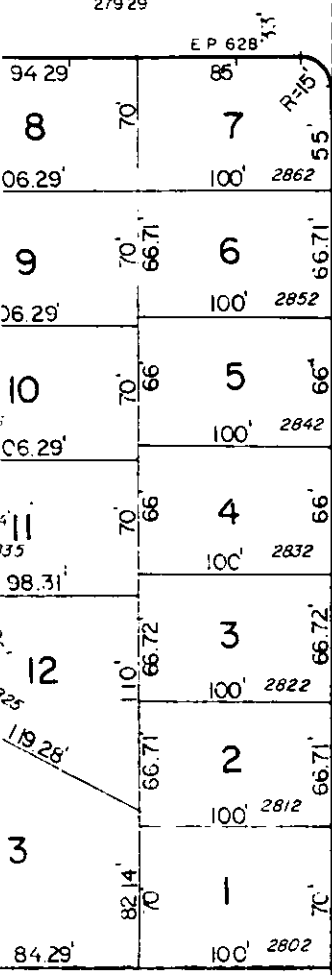


Place 8 9 10 11 12 3

STREET


GRATTON

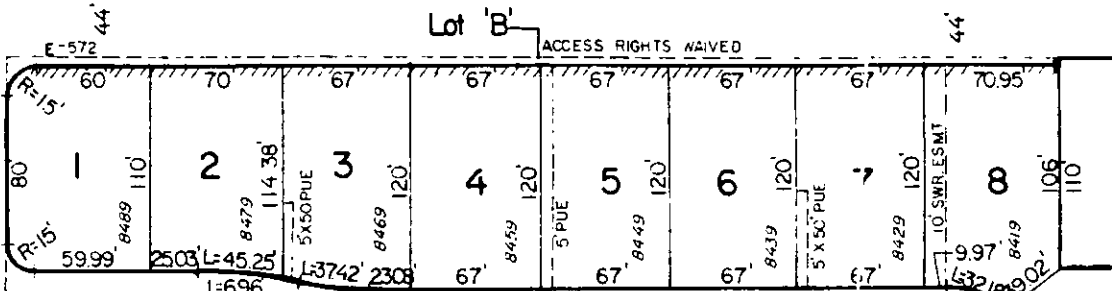


Place 1 2 3 4 5 6 7 8

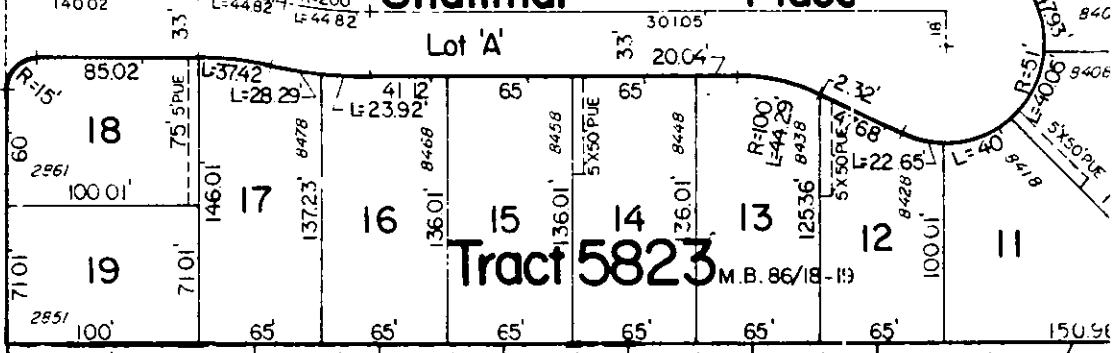

Place 11 12 13 14 15 16 17 18 19

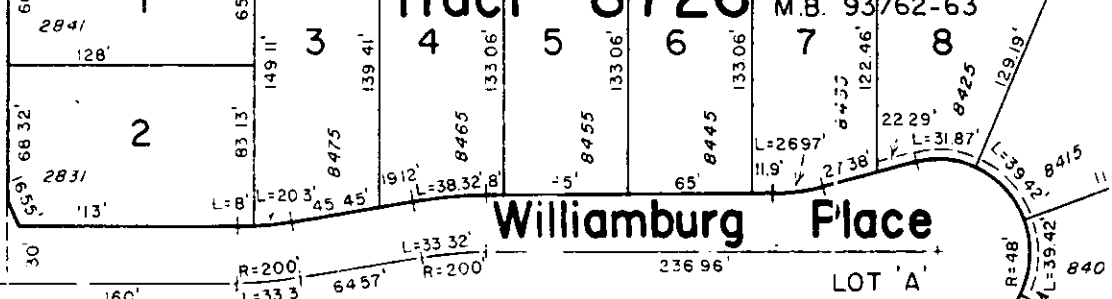

Place 1 2 3 4 5 6 7 8

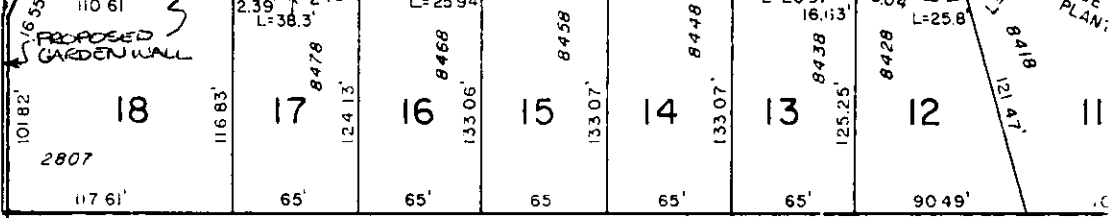

Place 11 12 13 14 15 16 17 18

0

1

2

3

4

2

4

3

2

18

17

16

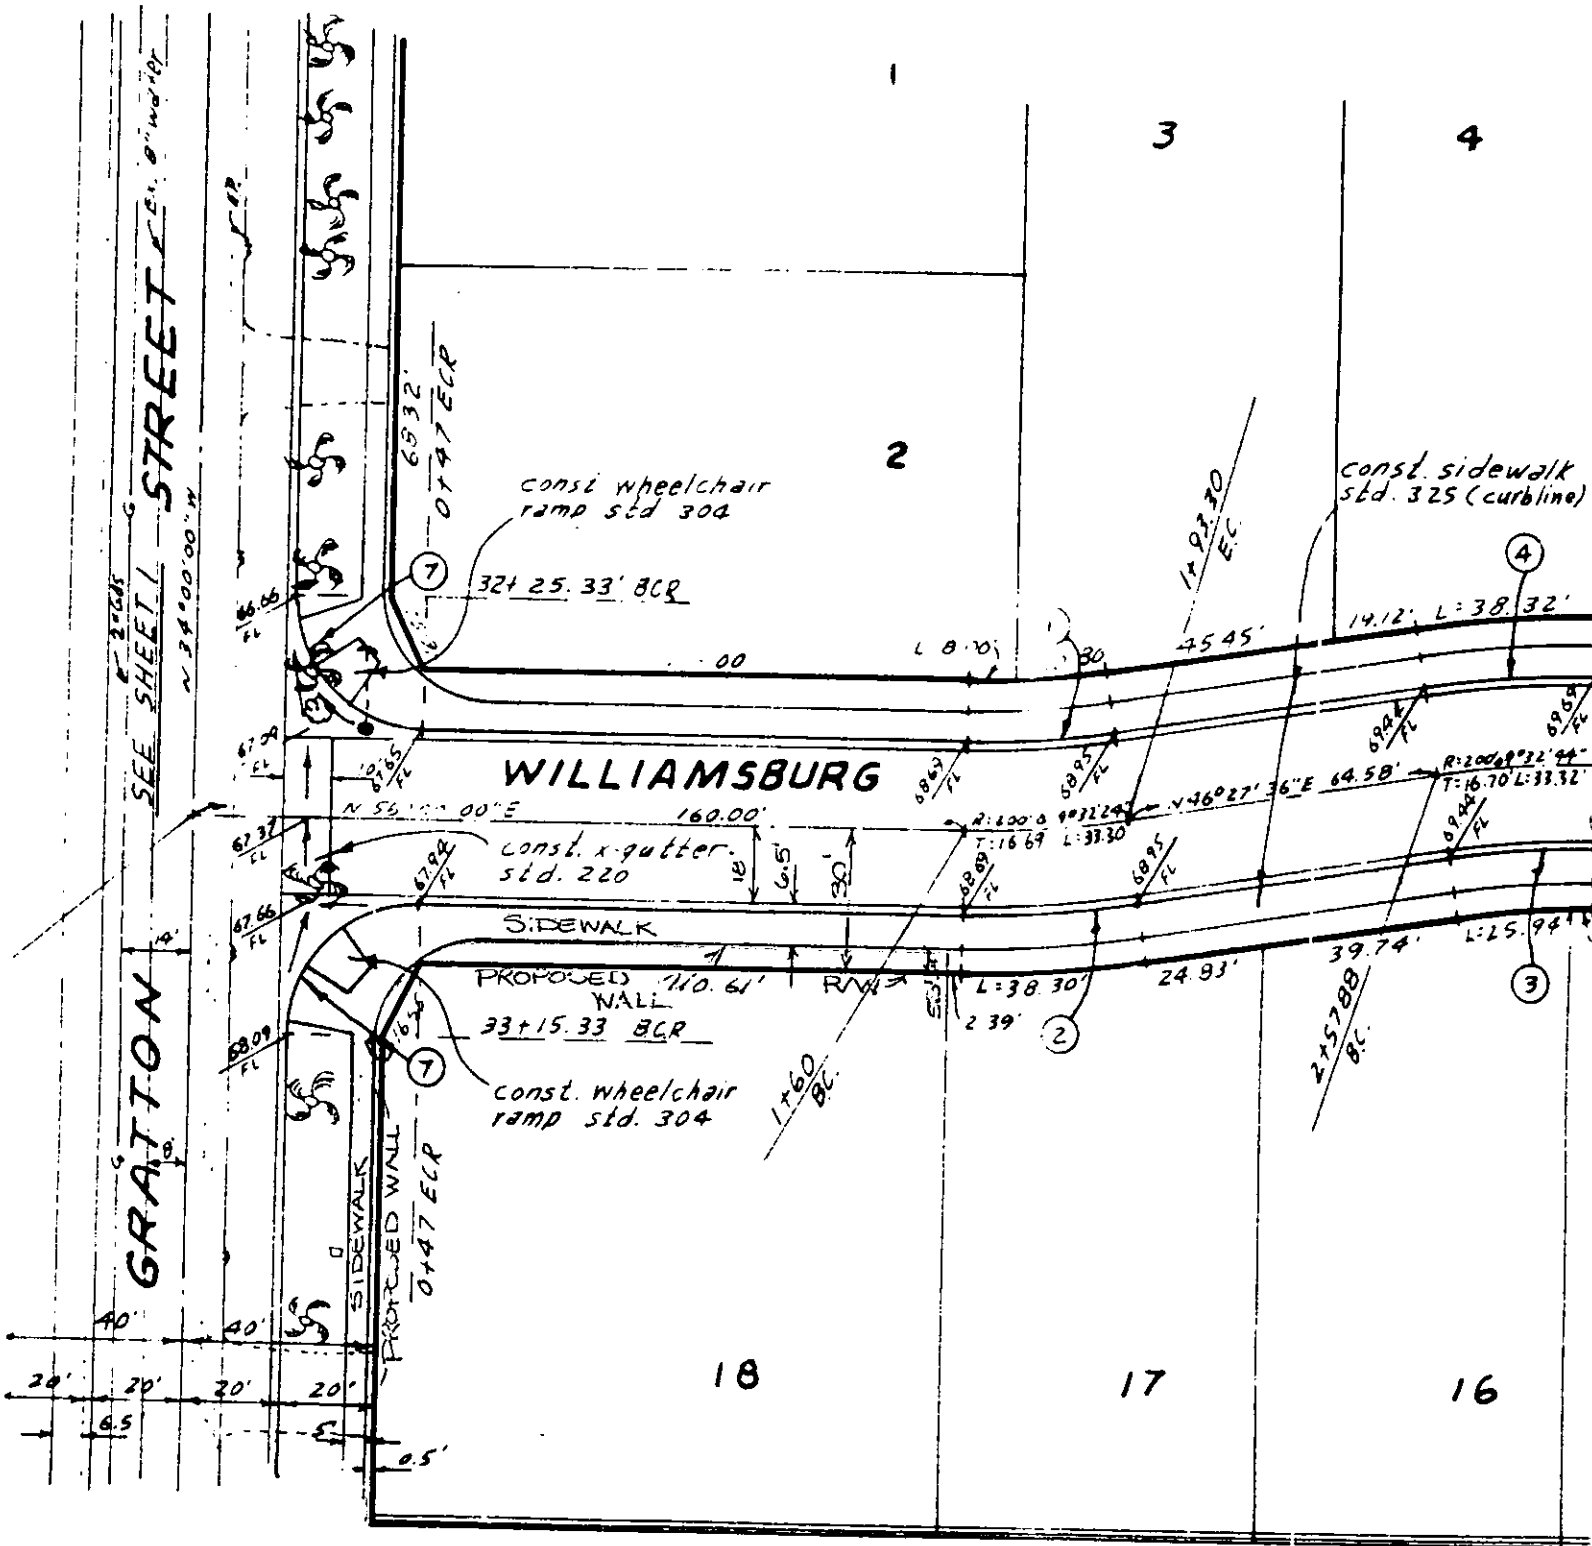


EXHIBIT "A"
SHEET 2 OF 2