

SEWAGE COLLECTION SYSTEM SHEET SCHEDULE

- General layout plan, sewerage system - sheet No. 1
- Sewage collection system, index plan - sheet No. 2
- Sewage collection system, section 1 - sheet No. 3
- Sewage collection system, section 2 - sheet No. 4
- Sewage collection system, section 3 - sheet No. 5
- Sewage collection system, section 4 - sheet No. 6
- Sewage collection system, section 5 - sheet No. 7
- Sewer profiles Nos. 1 - 2 - sheet No. 8
- Sewer profiles Nos. 3 - 4 - 5 - 6 - 7 - 8 - 9 - 10 - sheet No. 9
- Sewer profiles Nos. 11 - 12 - 13 - 14 - 15 - 16 - 17 - 18 - sheet No. 10
- Sewer profiles No. 19 - sheet No. 11
- Main sewage pumping plant - Location plan - sheet No. 12
- Main sewage pumping plant - Plan plan - sheet No. 13
- Main sewage pumping plant - Structural plan - sheet No. 14
- Main sewage pumping plant - Details - sheet No. 15
- Sanitary Sewer Station - sheet No. 16

Note: sewer profiles No. 9 & 10 are on sheet No. 9

SYMBOLS

- numbers shown thus will denote respectively profile and sheet number
- numbers shown thus will denote sewer line
- manhole

1001

REV. NO.	DATE	REVISION	REV. CHR.	APP.		
1	10/22	Original plan of lines on lines 75 and 76 and 77 

MILITARY CONSTRUCTION ARLINGTON STAGING AREA



SCALE: 1 IN. = 400 FT. IN 17 SHEETS SHEET NO. 1 GRAPHIC SCALE FEET U. S. ENGINEER OFFICE, LOS ANGELES, CALIF.

SUBMITTED BY: [Signature] APPROVED BY: [Signature]

FILE NO. DRAWN: [ ] TRACED: [ ] CHECKED: [ ] TO ACCOMPANY: [ ]

ERICK, PHILIP S. CIVIL ENGINEER

21

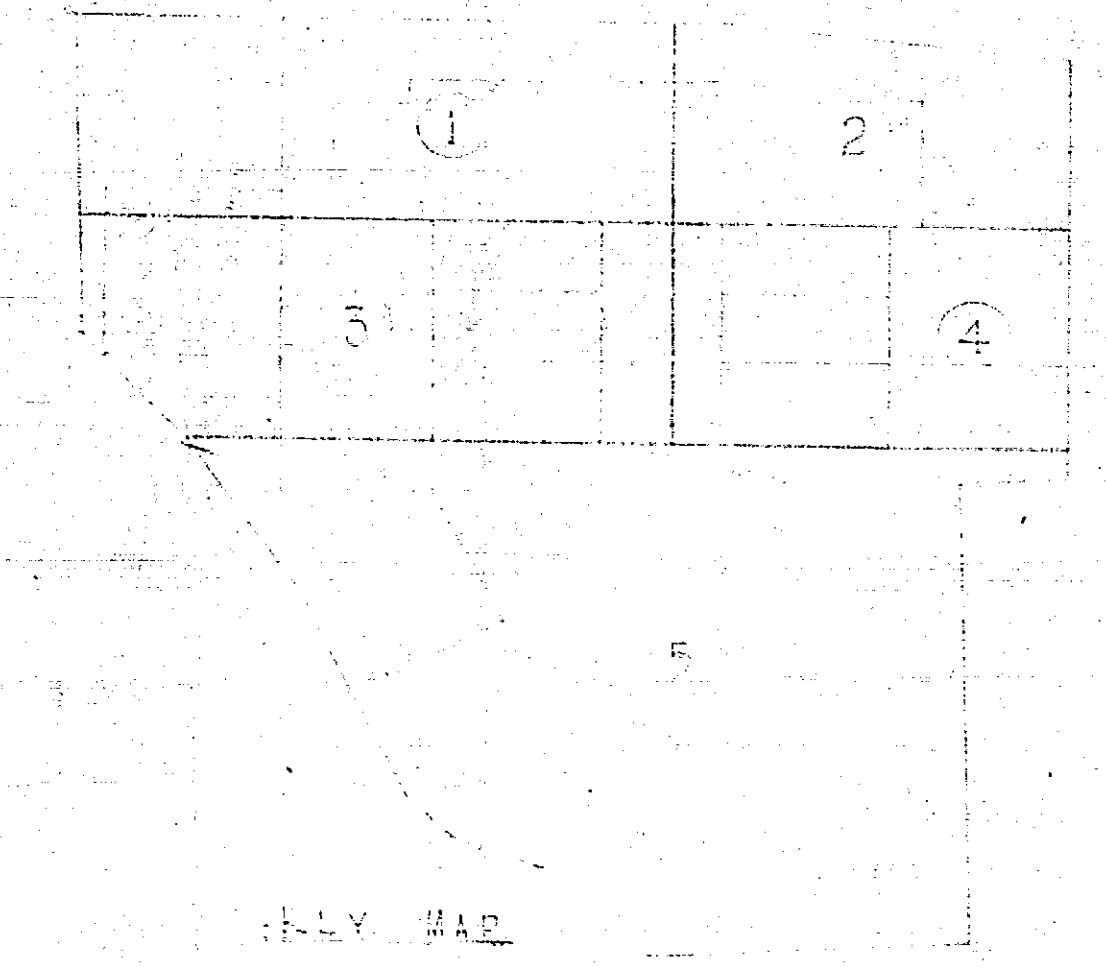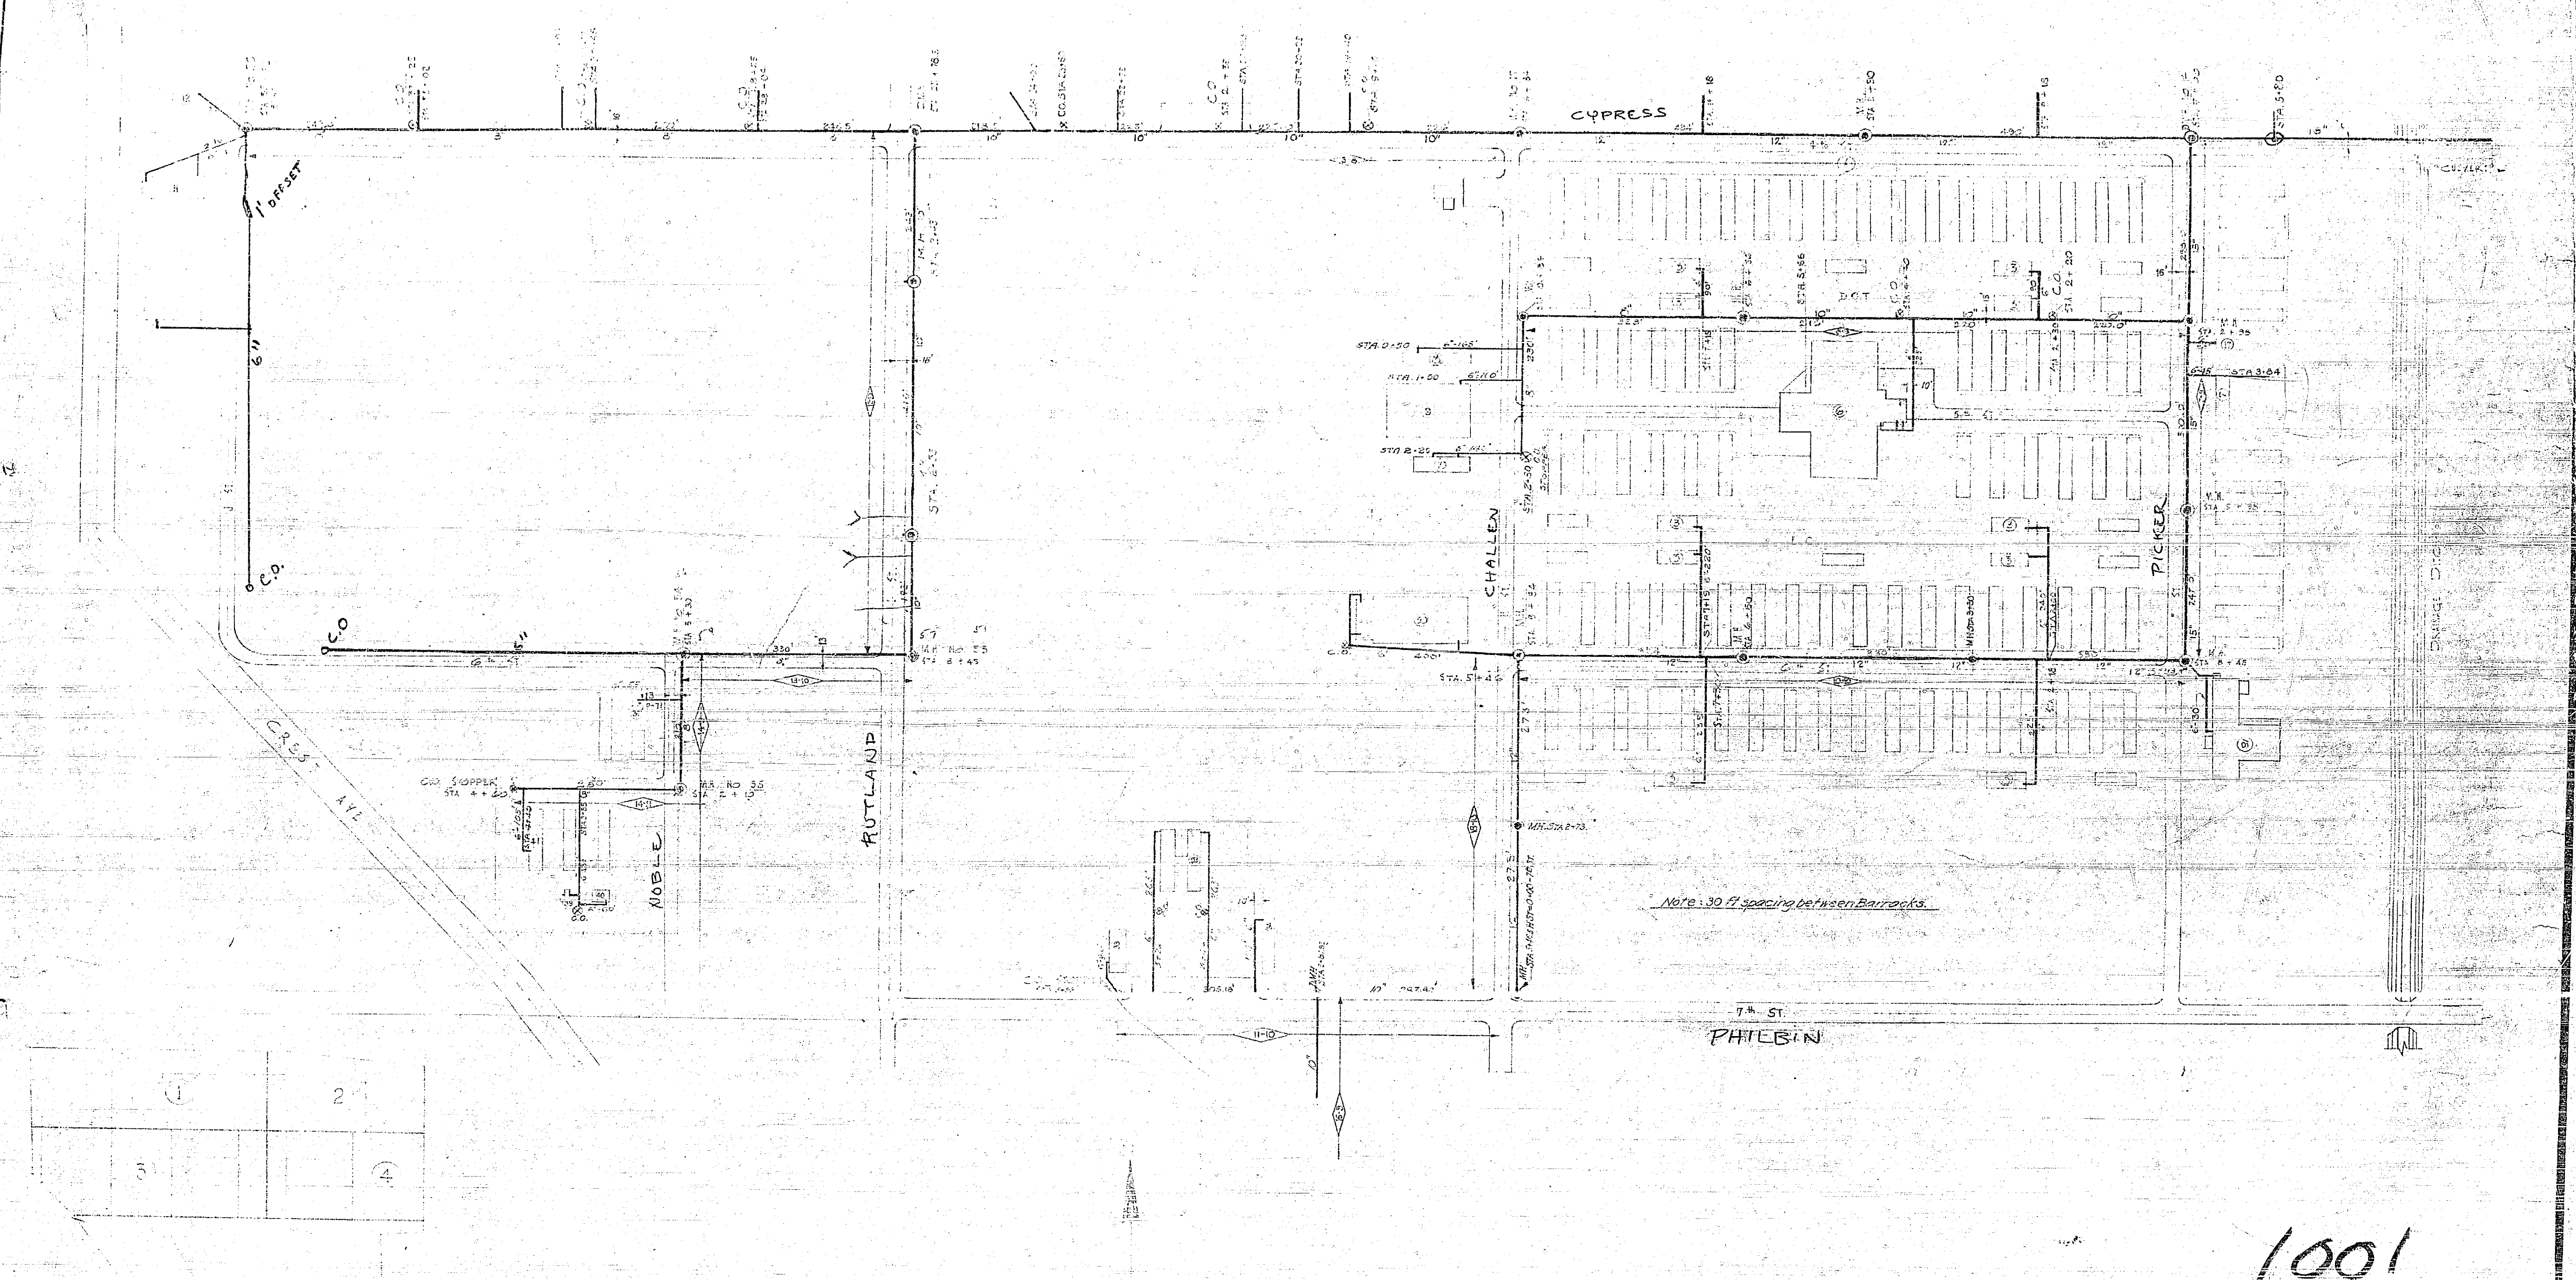

REV. NO.	DATE	REVISION	REV.	CHK.	APP.

1001


MILITARY CONSTRUCTION  
**ARLINGTON STAGING AREA**  
 ARLINGTON STATION  
 SEWARD AVENUE, LOS ANGELES, CALIF.  
 SECTION NO. 3

SCALE: 1/4" = 10'-0" IN 17 SHEETS SHEET NO. 5  
 GRAPHIC SCALE: \_\_\_\_\_ FEET  
 U. S. ENGINEER OFFICE, LOS ANGELES, CALIF., JUN 1942

SUBMITTED BY: *W. Thompson* APPROVED BY: *W. C. Nelson*  
LT. COL. CHIEF, ENGINEERING DIVISION COLONEL, CHIEF OF ENGINEERS

FILE NO. 53274 DRAWN TRACED CHECKED TO COMPANY  
DATE: JULY 20, 1942



630  
308  
410

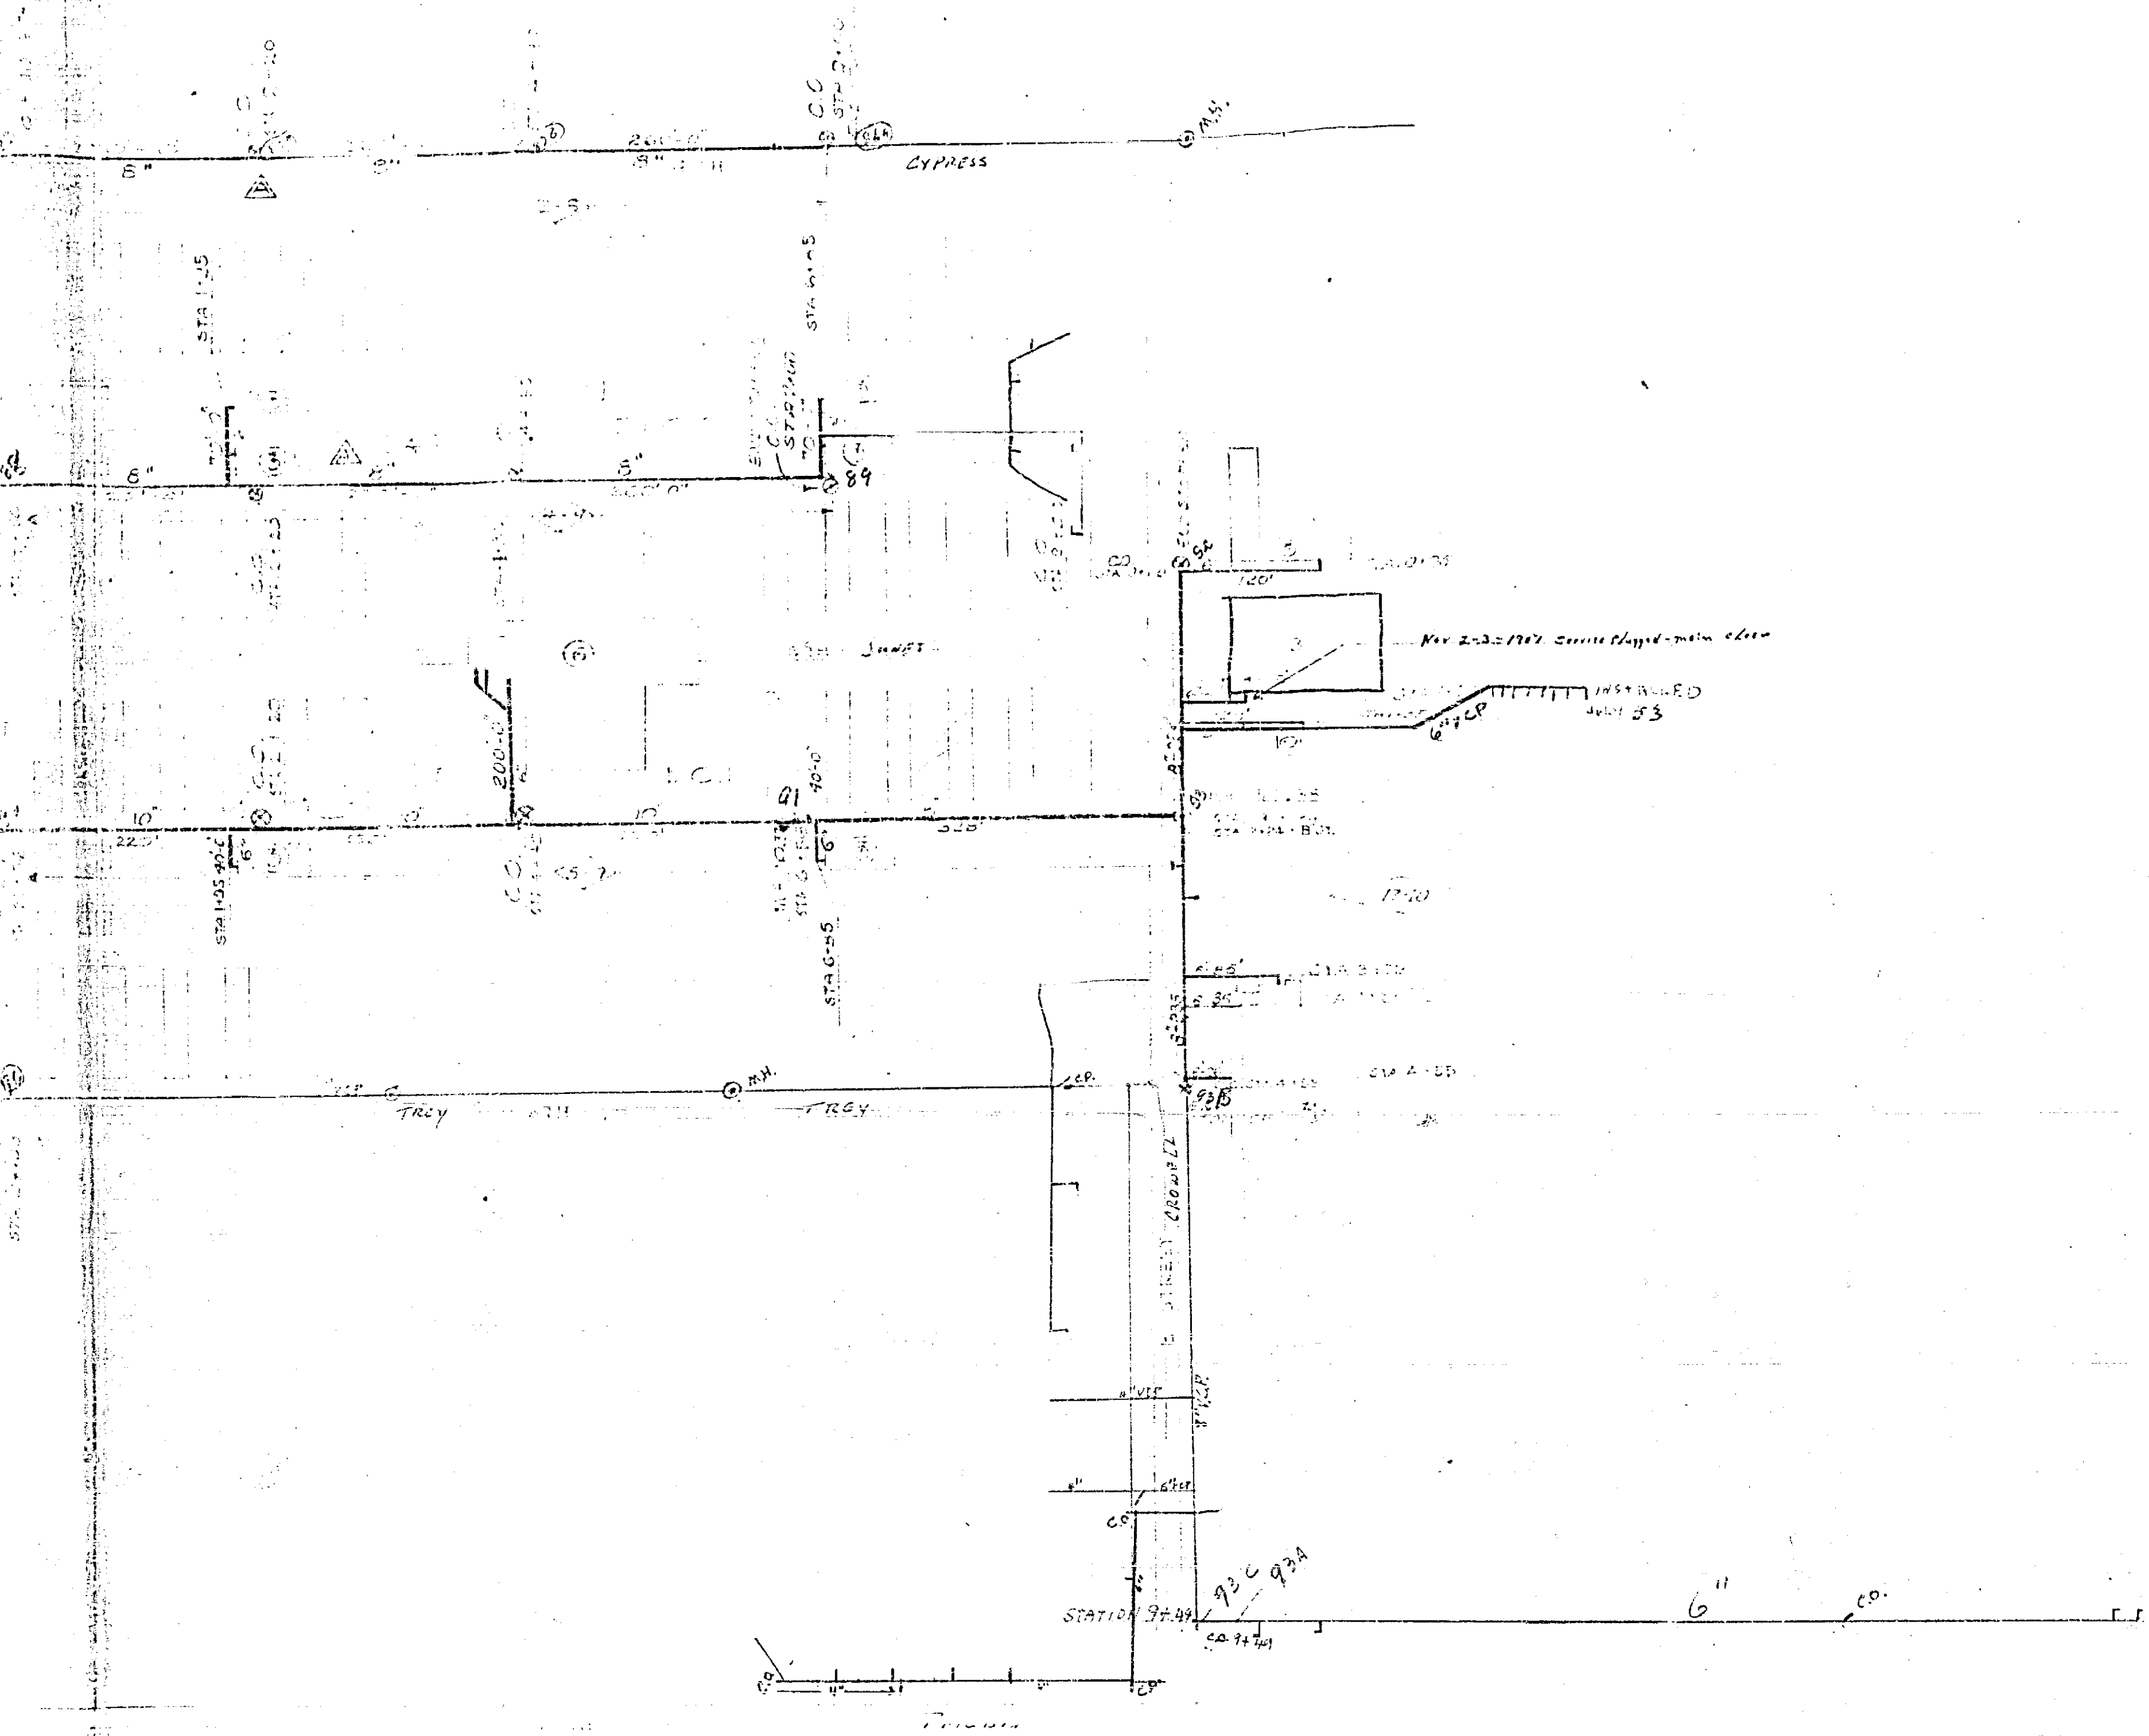

630

TRACED 11/30/52  
H. Ball

1001

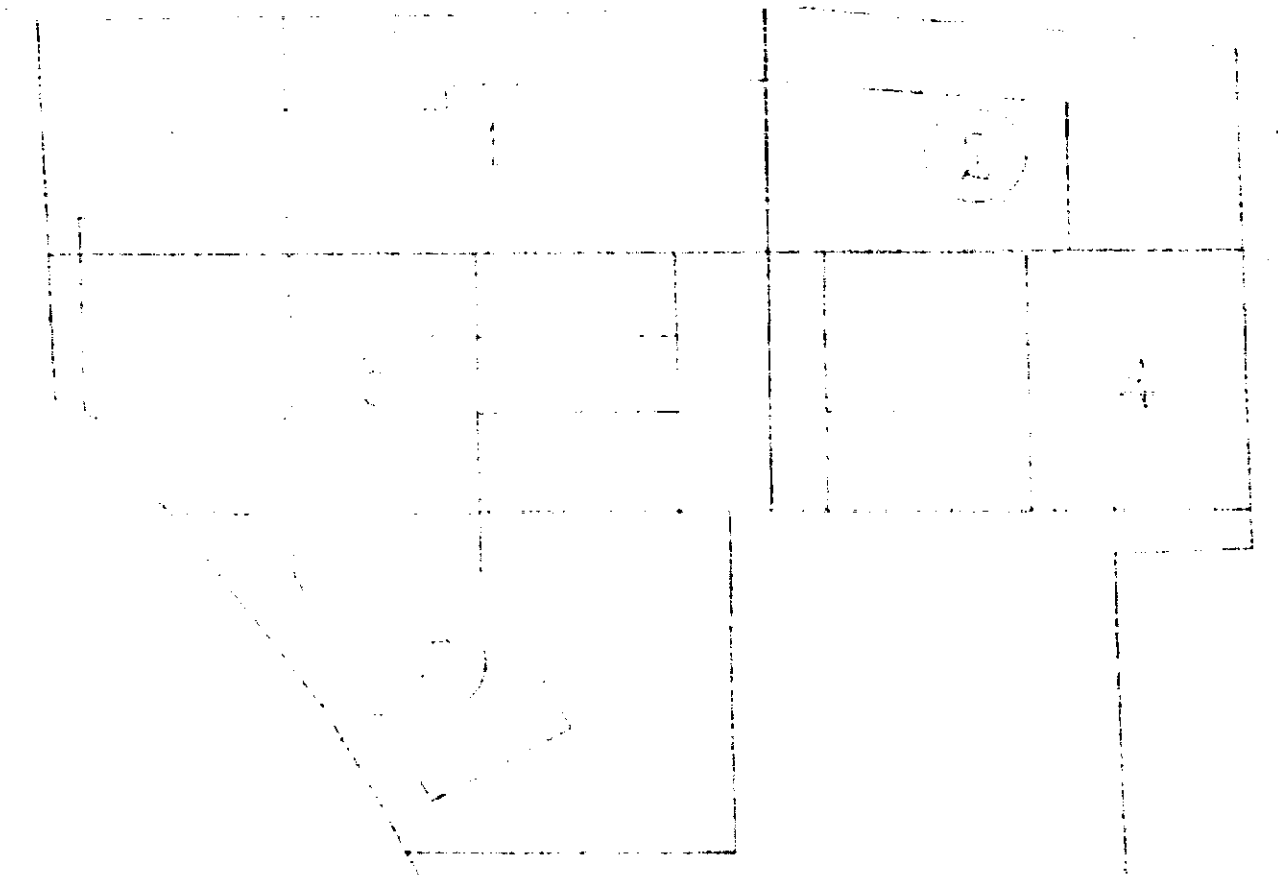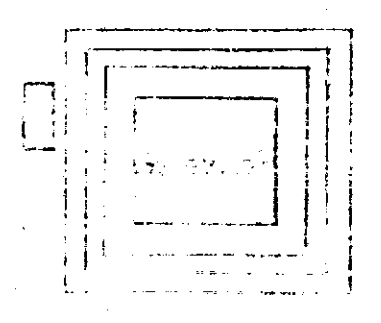

REV. NO.	DATE	REVISION	REV.	CHK.	APP.
1					
2					
3					
4					
5					
6					
7					
8					
9					
10					

MILITARY CONSTRUCTION

SCALE: 1" = 10' SHEETS SHEET NO. 17



GRAPHIC SCALE

U. S. ENGINEER OFFICE, LOS ANGELES, CALIF.

SUBMITTED BY: H. M. Thompson, CIVIL ENGINEER

APPROVED BY: [Signature]

FILE NO. DRAWN TRACED [ ] [ ] [ ] [ ] [ ] [ ] [ ] [ ] [ ] [ ]

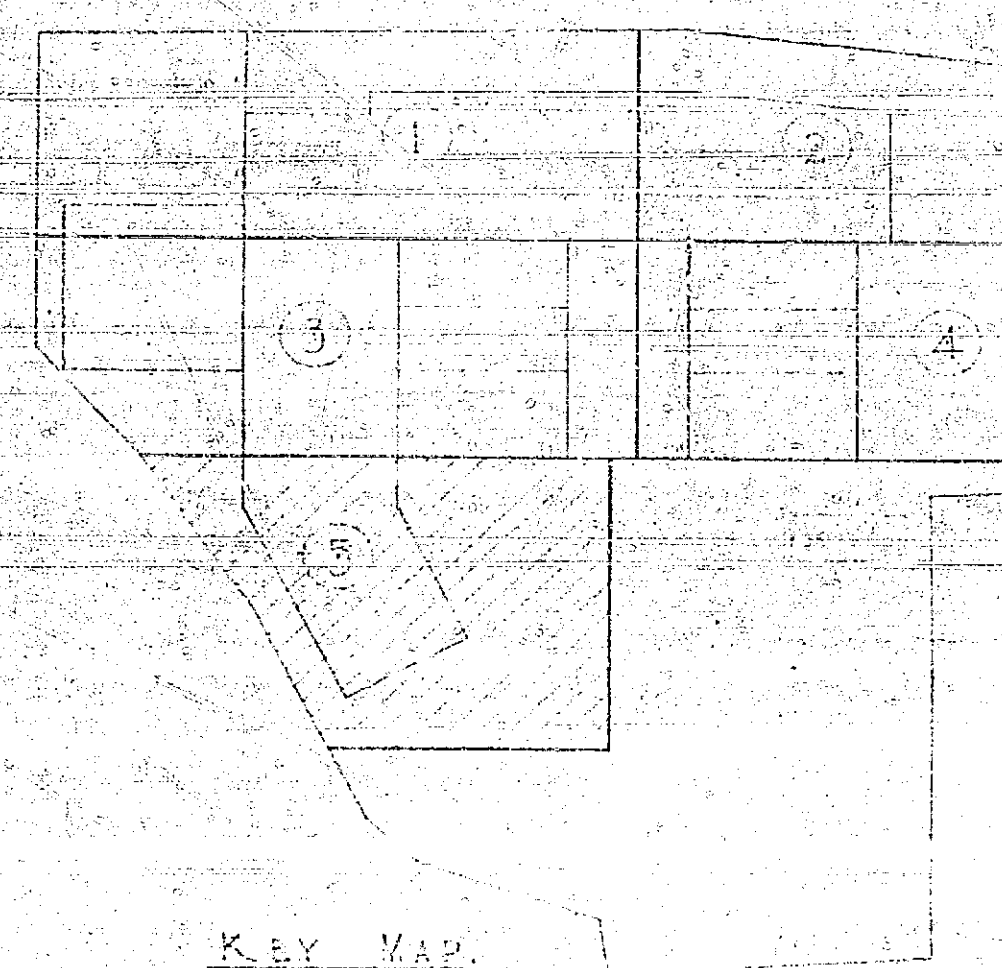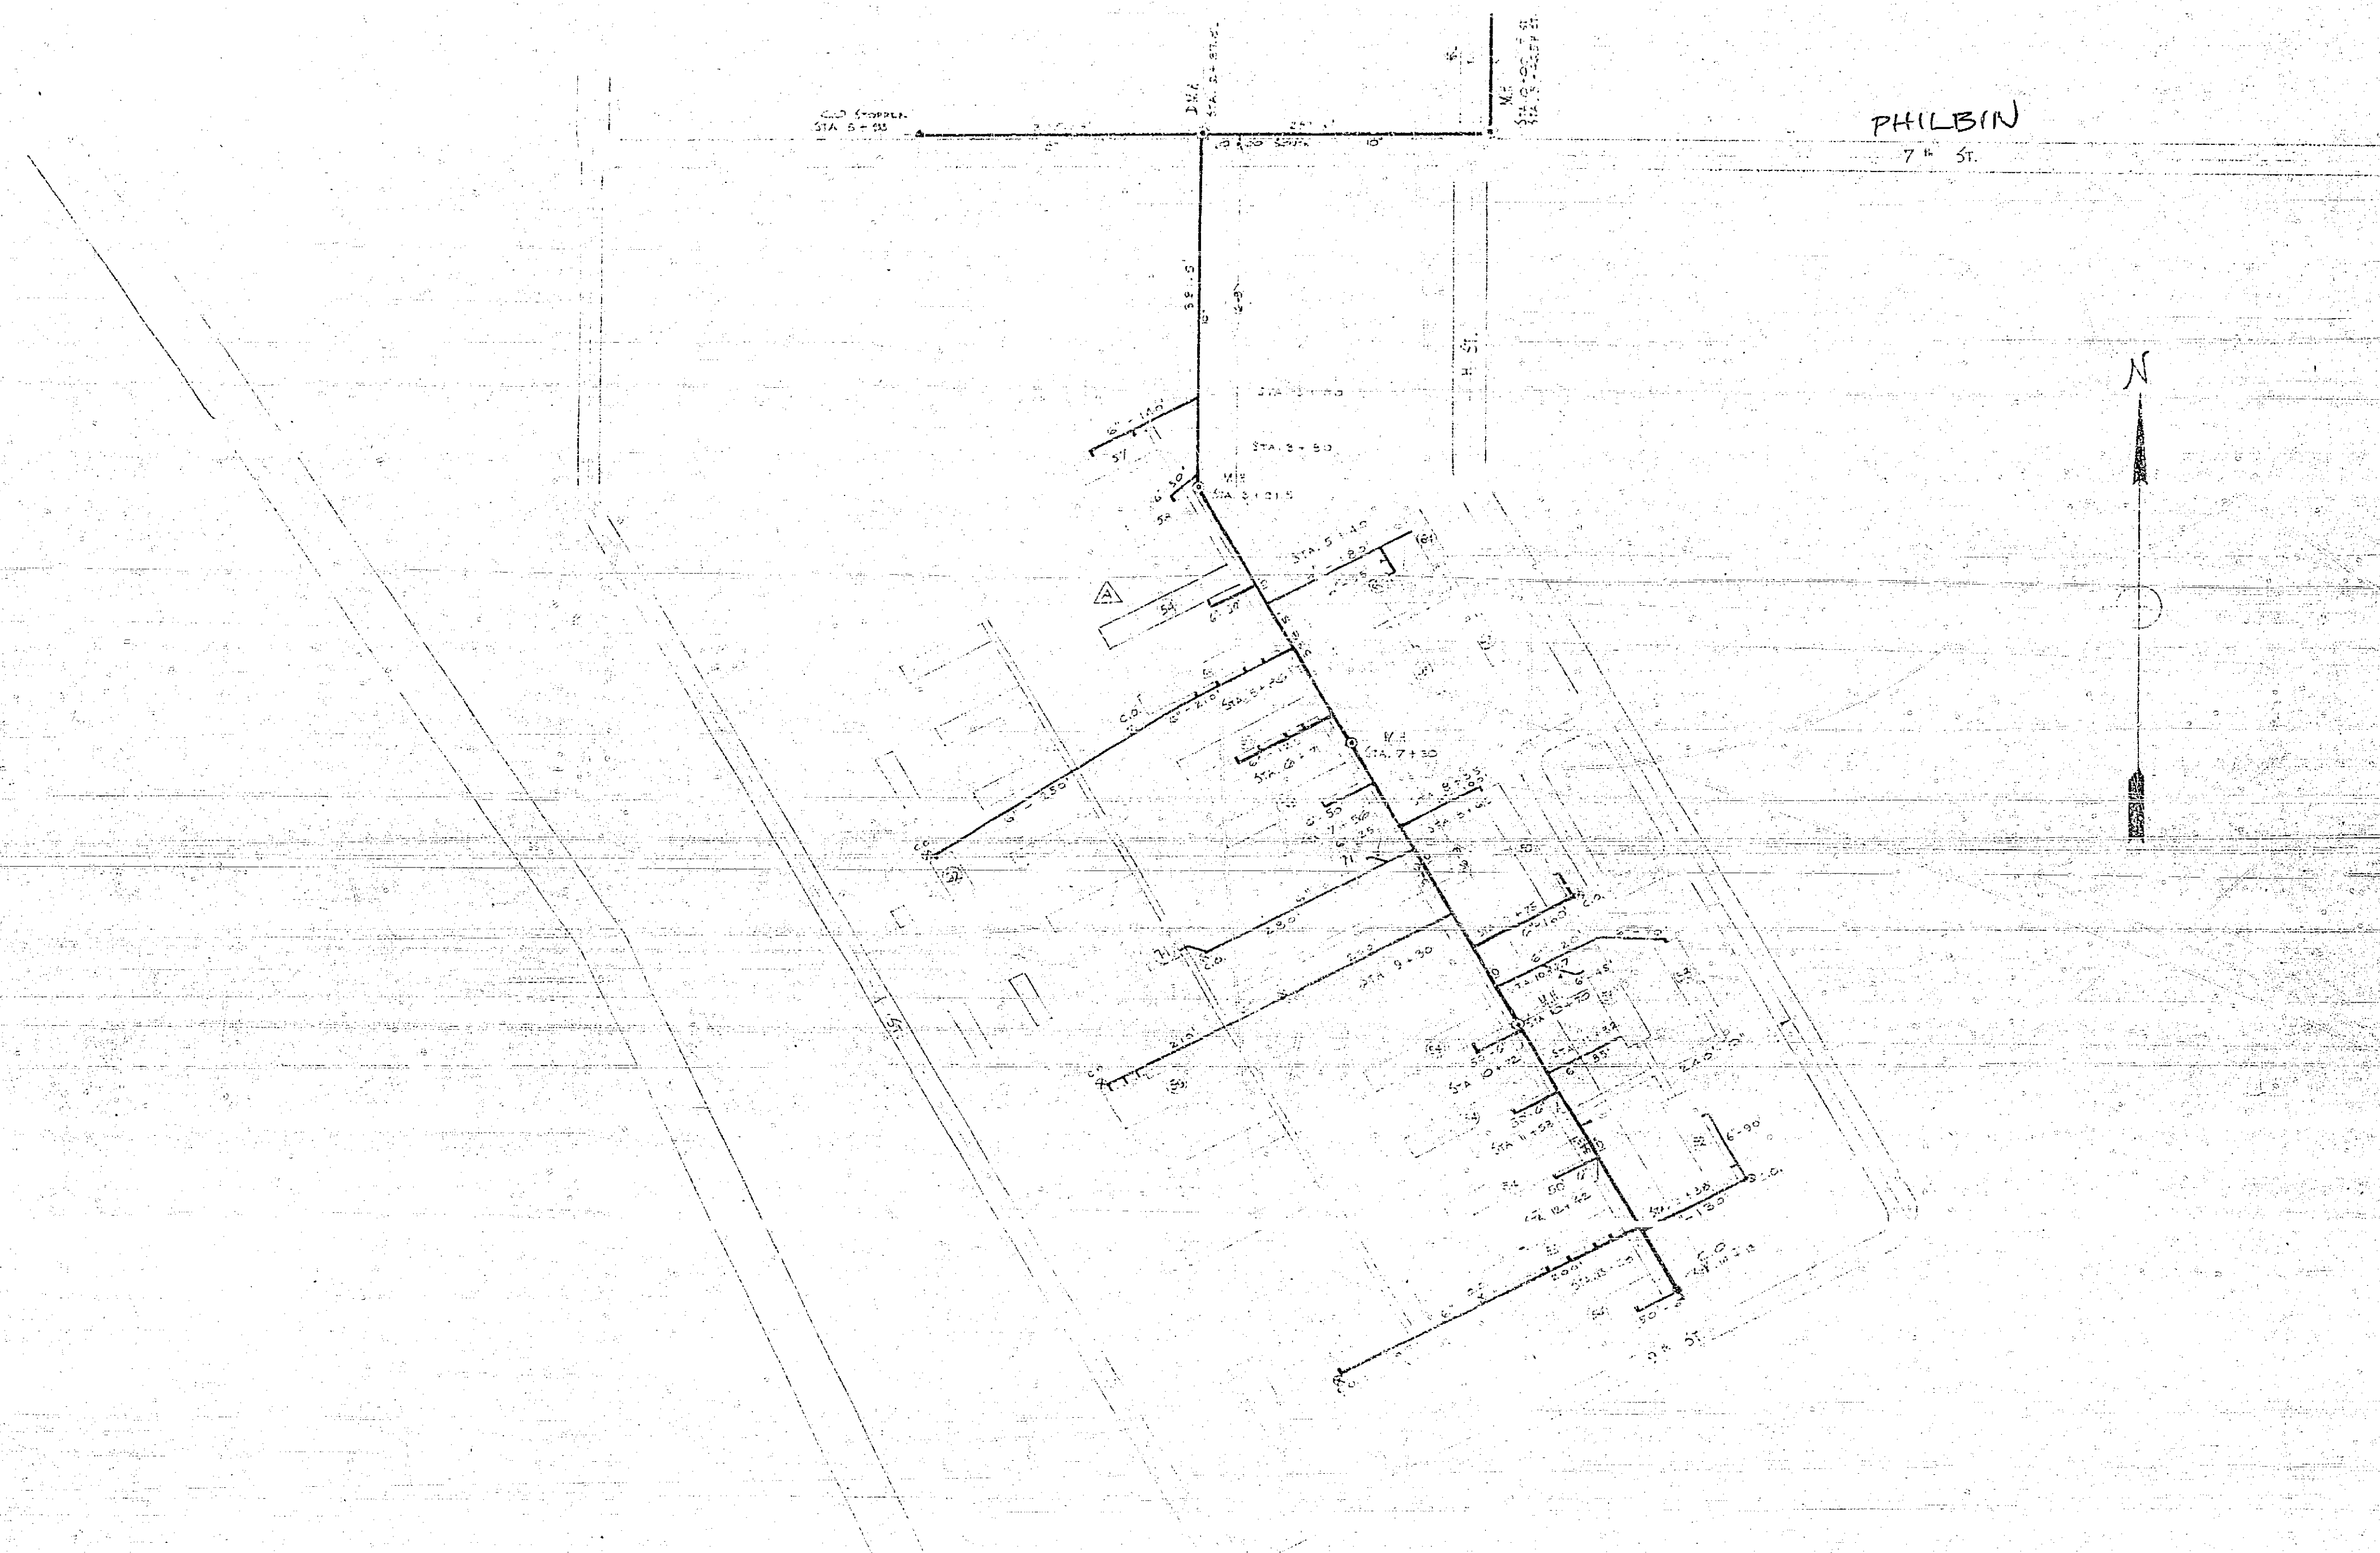

1001

REV. NO.	DATE	REVISION	REV. CHK.	APP.
1	7-24-58	Added Philbin and service	J.M.	W.F.

MILITARY CONSTRUCTION  
ARLINGTON STAGING AREA  
ARLINGTON CALIF.  
SEWAGE COLLECTION SYSTEM  
SECTION 5

SCALE: 1" = 100' IN 17 SHEETS SHEET NO. 1  
GRAPHIC SCALE FEET  
U. S. ENGINEER OFFICE, LOS ANGELES, CALIF.

SUBMITTED BY: *H. Thompson*  
CHIEF ENGINEER DIVISION

APPROVED BY: *W. C. Nelson*  
CHIEF ENGINEER

FILE NO.	DRAWN	TRACKED	CHECKED	TO ACCOMPANY
				DATED: 28-17


**SEWAGE TREATMENT PLANT**

SHEET 1001

LOCATION PLAN BETWEEN SANTA ANA RIVER & SEWAGE COLLECTION SYSTEM

PLANT LAYOUT

PRIMARY CLARIFIER PLANS & DETAILS

SECONDARY CLARIFIER PLANS & DETAILS

PRIMARY & SECONDARY BIO-FILTERS PLANS & DETAILS

DIGESTER PLANS & DETAILS


PUMP PLANT & BOILER HOUSE LAYOUT PLANS & DETAILS

DETAILS OF PALMER BOWLUS WEIR, CHAMBER ON BOILER AND TANK

SCREEN, Grit CHAMBER & DIVISION BOX

BOILER HOUSE PIPING

SLUDGE BEDS PLANS & SECTIONS

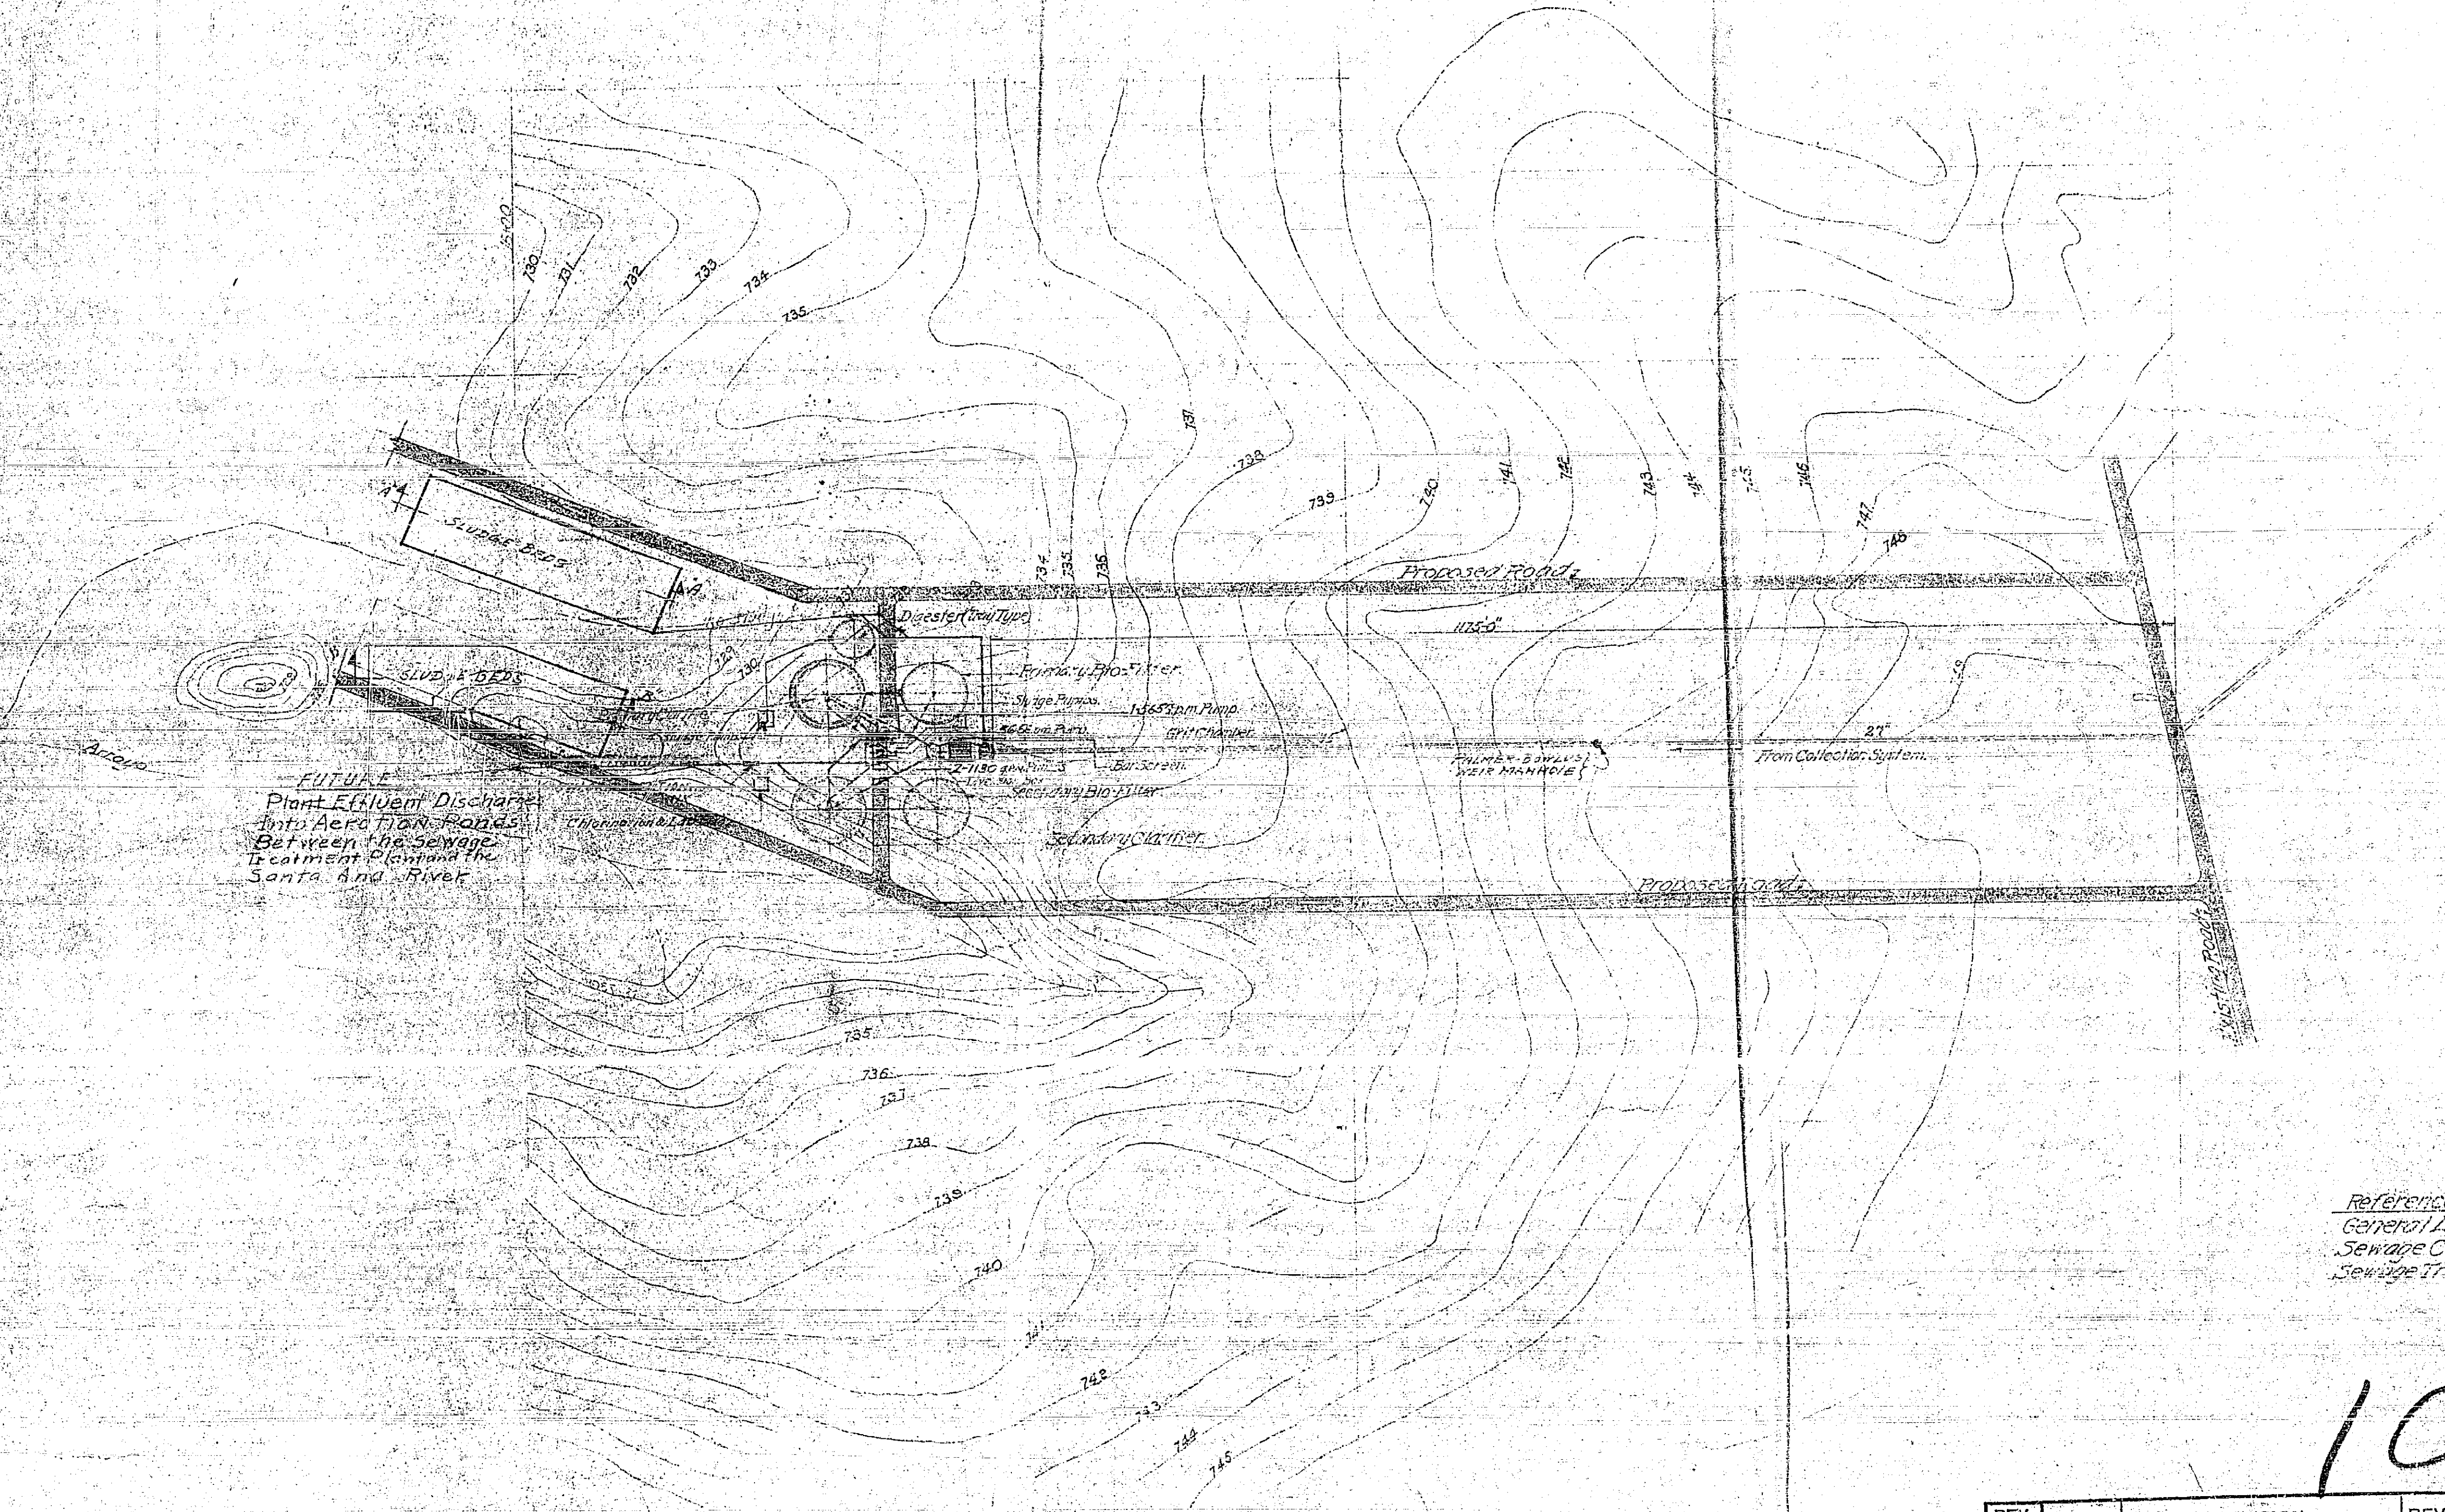

References  
 General Layout Plan Sewage System  
 Sewage Collecting System Index Map  
 Sewage Treatment Plant Layout

1001 2500

REV. NO.	DATE	REVISION	REV.	CHK.	APP.

MILITARY  
**ARLINGTON**  
 ART  
**SEWAGE**  
 LOCATION PLAN  
 SCALE: 1"=100'-0"  
 GRAPHIC SCALE  
 U. S. ENGINEERING  
 SUBMIT  
 FILE NO.