
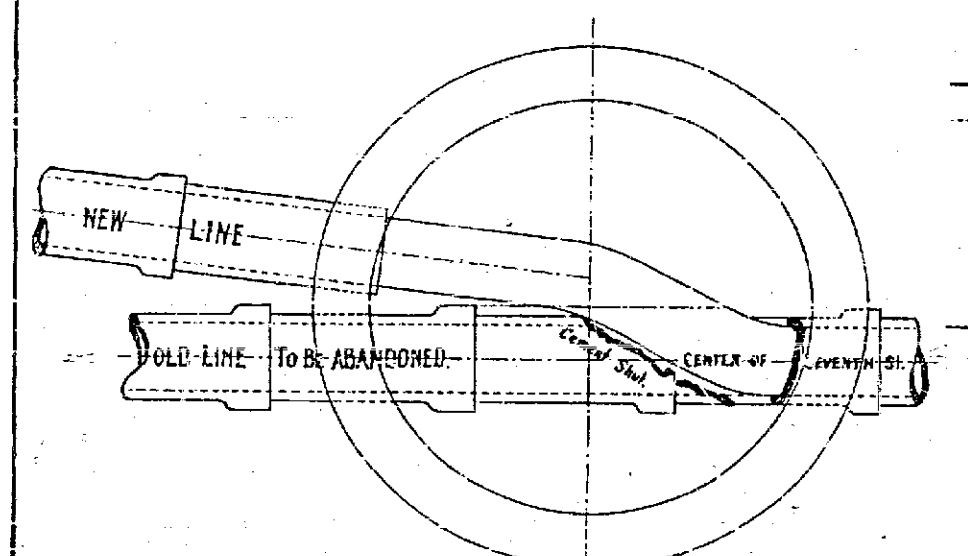


MAP OF FIRST ST. AND BLAINE ST. SEWER.

Scale of Map, 1 in = 200 feet
Scale of Profile, 1 in = 100 feet
1 in 1000 = 1 ft.

DISTRICT BENEFITED IS BOUNDED BY A GREEN BAND THUS:—
Sewer to be constructed is shown thus:—
is shown thus:—

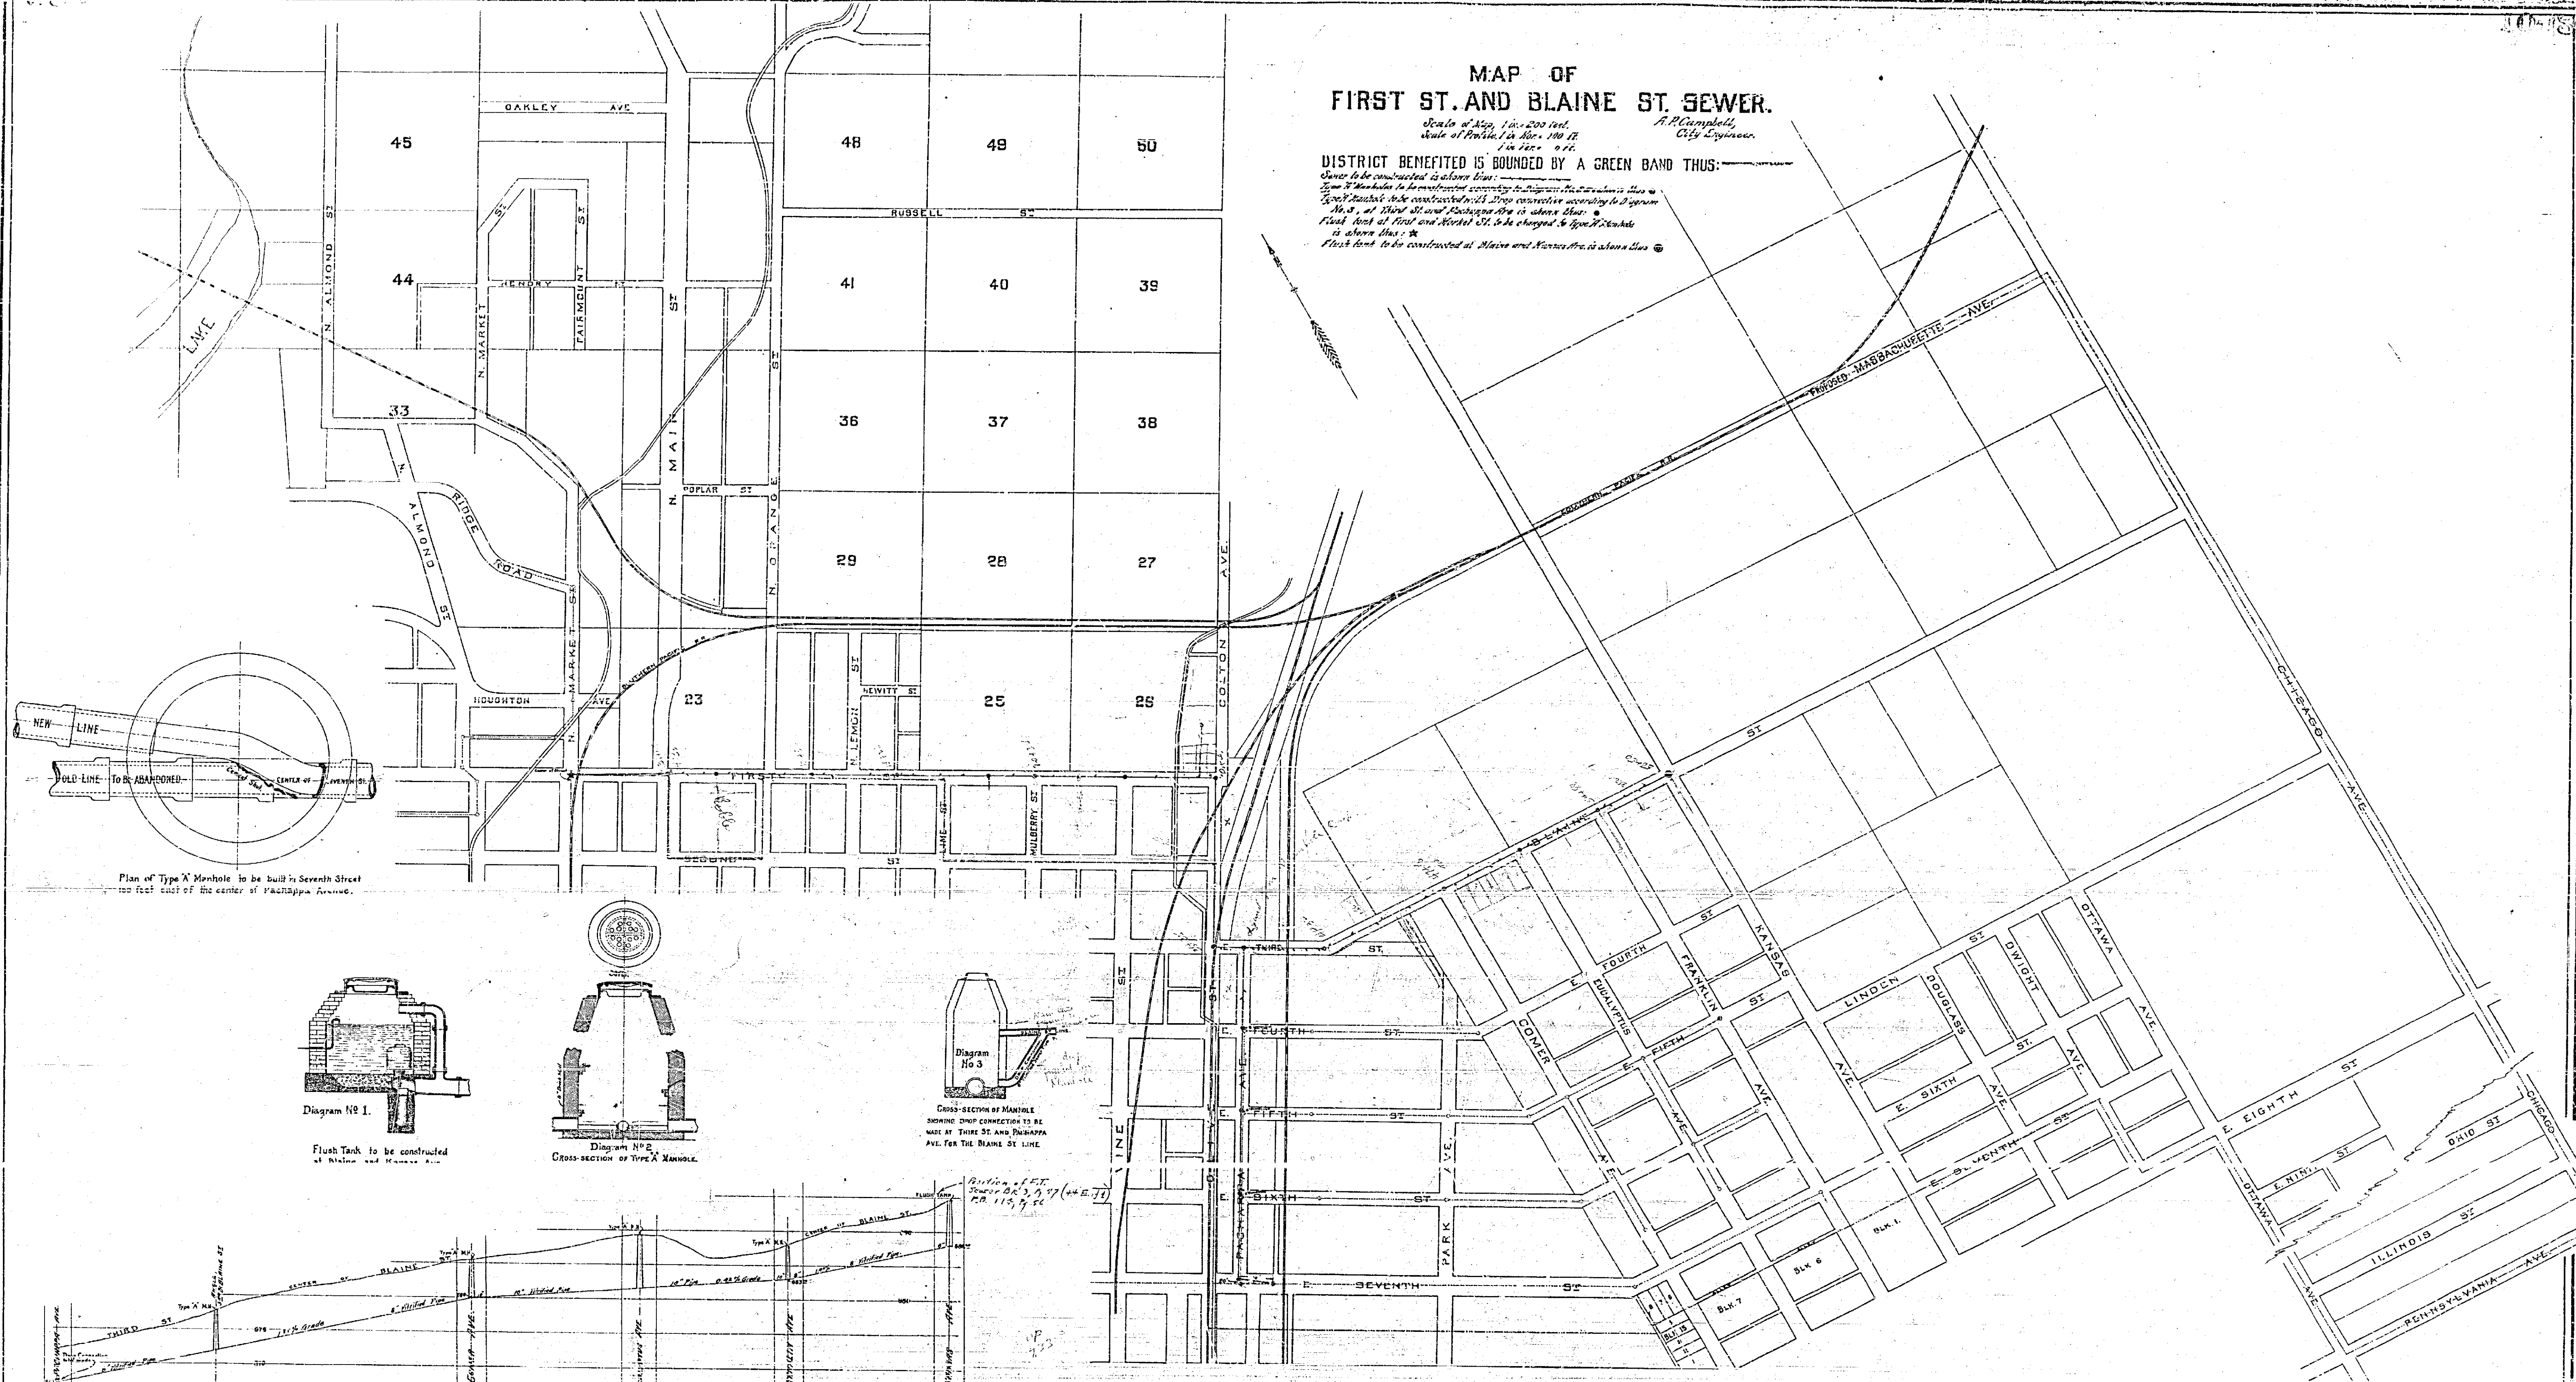


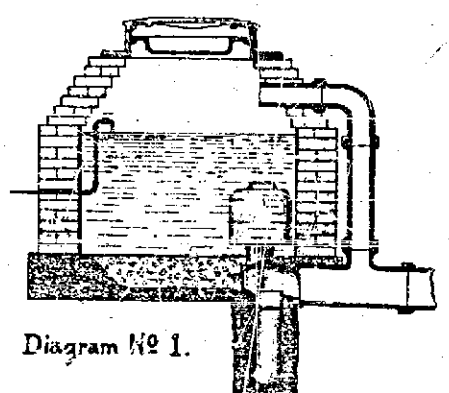


Diagram No. 1.

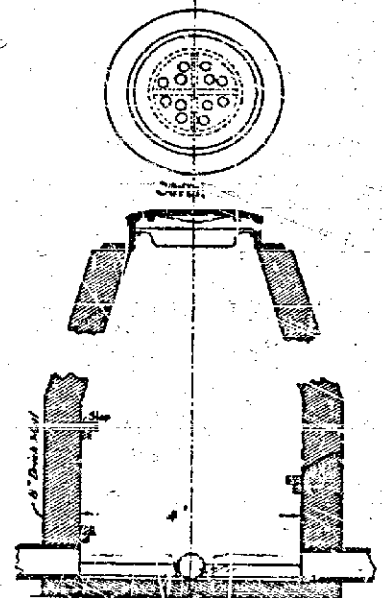


Diagram No. 2.


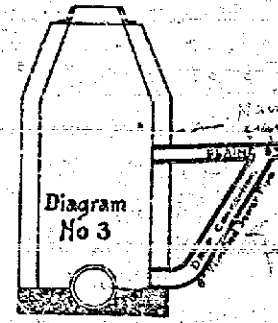


Diagram No. 3.

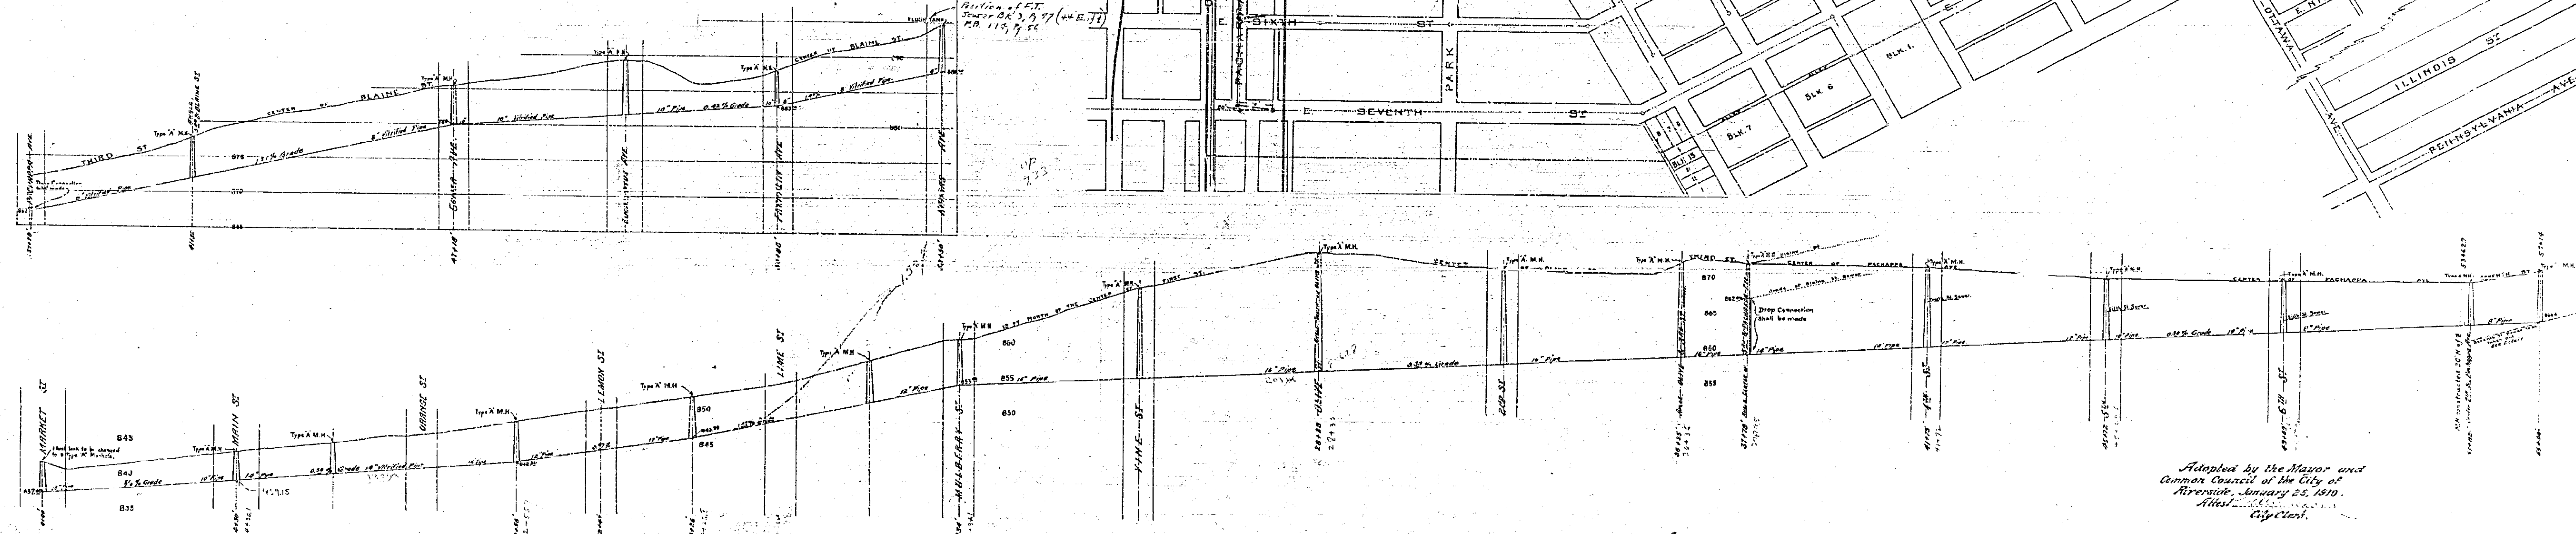

Adopted by the Mayor and
Common Council of the City of
Attest: _____
City Clerk.