



**CARLTON PLACE AND PRINCE ALBERT DRIVE  
STREET IMPROVEMENT**


OCT. 1929. R.E. BROWN CITY ENGINEER  
 CONSTRUCTED BY OWNERS  
 W.R. SCHOONOVER CARLTON PLACE. C.D. PERRY PRINCE ALBERT DRIVE

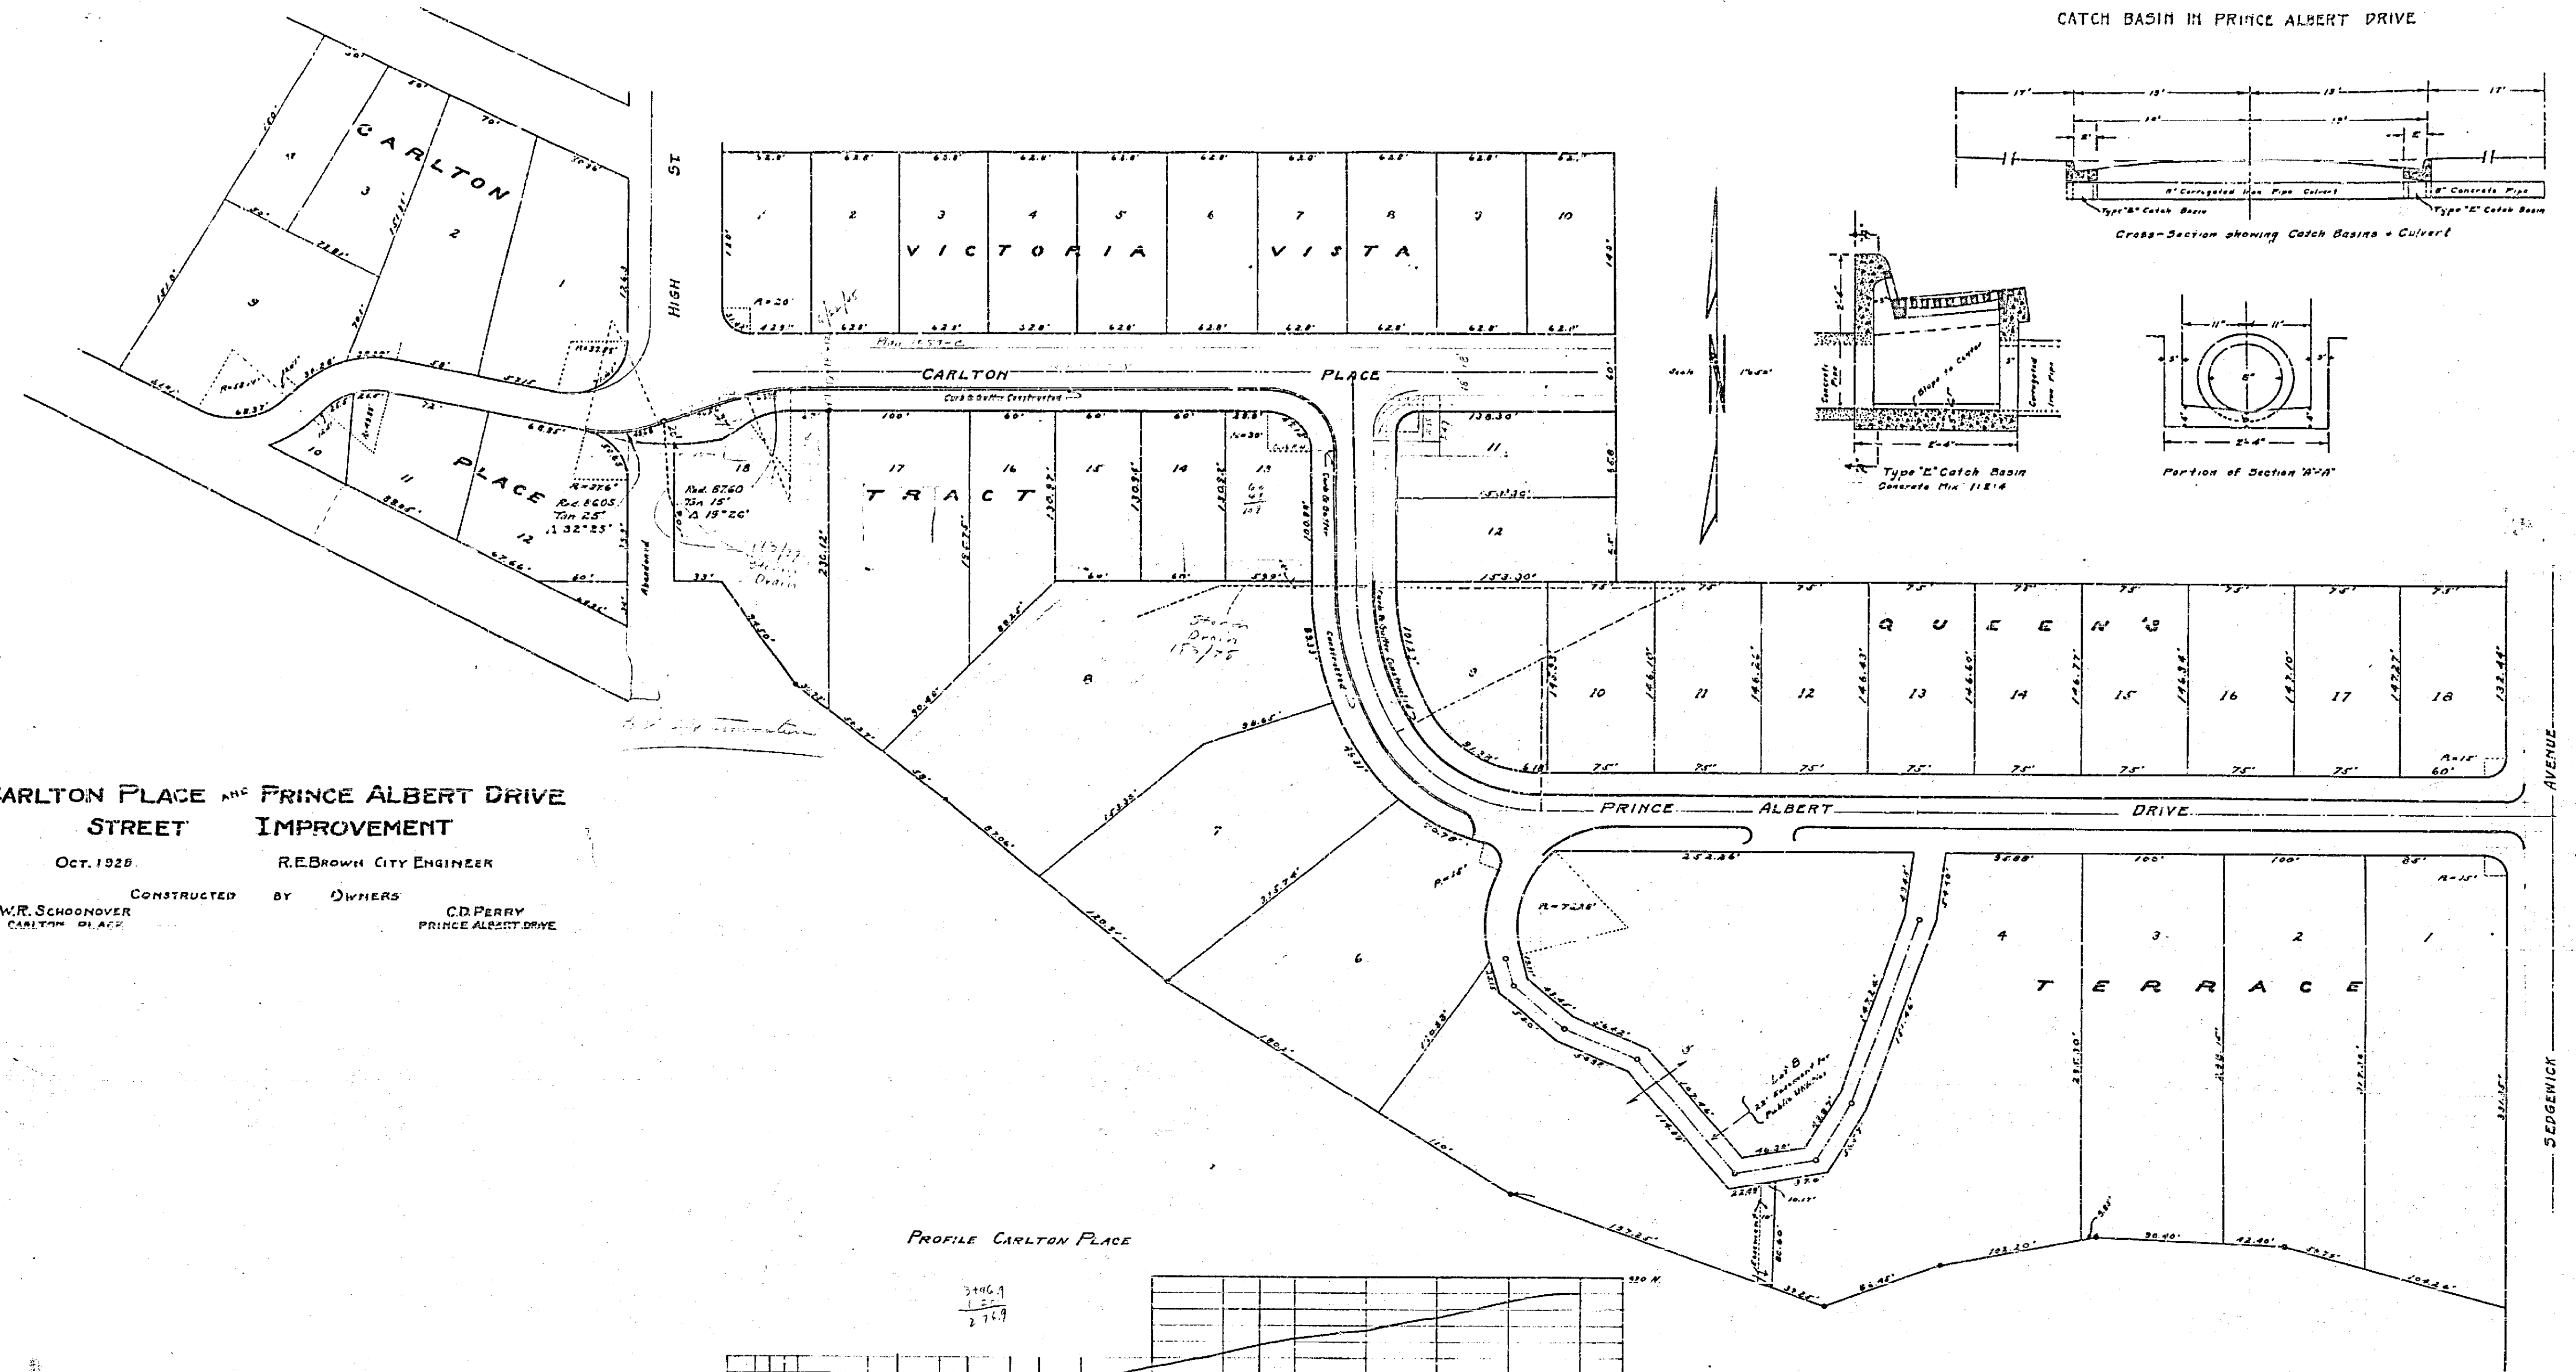

PROFILE CARLTON PLACE

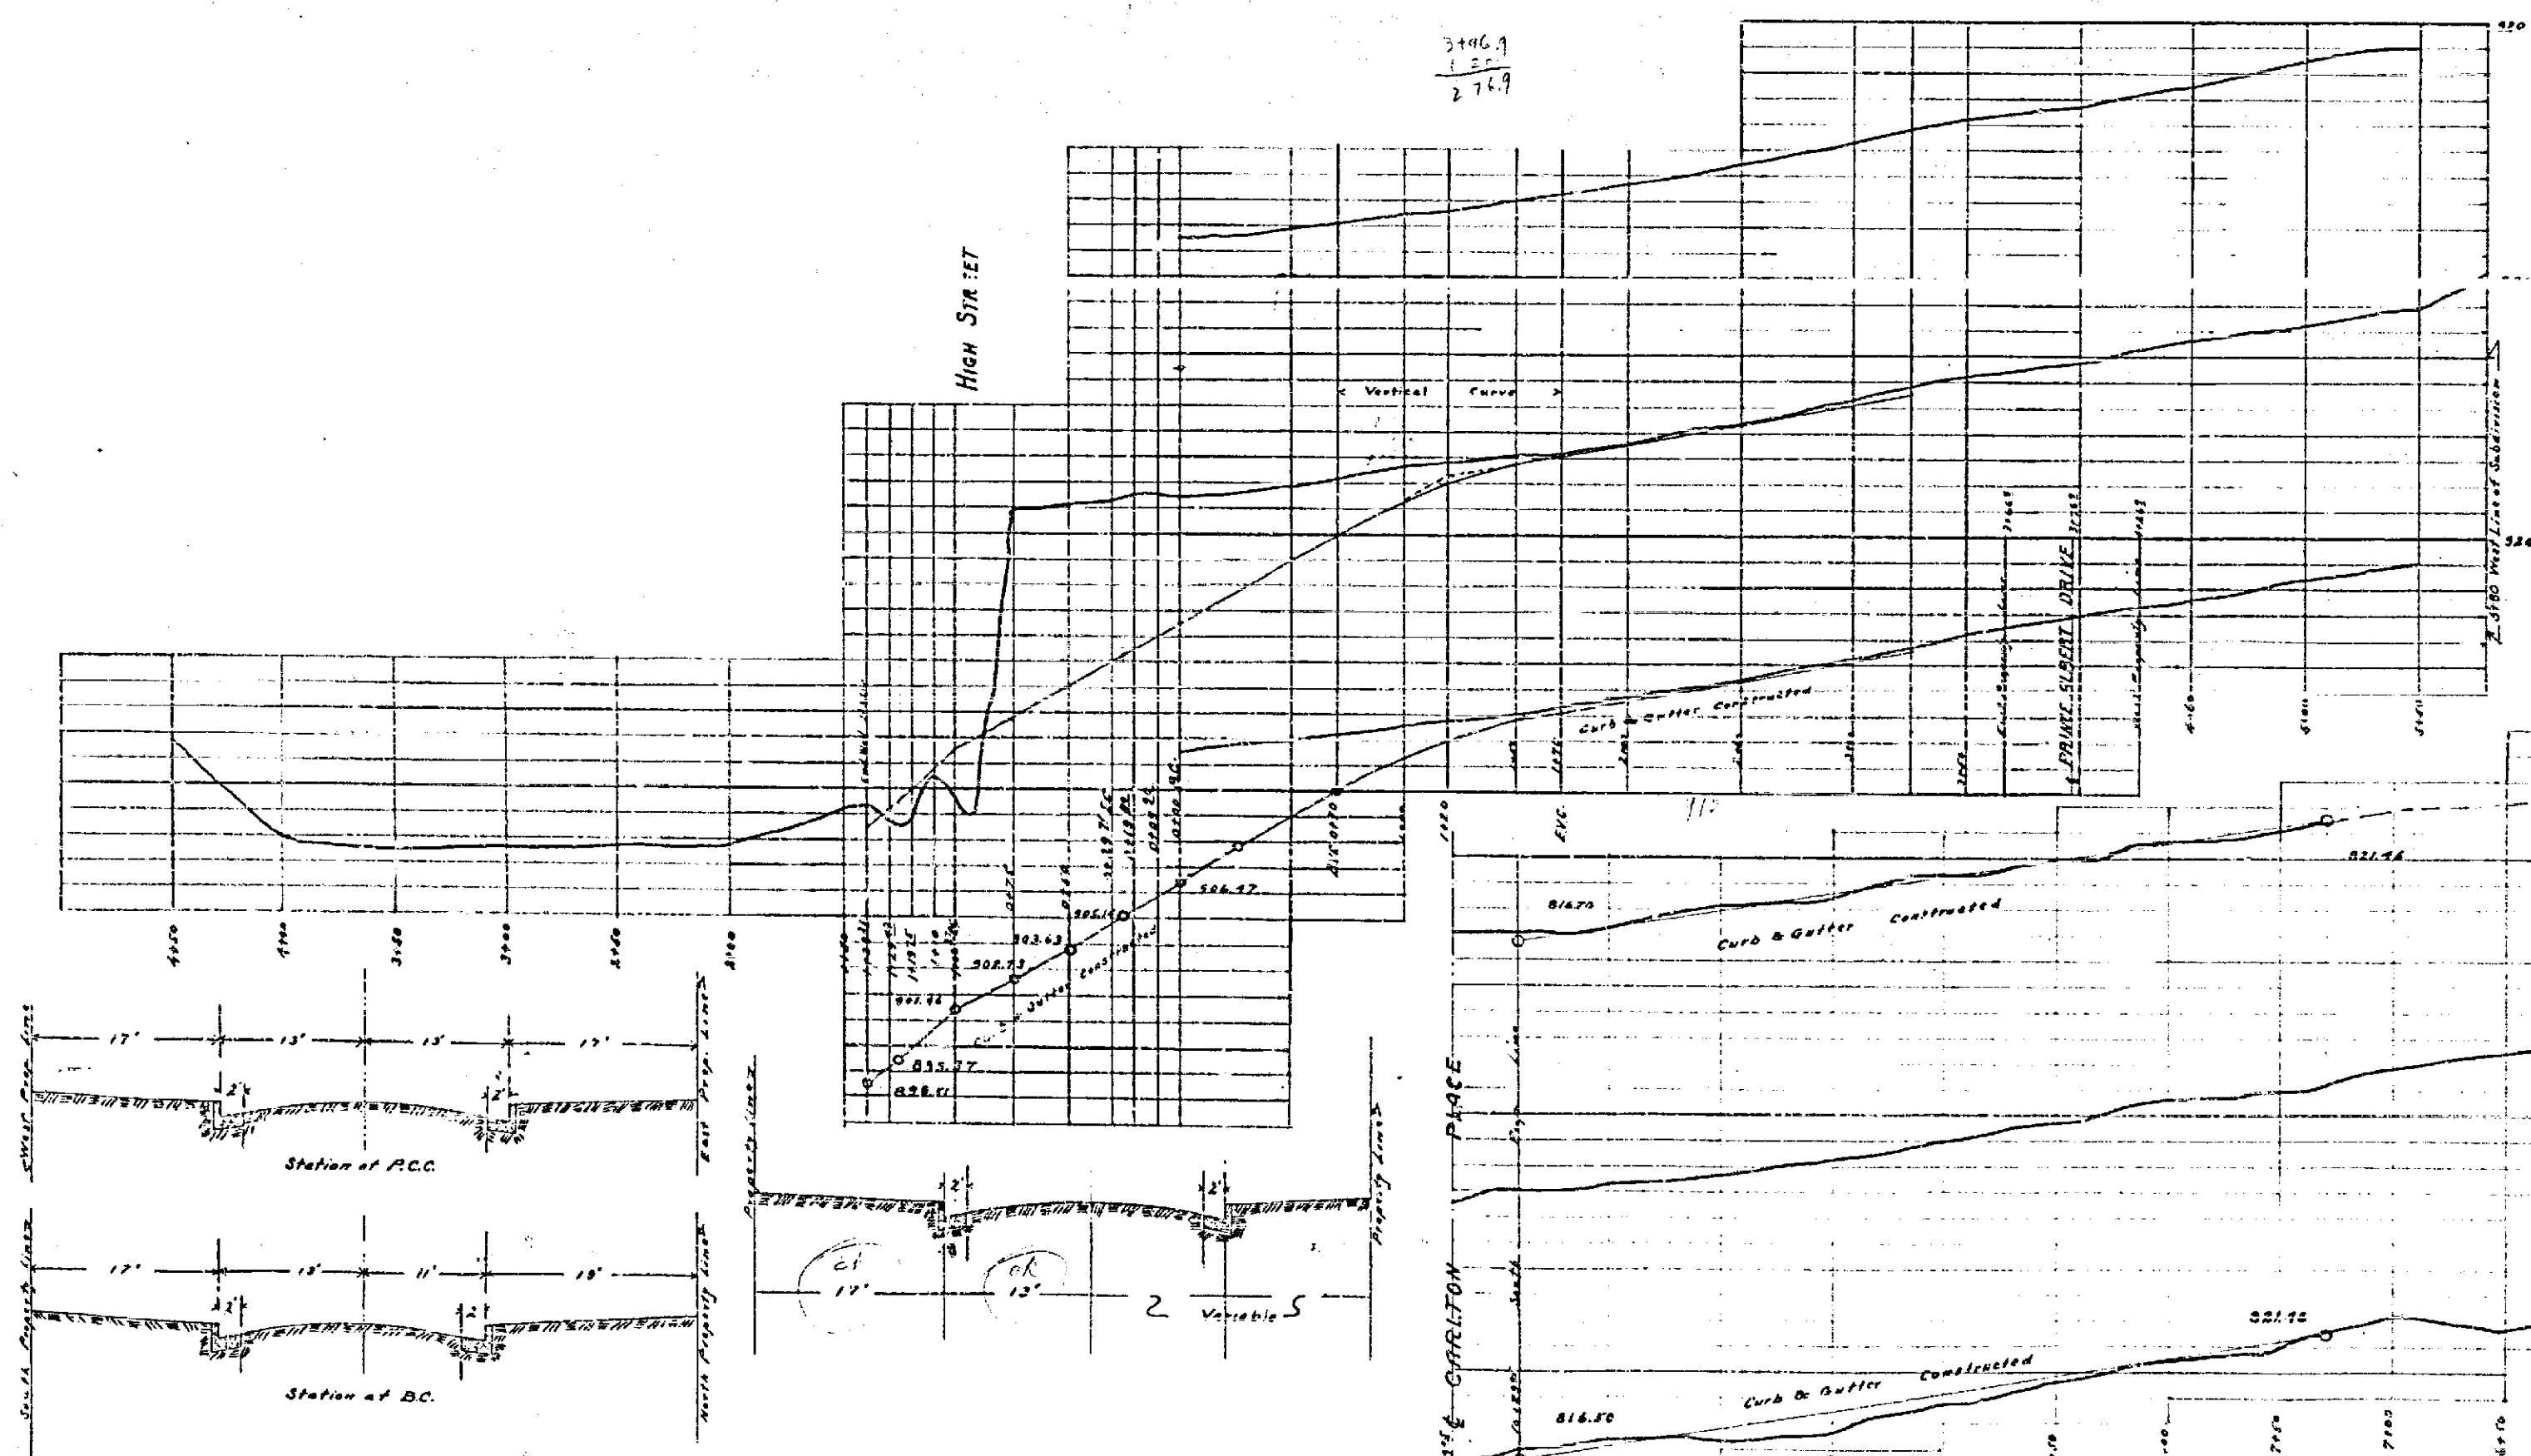

PROFILE PRINCE ALBERT DRIVE

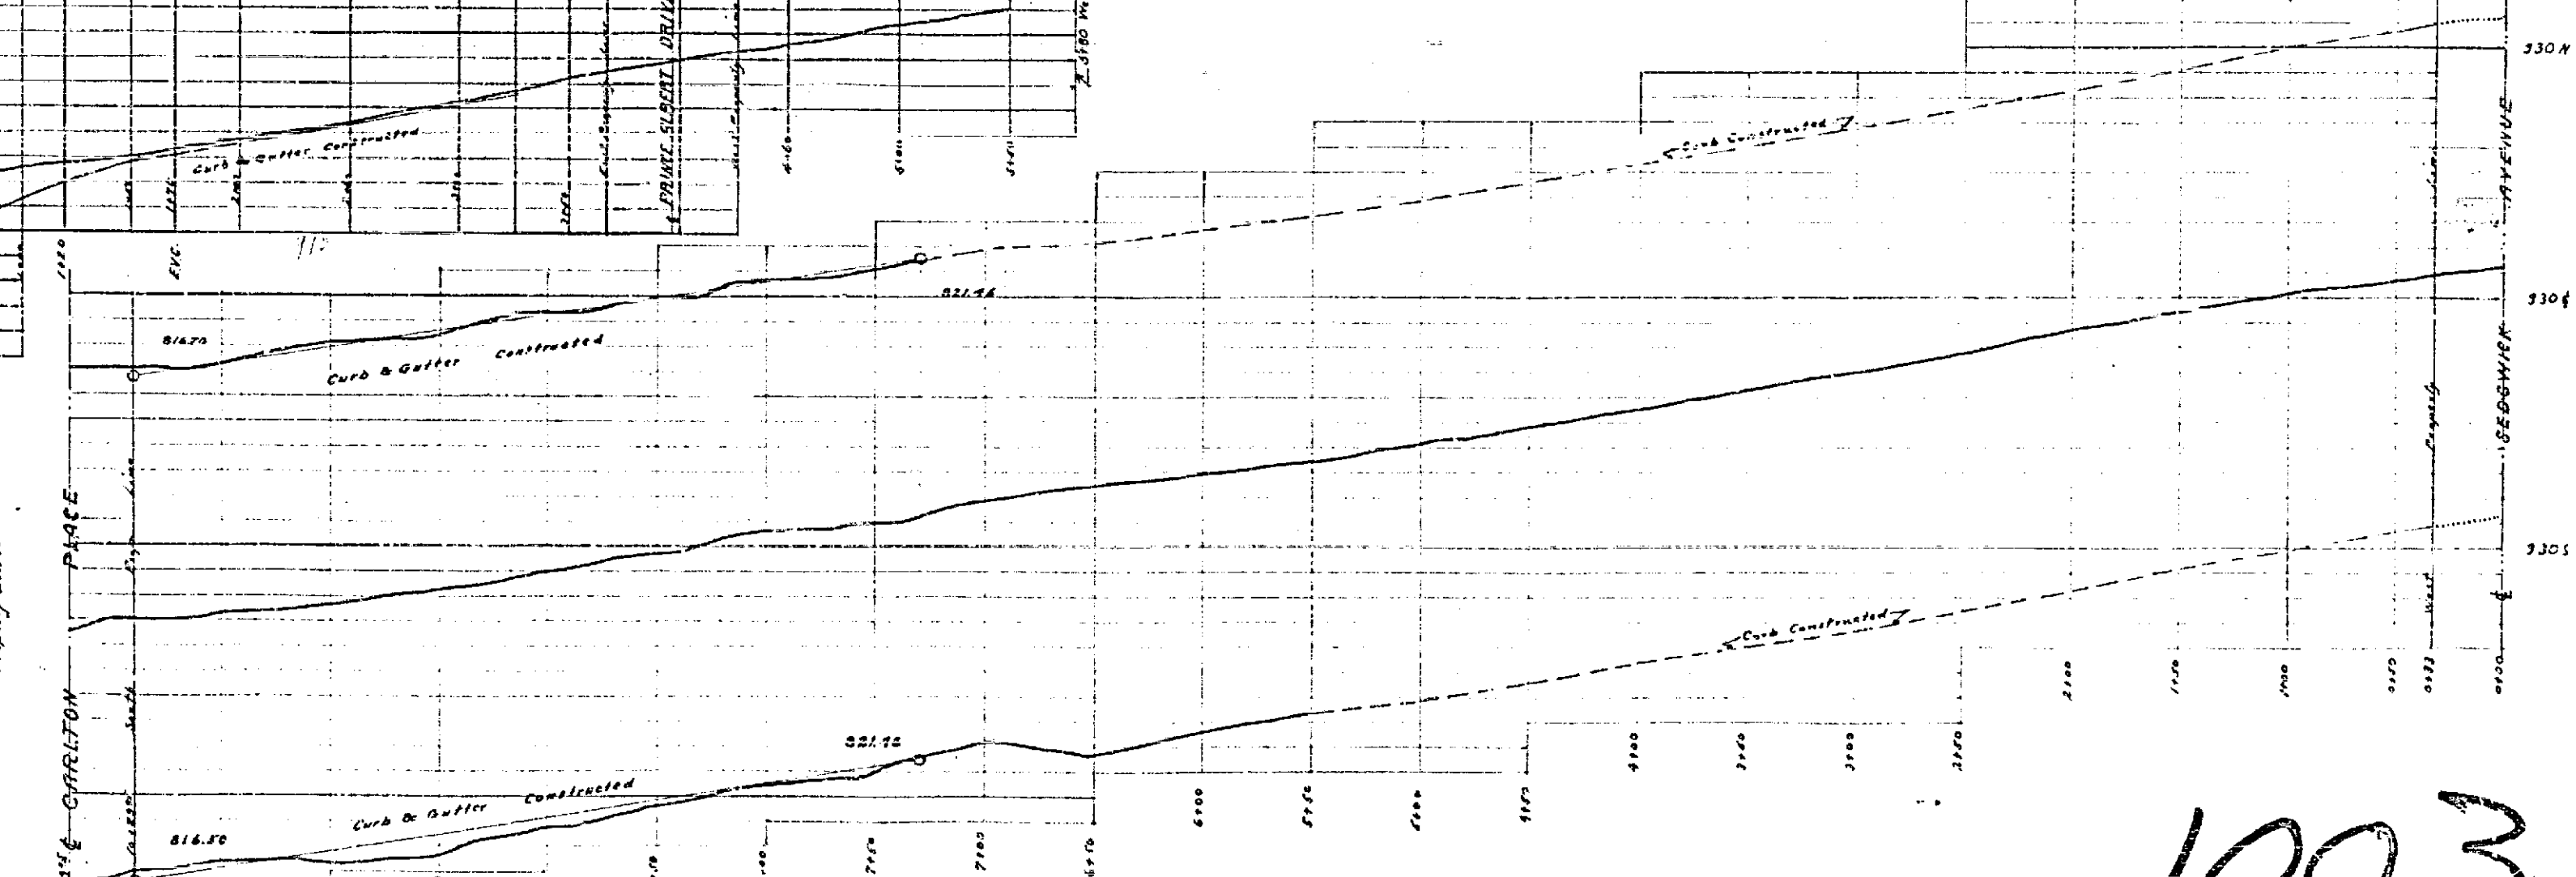

1003