

PLAN AND PROFILE

OF THE PROPOSED IMPROVEMENT ON

CEDAR STREET

BETWEEN 12TH ST. & 13TH ST.

ENGINEER DEPT. RIVERSIDE CALIF. 1936





CITY (U.S.G.S.) DATUM PLANE

FIELD BOOK 326 PAGES 44-50
 Const. by St. Dept. 1936

APPROVED _____
 CITY ENGINEER.

APPROVED AND ADOPTED BY THE MAYOR
 AND COUNCIL OF THE CITY OF RIVERSIDE
 THIS _____ DAY OF _____ 1936

 CITY CLERK, CITY OF RIVERSIDE.

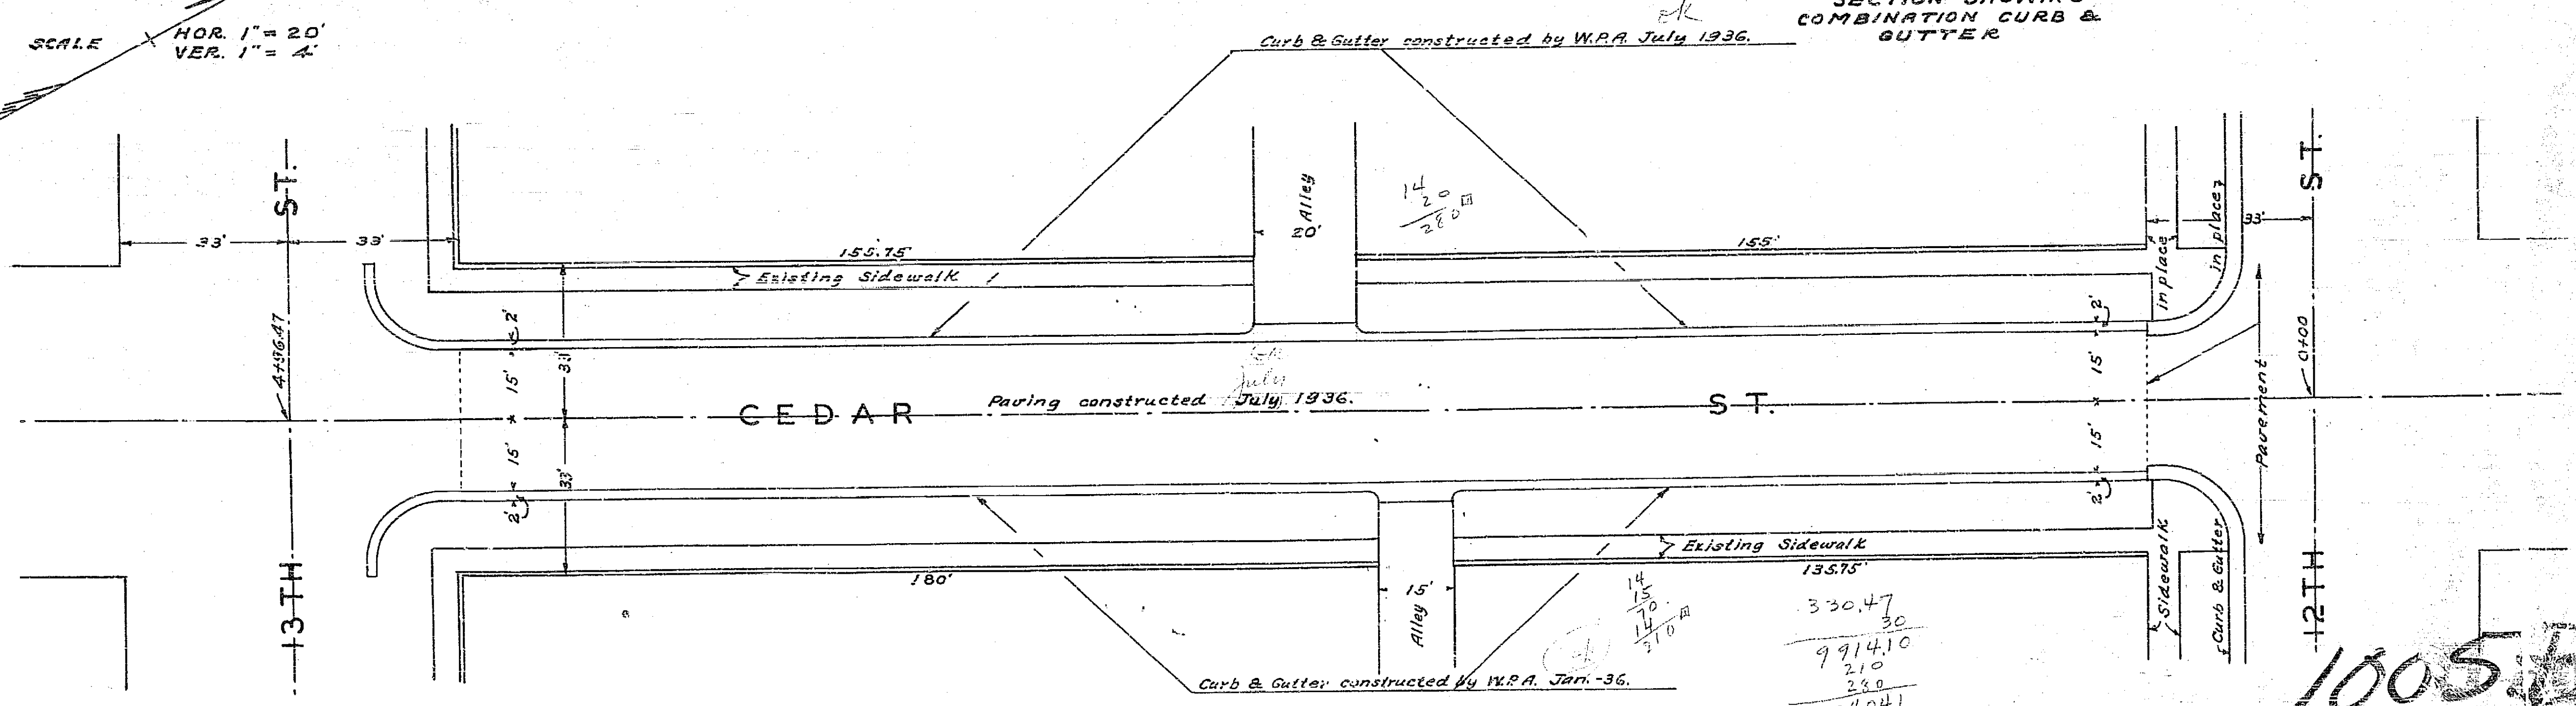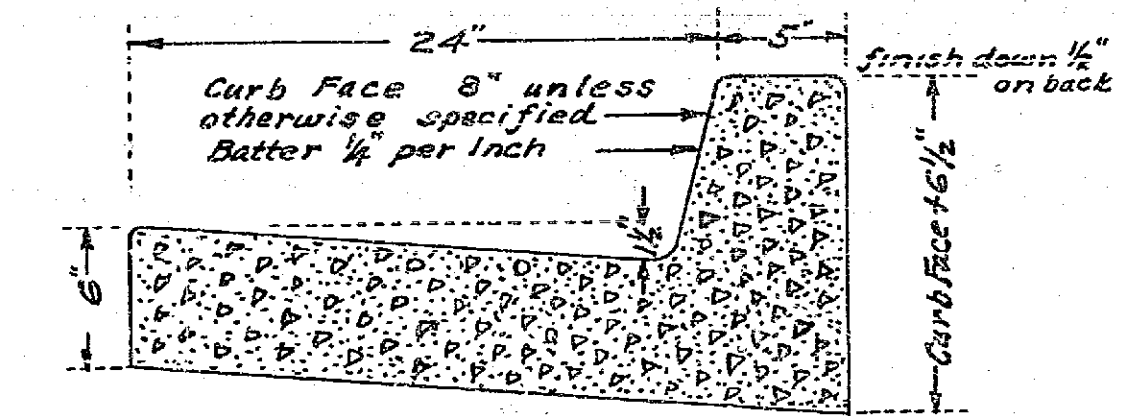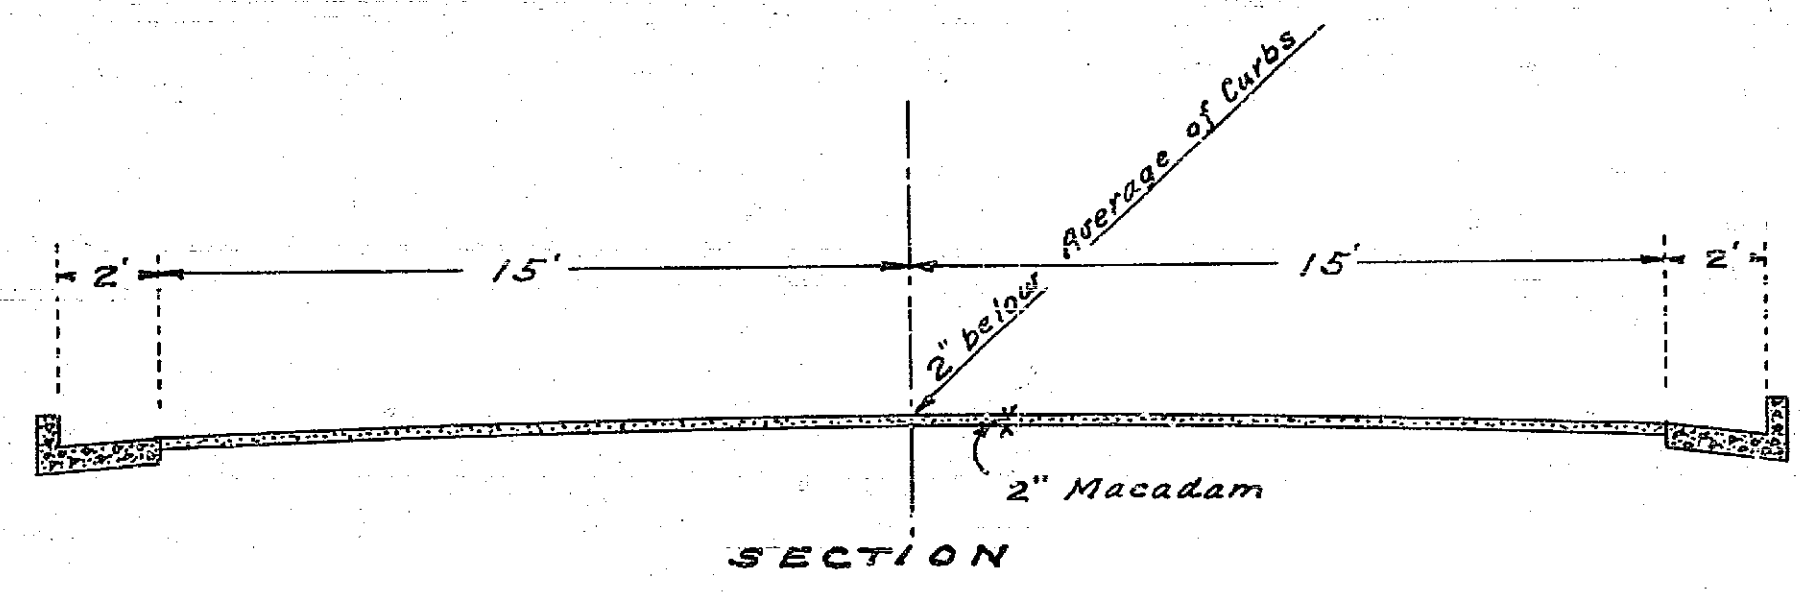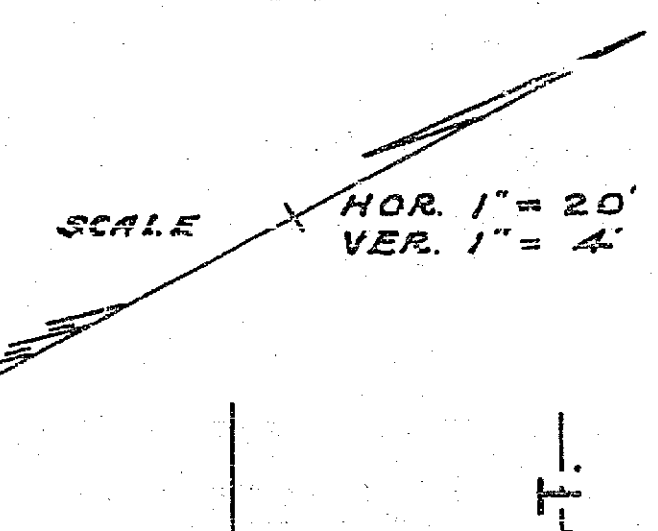

330.47
 30
 9914.10
 210
 230
 910404.1
 1156

1005-B