


Right Av. 115 1/2 Linden St.
BR 3-2, P. 22-28

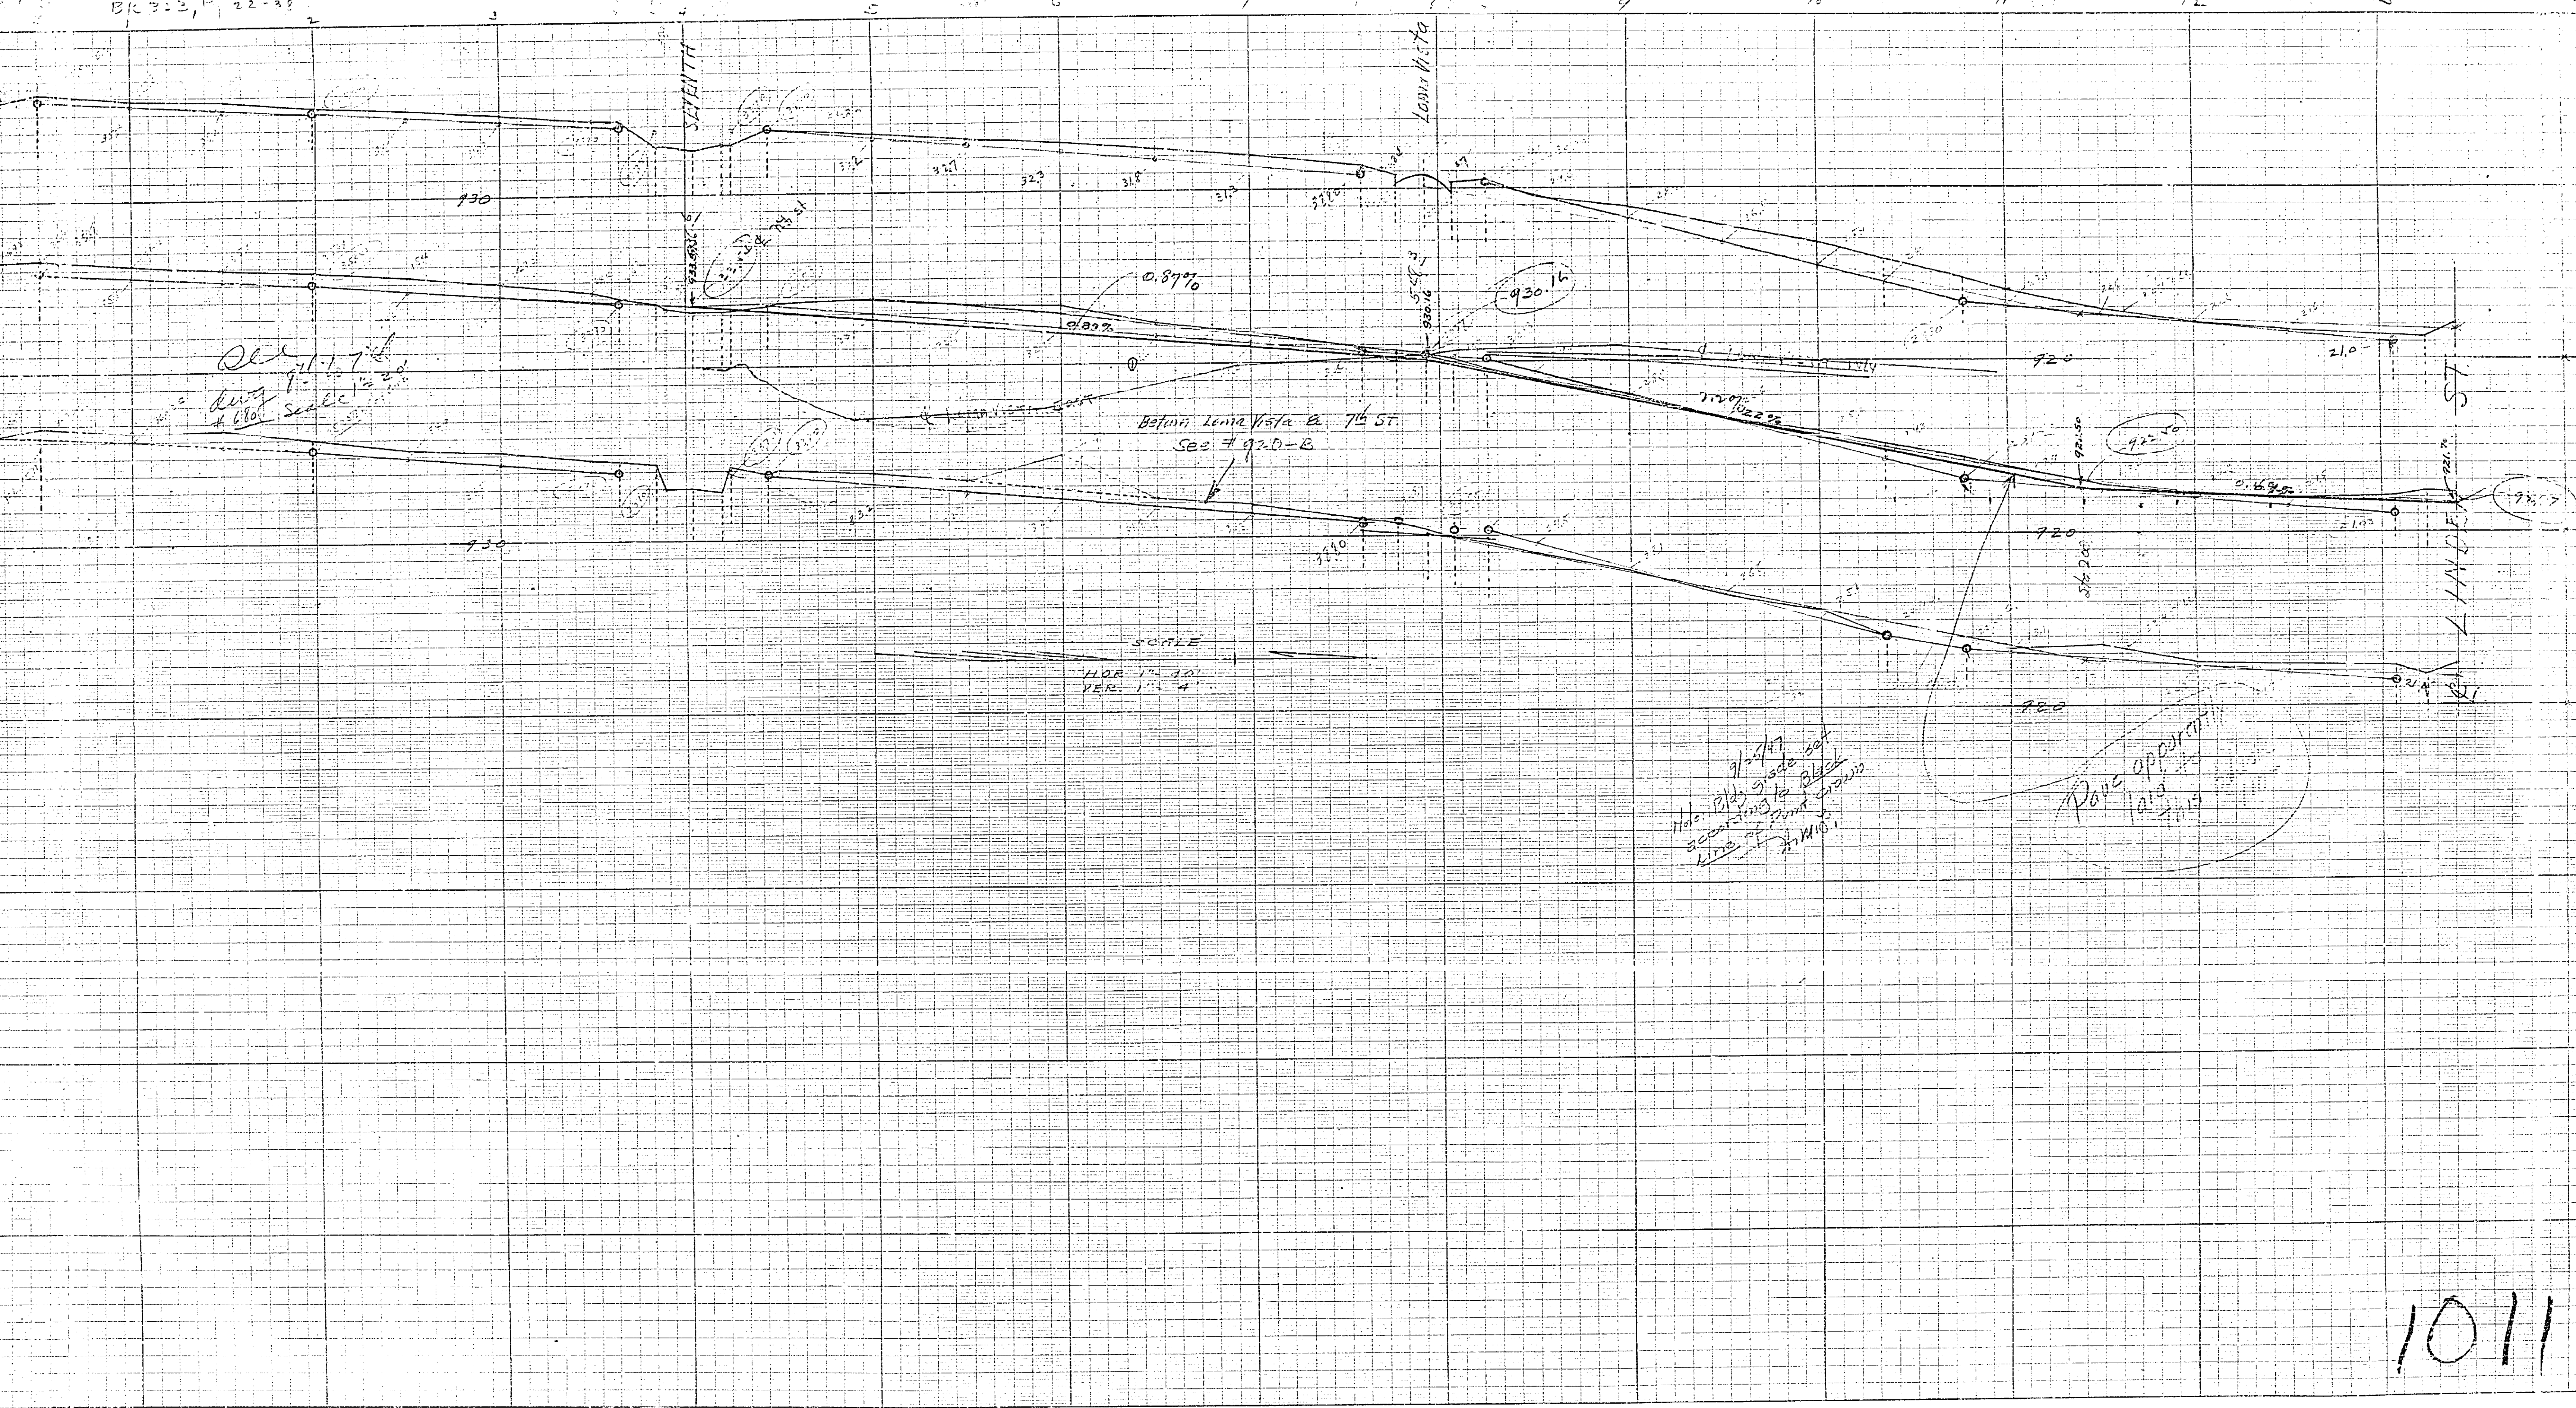

1011