


MESA STREET  
7th Street to 8th Street  
Book 210, Page 71.

30' Roadway

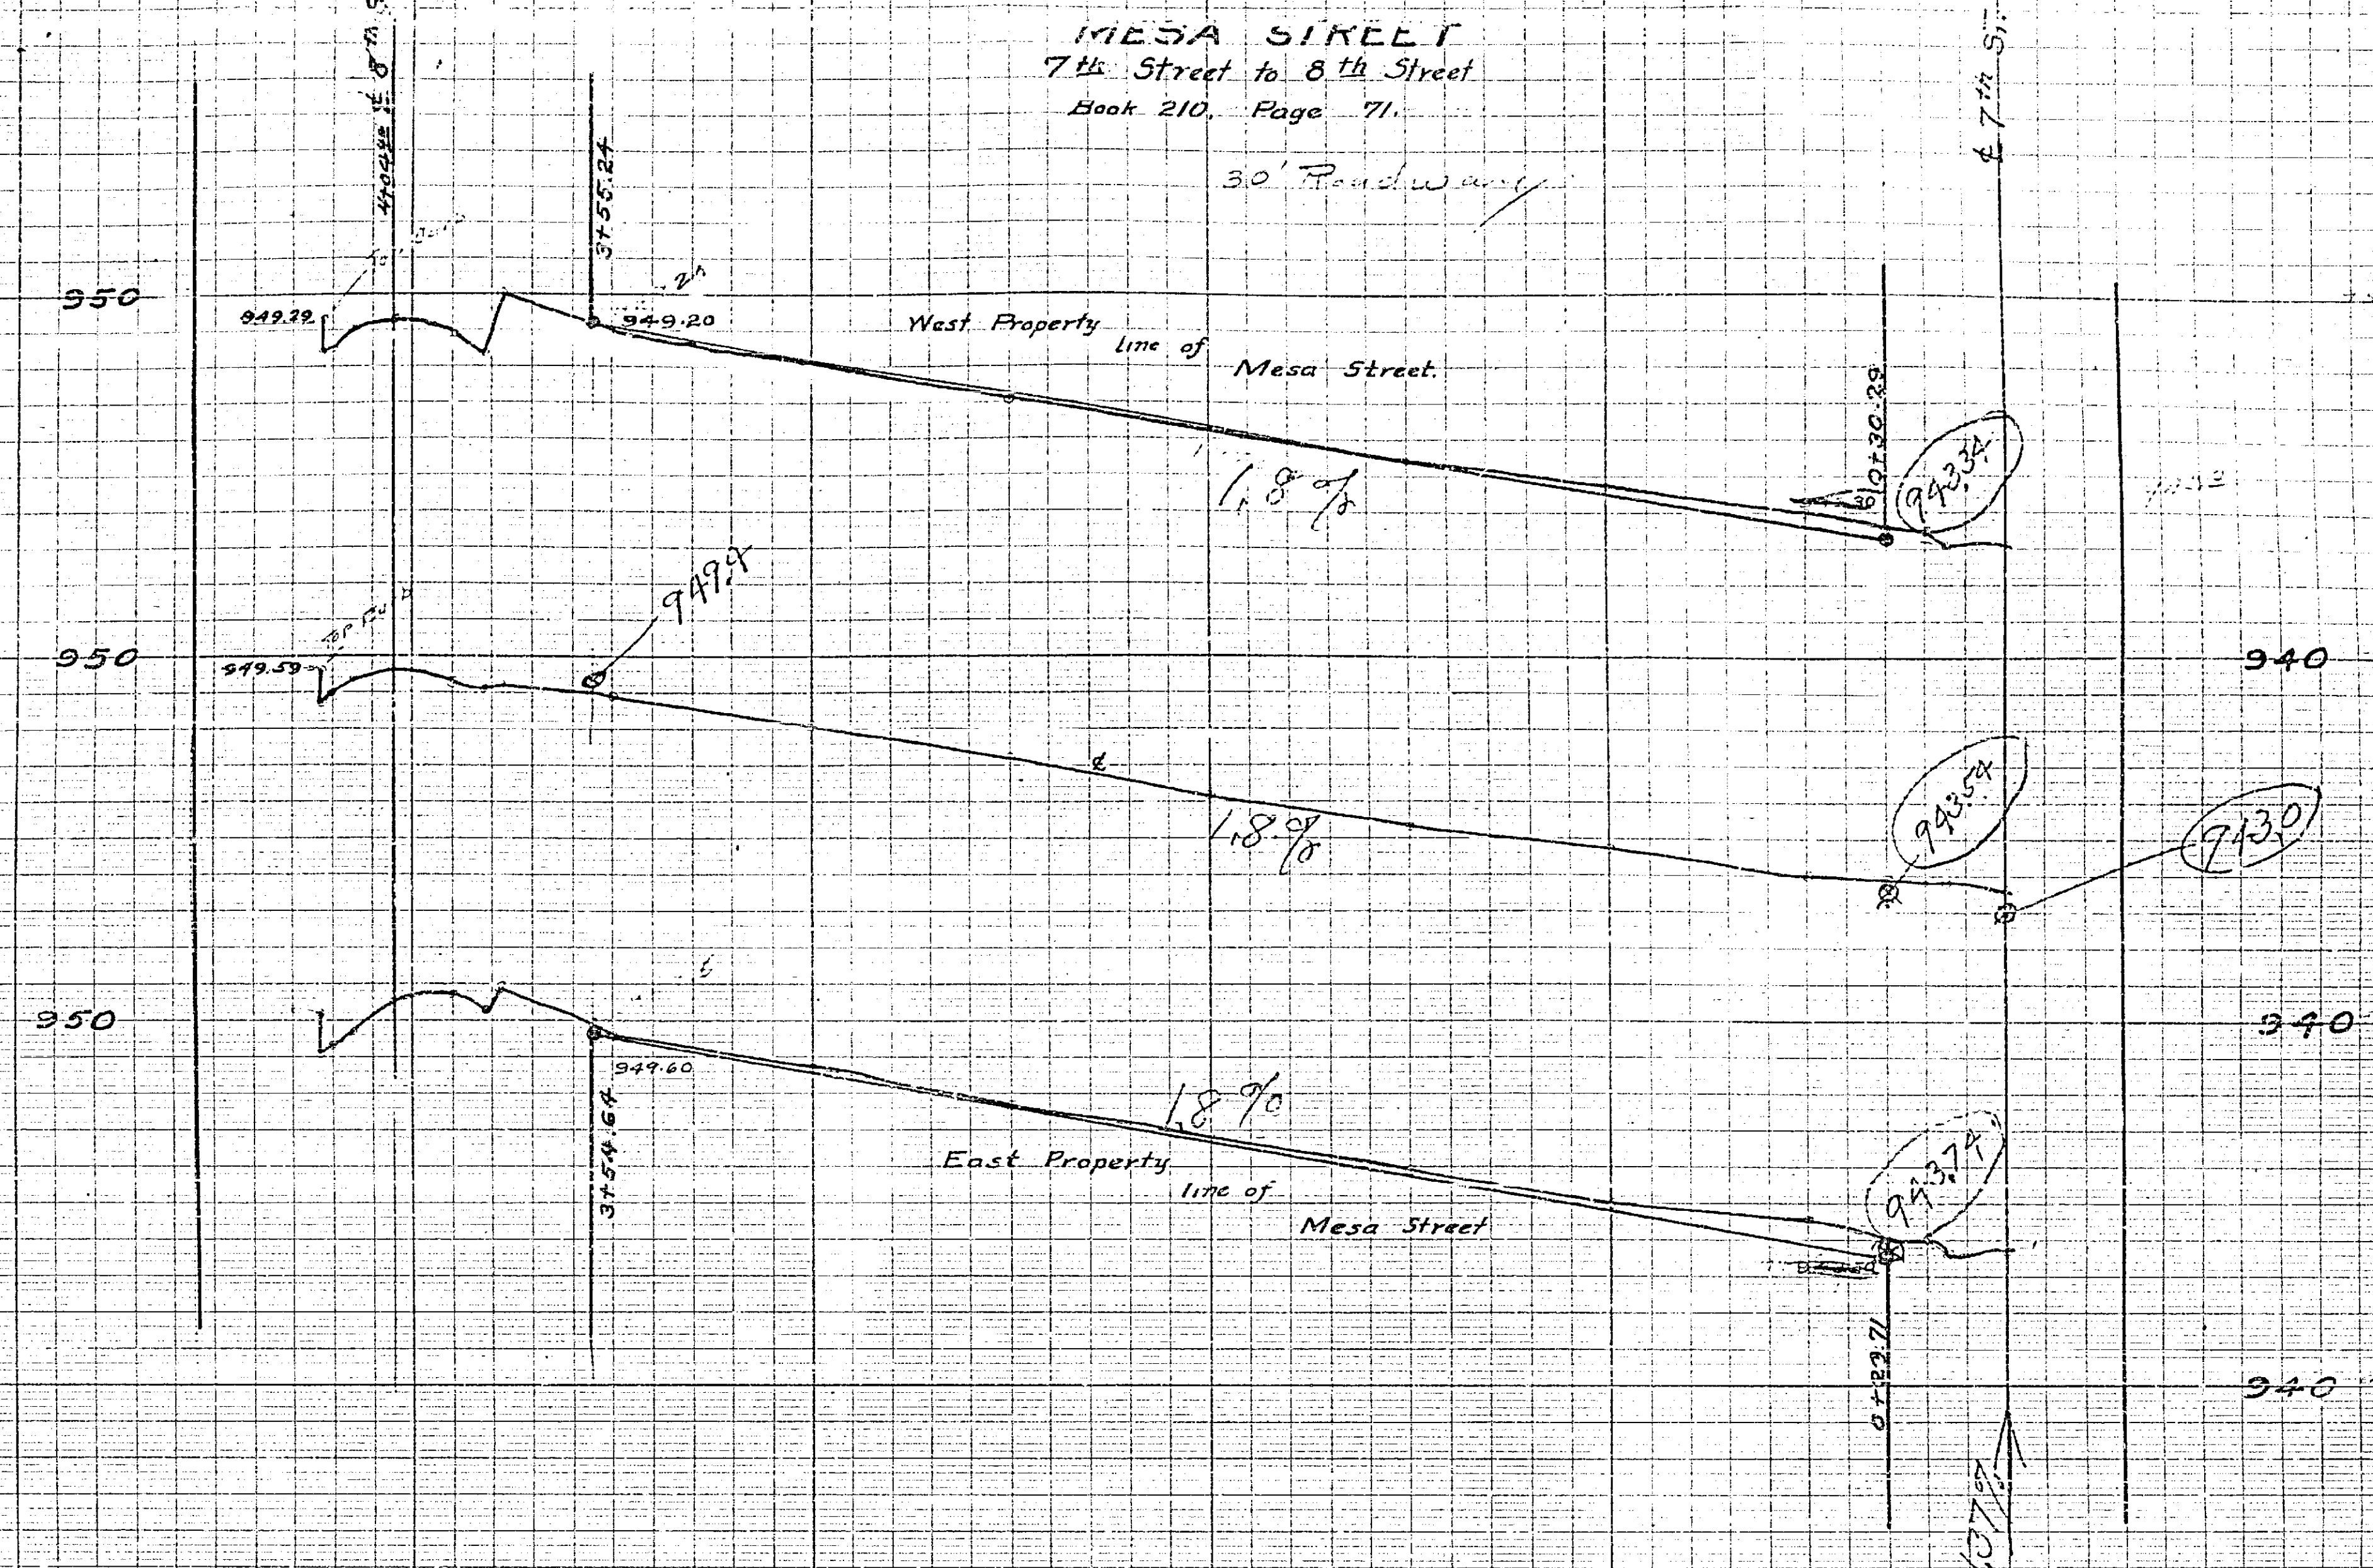

1011D