


PROFILE OF ELEVENTH ST.

Block 110 B. 22 X Block 154 B. 22
SCALE 1" = 100'

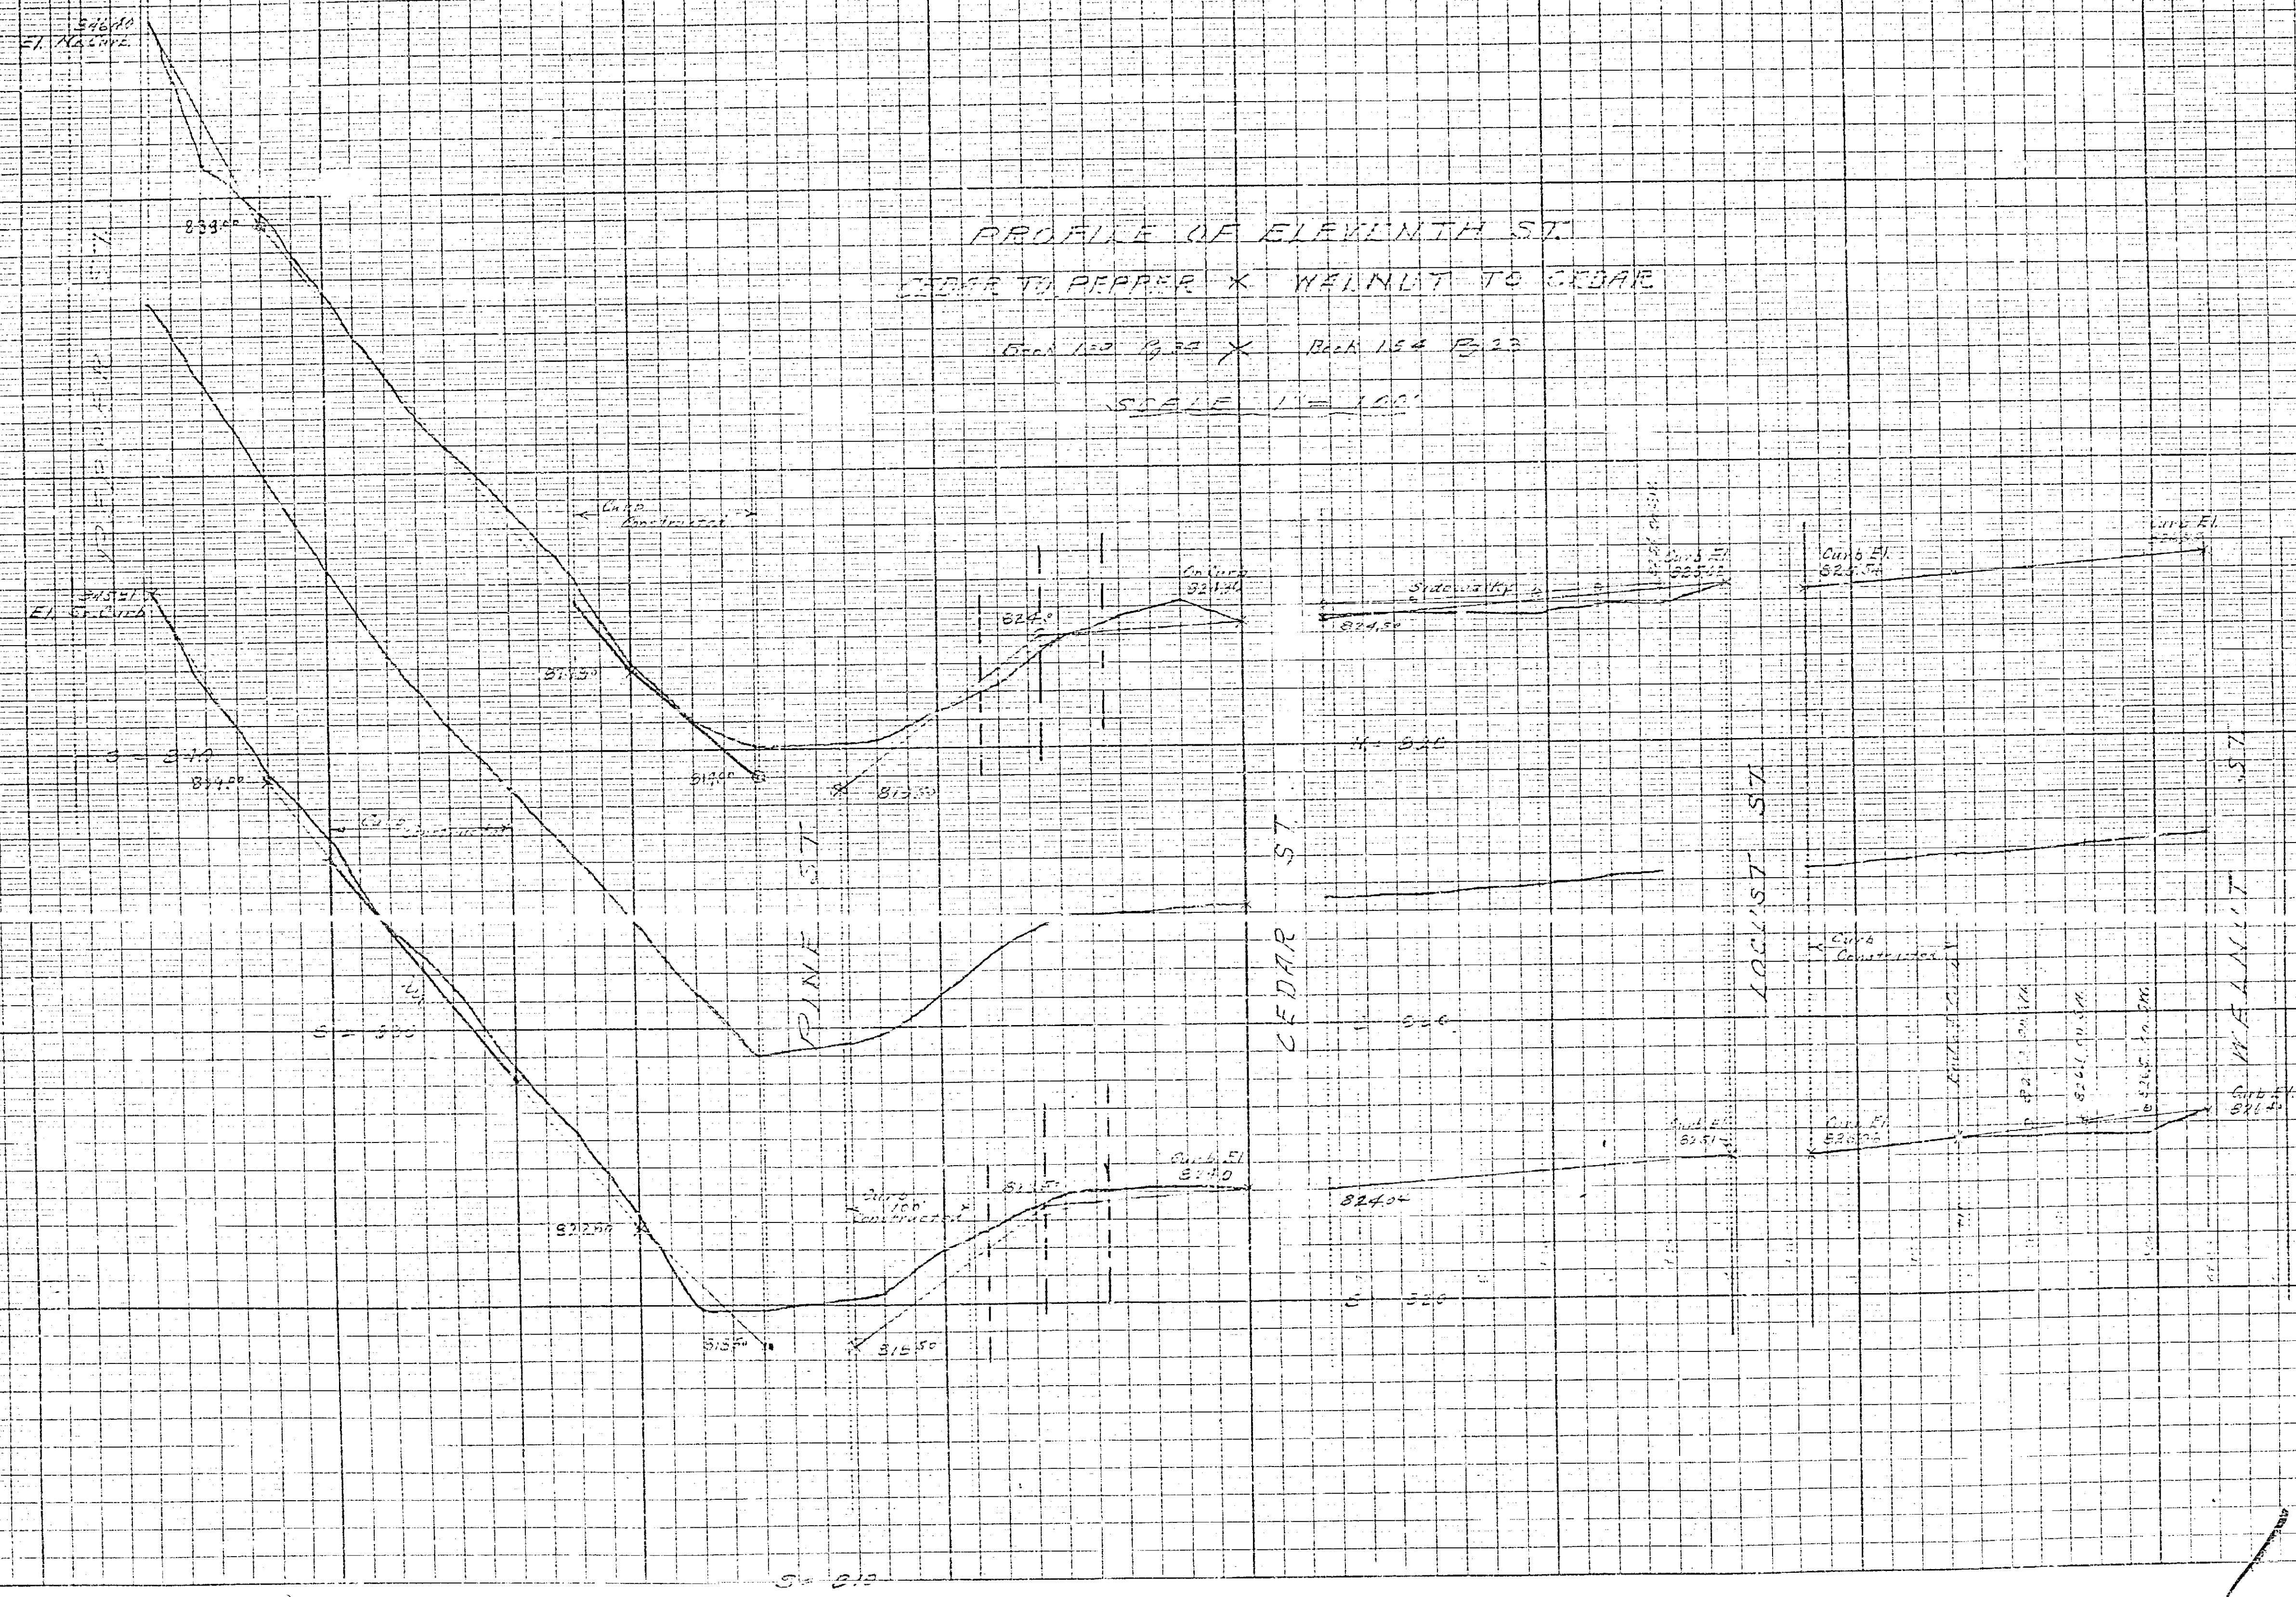

1012