


1016-V

EASTSIDE STORM DRAIN SANTA FE R.R. TO MULBERRY ST.		
Drawing No. Sheet No.	Total Sheets	Field Book
1016-A	1	346
Checked	Checked	
W.C.M. 6-22-37	6-25-37	

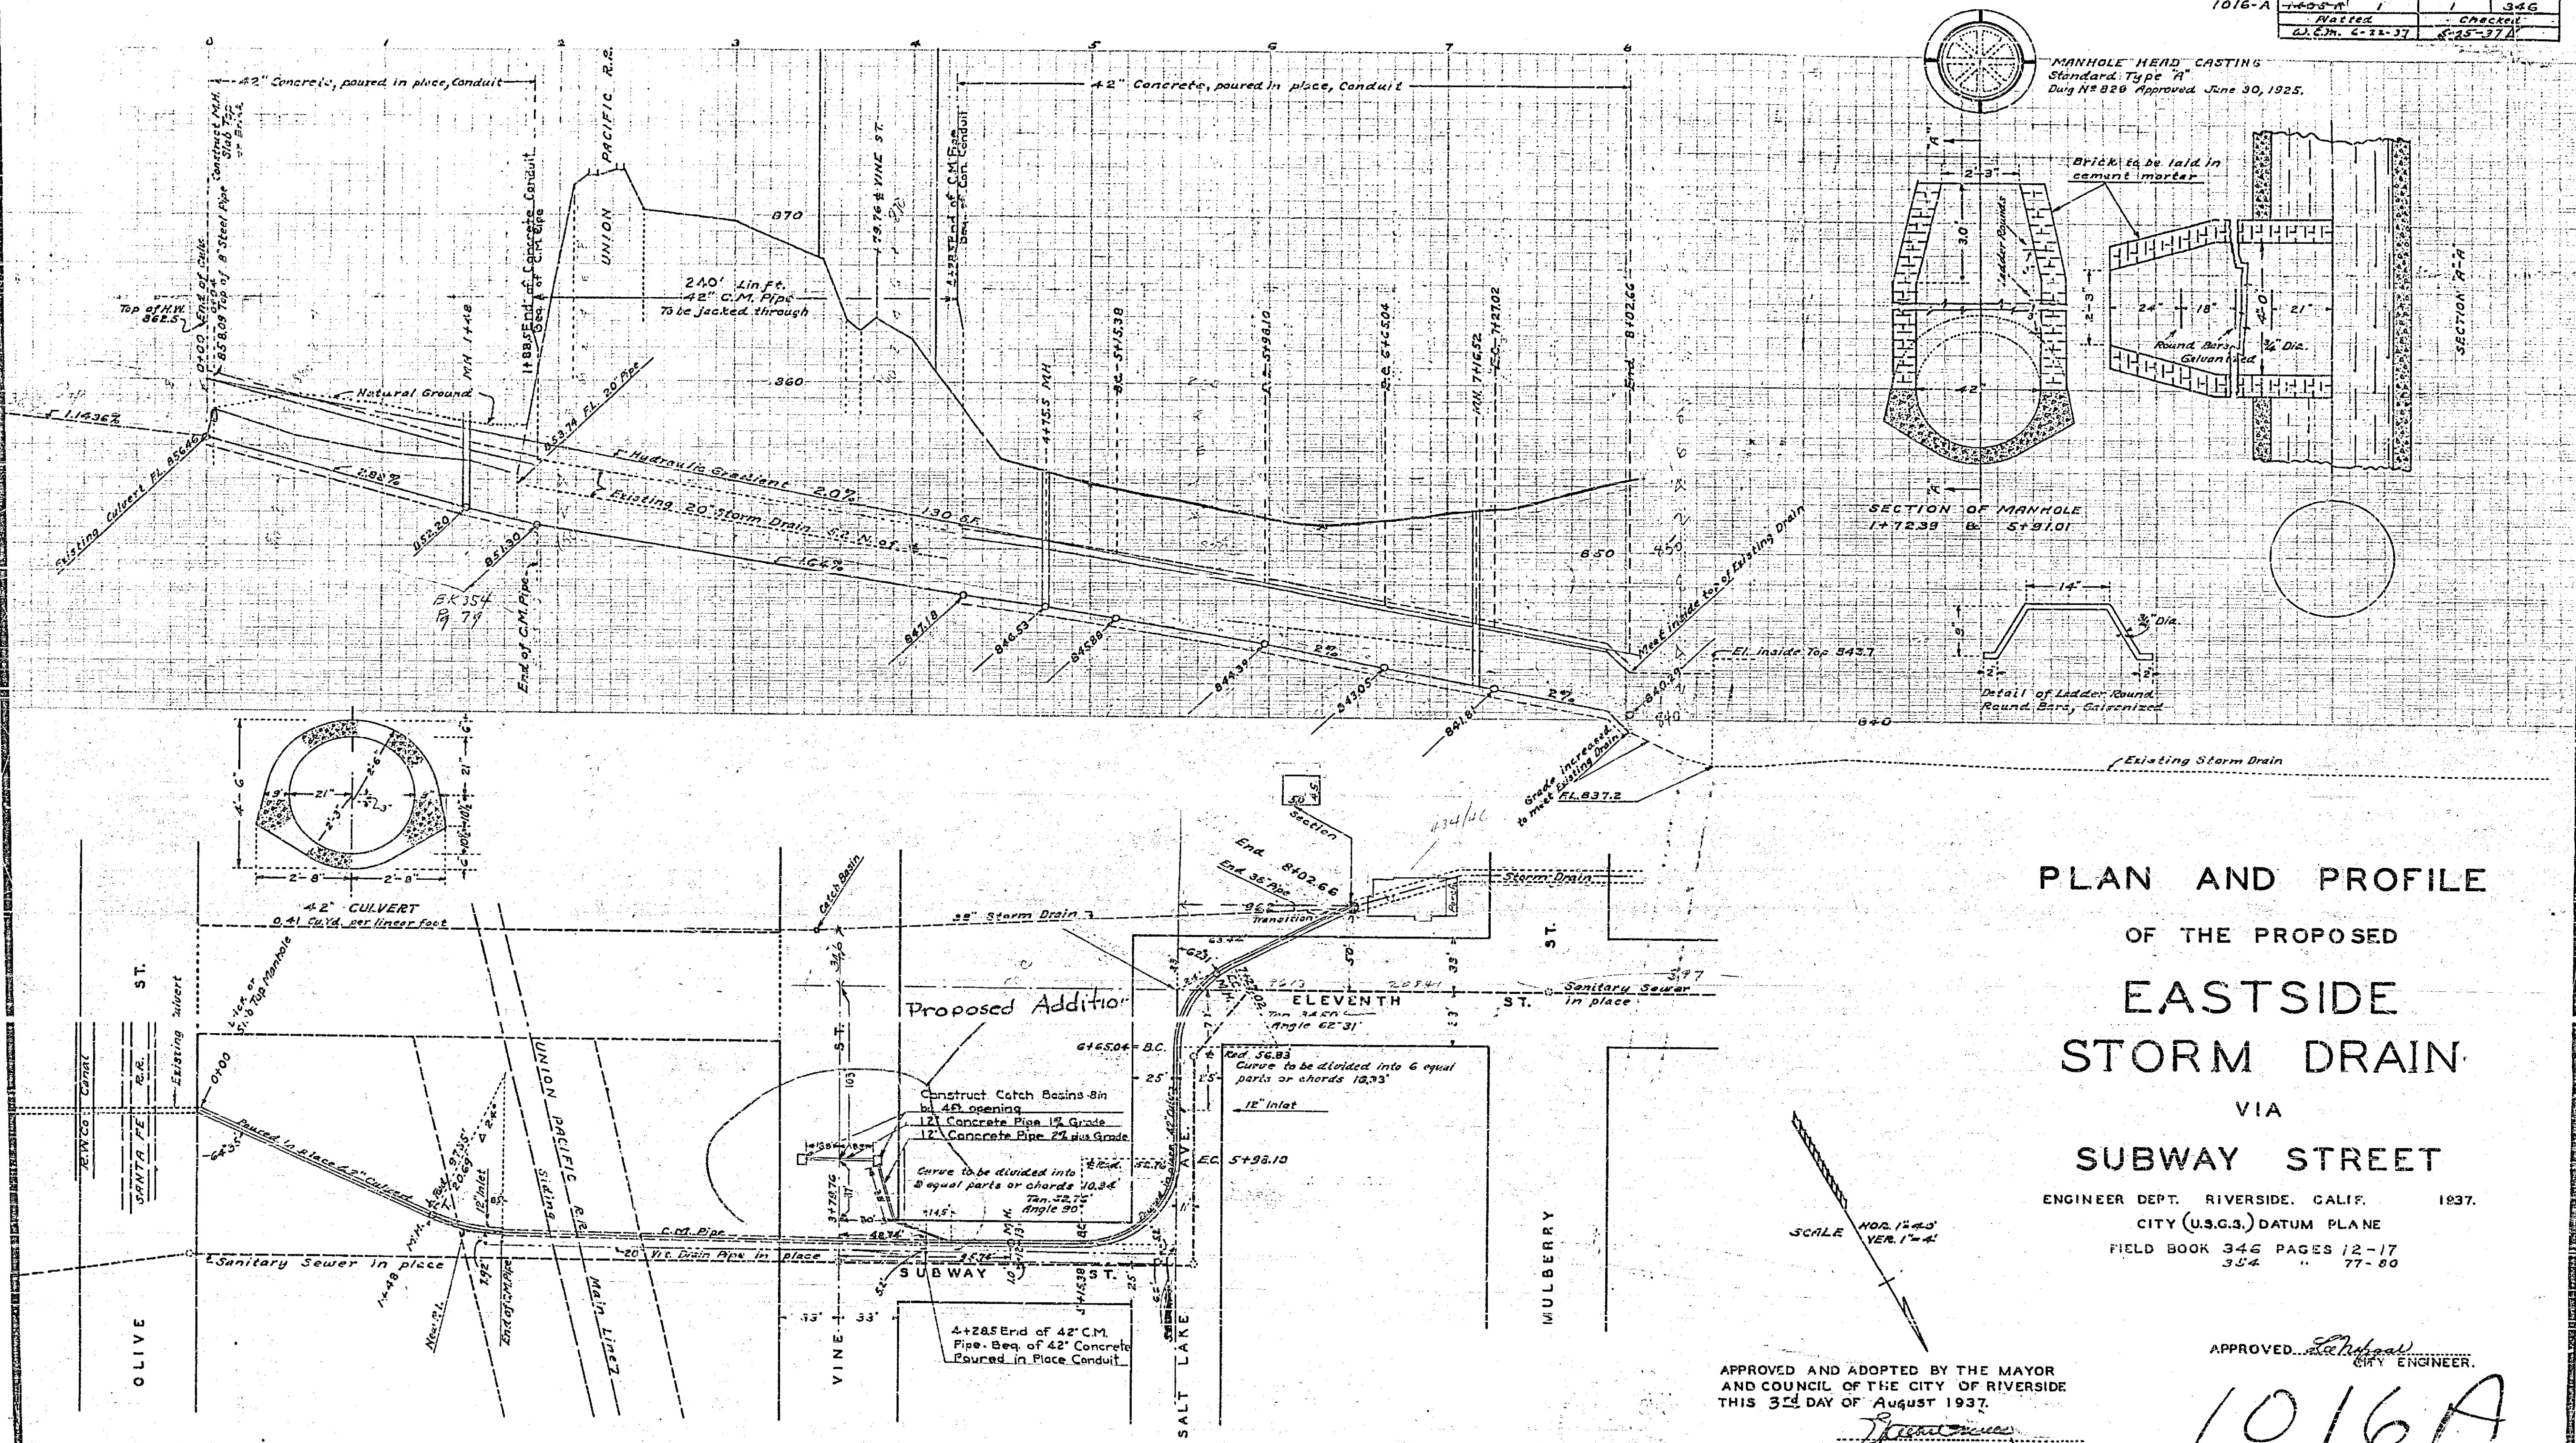

PLAN AND PROFILE
OF THE PROPOSED
EASTSIDE
STORM DRAIN
VIA
SUBWAY STREET

ENGINEER DEPT. RIVERSIDE, CALIF. 1937.
CITY (U.S.G.S.) DATUM PLANE
FIELD BOOK 346 PAGES 12-17
354 " 77-80

APPROVED AND ADOPTED BY THE MAYOR
AND COUNCIL OF THE CITY OF RIVERSIDE
THIS 31 DAY OF August 1937.

APPROVED: *[Signature]*
CITY ENGINEER.

1016A

SCALE HOR. 1"=40'
VER. 1"=4'

CITY CLERK, CITY OF RIVERSIDE.