



TOPOGRAPHY ON PALM AVE.
FROM CENTRAL AVE TO ARLINGTON AVE.
BOOK 101, PAGE 51 TO 55, INC.
SEPT. 25, 1929

PROFILE OF PALM AVE
FROM CENTRAL AVE TO ARLINGTON AVE.
BOOK 101, PAGE 51 TO 55, INC.

Resolution = Intention
Show Change of Grades

7020

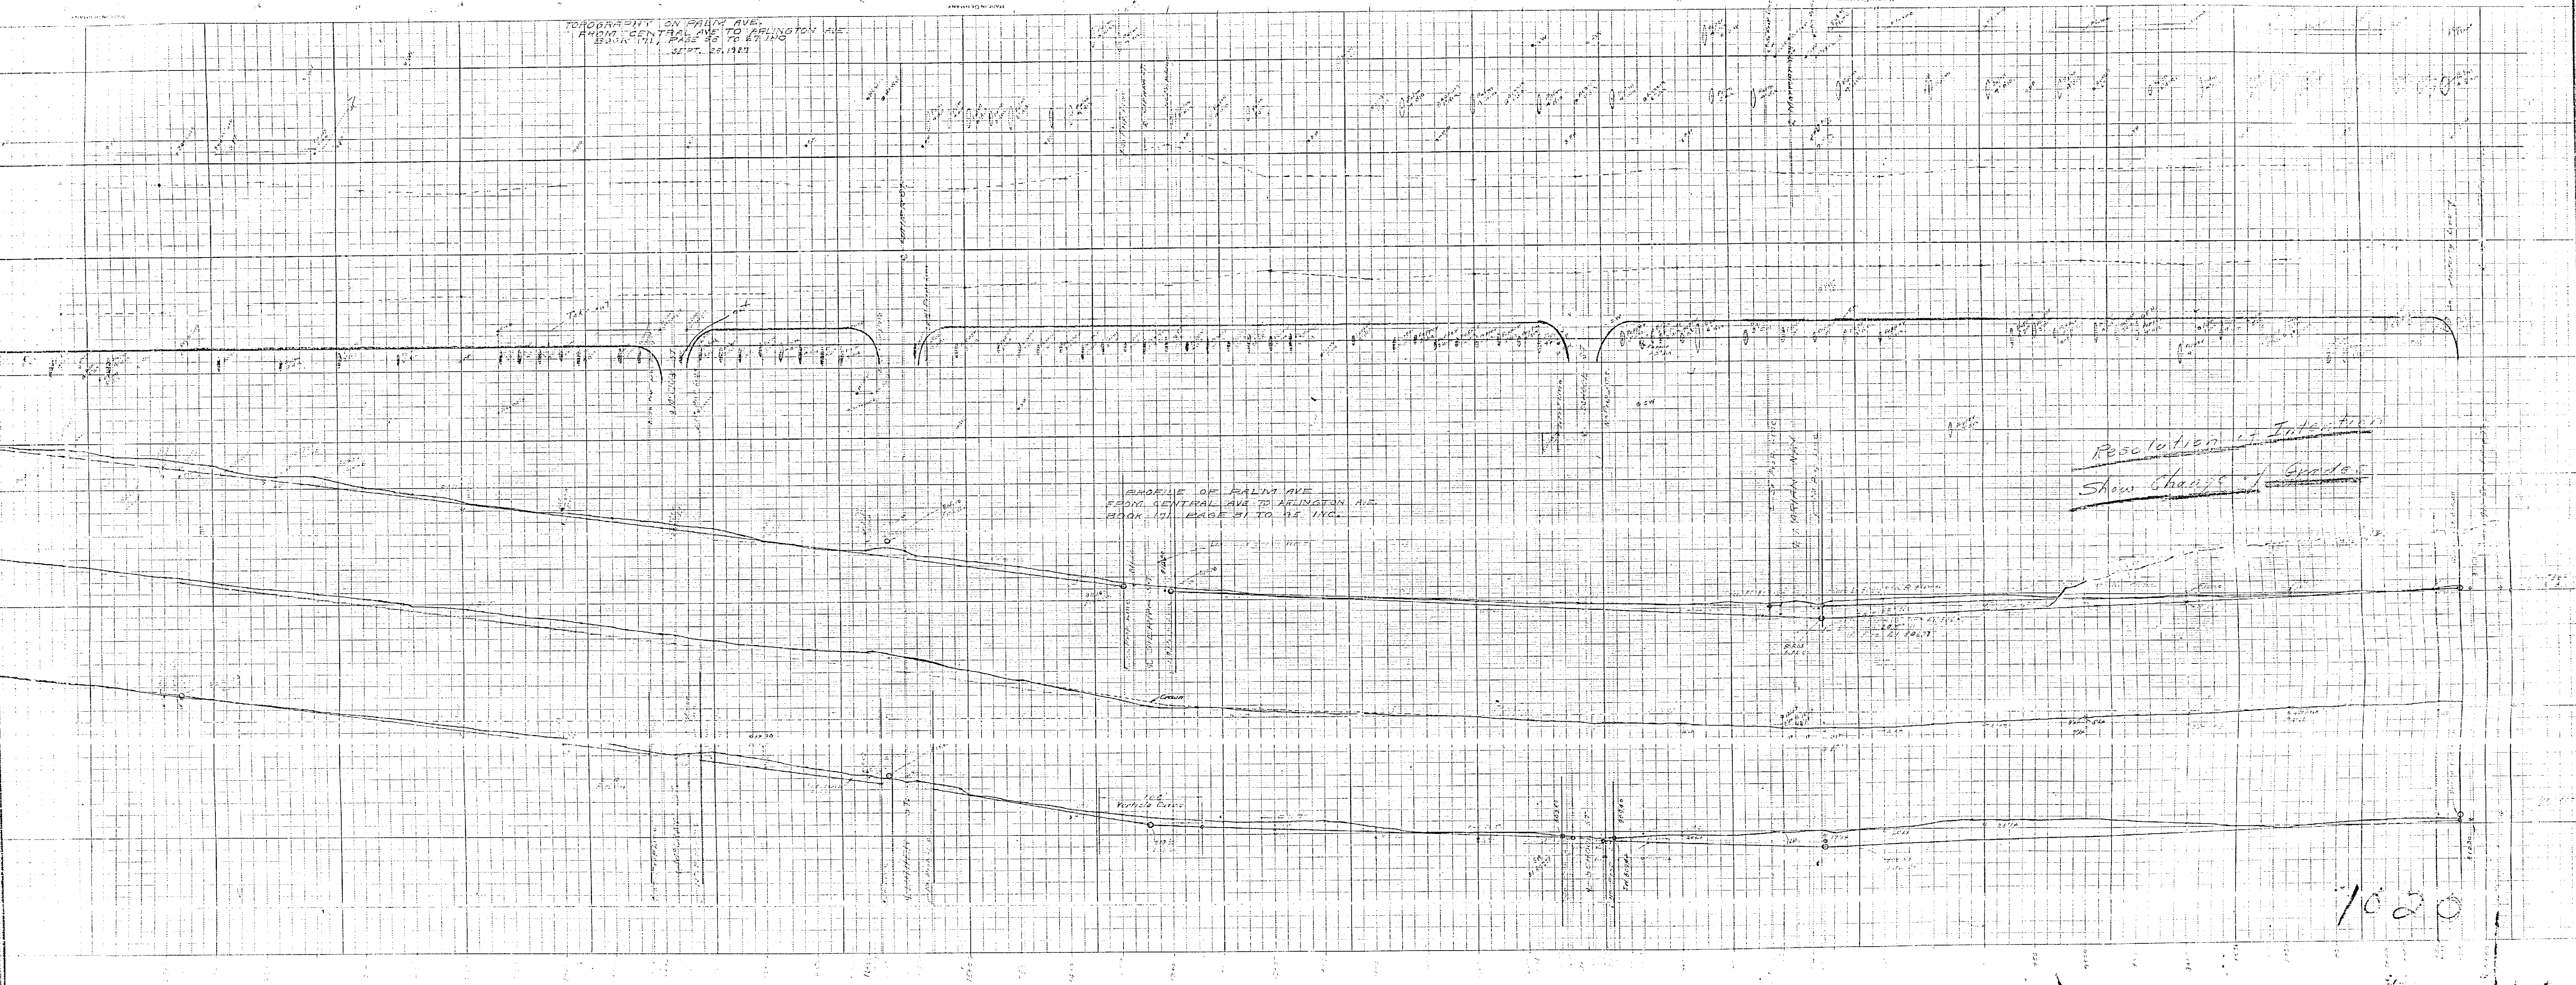

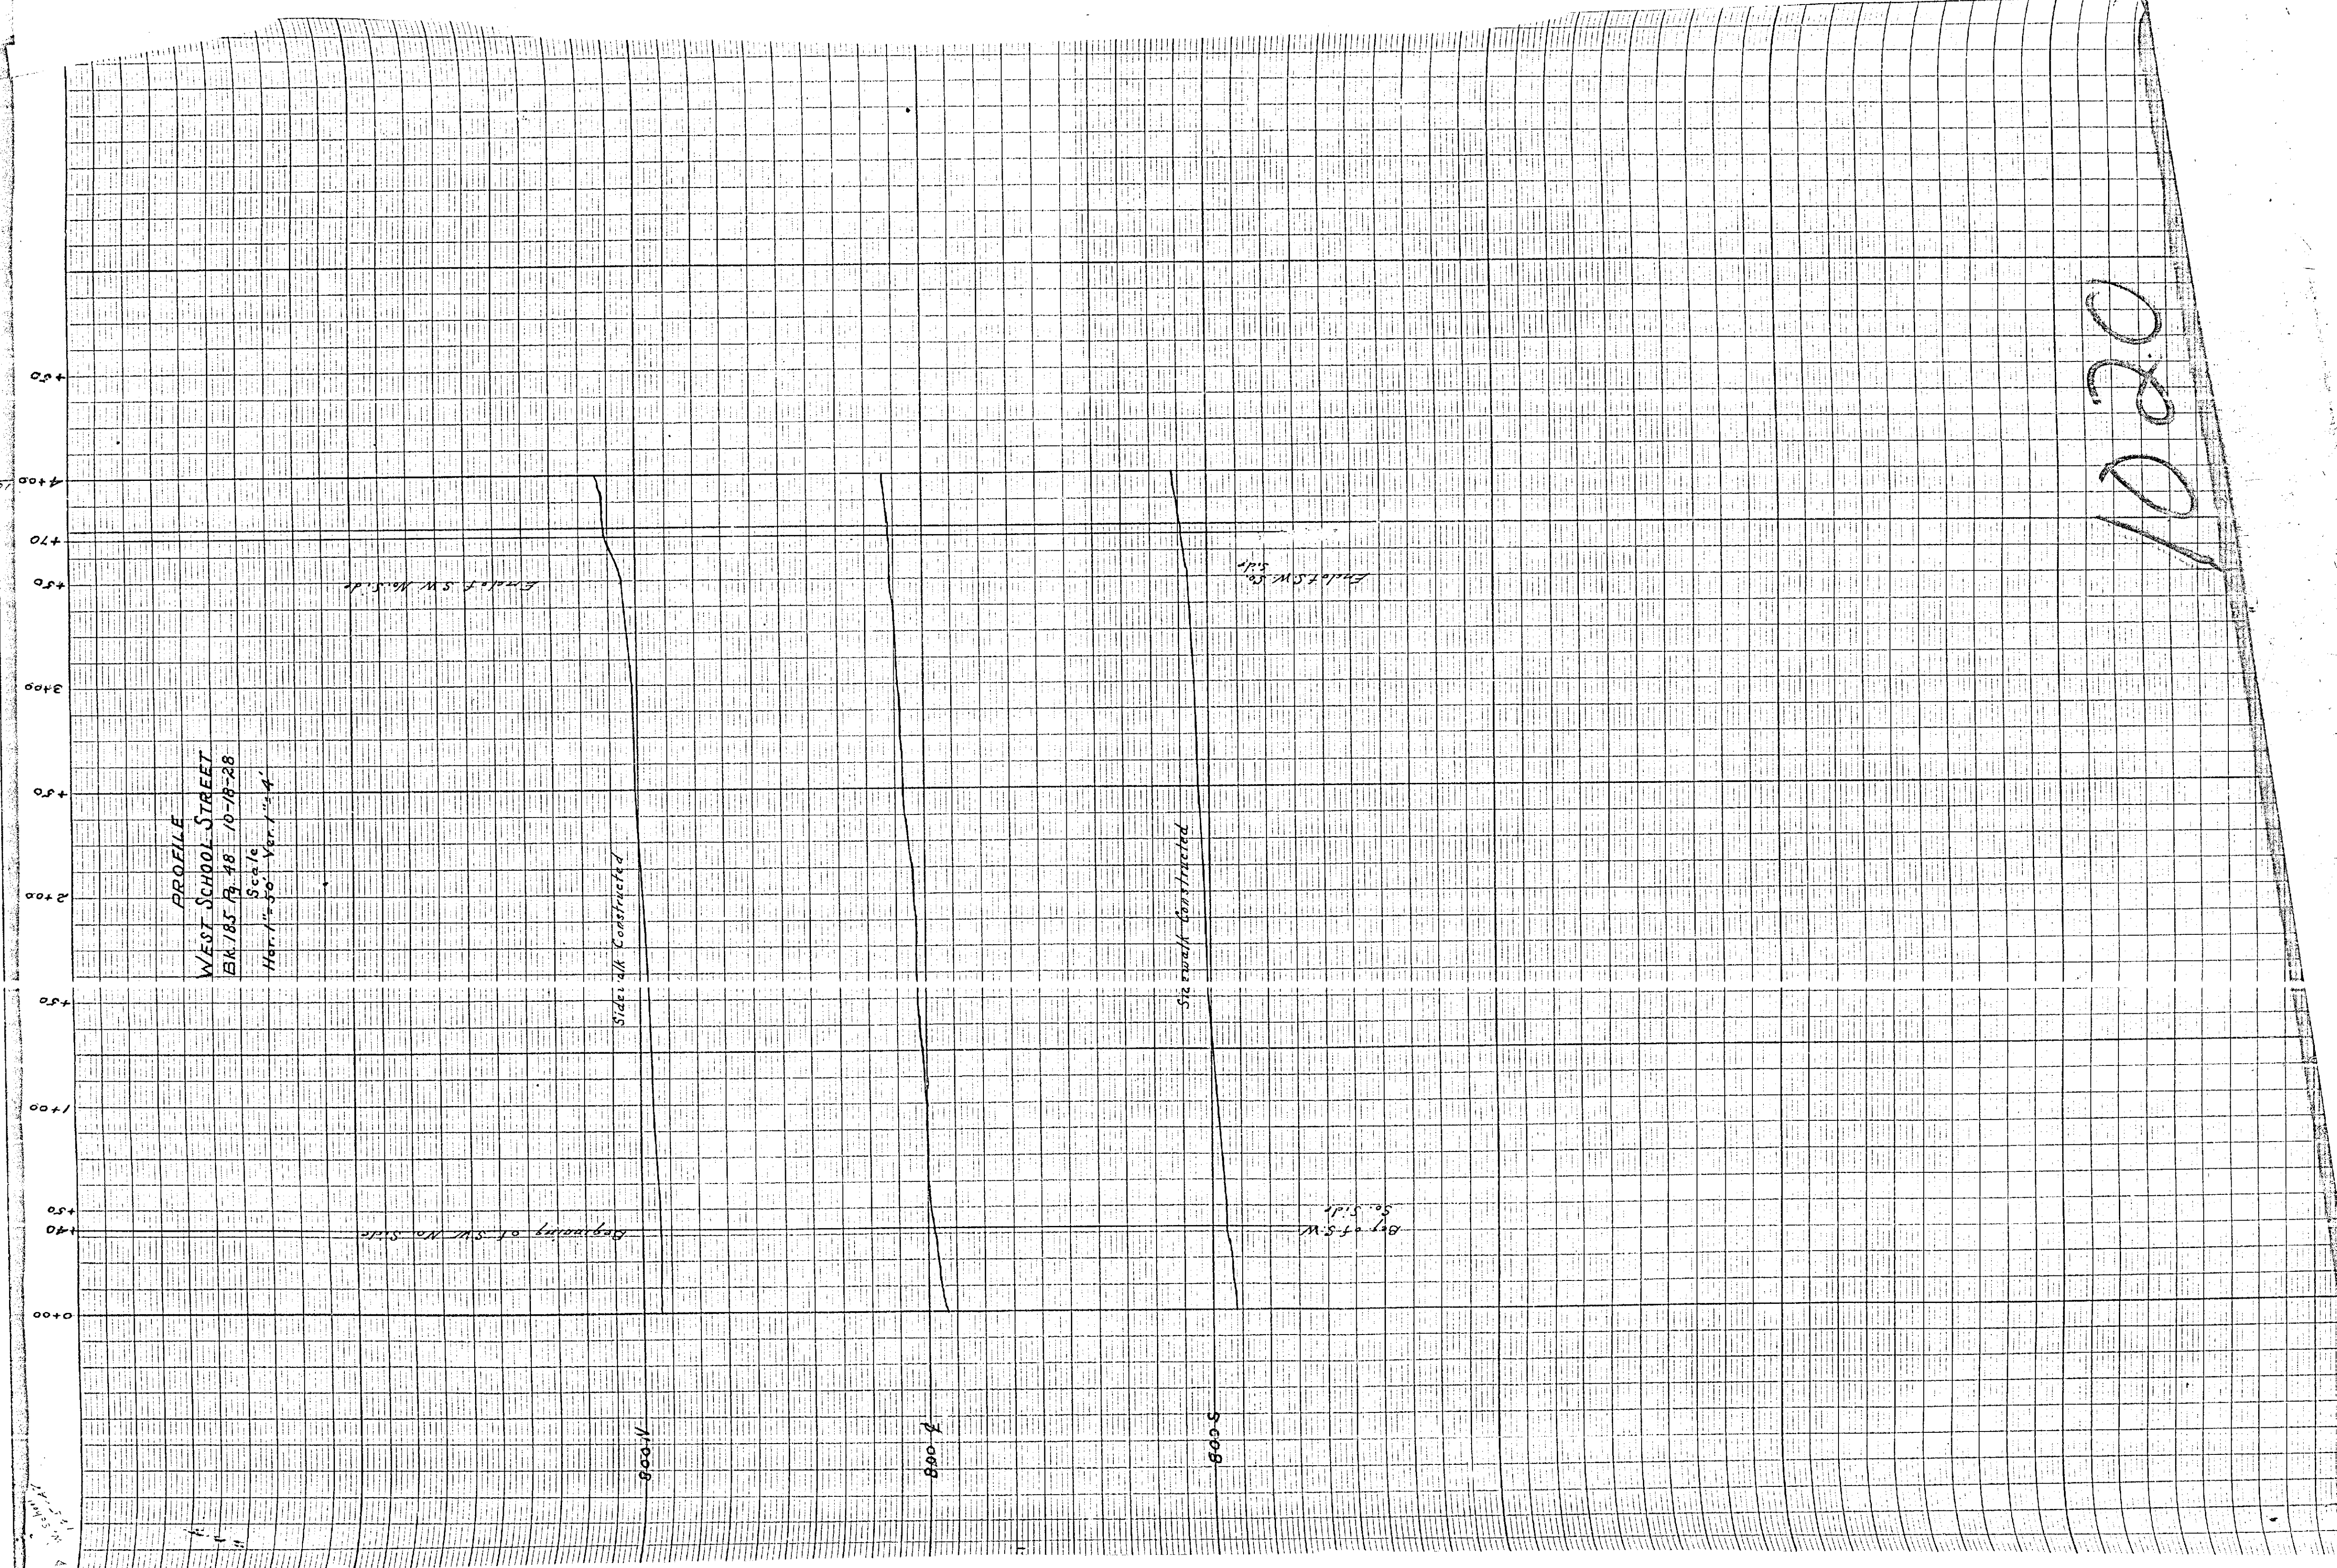

Scale
Hor. 1" = 50' Ver. 1" = 4'

4+50
4+00
3+50
3+00
2+50
2+00
1+50
1+00
+50
0+50
0+00

8+00
8+10
8+20
8+30
8+40
8+50

Finished SW Side

Side Walk Constructed

Proposed

Finished SW Side

Proposed SW Side

1020

PROFILE PALM AVE

CENTRAL to ARLINGTOWN

BOOK 12, 51

2211-27-2225

MAP OF PROPOSED IMPROVEMENT

PALM AVENUE

PALM CITY ENGINEER 1928

PALM AVENUE

North of Sierra Street

PALM AVENUE

South of Sierra Street

1020