1039-E

REVISION OF INTERSECTION, MAIN & RUSSELL ST.			
DRAWING NUMBER	SHEET NUMBER	TOTAL SHEETS	FIELD BOOKS
1039 E	1	1	
DRAWN BY	CHECKED BY	APPROVED BY	
H.E.M.	R.E.D.	L.N.	

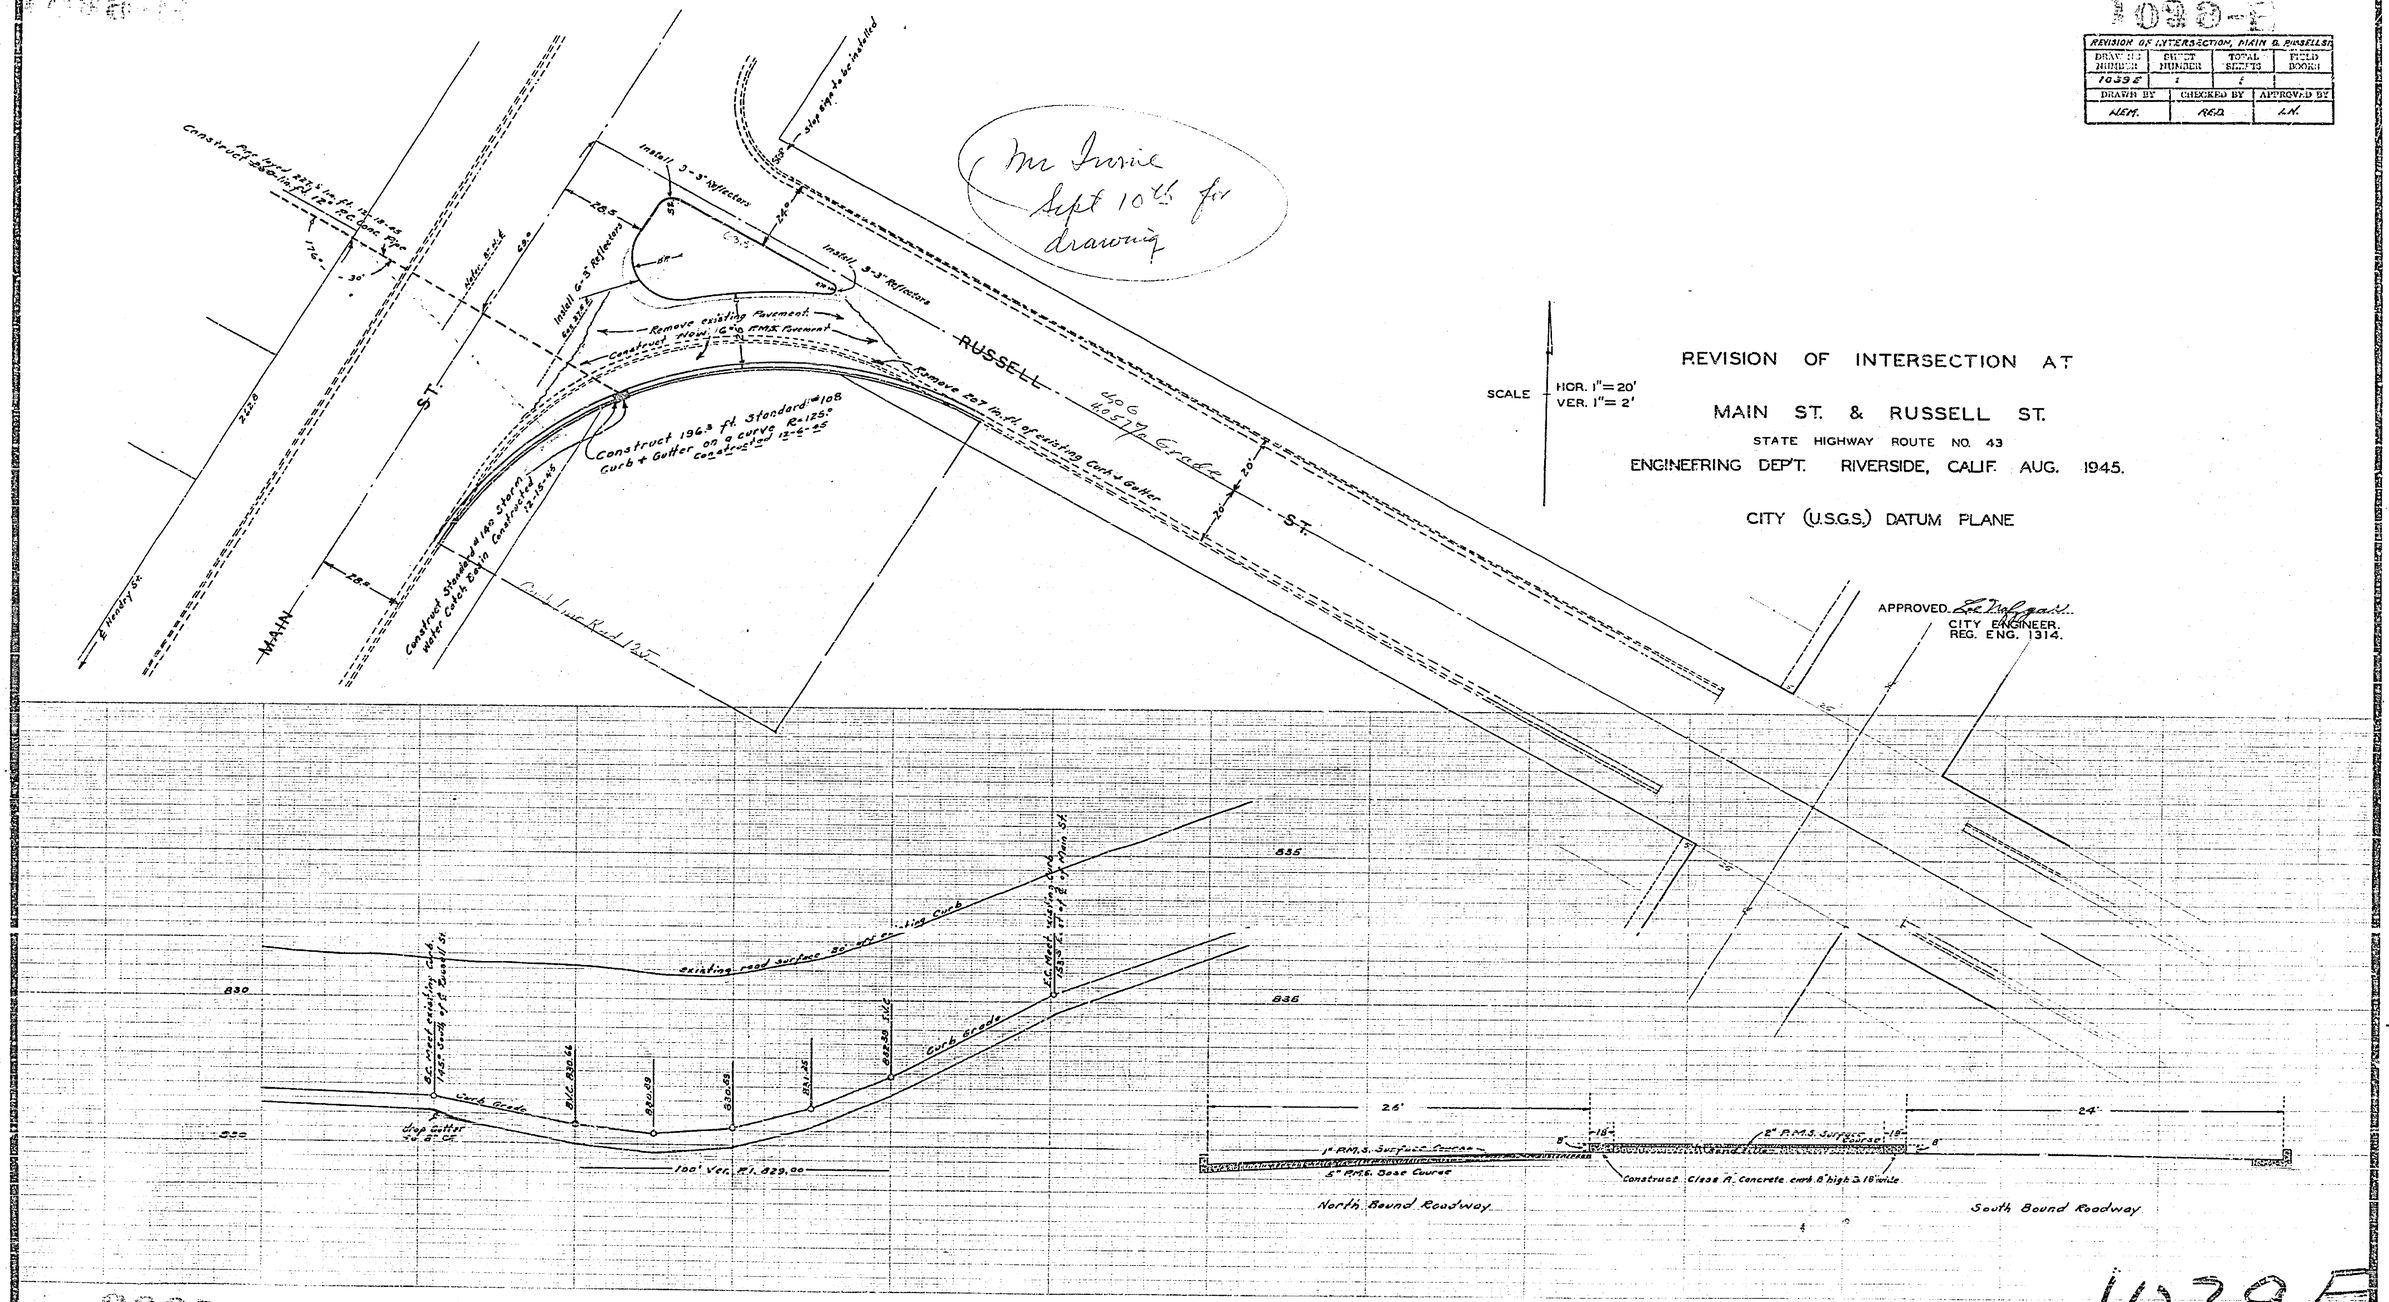

1039E