
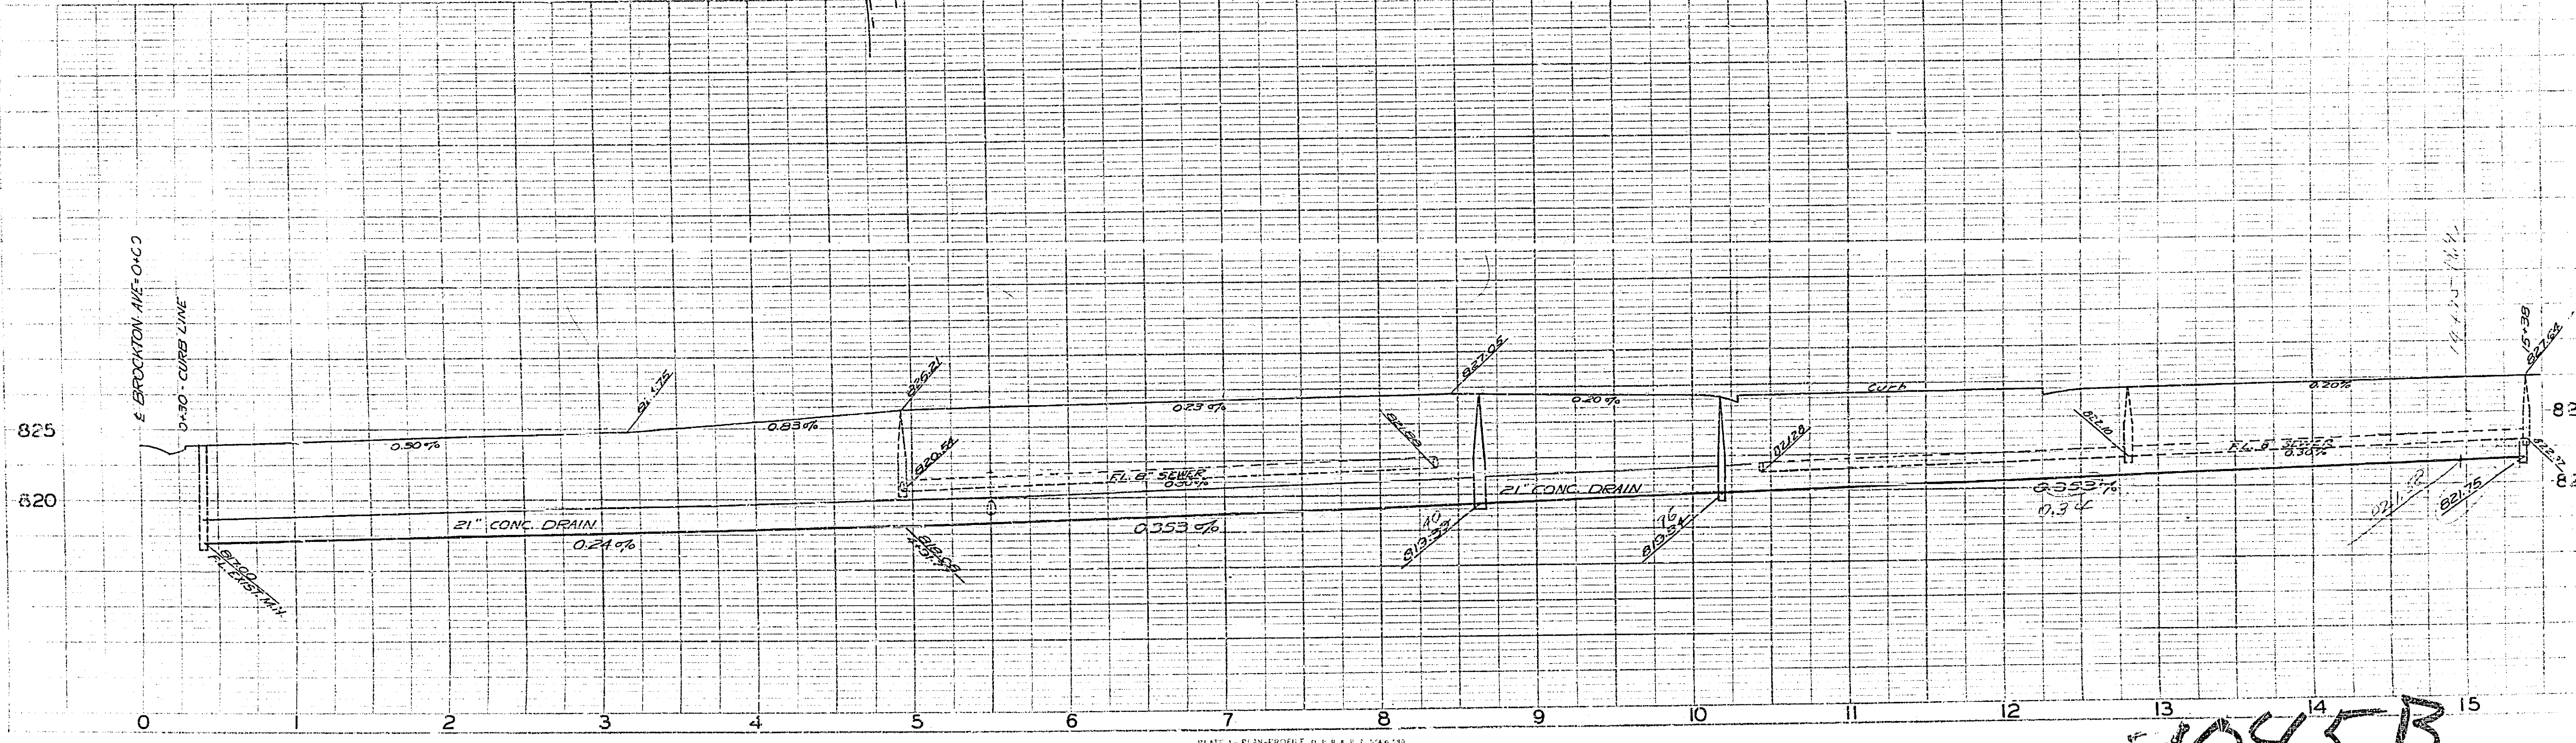


PLAN AND PROFILE  
 NO 1045 B  
 FOR THE CONSTRUCTION OF  
**NELSON STREET  
 STORM DRAIN**  
 FROM BROCKTON AVE. TO THE EASTERLY LINE OF  
 SUN GOLD TERRACE UNIT NO. 1.  
 RIVERSIDE, CALIFORNIA

APPROVED: *M. H. Swine*  
 M.H. IRVINE, REG. C.E. NO. 3011  
 CITY ENGINEER

SCALES: HORIZ. 1"=50'  
 VERT. 1"=5'

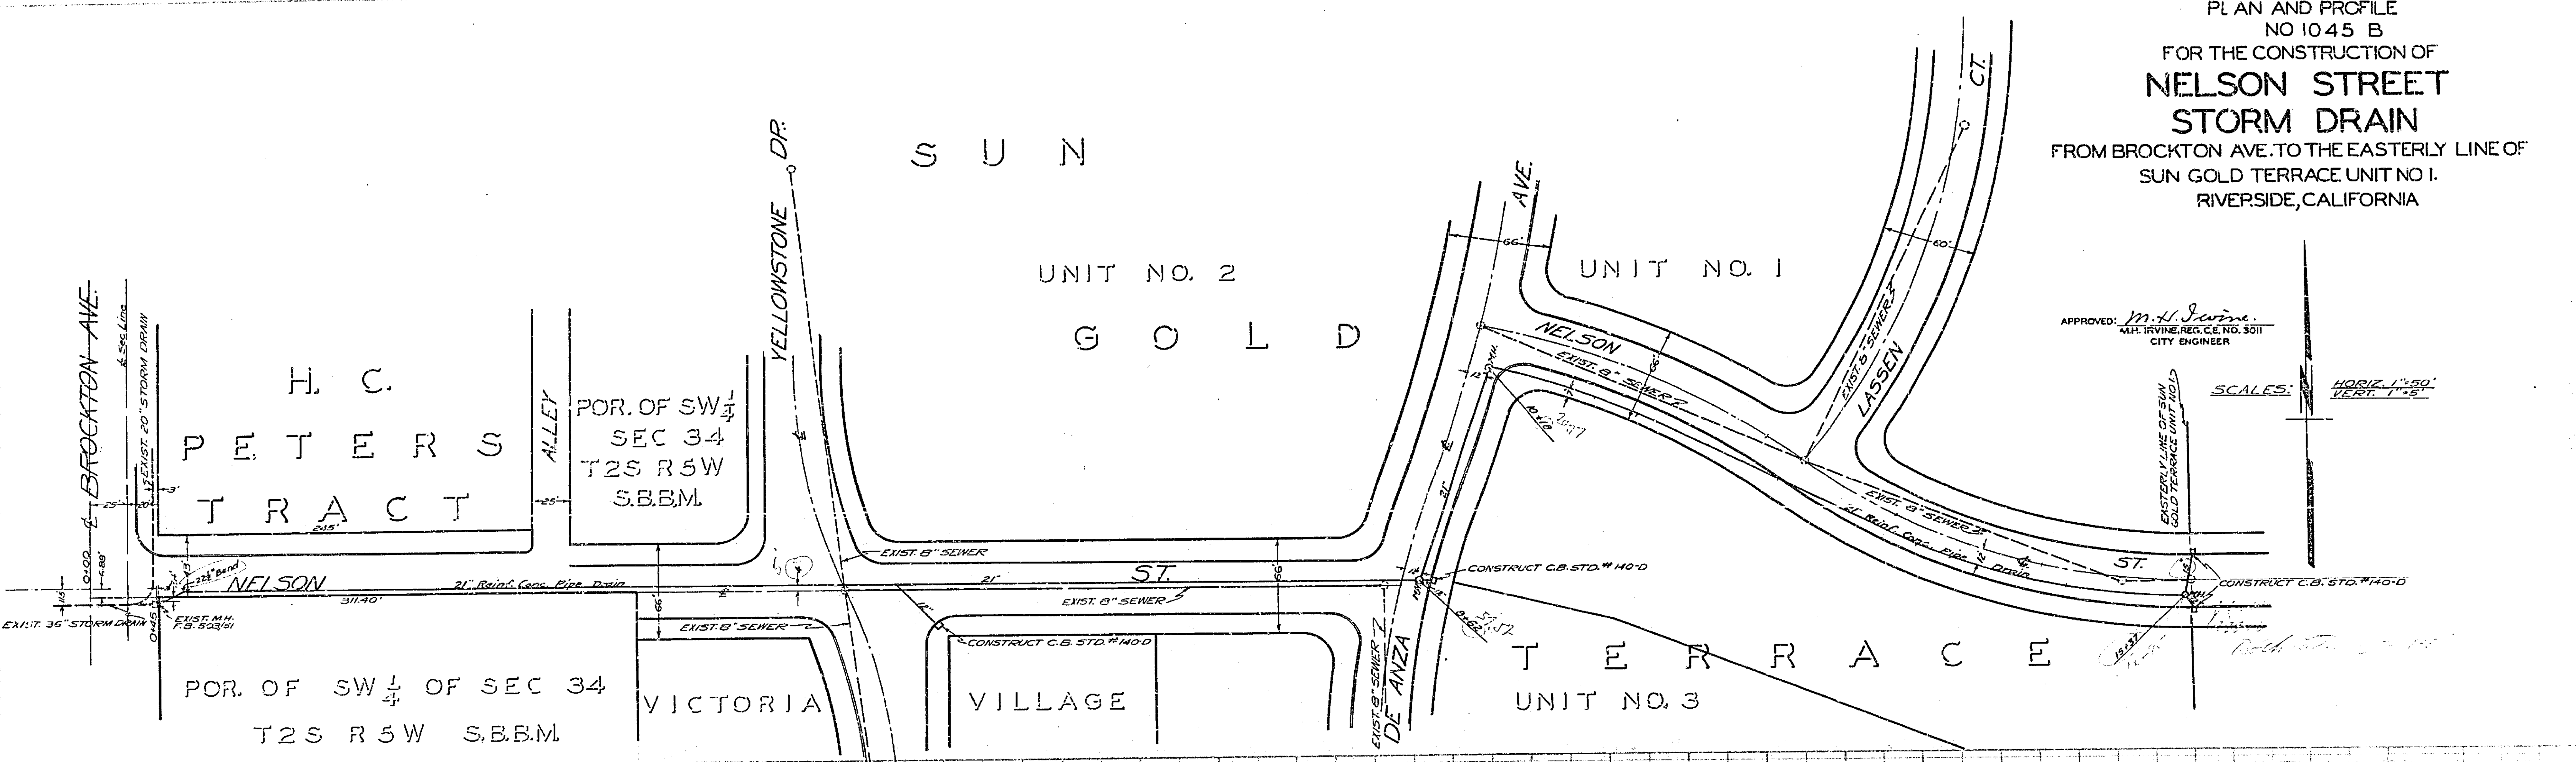

1045B