
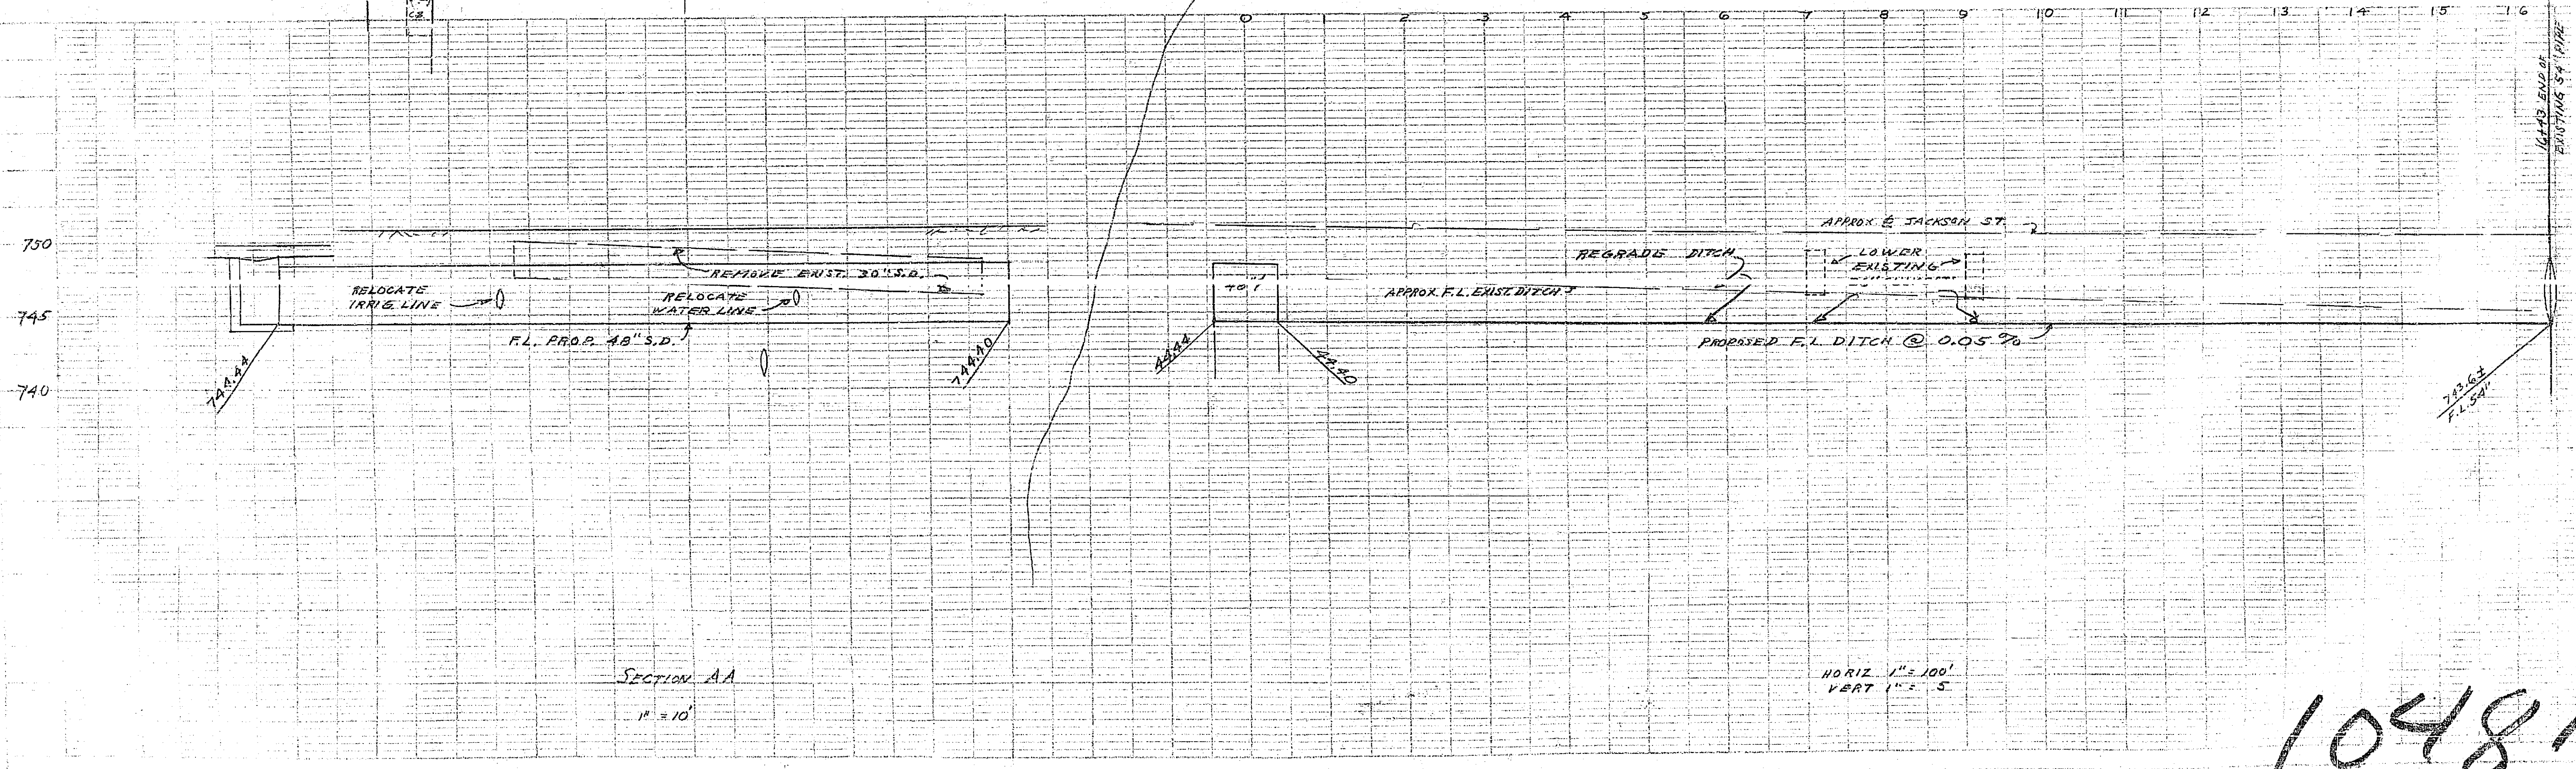


PLAN No 1048-A
 SHOWING
 PROPOSED STORM DRAIN REHABILITATION
 IN JACKSON STREET
 NORTHWESTERLY FROM CALIFORNIA AVE
 CITY OF RIVERSIDE - CALIFORNIA

APPROVED *M. H. Irvine*
 M. H. IRVINE, REG. C.E. 3011
 CITY ENGINEER

FB 561/48

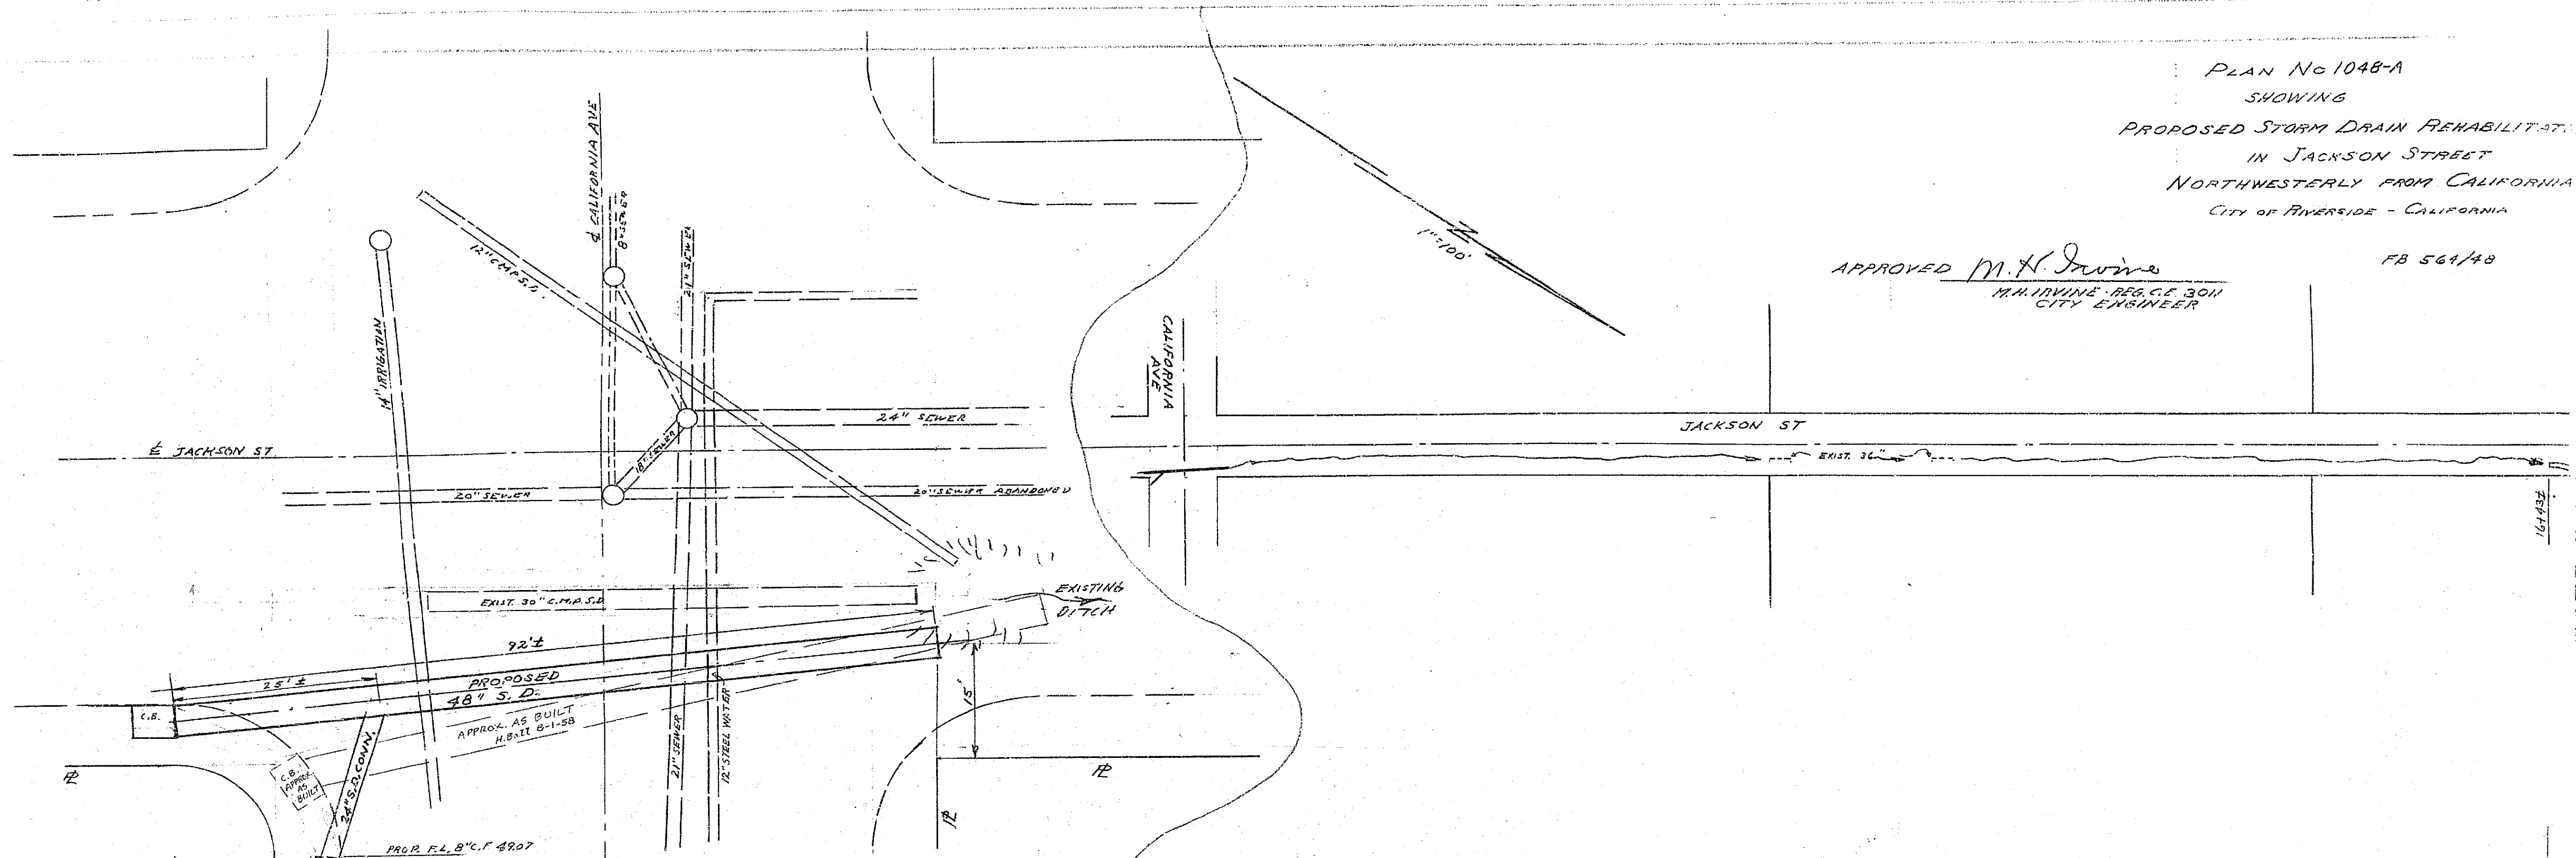

SECTION AA
 1" = 10'

HORIZ. 1" = 100'
 VERT. 1" = 5'

1048A

Revised Est. - 48" R.P. No. 72 L.F. @ 1.176 = 1176
 4/1/55
 Regrade ditch - 1650
 48" R.C.P. - 1570
 3150 = + level. carrying 2 pipe lines
 Max. @ 125' per ft. for 70'
 3270 S.D. @ 3500

E 386
 4/1/55