


1059-C

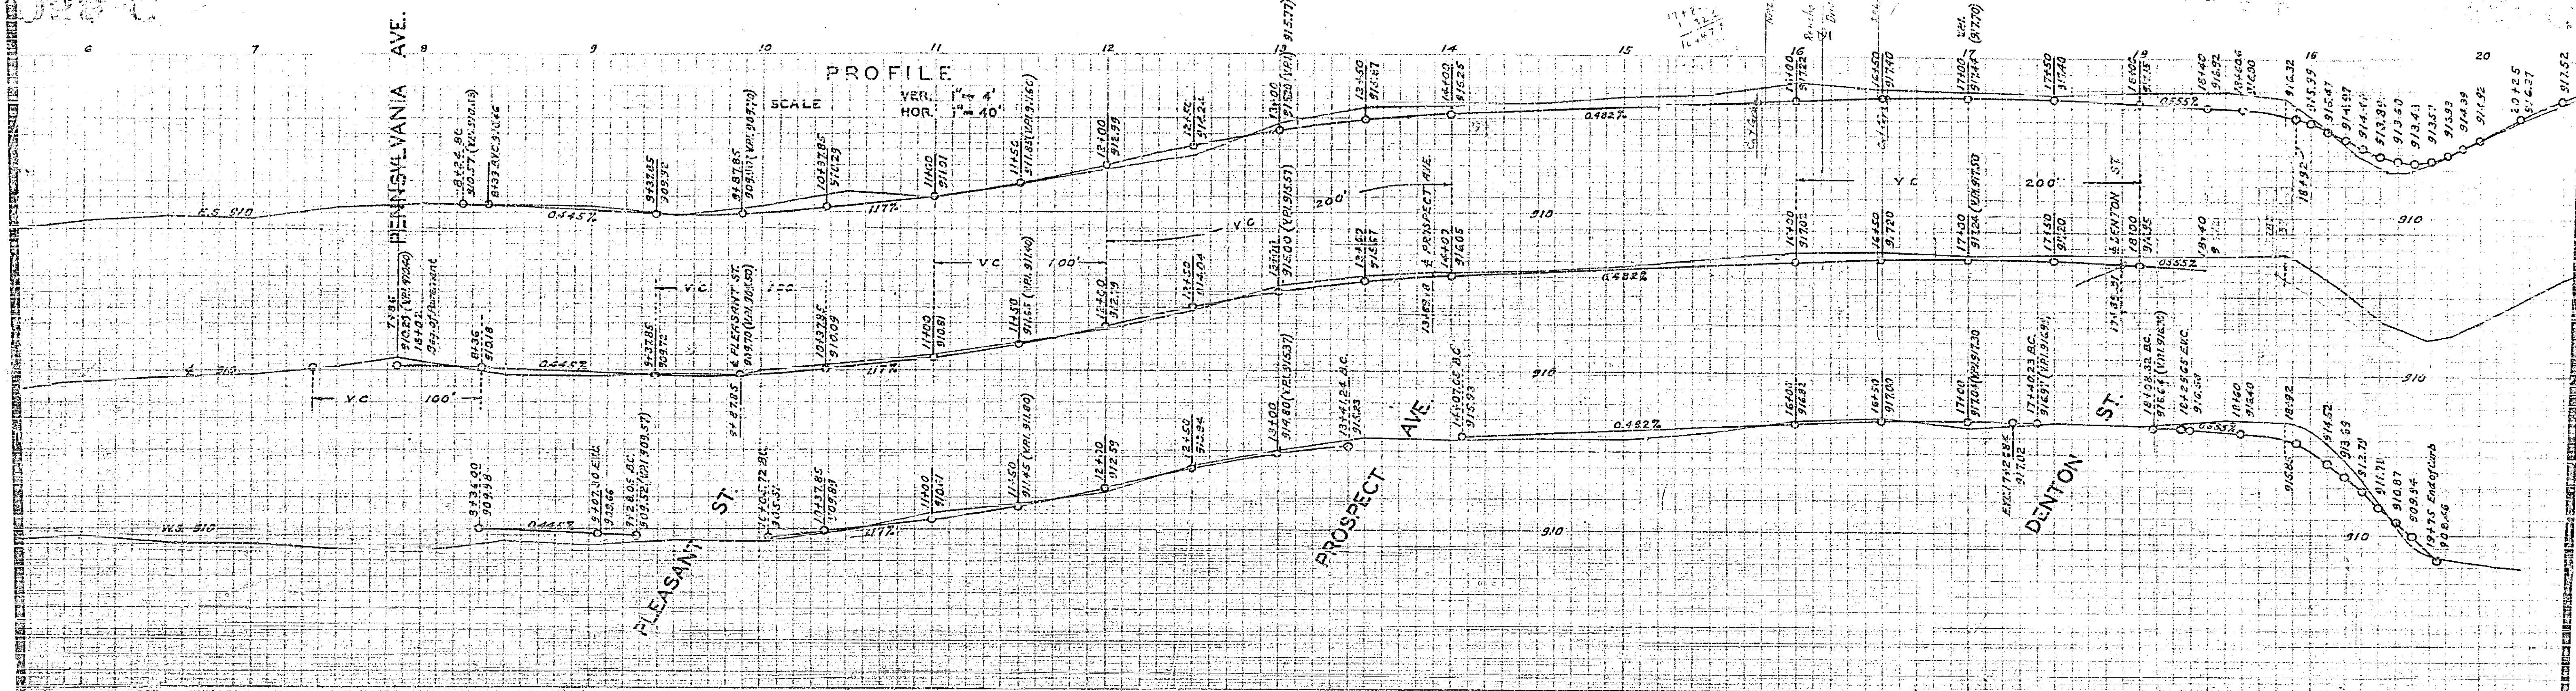


PLAN & PROFILE

Title
Date Work
Drawn

HIGH STREET
 PENNSYLVANIA AVE. TO CARLTON PL.

HIGH ST. PENNSYLVANIA TO CARLTON			
DRAWING NUMBER	SHEET NUMBER	TOTAL SHEETS	FIELD BOOKS
1059-C	1	1	390
DRAWN BY	CHECKED BY	APPROVED BY	
<i>W.E. De...</i>			

ENGINEERING DEPT. RIVERSIDE CALIF. 1941.
 CITY (U.S.G.S.) DATUM PLANE
 FIELD BOOK 390 PAGES 1-10.
 APPROVED _____
 CITY ENGINEER. REG. ENG. 1312.

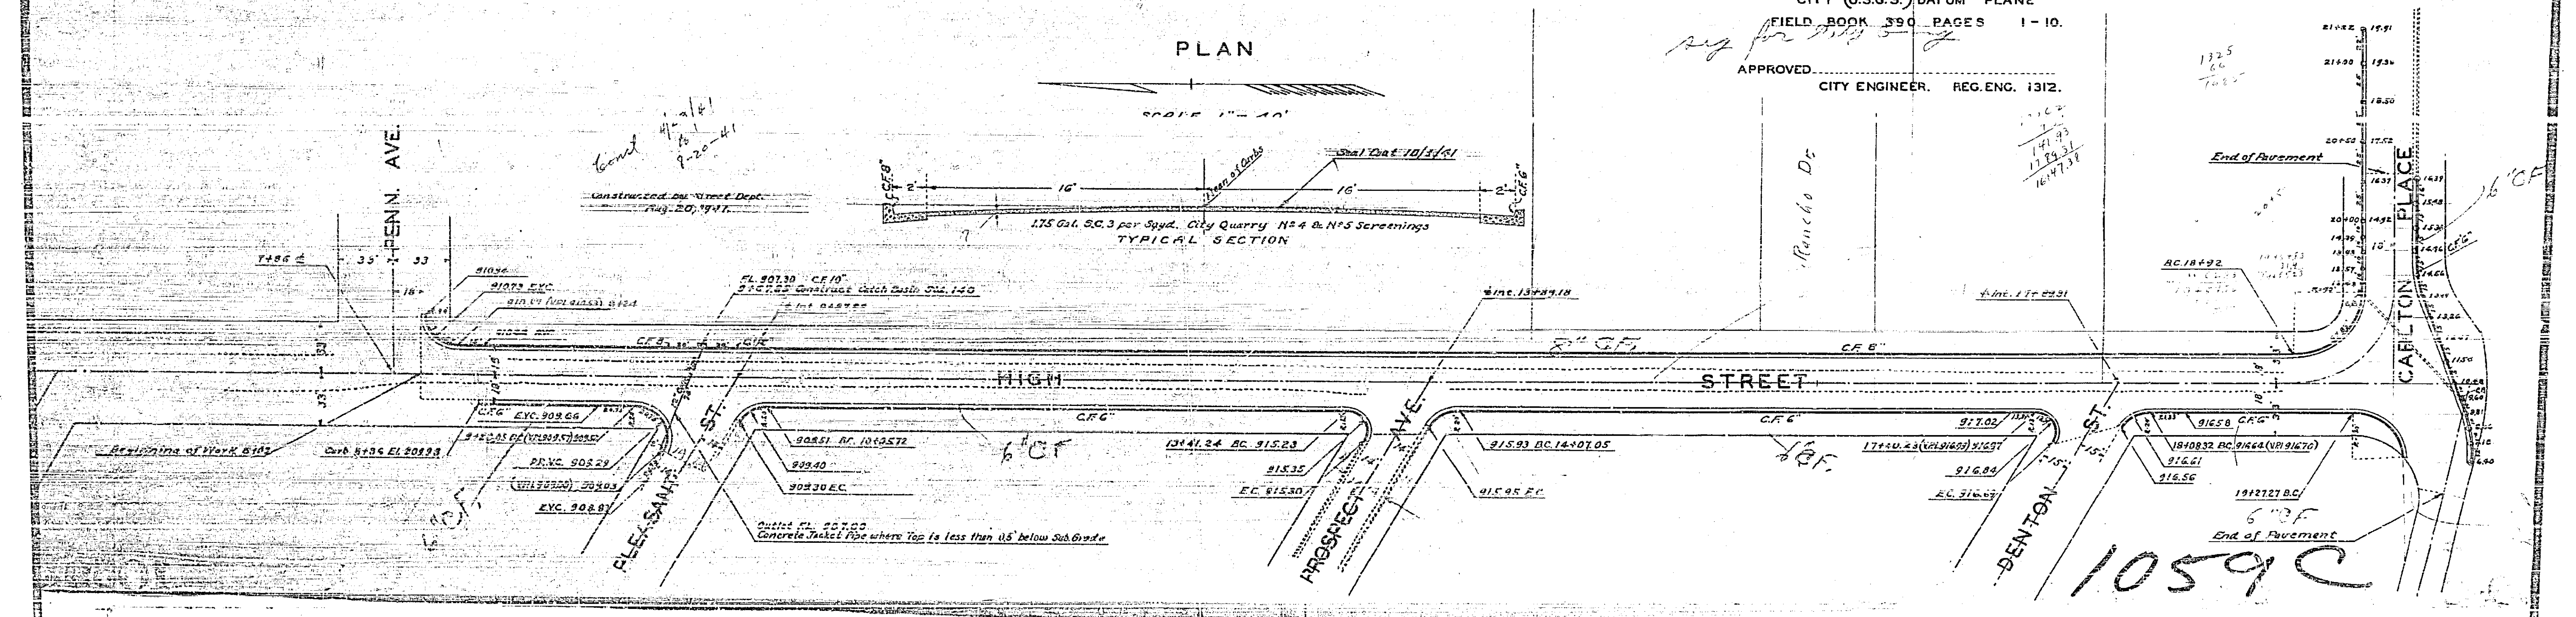

1059C