
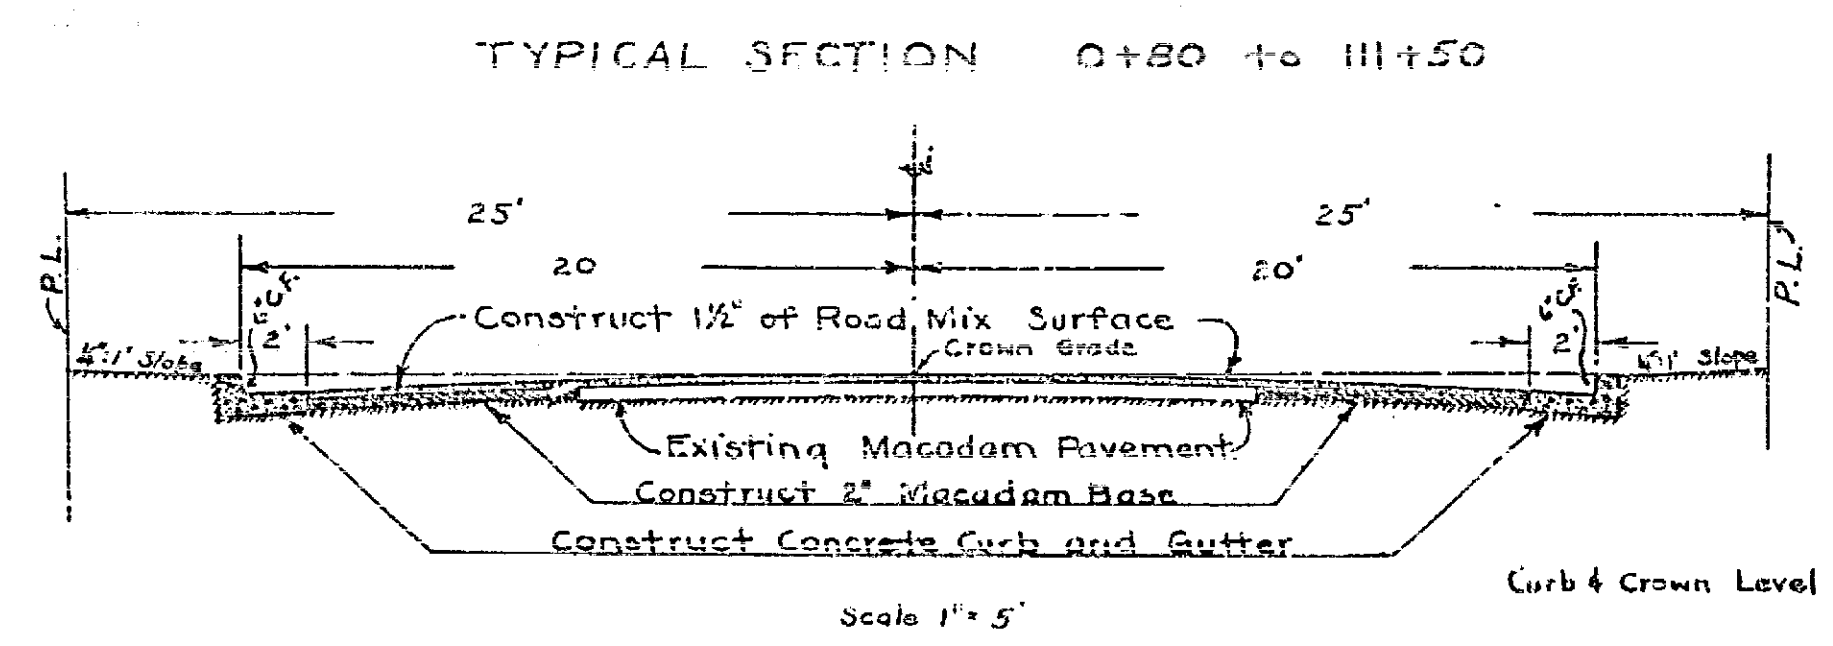
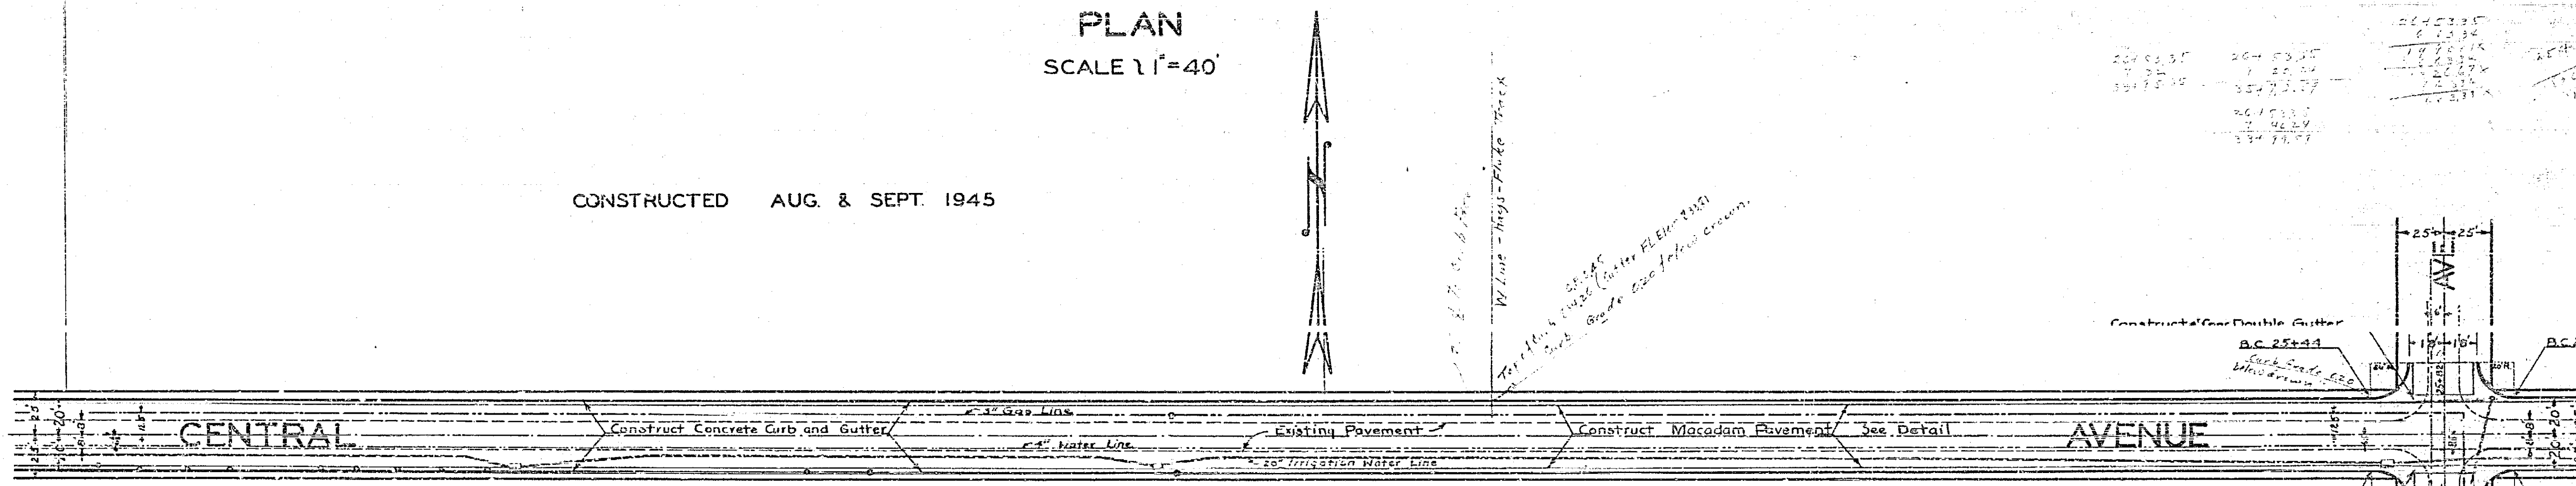


Central Ave. Macado Ave to E. City Lim			
Drawing Number	Sheet Number	Total Sheets	Total Books
1061 A	2	12	389,322
Drawn	Checked	Approved	
JULY 1945			

Abolishment
 F12377/32-25
 11567
 7547
 194
 1947

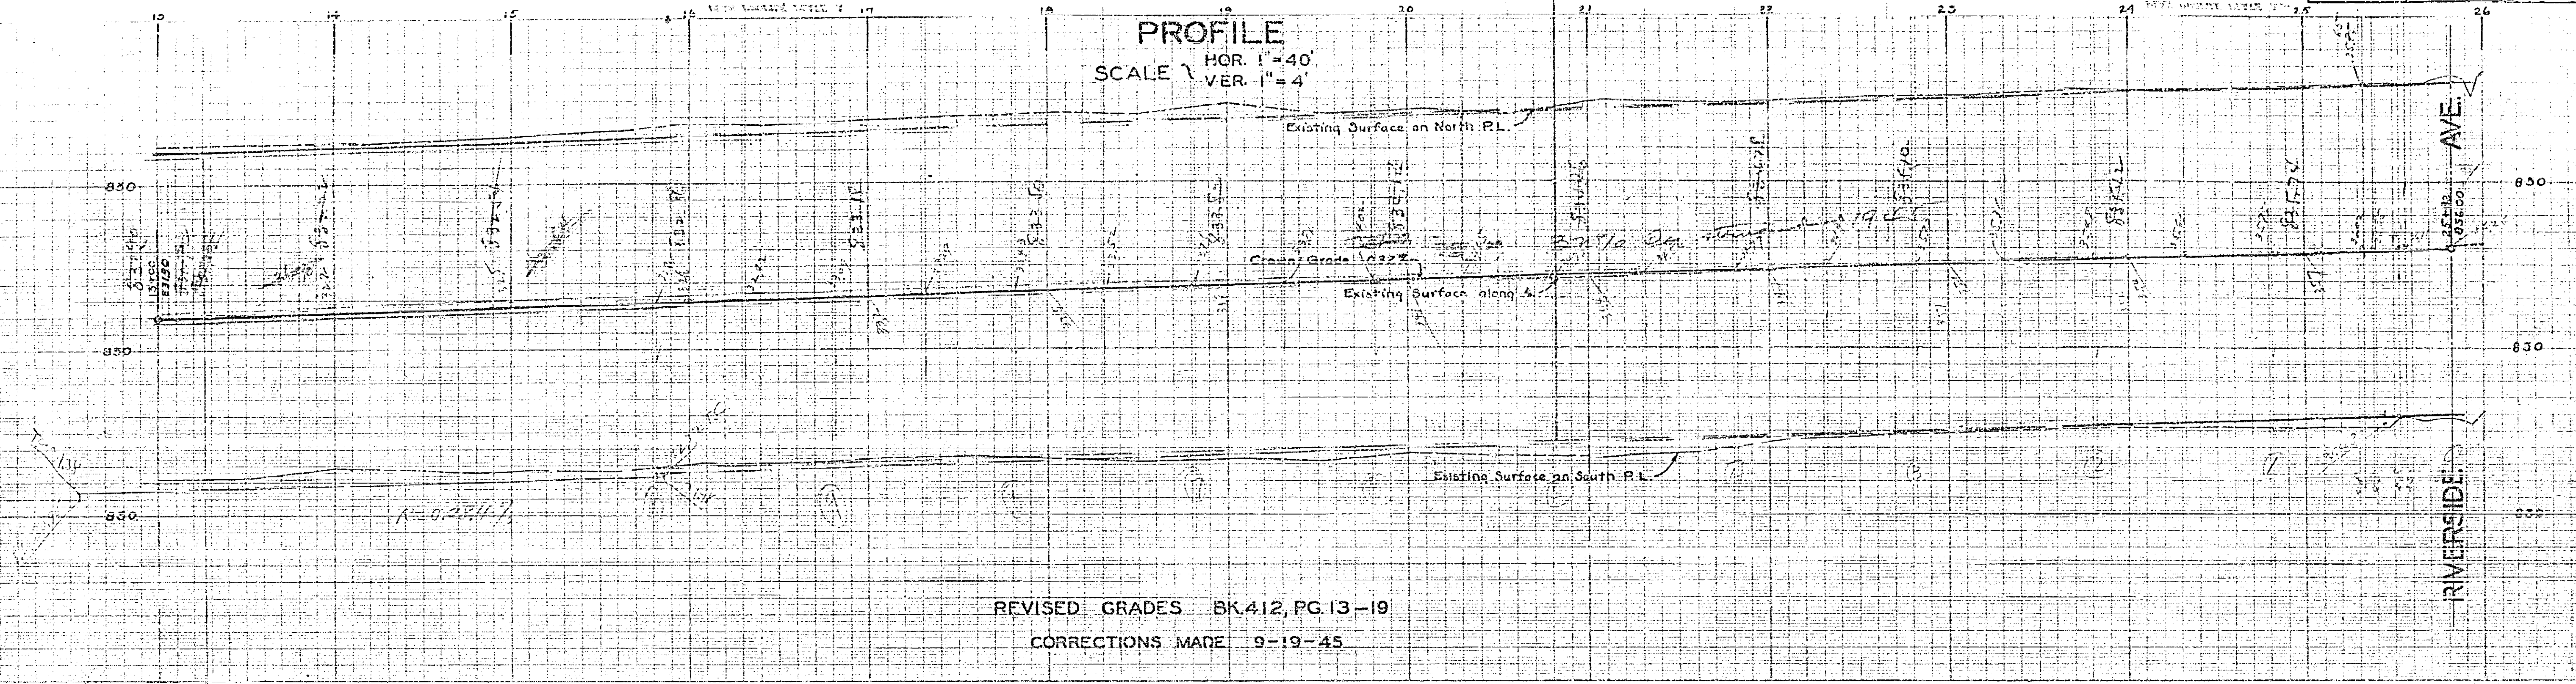


1061A


1001

Central Ave Magnolia Ave to City Lim.			
Drawing Number	Sheet Number	Total Sheets	Block
1061 A	3	12	339 332
Drawn	Checked	Approved	
JULY 1941	W.L.		


PROFILE
 HOR. 1" = 40'
 VER. 1" = 4'

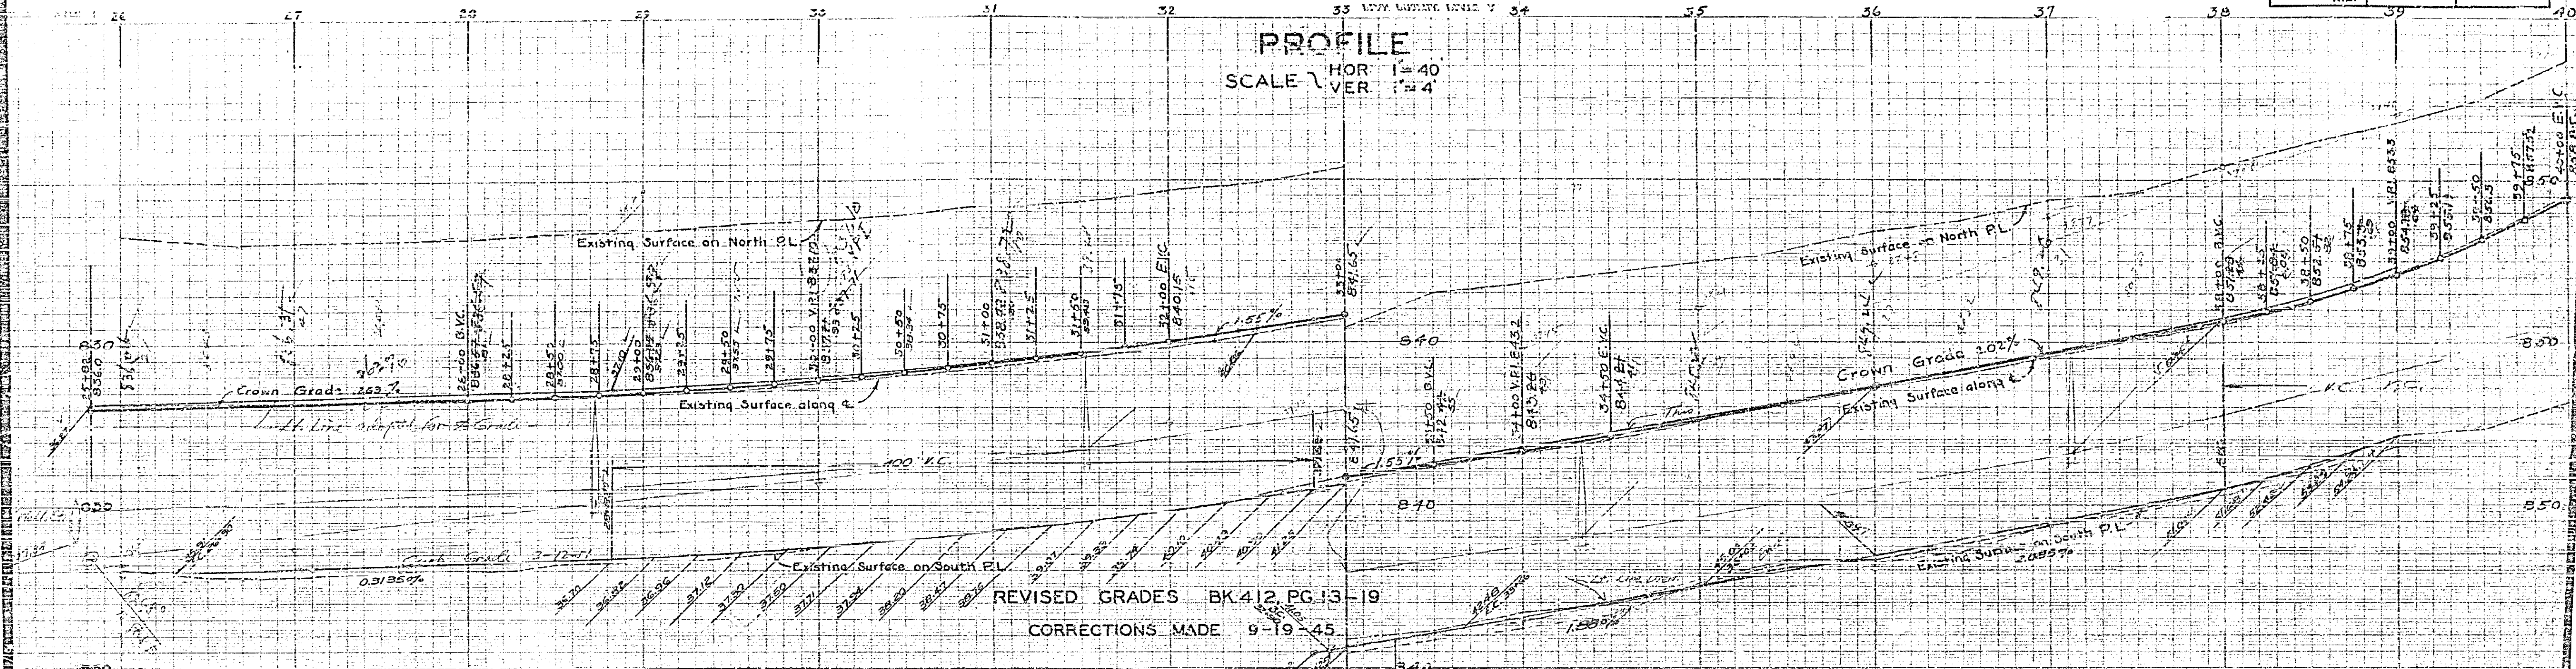

PLAN
 SCALE 1" = 40'

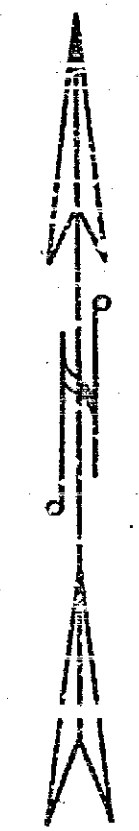


CONSTRUCTED AUG. & SEPT. 1945

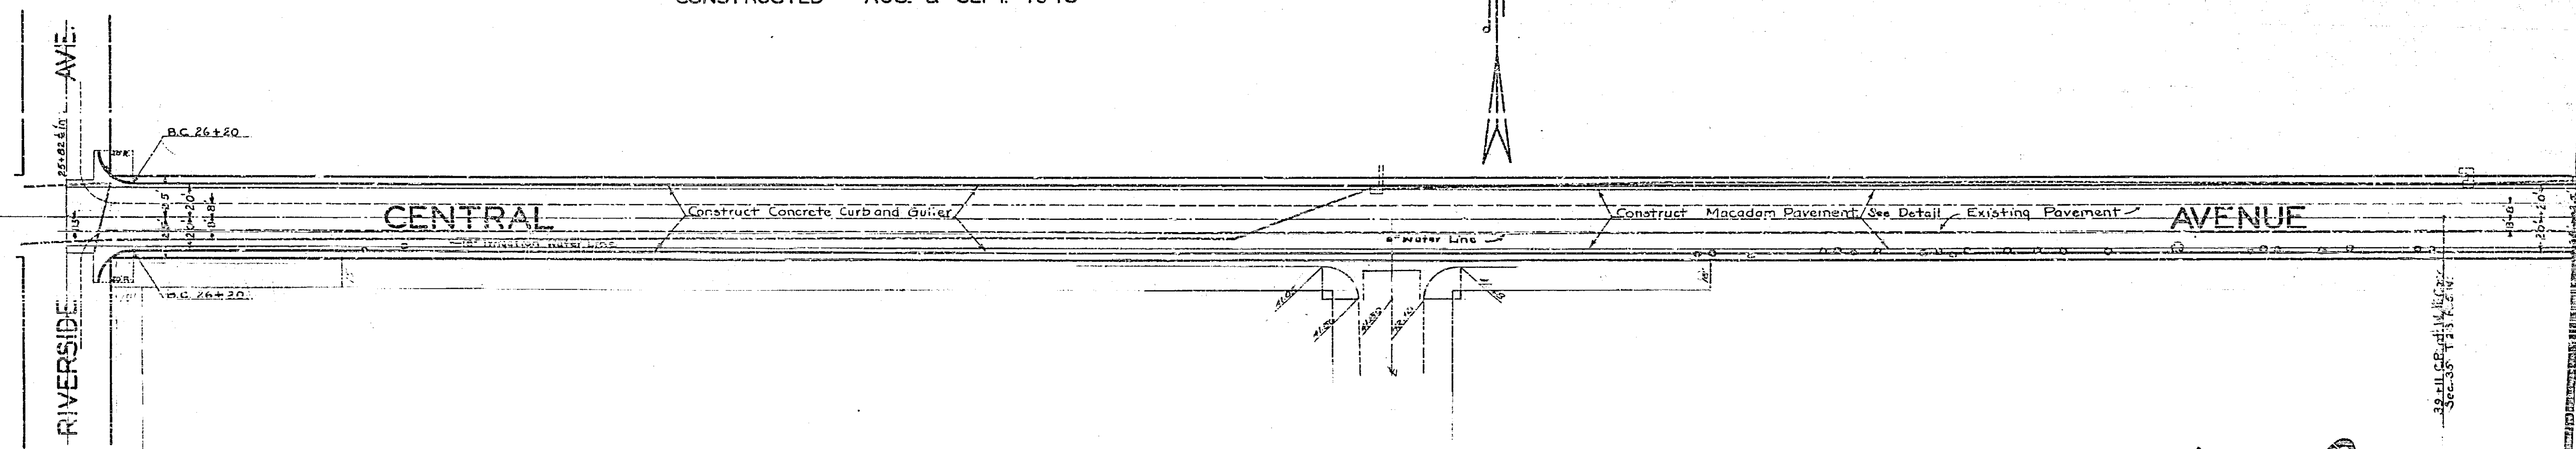


1061A

1000

Central Ave		Magnolia Ave to E. City Lim	
Drawing Number	Sheet Number	Total Sheets	Book
1061A	4	12	383592
Drawn	Checked	Approved	
JULY 1945			

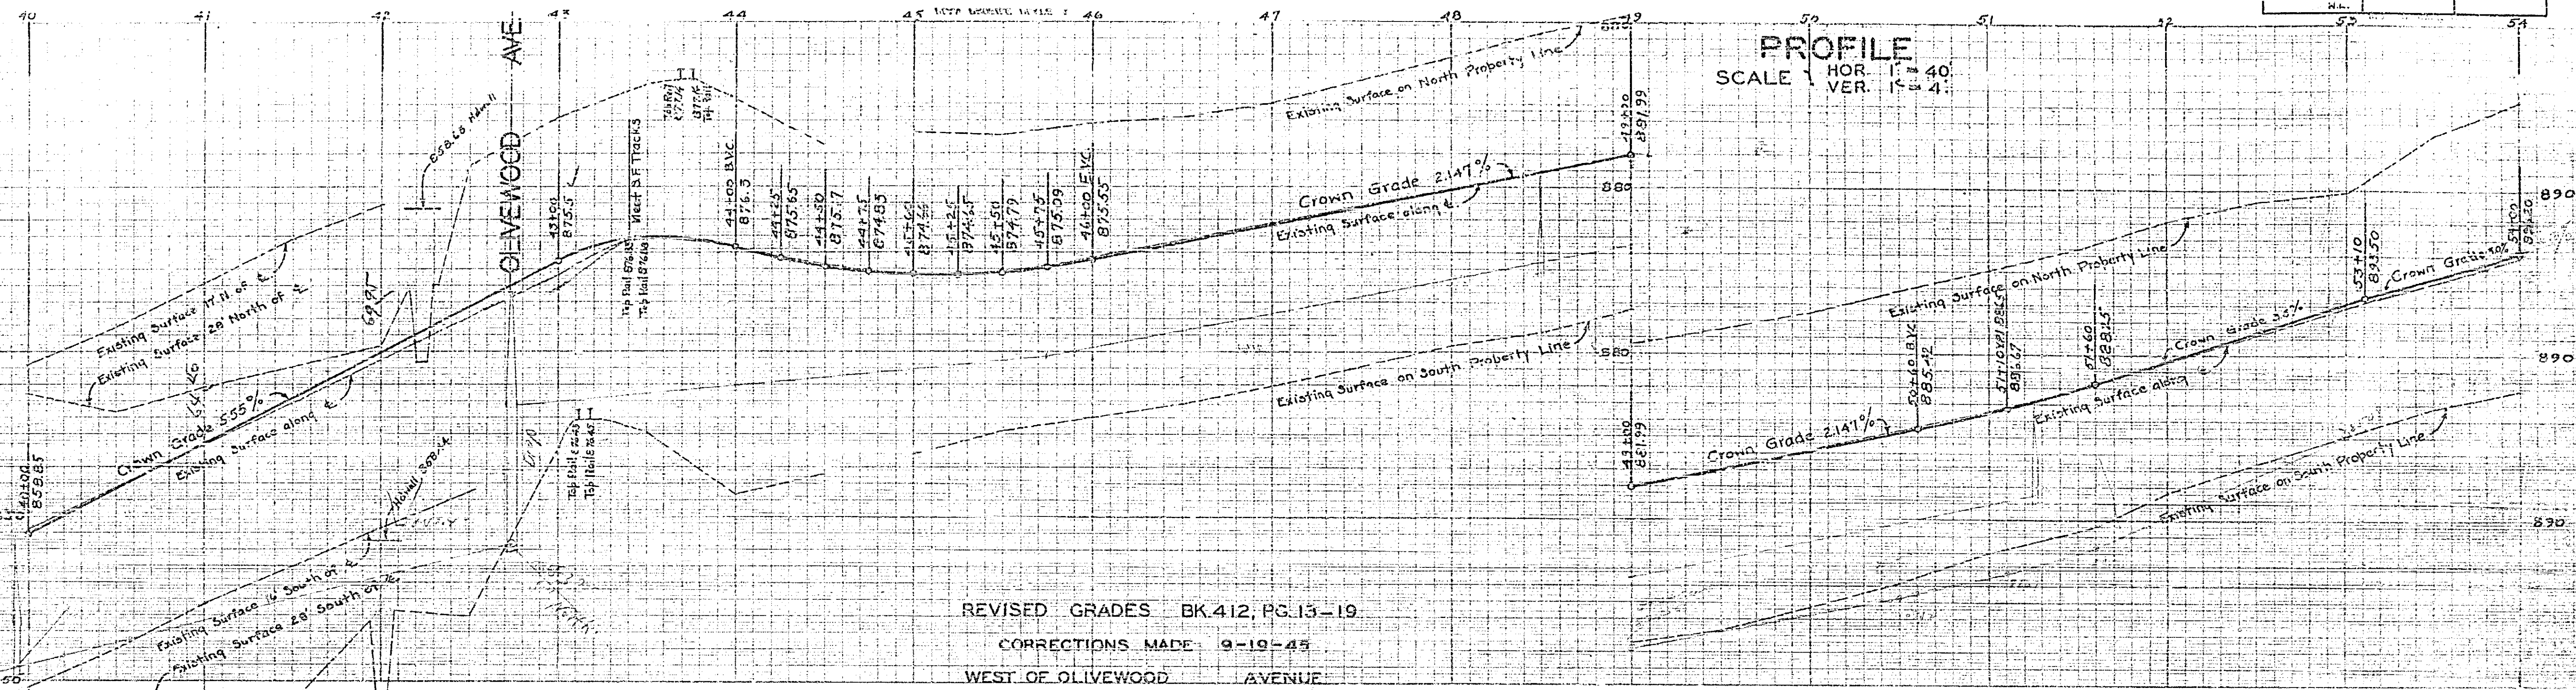


REVISED GRADES BK.412, PG.13-19
 CORRECTIONS MADE 9-19-45
 WEST OF OLIVEWOOD AVENUE

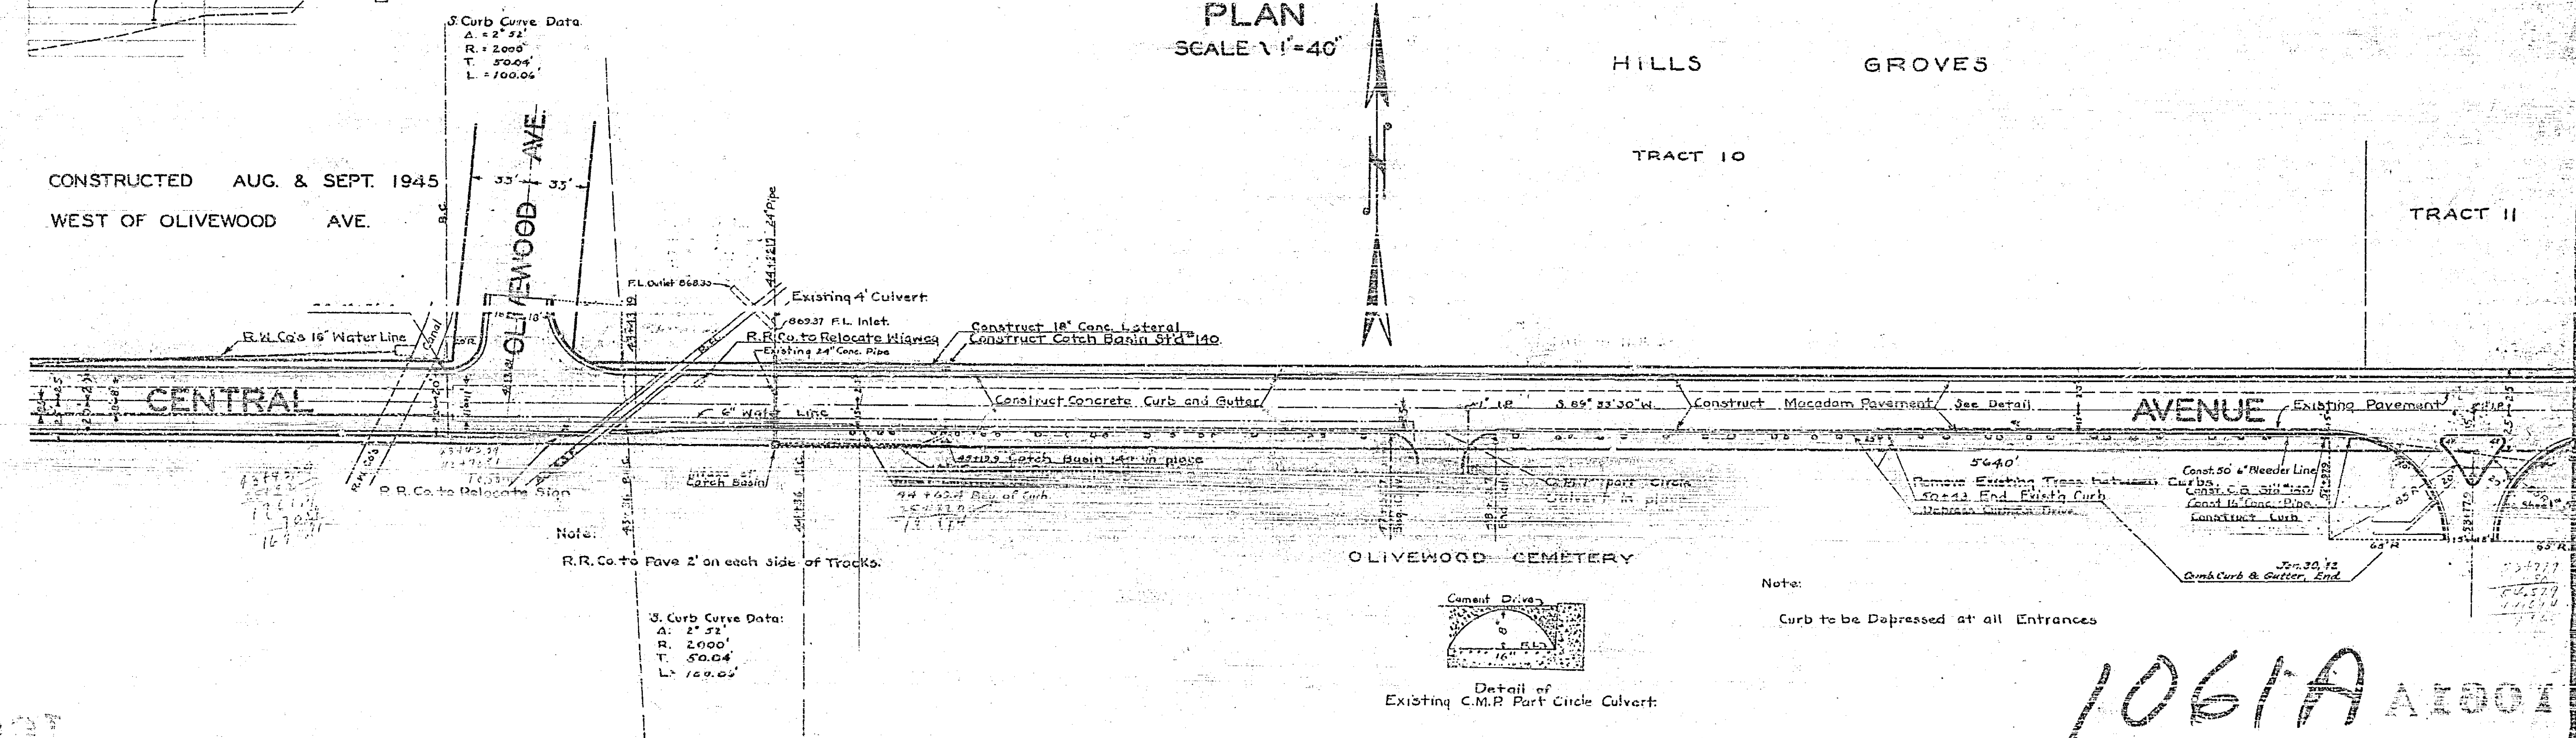

S. Curb Curve Data
 A = 2° 52'
 R = 2000'
 T = 50.04'
 L = 100.00'

S. Curb Curve Data
 A = 2° 52'
 R = 2000'
 T = 50.04'
 L = 100.00'



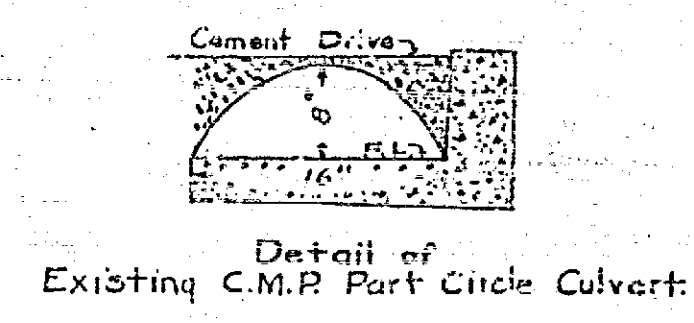


Detail of Existing C.M.R. Part Circle Culvert

Note: Curb to be Depressed at all Entrances

1061A A1501


Central Ave. Minard Ave. to F. City Line.			
Drawing Number	Sheet Number	Total Sheets	Field Books
1061 A	5	72	289,392
Drawn	Checked	Approved	
JULY 1941	W.L.		

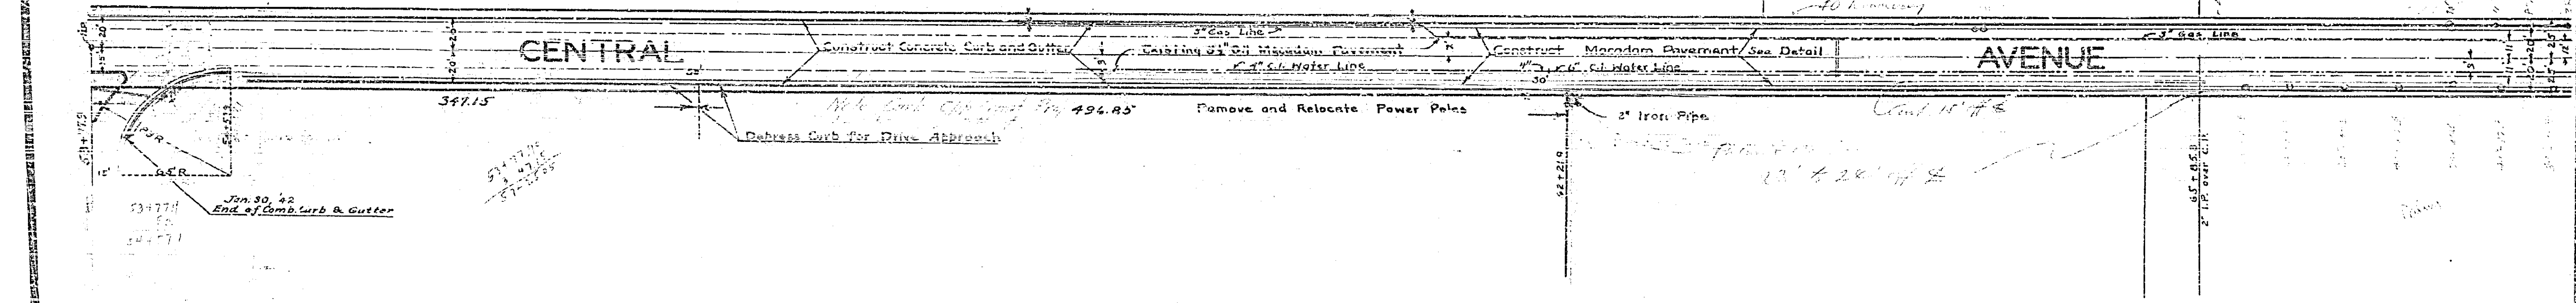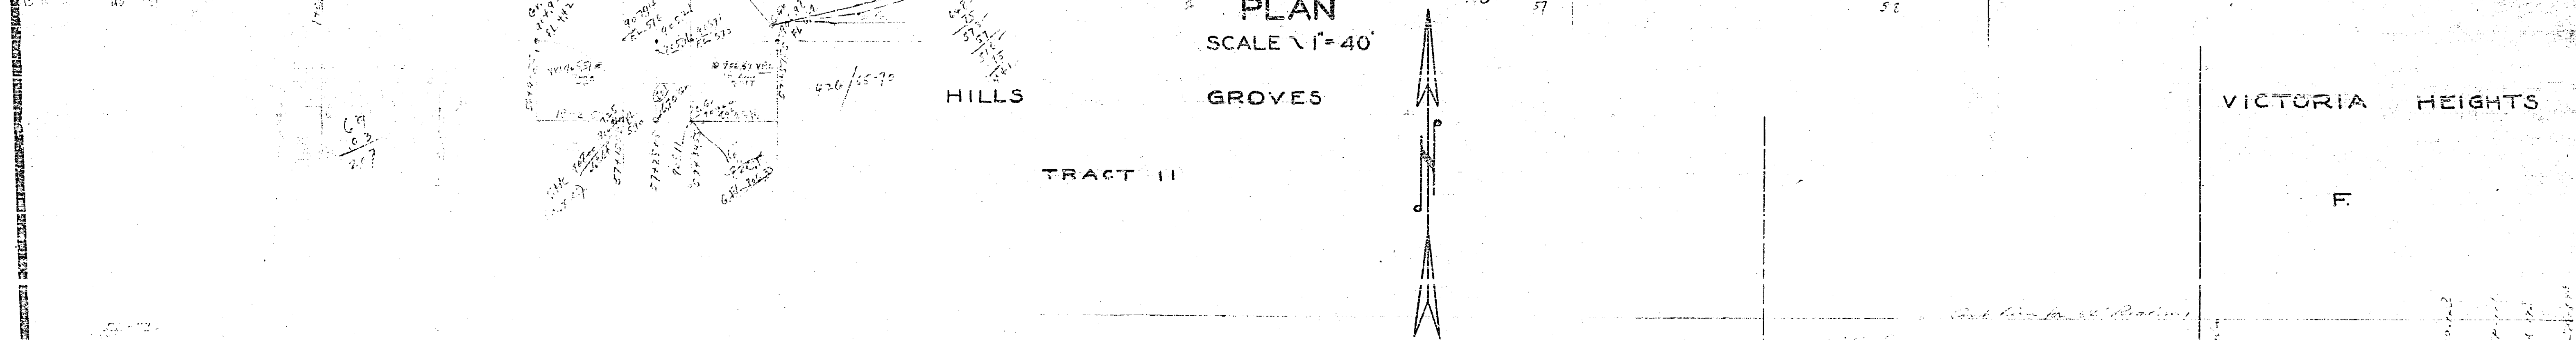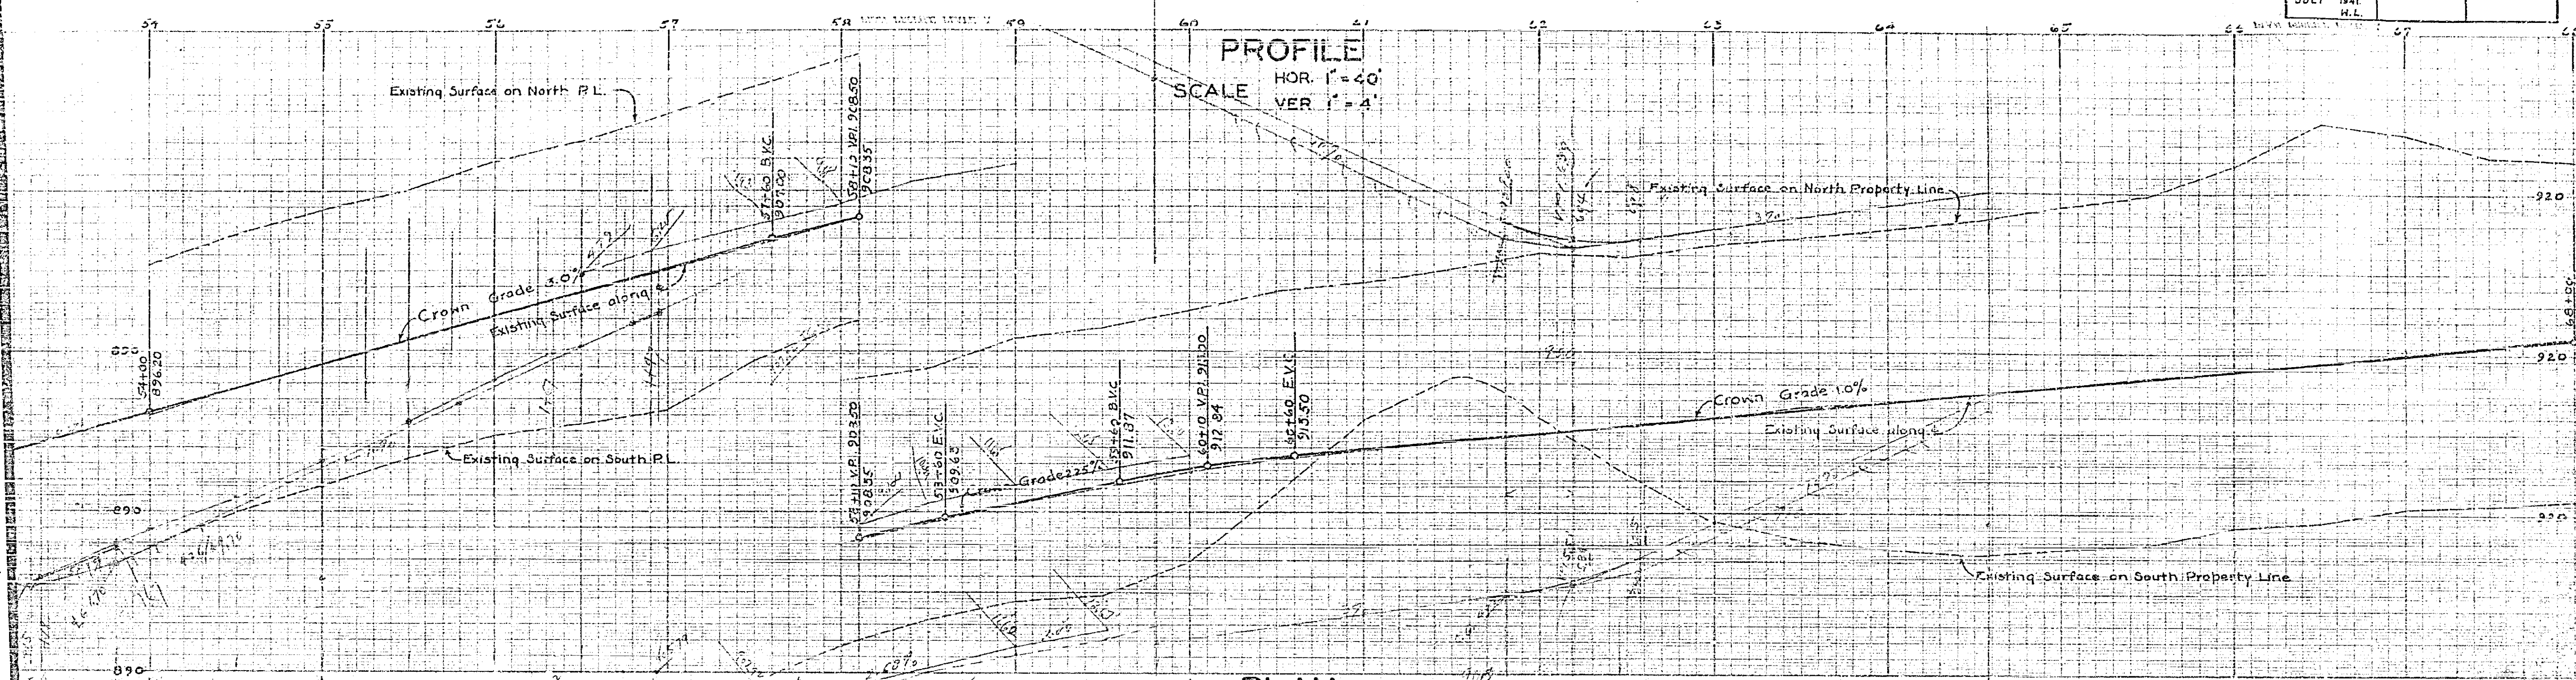

1061 A


Central Ave. Victoria Ave to E. City Lim.			
Drawing Number	Sheet Number	Total Sheets	Field Book
1061 A	6	72	38872
Drawn	Checked	Approved	
JULY 1941	H.L.		

74+09.46
13 20

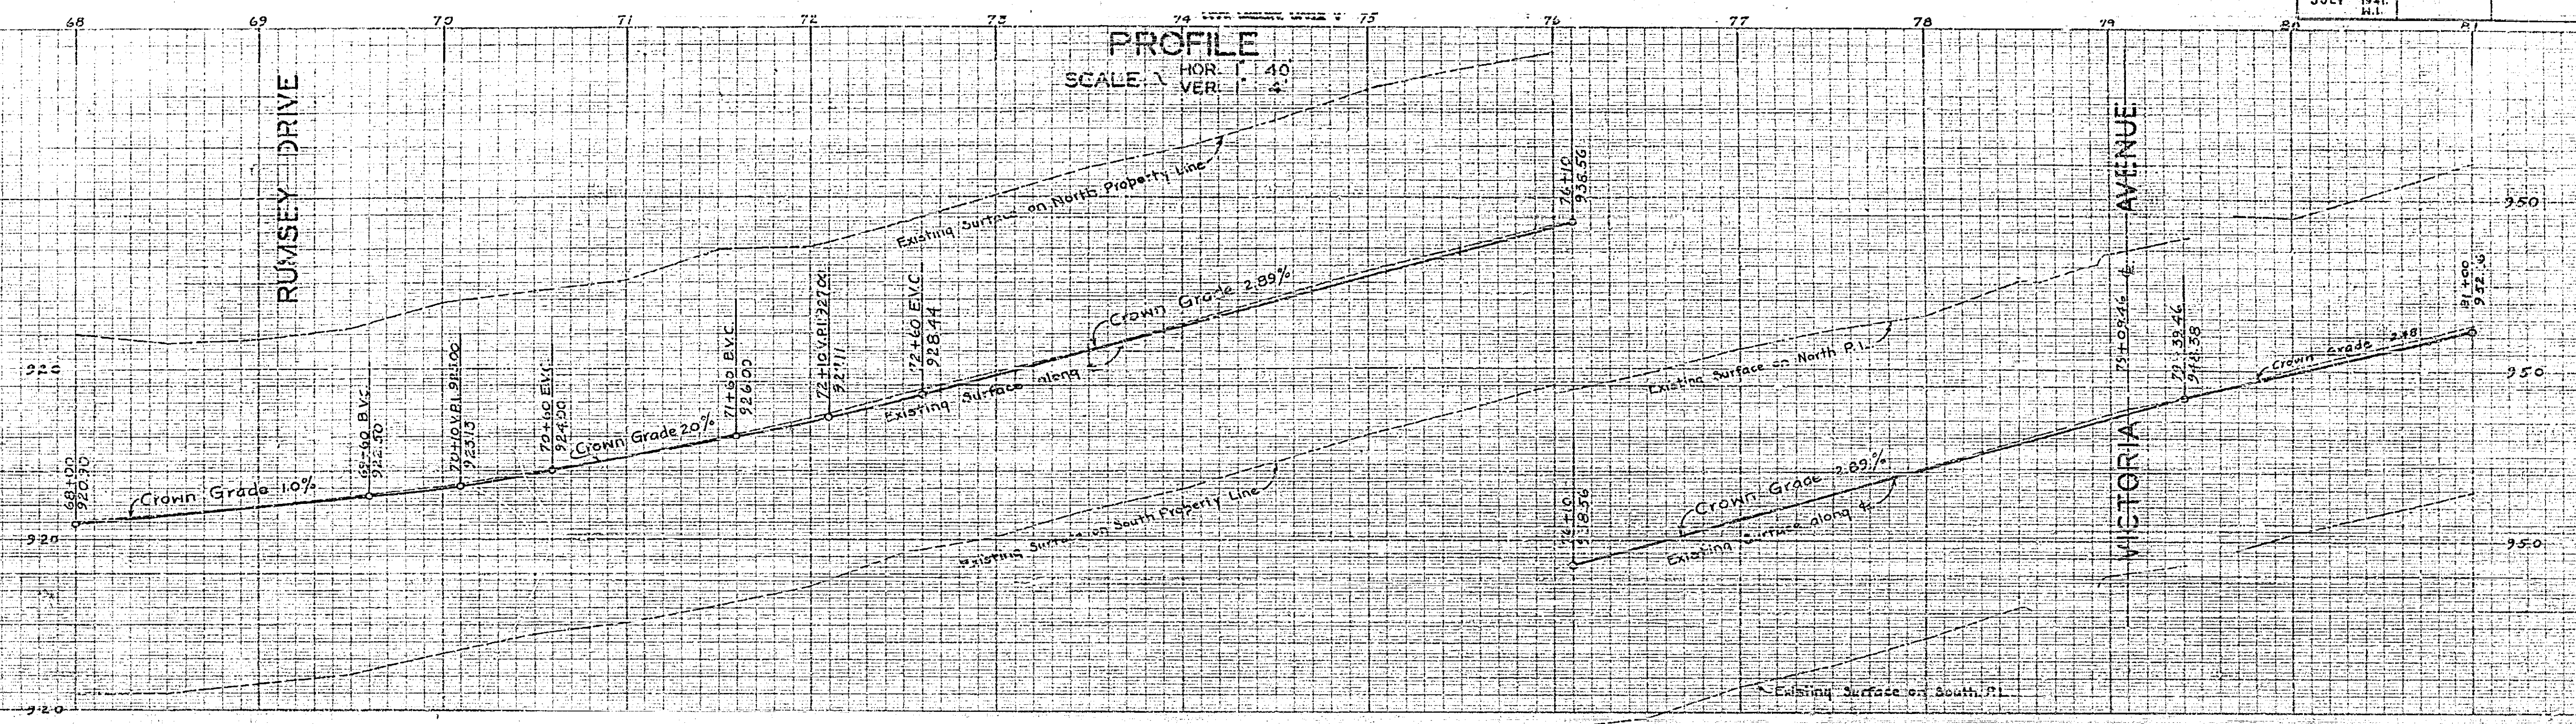


PLAN
SCALE 1" = 40'

74+09.46
72+67.72

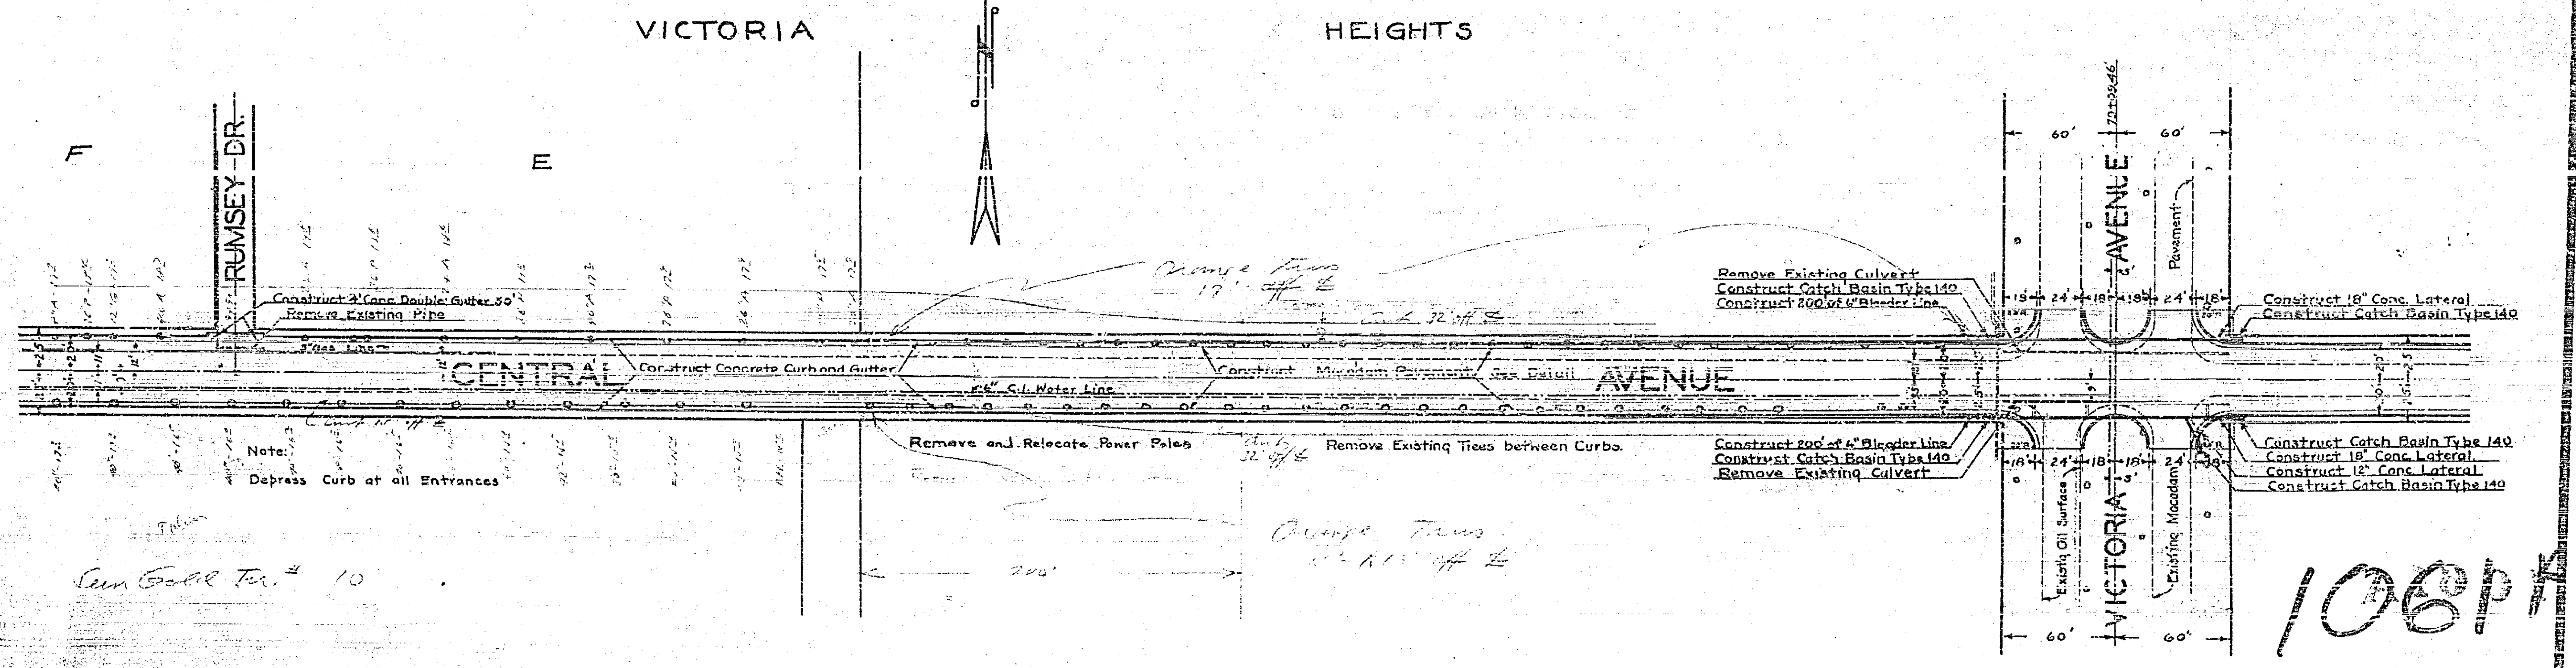


1061 A

Central Ave Manalima Ave to City Lim.			
Drawing Number	Sheet Number	Total Sheets	Field Book
1061 A.	7	123	597-598-599
Drawn	Checked	Approved	
JULY 1941	N.L.		

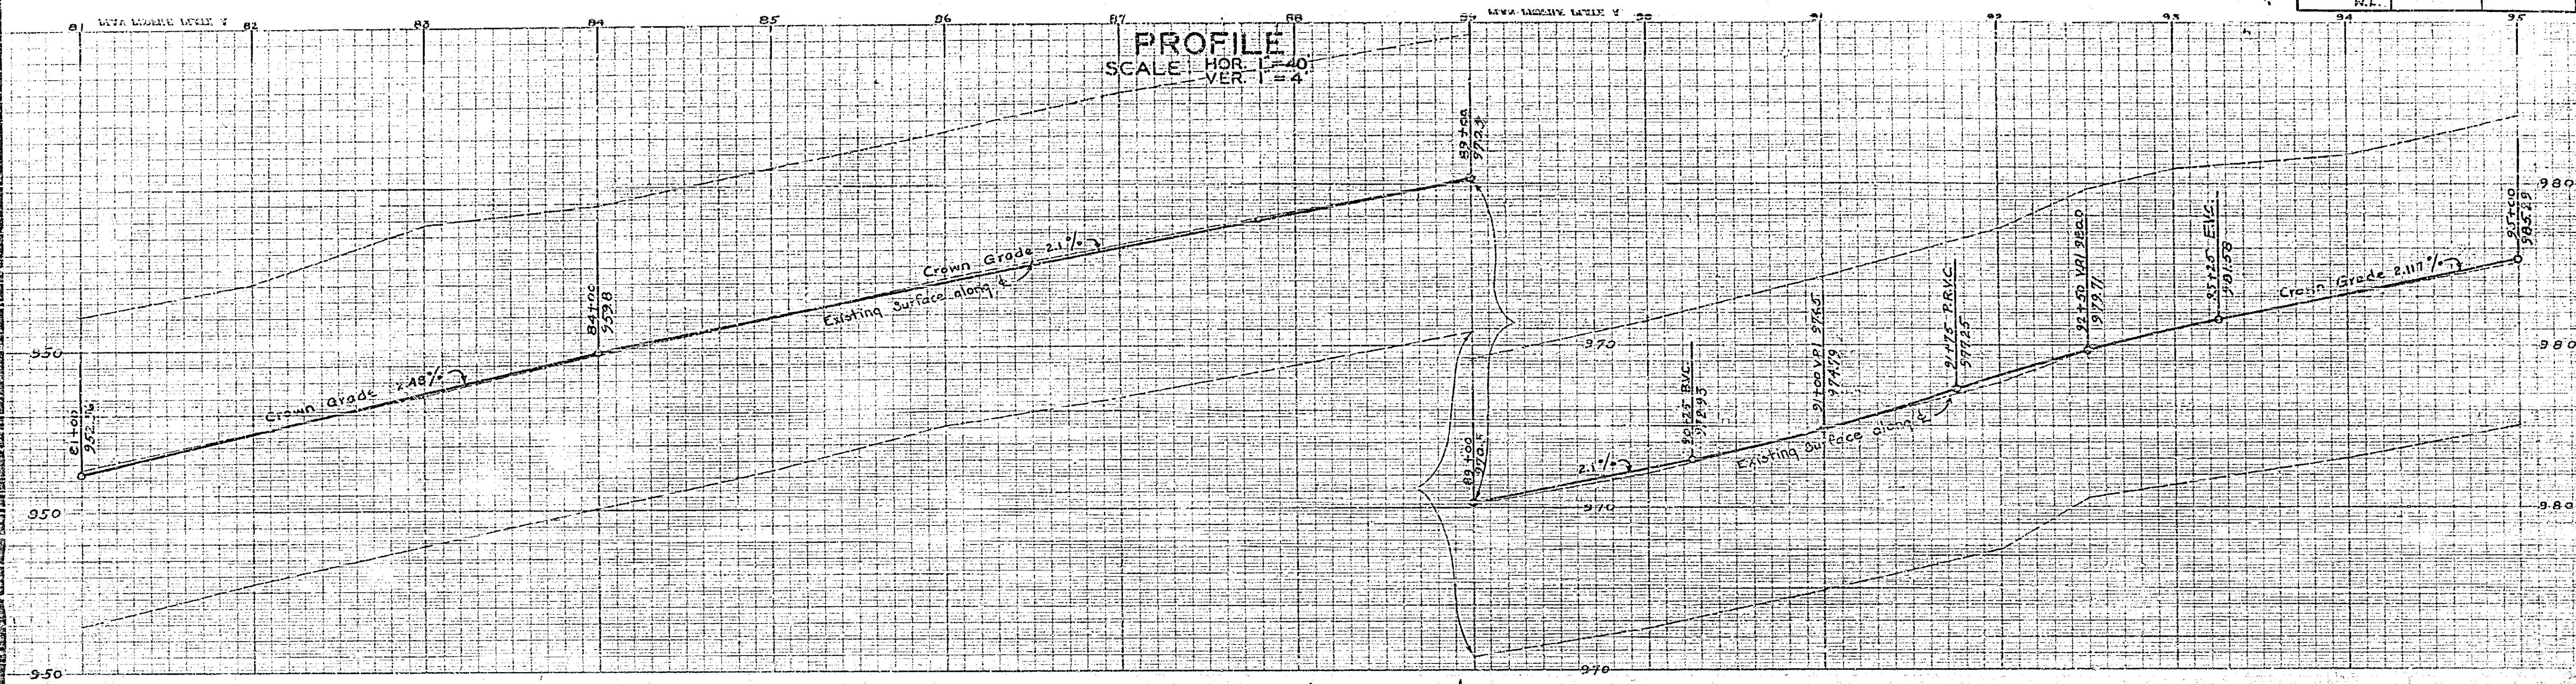

PROFILE
 SCALE: HOR. 1"=40'
 VER. 1"=4'


PLAN
 SCALE 1"=40'

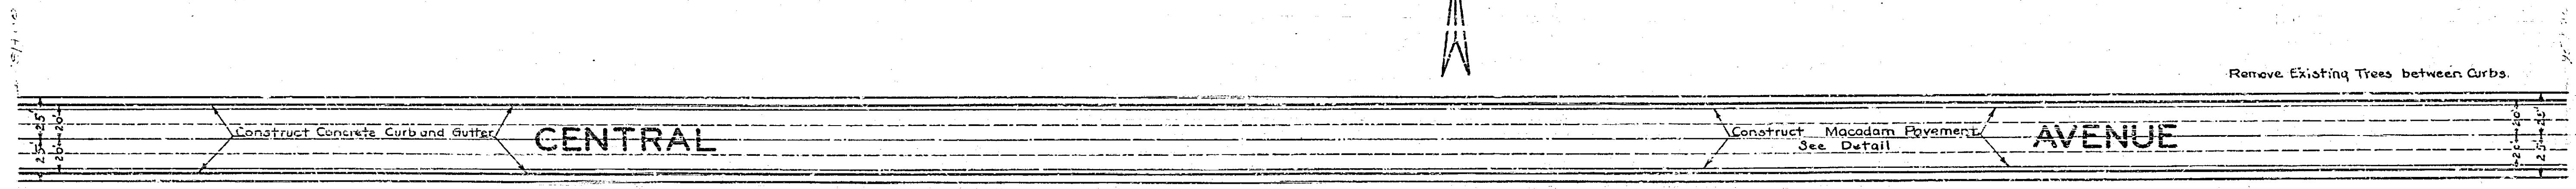


1061 A

1061A


Central Ave. Magnolia Ave. to E. City Line			
Drawing Number	Sheet Number	Total Sheets	Field Book
1061 A	8	12	1289.312
Drawn	Checked	Approved	
JULY 1941			

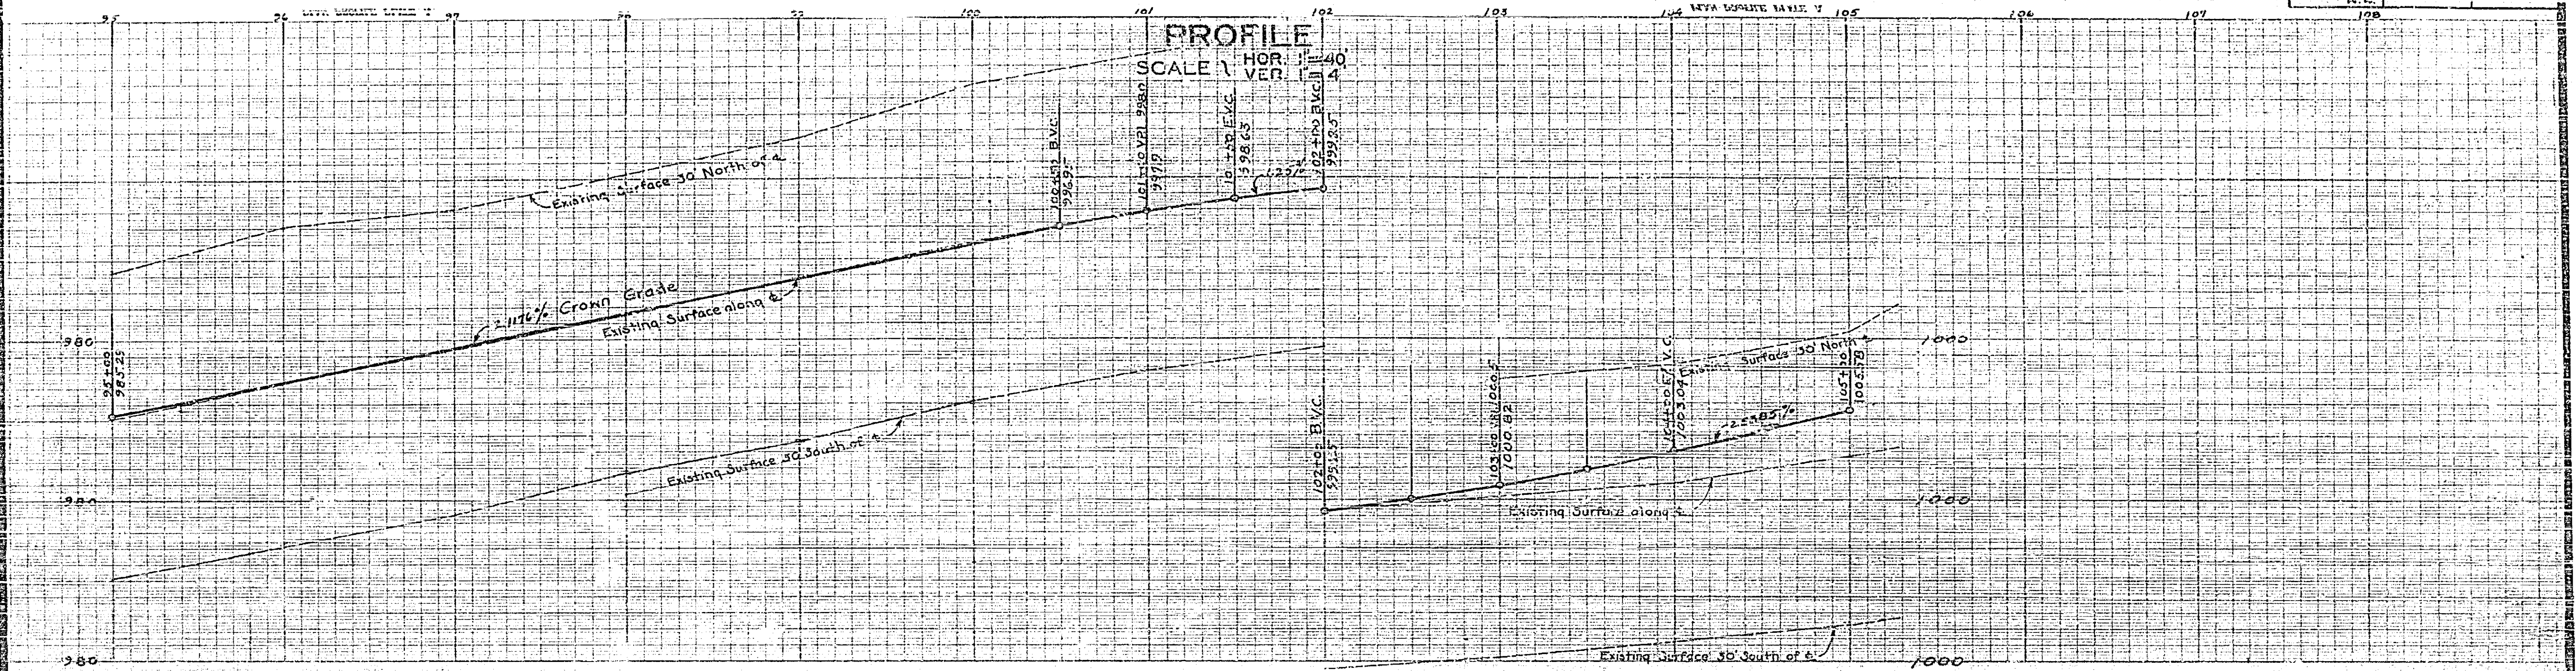

PLAN
SCALE 1"=40'




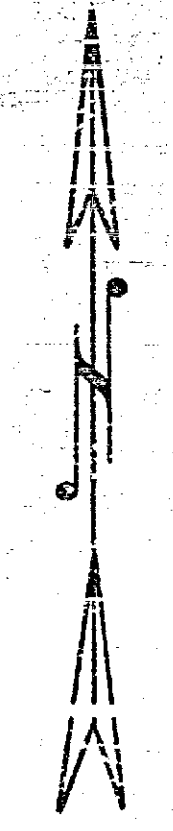


Remove Existing Trees between Curbs

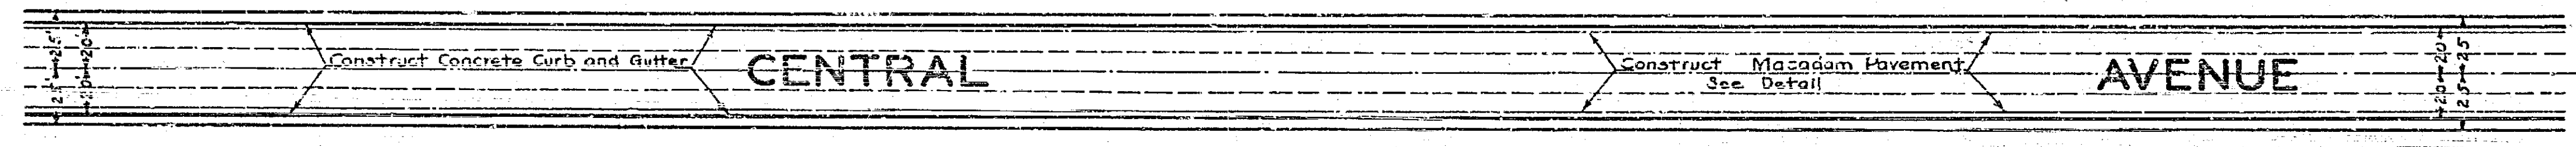

1061A

Central Ave. Magnolia Ave. to City Lim.			
Drawing Number	Sheet Number	Project No.	Scale
1061 A	9	1000	1" = 40'
Drawn	Checked	Approved	
JULY 1941			

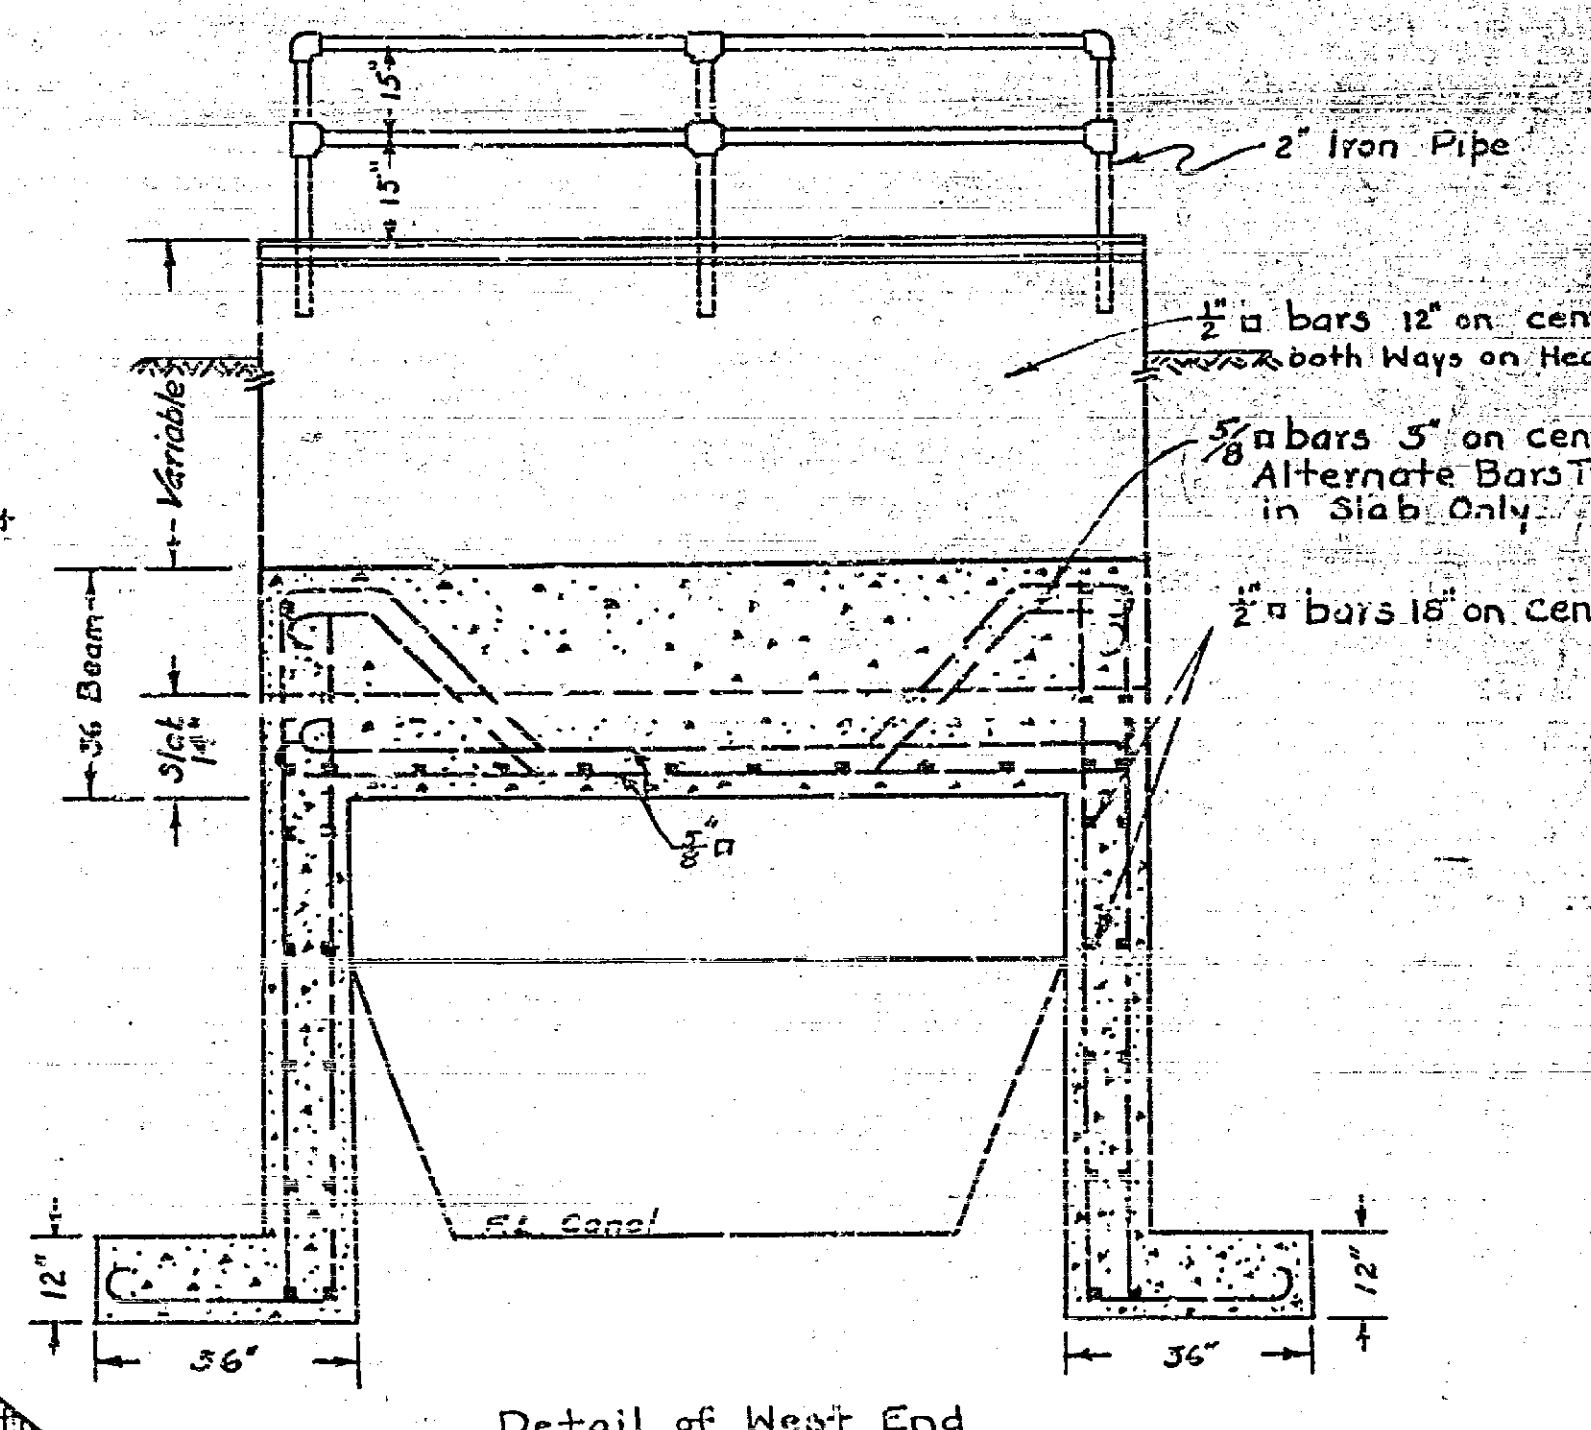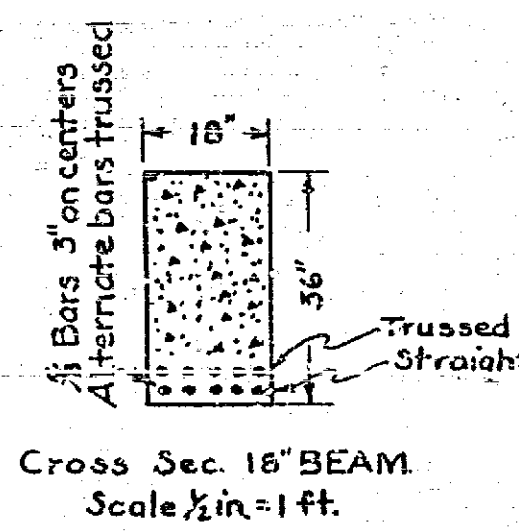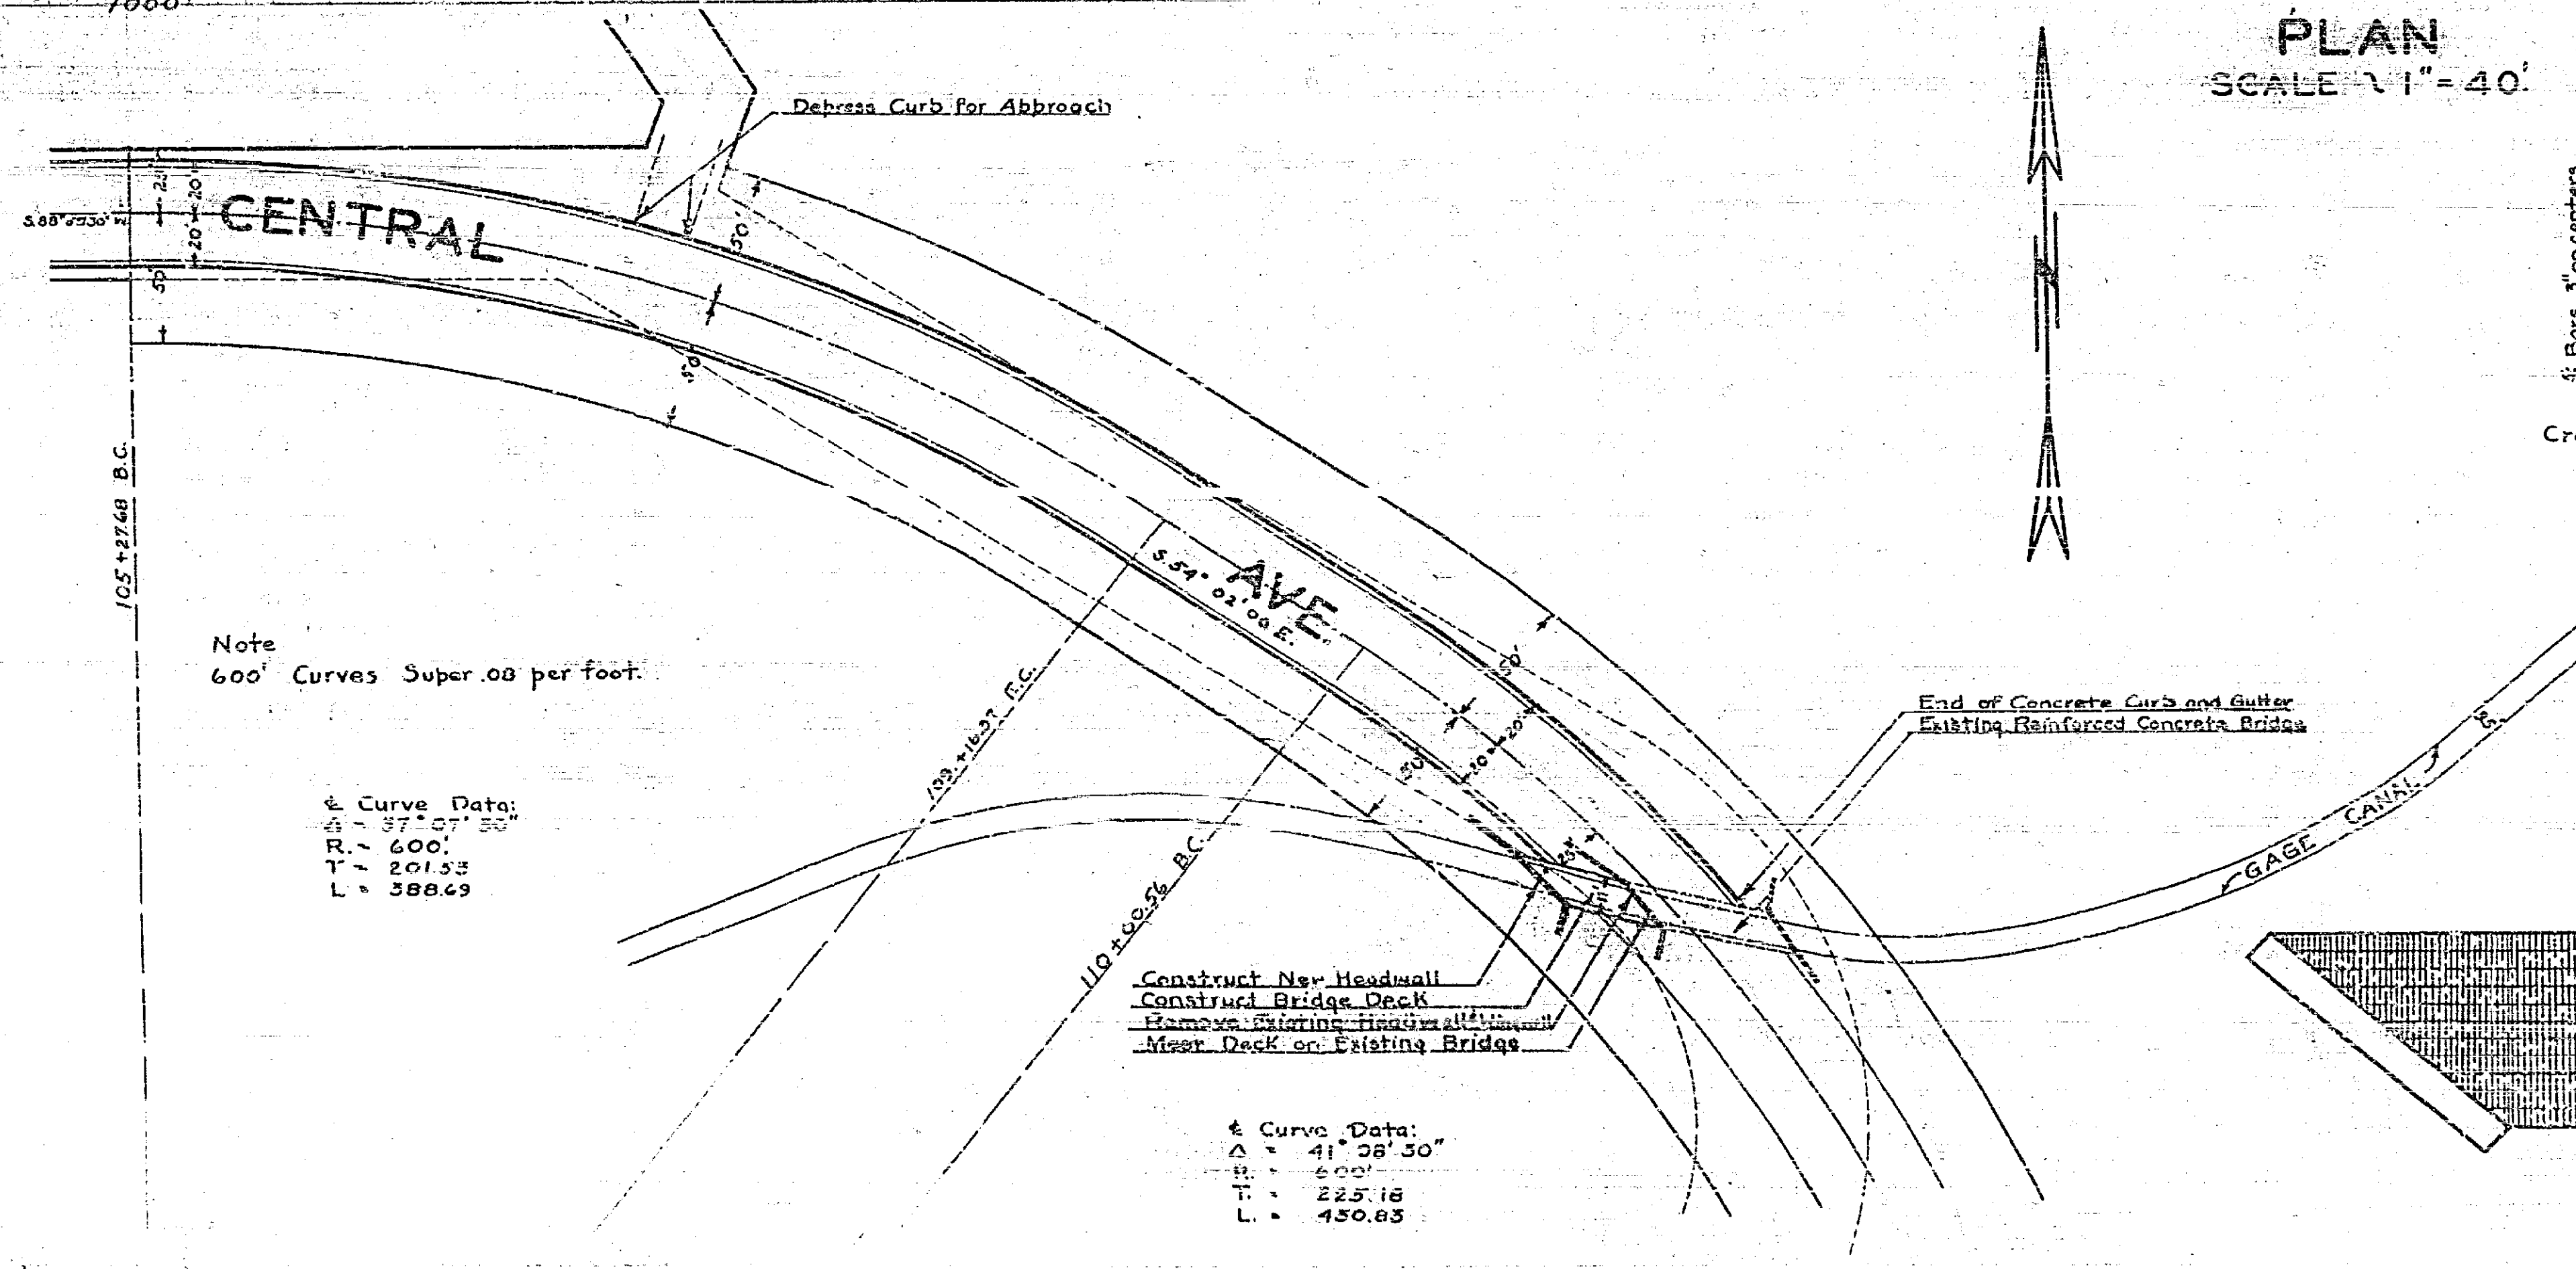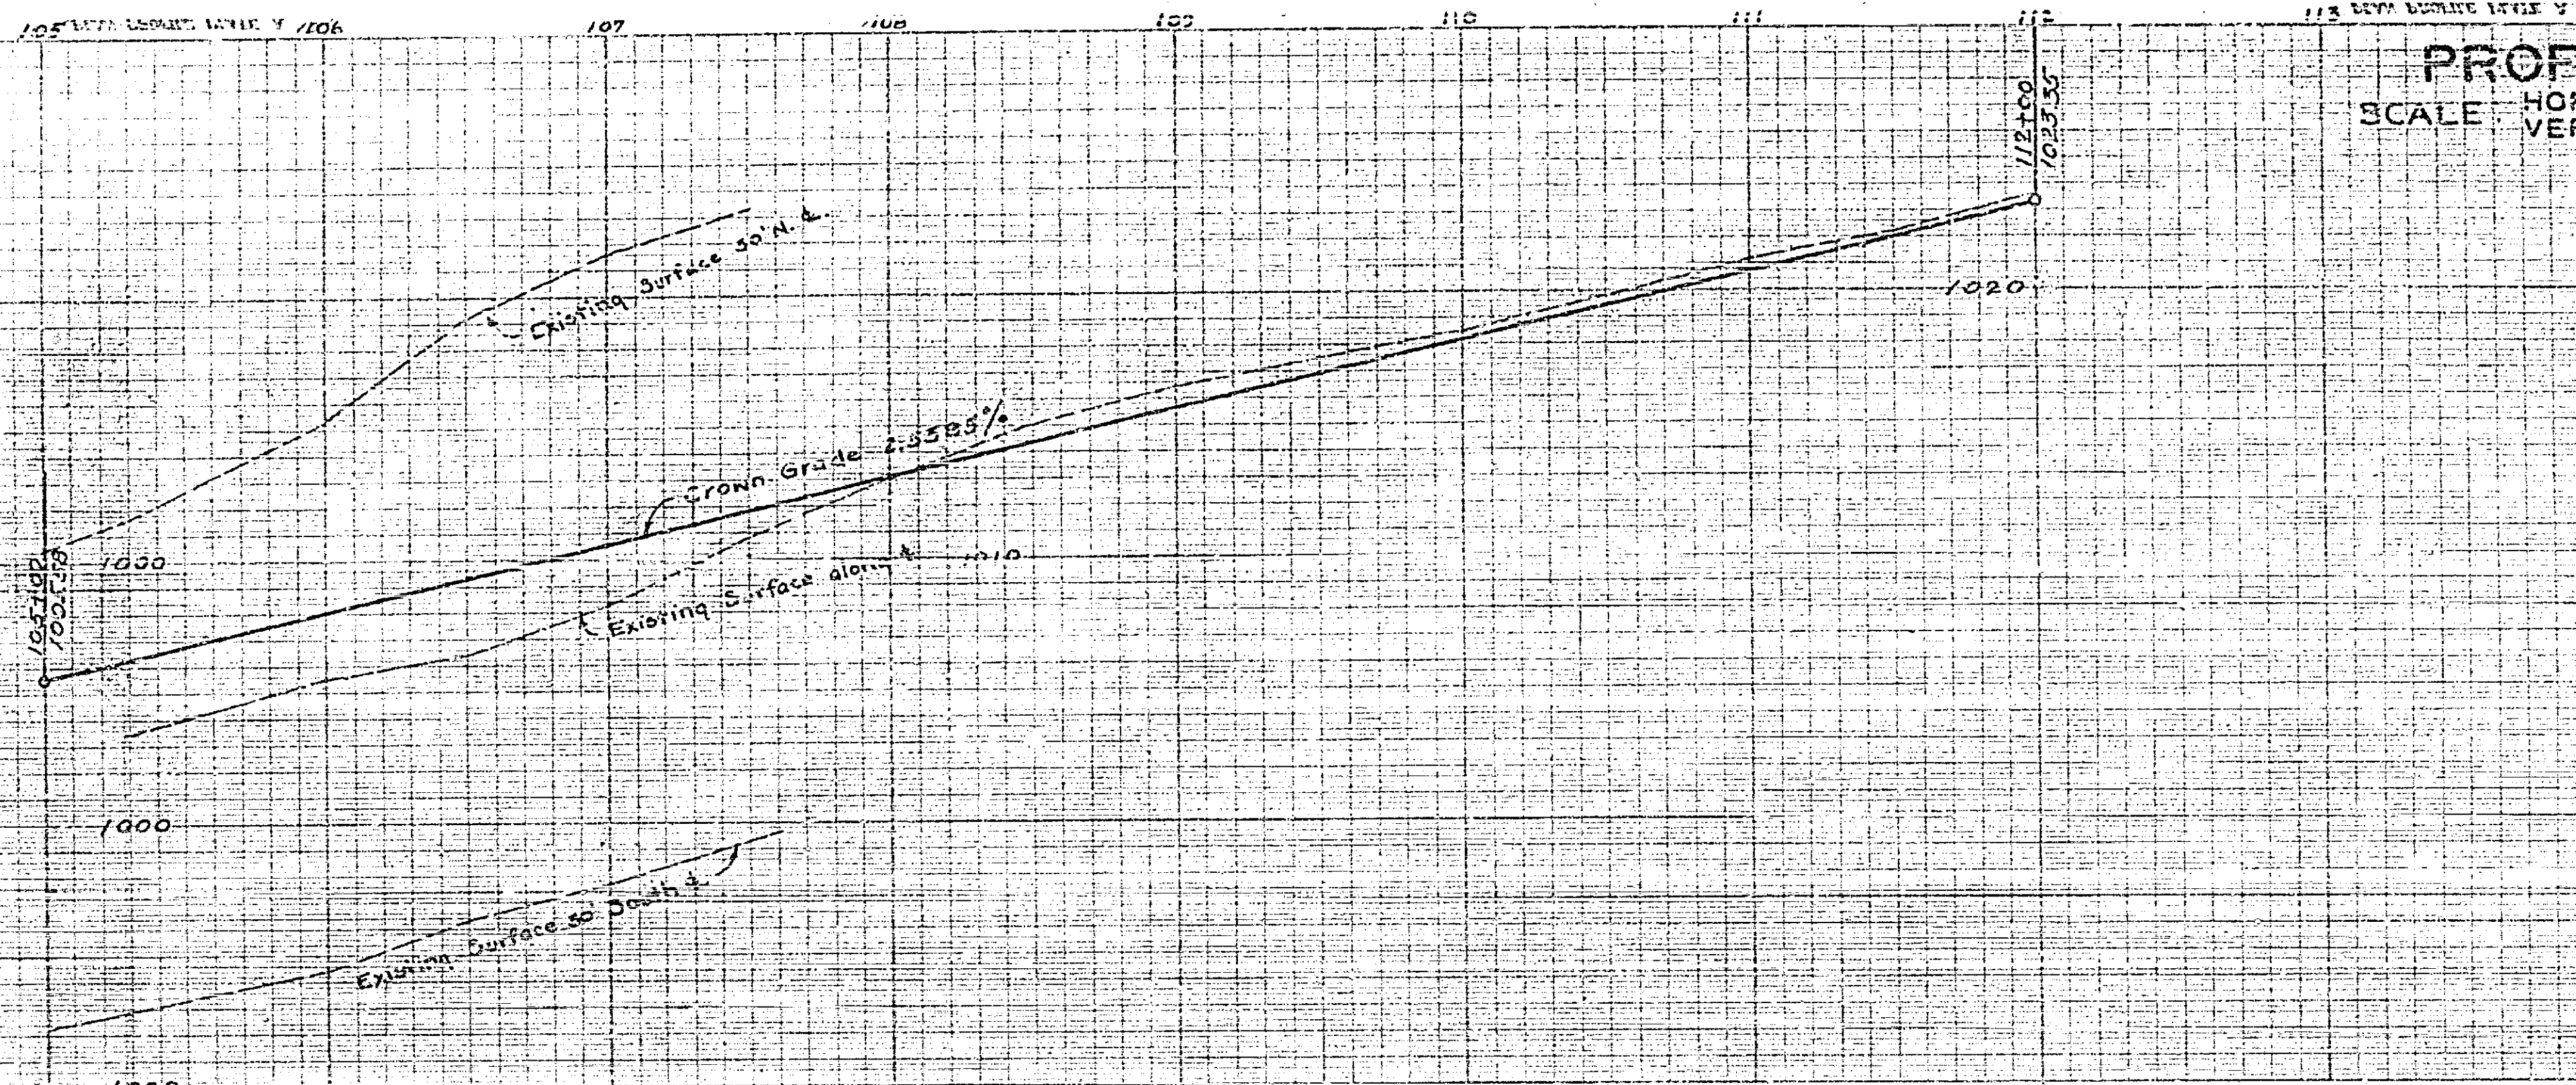


Detail of West End
REINFORCED CONCRETE BRIDGE

Notes:
Slab across Bridge Deck
5/8" Bars 3" C.C.
1/2" Bars 12" C.C.


Reinforced Concrete Bridge Deck.

1061 A

Central Ave. Magnolia Ave to E. City	Sheet	Total	1061 A
Drawn	Checked	Approved	
JULY 1921	H. Lee		

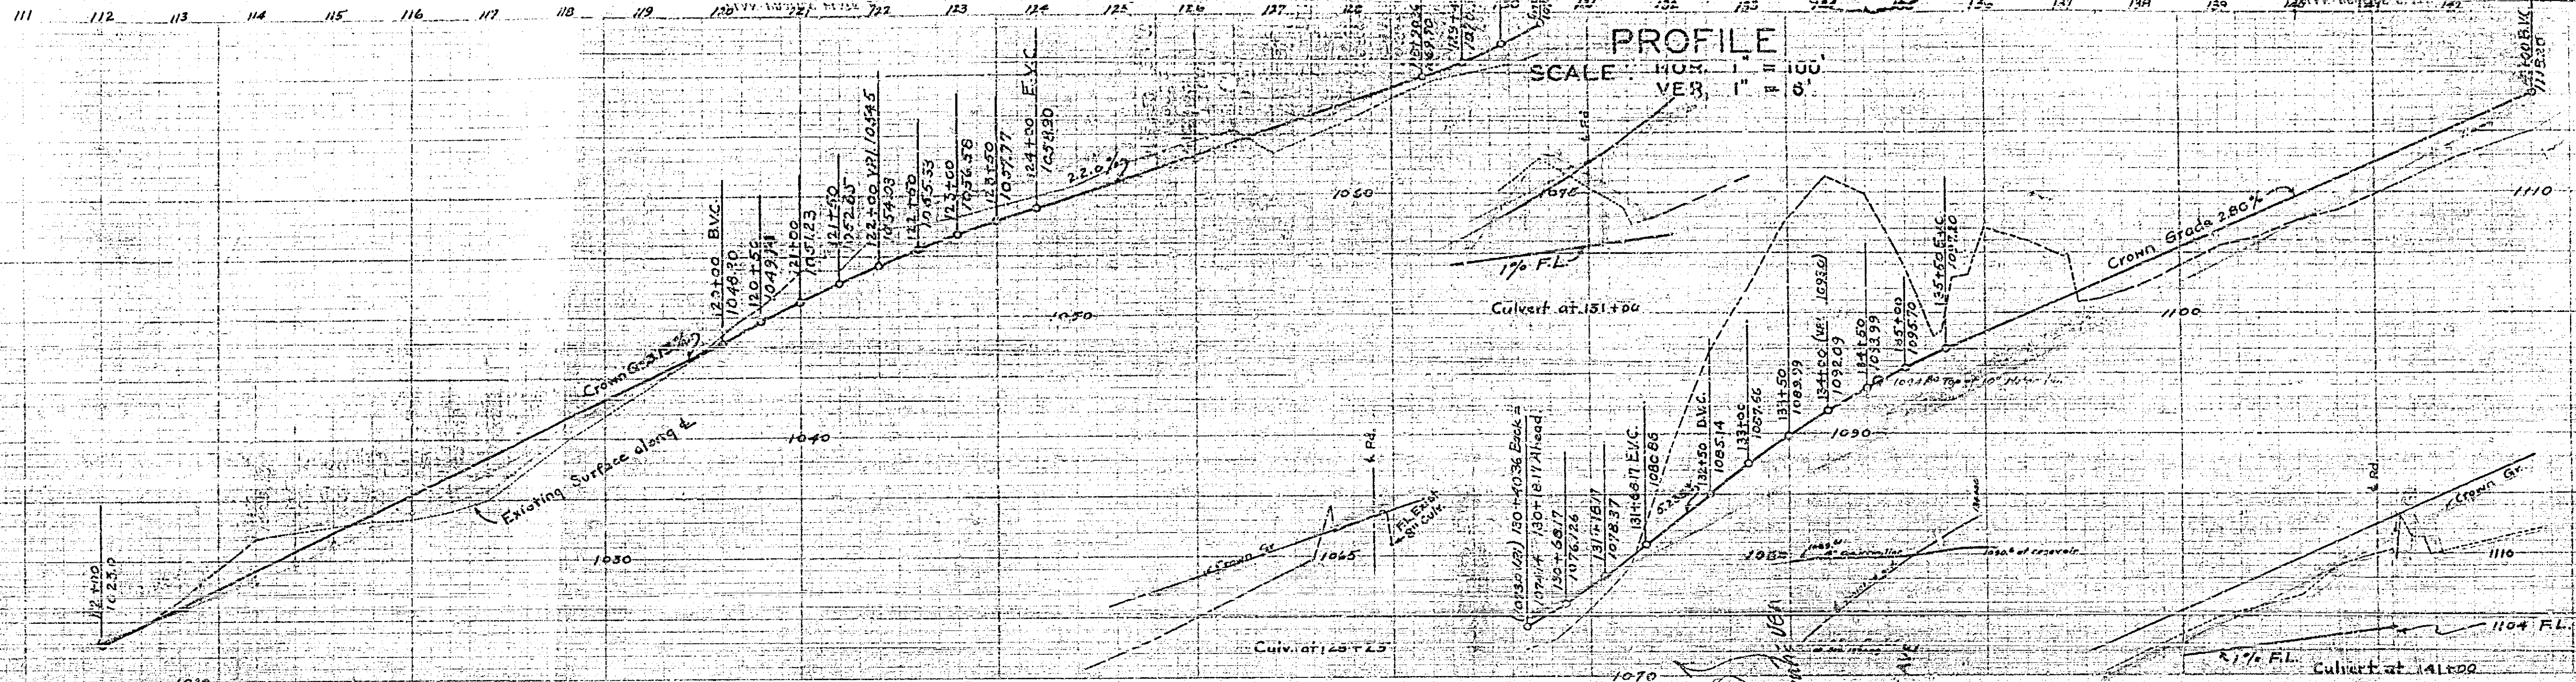

PLAN SCALE 1" = 100'

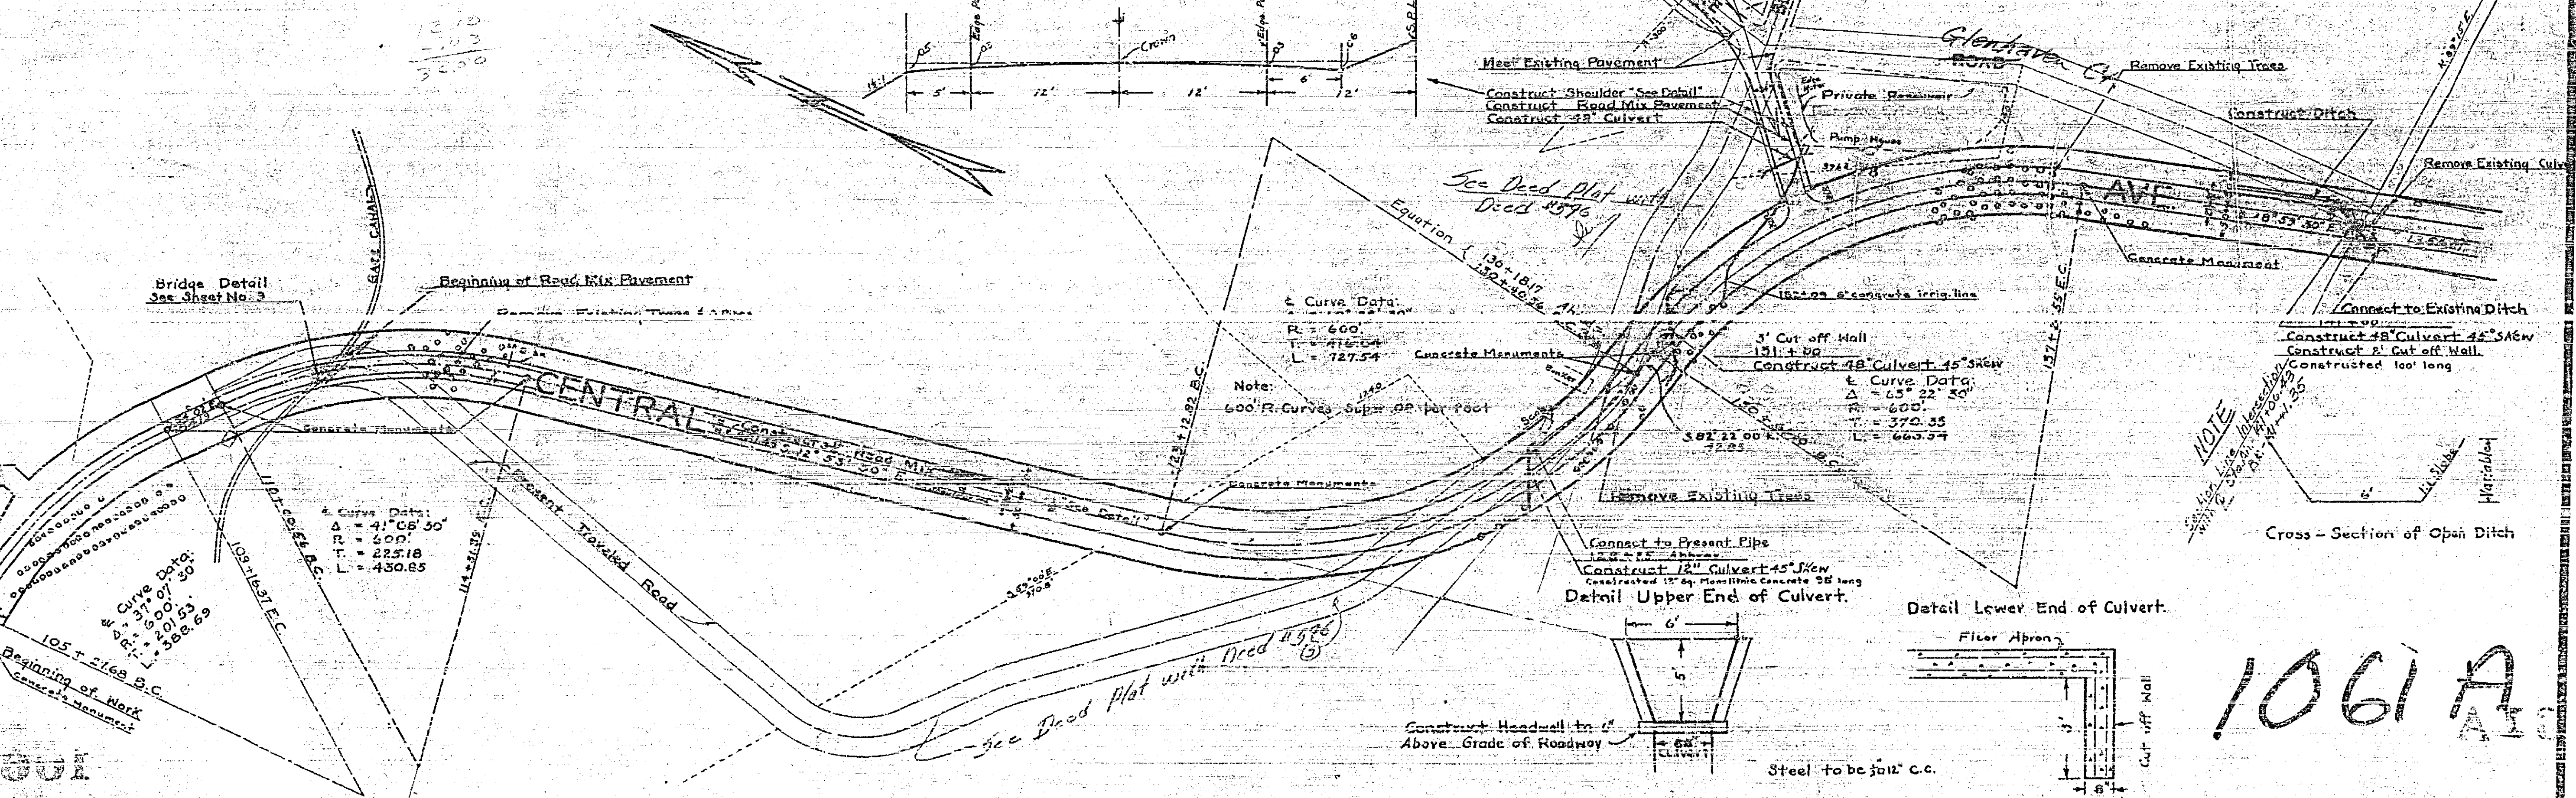

Curve Data:
 $R = 600'$
 $L = 727.54'$

Note:
 600' R. Curves Super 0.02 per foot



Detail Upper End of Culvert.

Detail Lower End of Culvert.

1061 A


1061A

Central Ave. Magnolia Ave. to E. City			
Drawing Number	Sheet	Total	1061A
1061A	11	12	1061A
Drawn	Checked	Approved	
JULY 1941	W. J. L.		

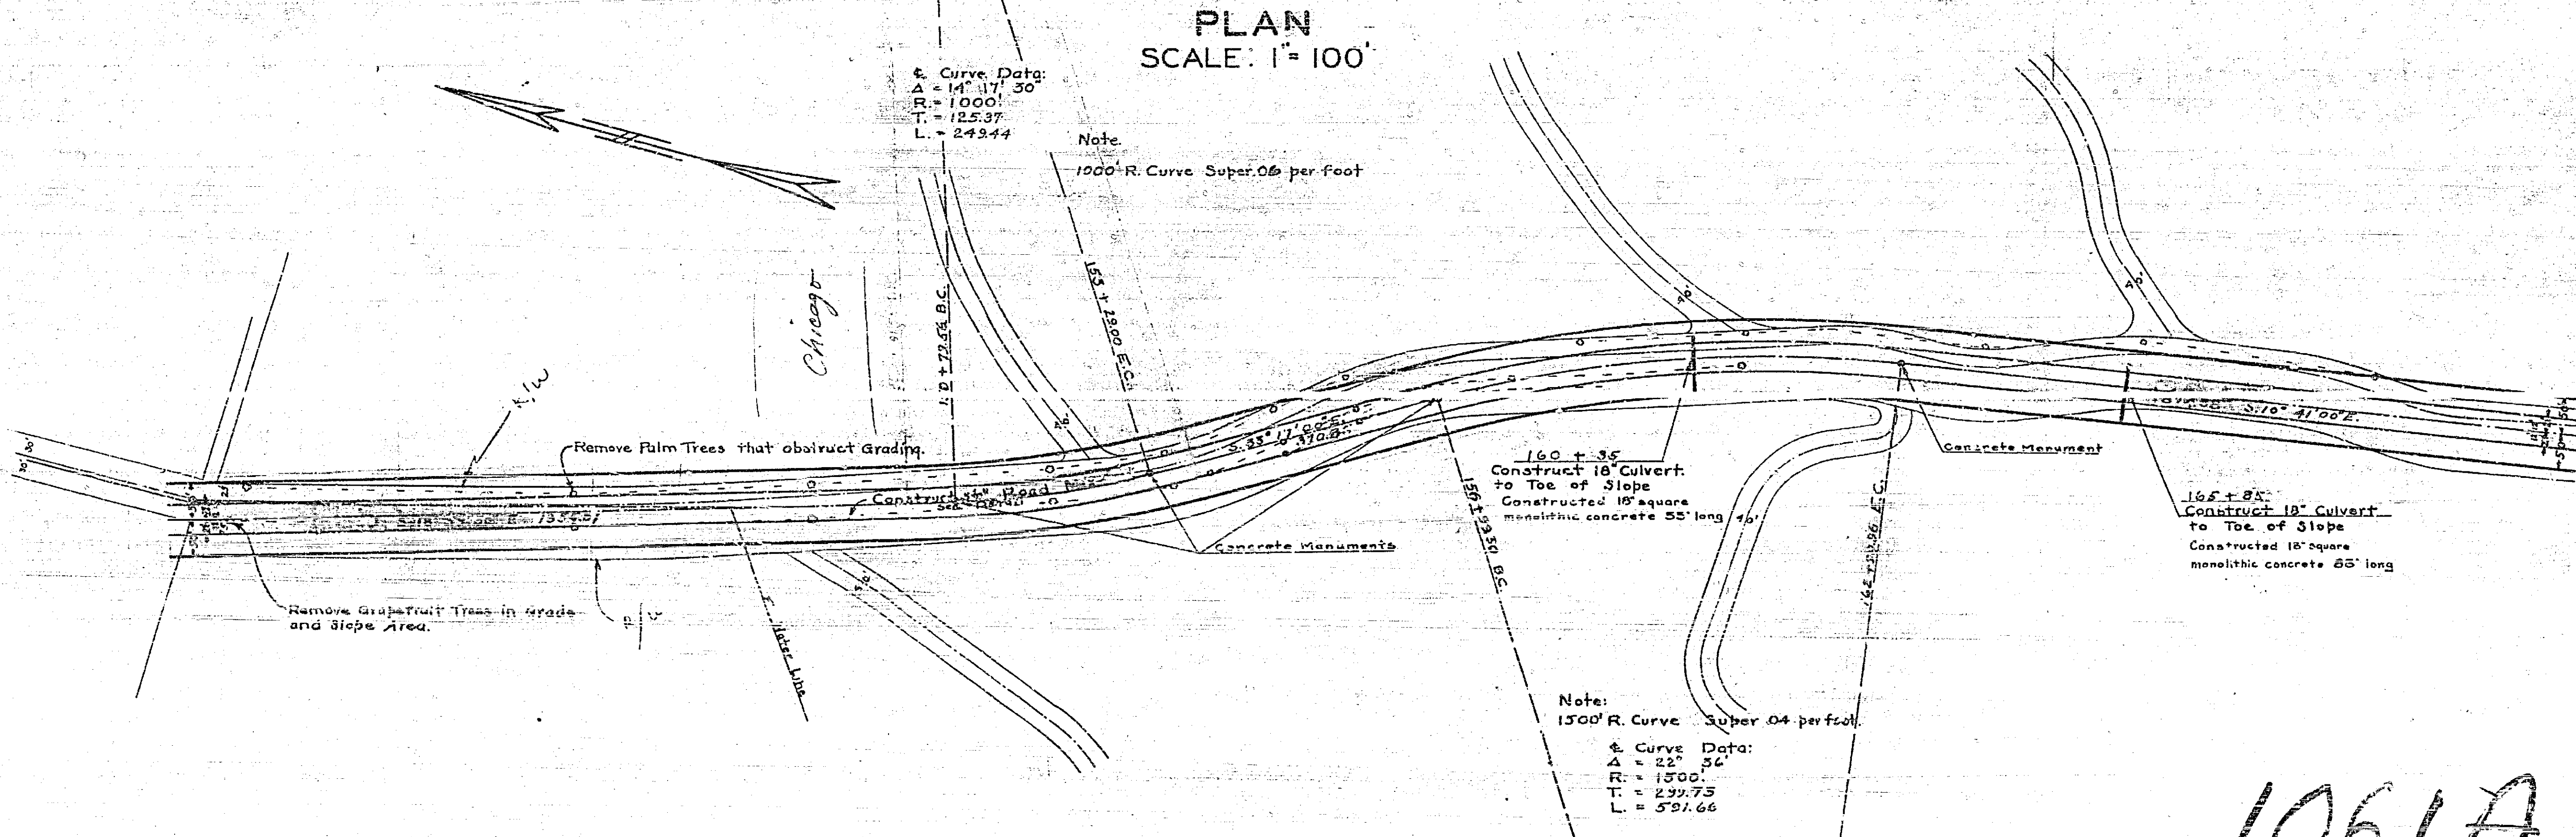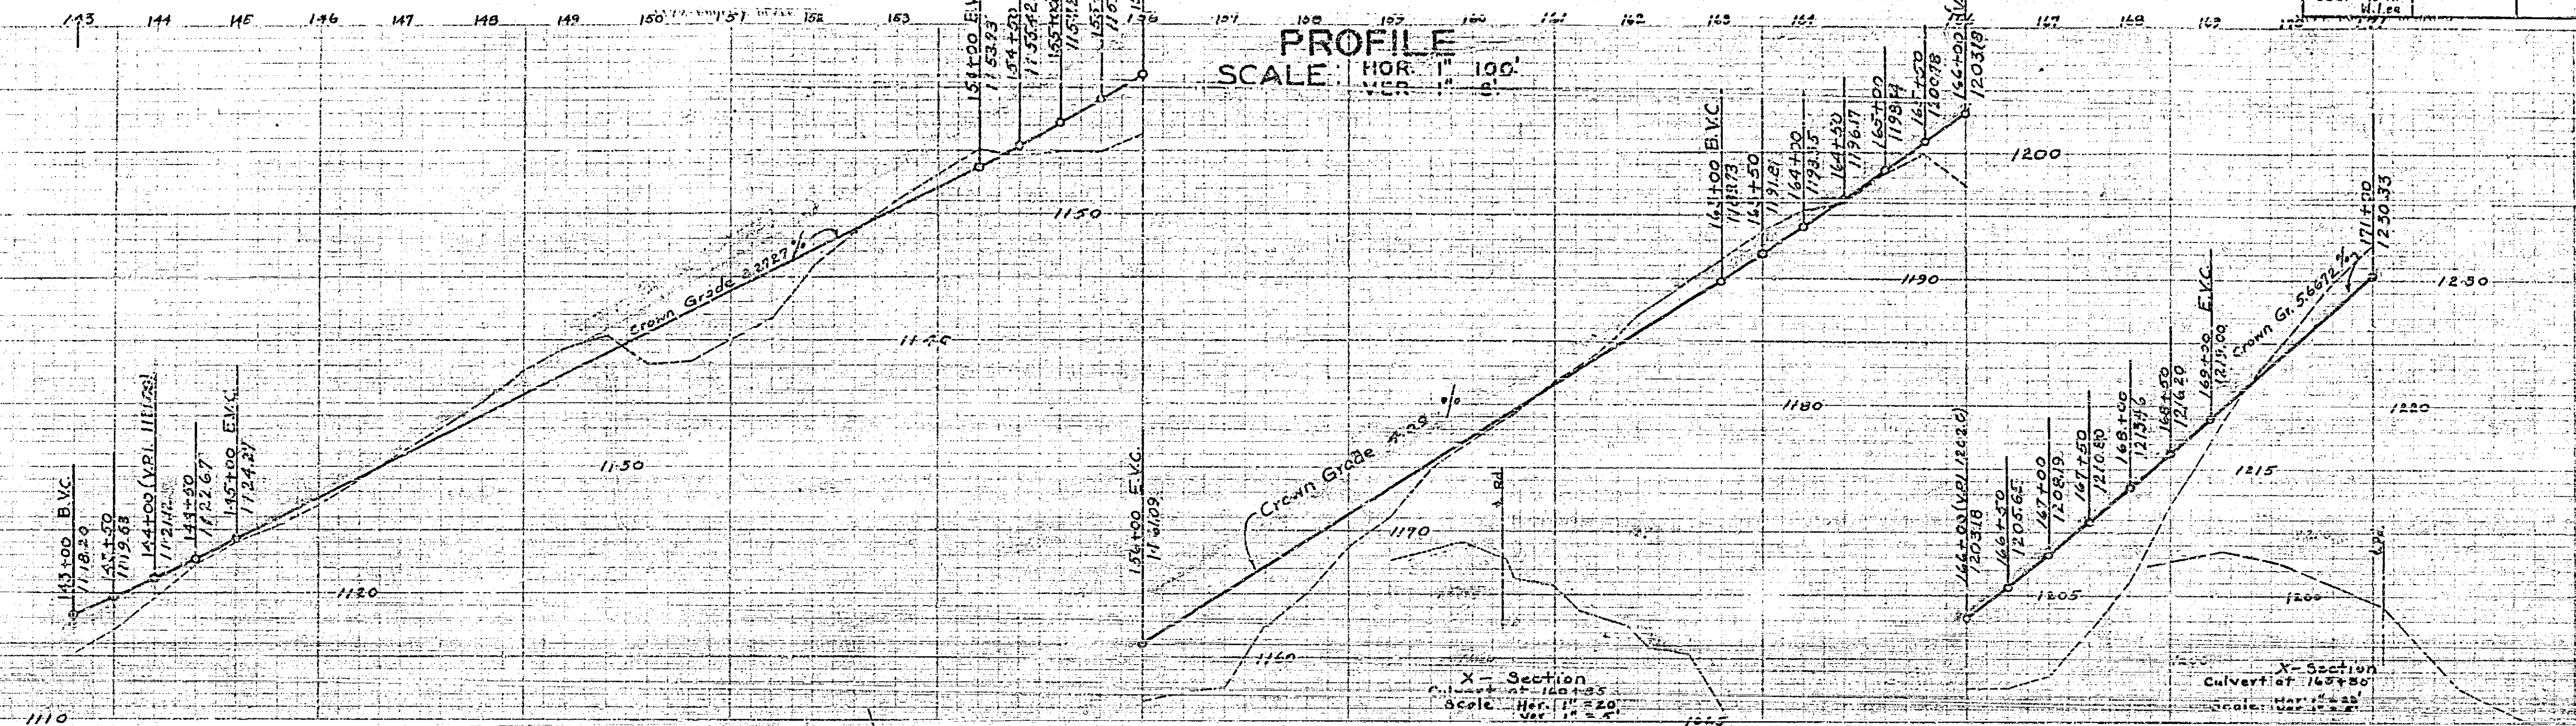

1061A

Central Ave		to Ave to E. City	
Drawing Number	Sheet Number	Total Sheets	File No.
1061A	12	12	589
Drawn	Checked	Approved	
JULY 1941			

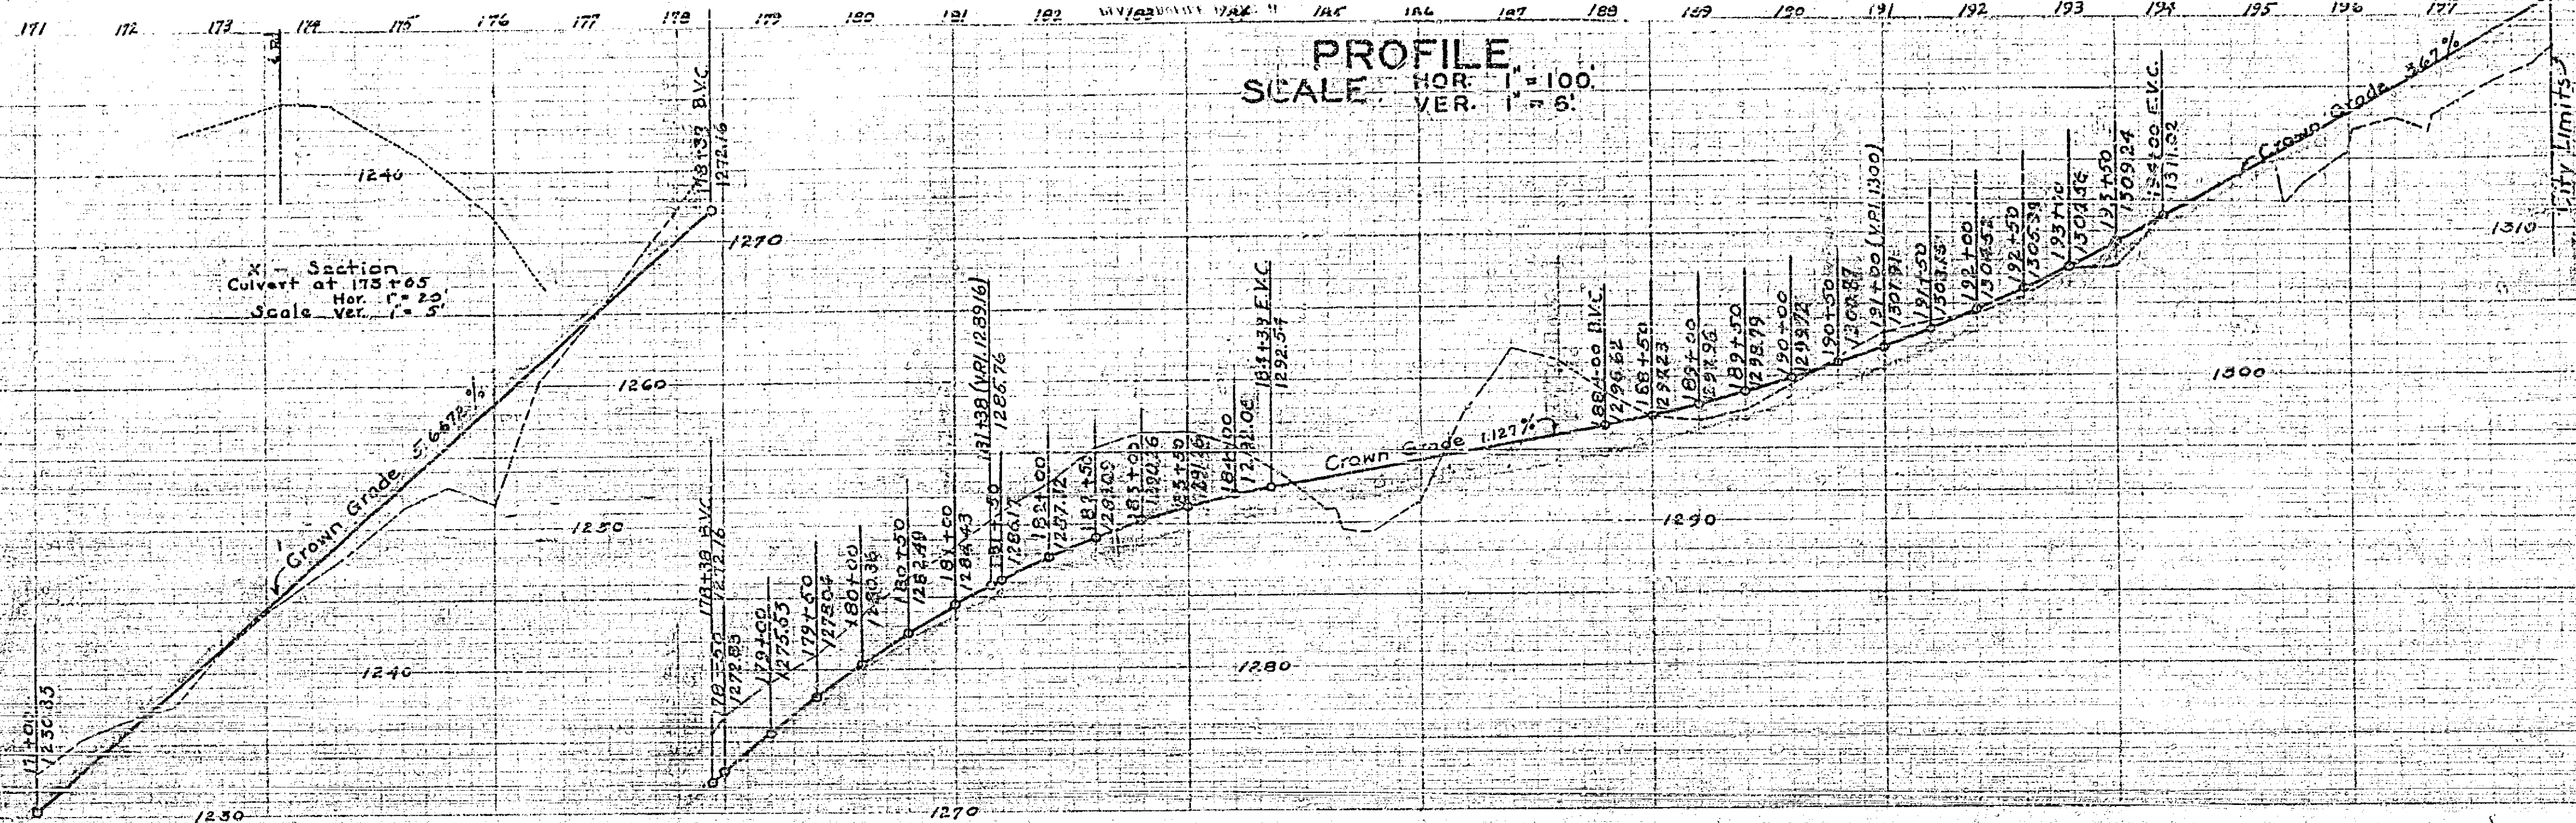


X-X Section
 Culvert at 173+65
 Scale Hor. 1" = 25'
 Ver. 1" = 5'

PROFILE
 SCALE HOR. 1" = 100'
 VER. 1" = 5'

PLAN
 SCALE 1" = 100'


Note:
 1500' R. Curve Supar. .04 per Foot.
 ± Curve Data:
 L = 218.60'

Note:
 2000' R. Curve Supar. .02 per Foot.
 ± Curve Data:
 Δ = 22° 46' 10"
 R = 2000'
 T = 707.4'
 L = 794.75'

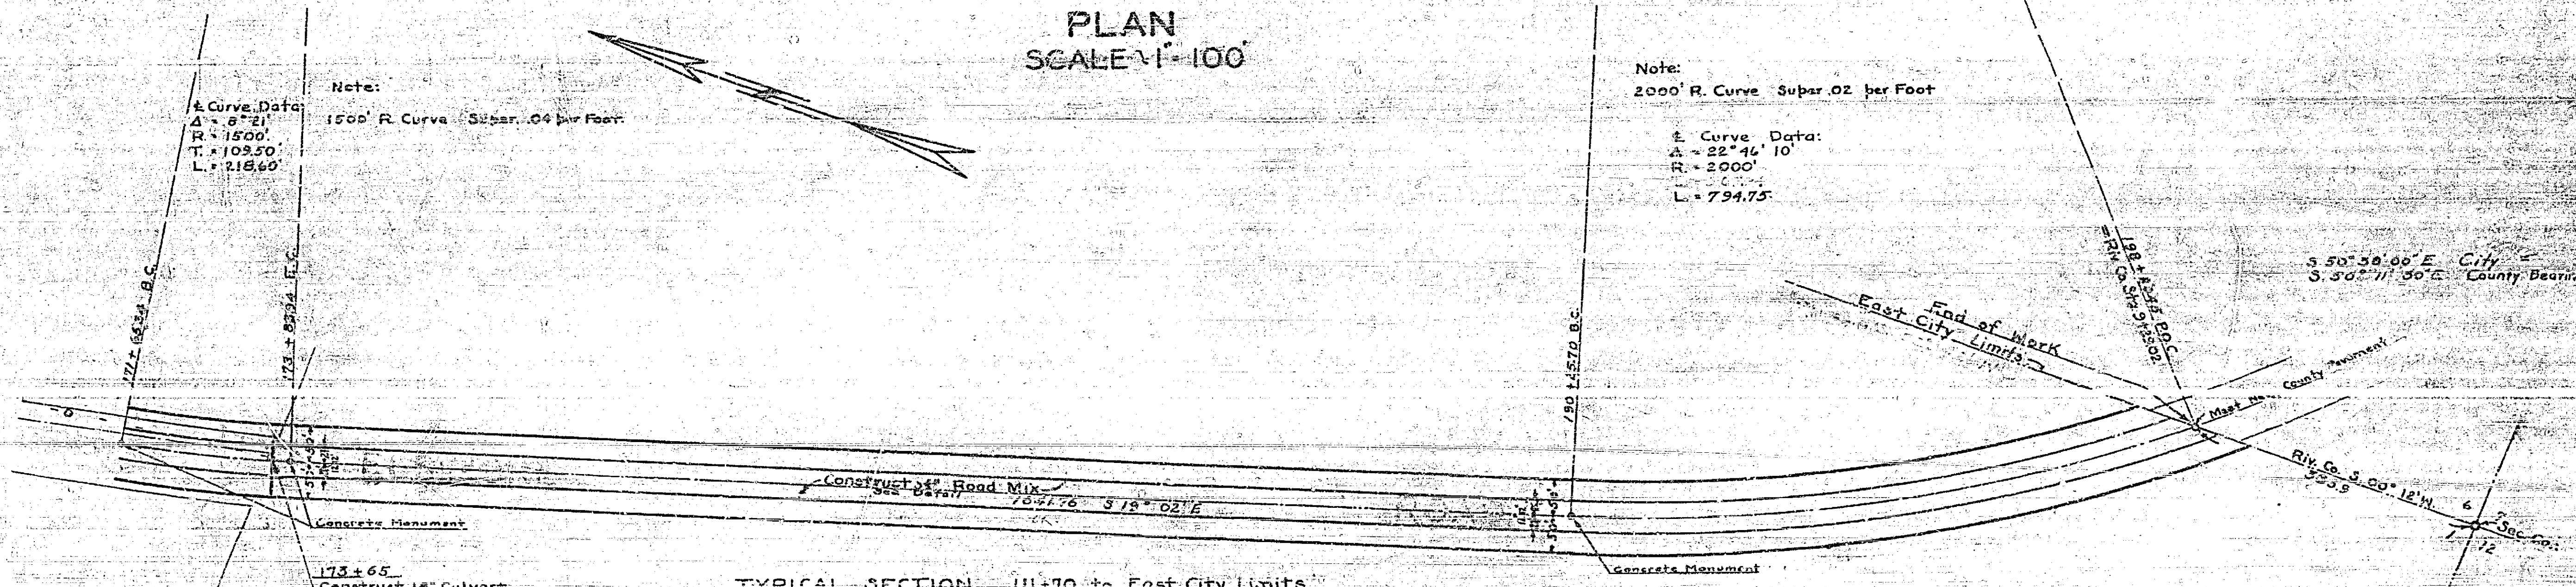

173+65
 Construct 16" Culvert
 to top of Slope
 Construct 10' square
 monolithic concrete 40" long

TYPICAL SECTION 173+70 to East City Limits

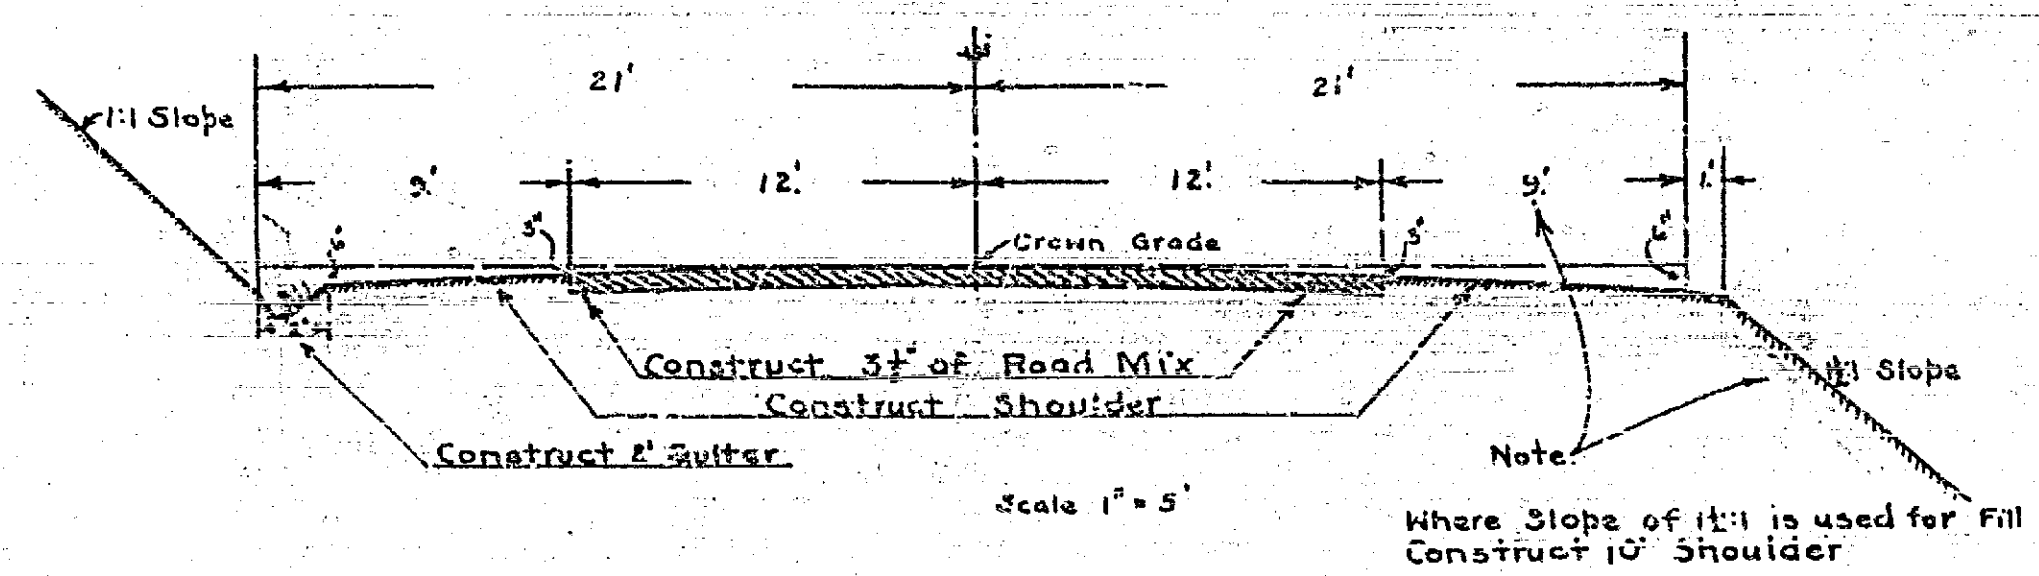

1061A