


5

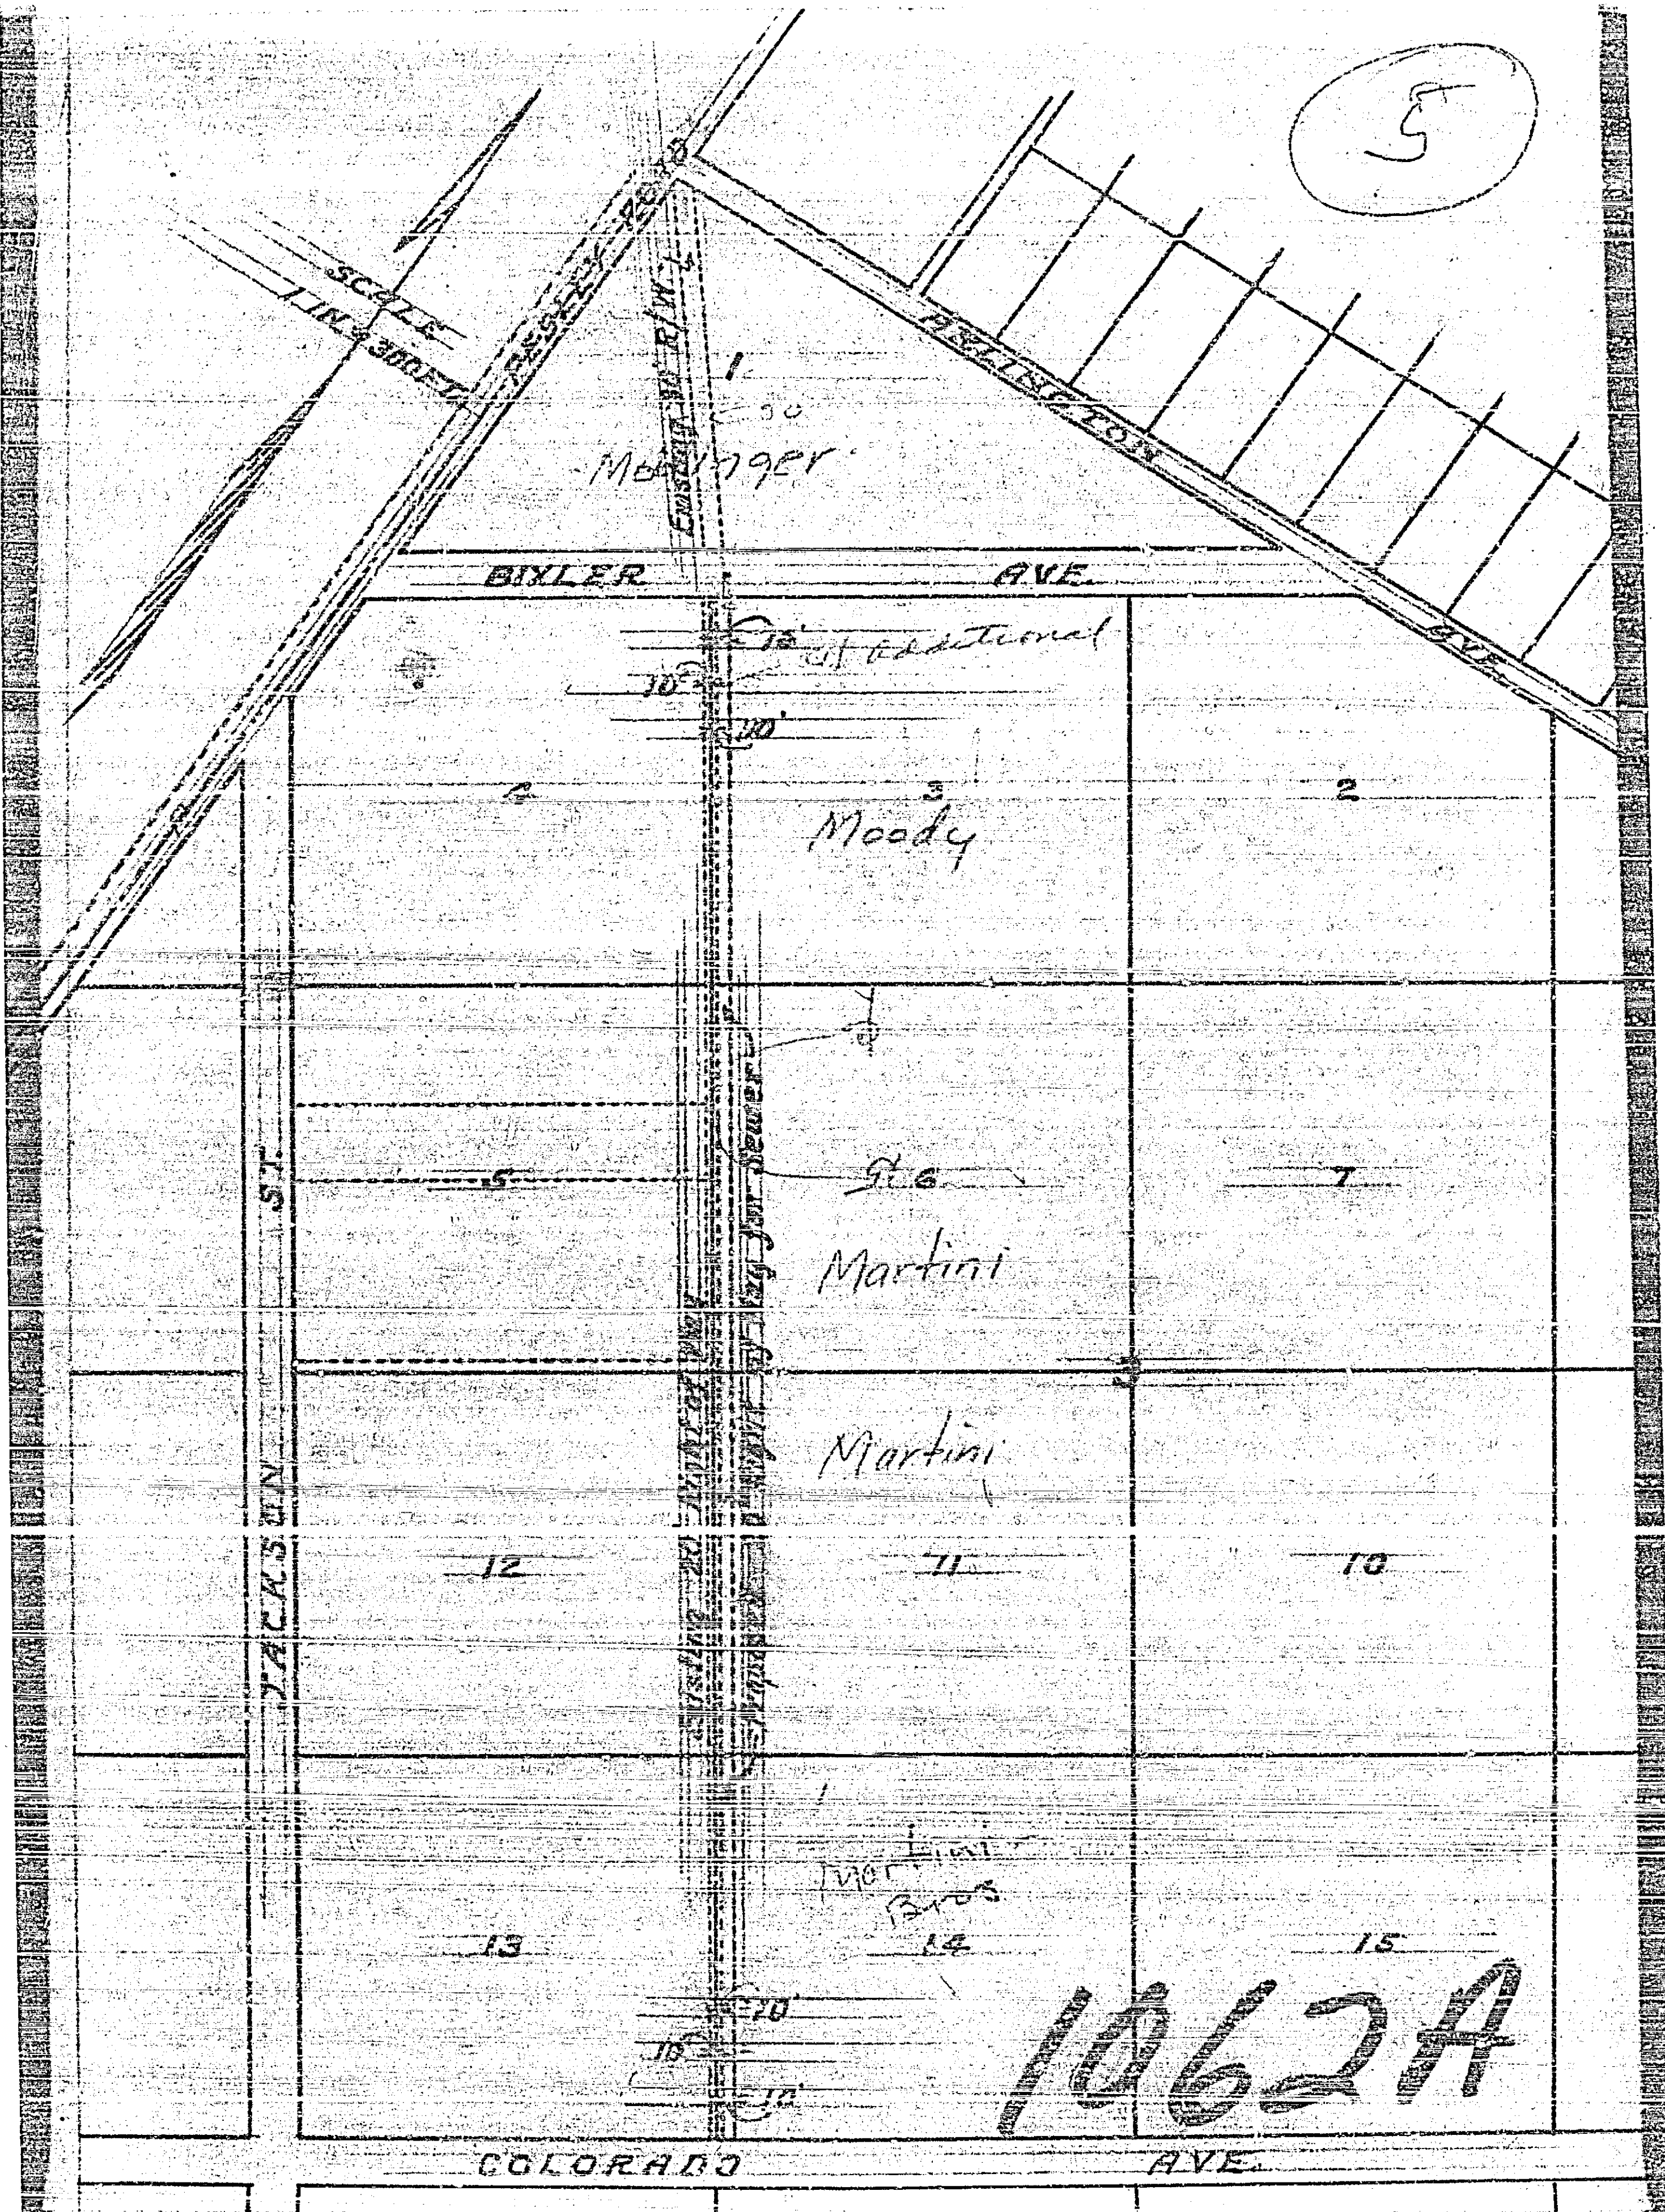

Moody

Moody

Martini

Martini

1062A

BIXLER AVE

COLORADO AVE

JACKSON ST


CROSSING BY R/W

SCALE

1st additional

1

2

3

4

5

6

7

8

9

10

11

12

13

14

15