



10150
E/10 M. IV

10150
E/10 M. IV

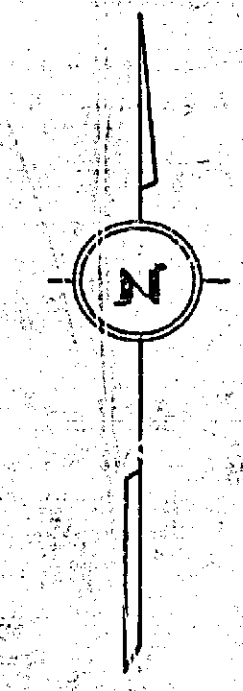

SCALE = 1" = 50'

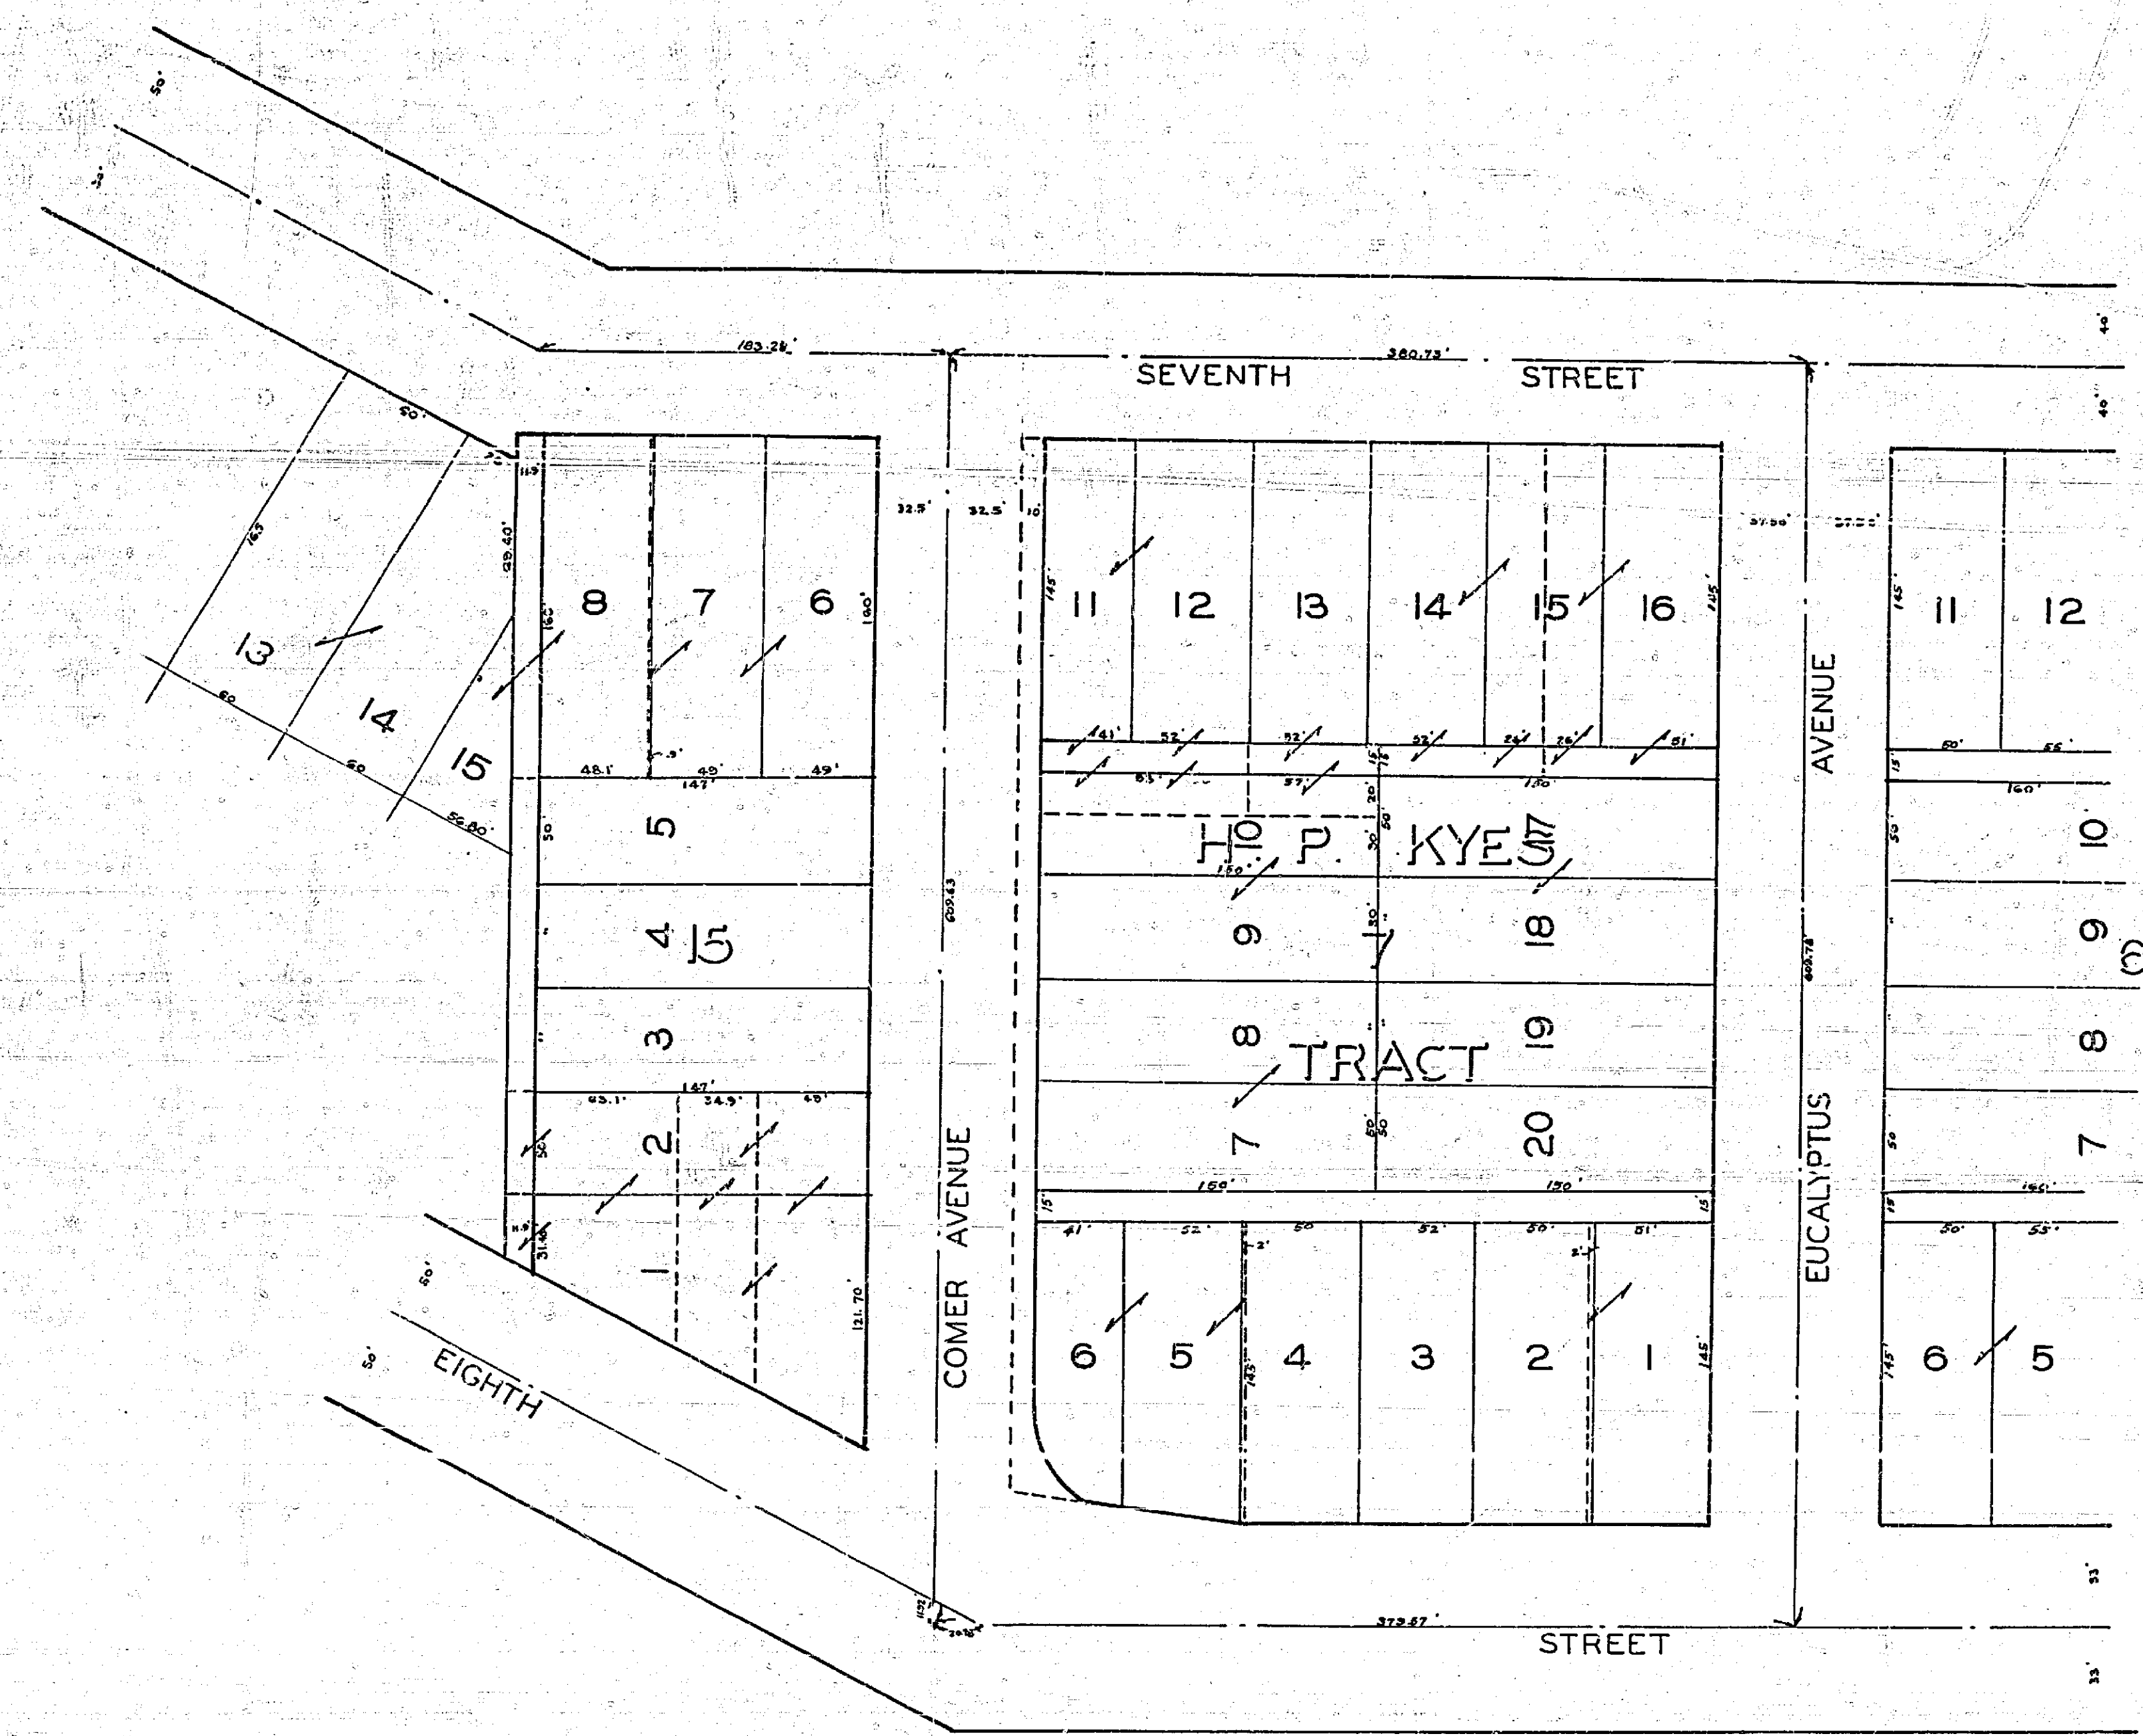

10150
E/10 M. IV

1079