
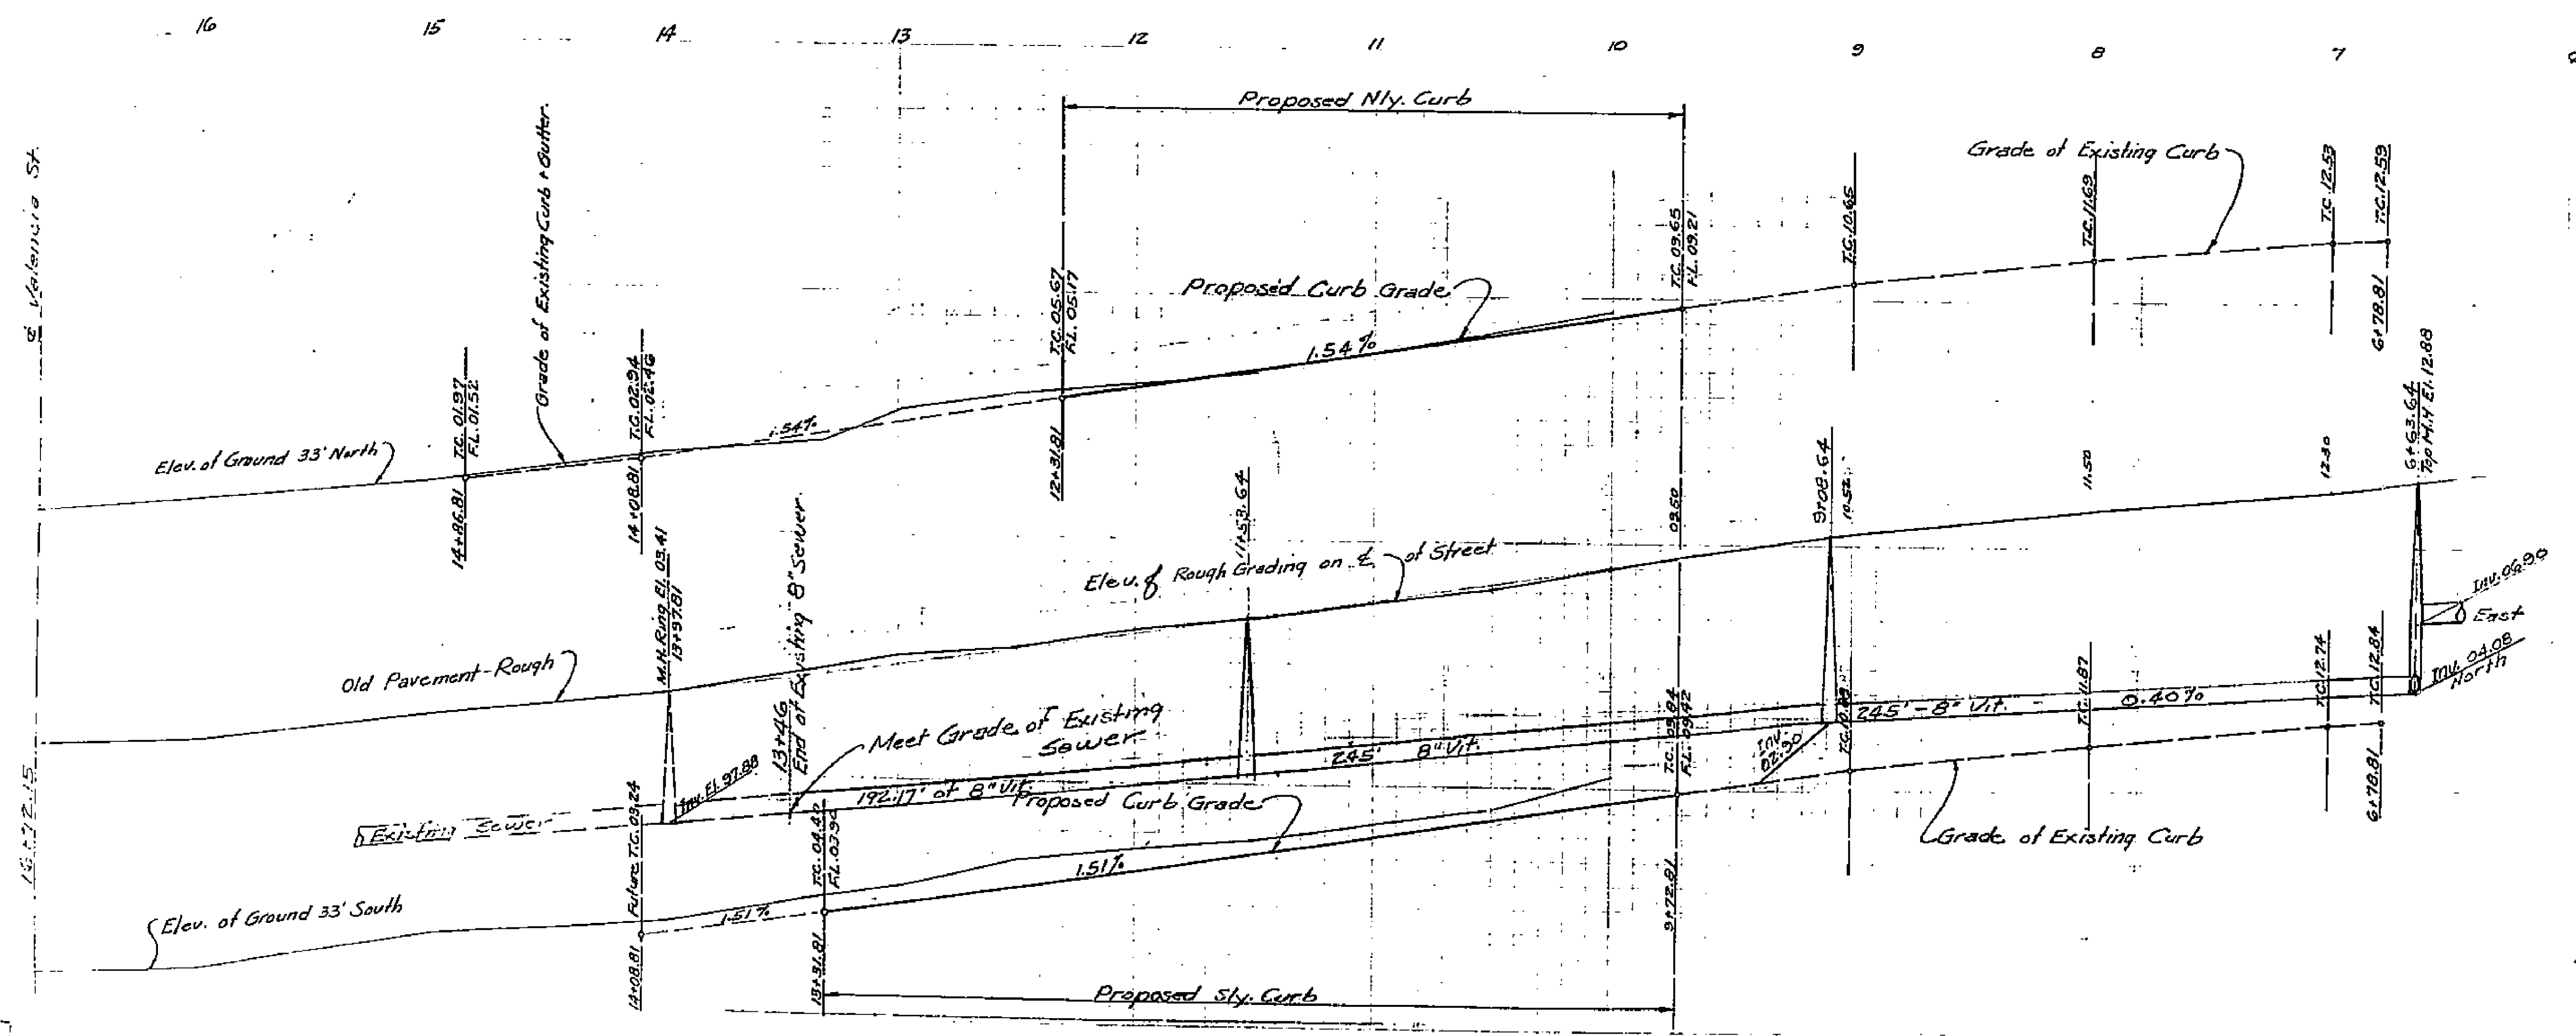


PROPERTY OF
CITY OF RIVERSIDE
CITY ENGINEERING DEPT.

PROPERTY OF
CITY OF RIVERSIDE
CITY ENGINEERING DEPT.

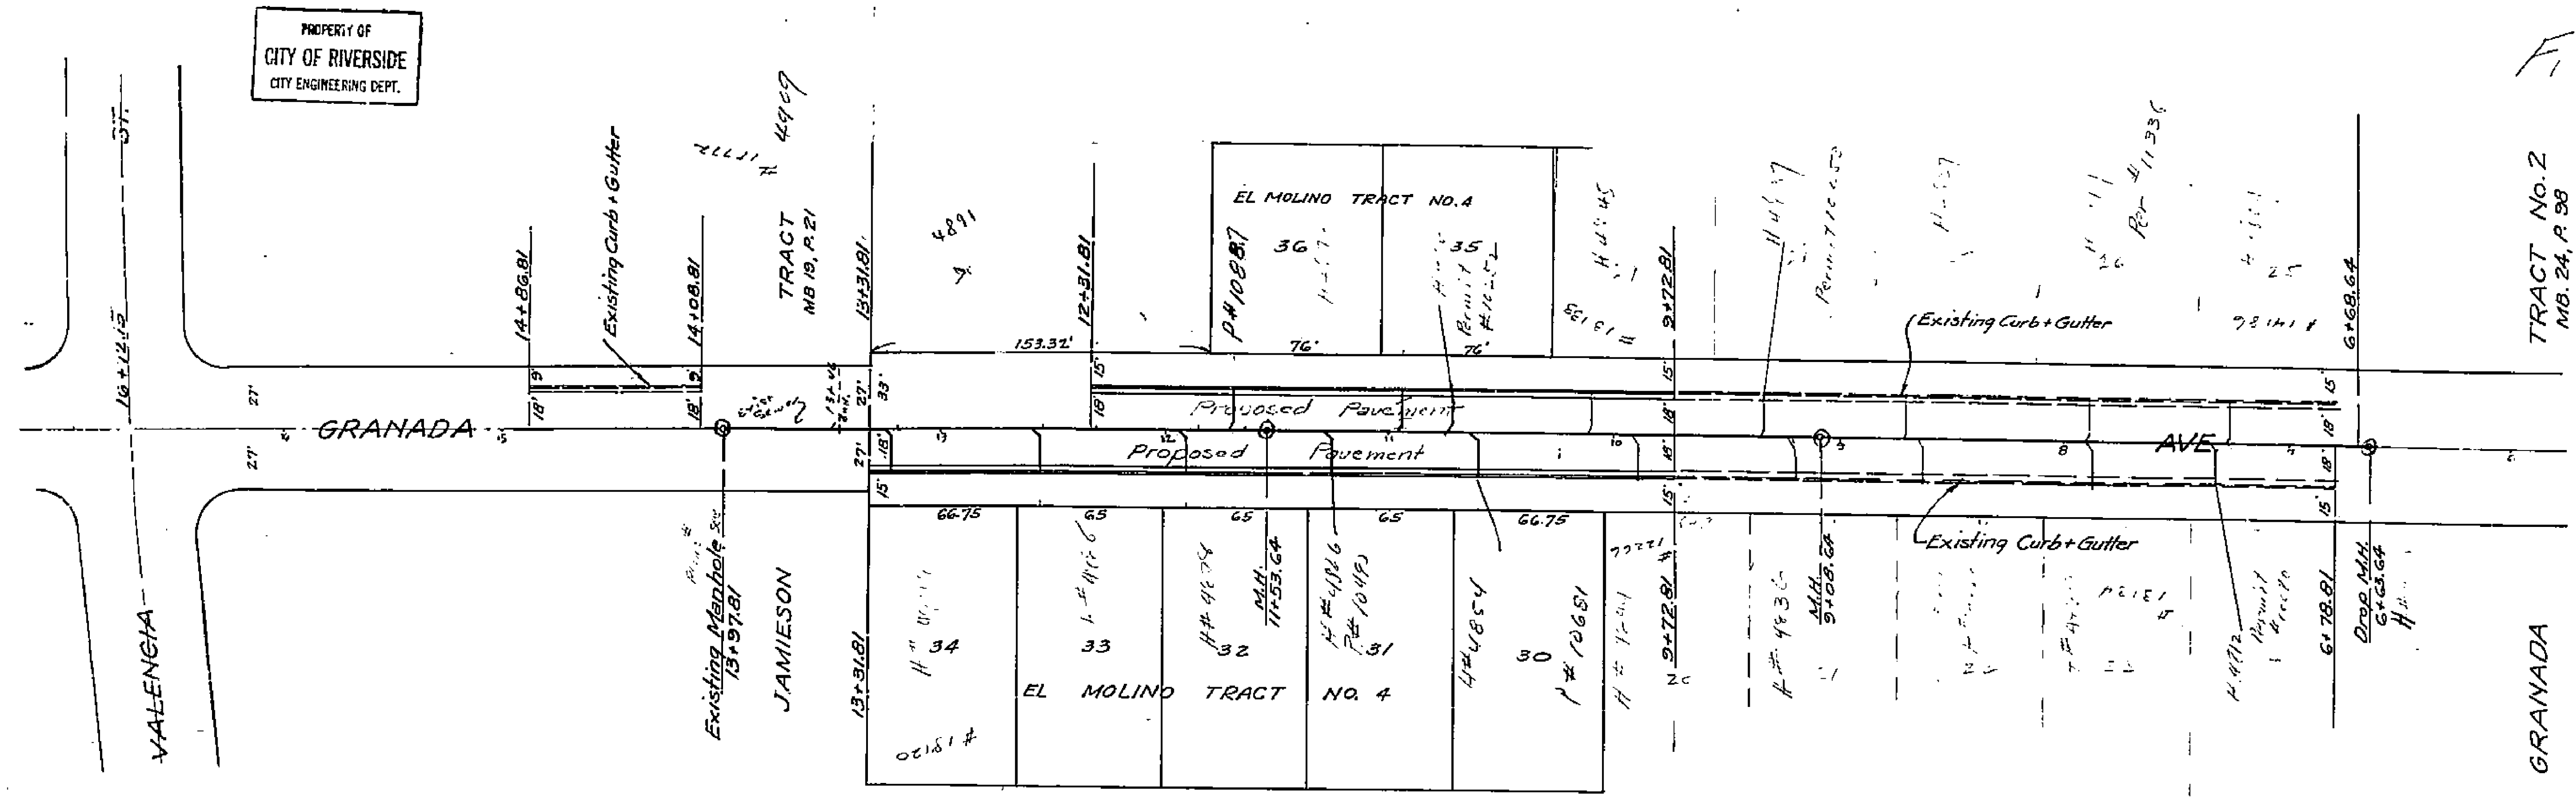

Plan and Profile
GRANADA AVENUE
Horz. Scale: 1"=40' Vert. Scale: 1"=4'
April, 1952
J. F. Davidson, C.E.
Approved *J. F. Davidson*
City Engineer.

1085A