

SHEET 1 OF 2 SHEETS



Search Marks  
Nail in road, S.W. Curb  
Return; Volcania St and  
Sierra St. Elev. 795.55

Approved M. H. Durin  
City Engineer

PLAN & PROFILE  
SIERRA STREET -  
EUGENE TERRACE  
December 1954 J.F. DAVIDSON, C.E.  
Scale: Hor. 1" = 40'  
Vert. 1" = 4'

10937  
PROPERTY OF  
CITY OF RIVERSIDE  
CITY ENGINEERING DEPT.  
FB 500-46

6 5 4 3 2 1 0 -1 -2 -3

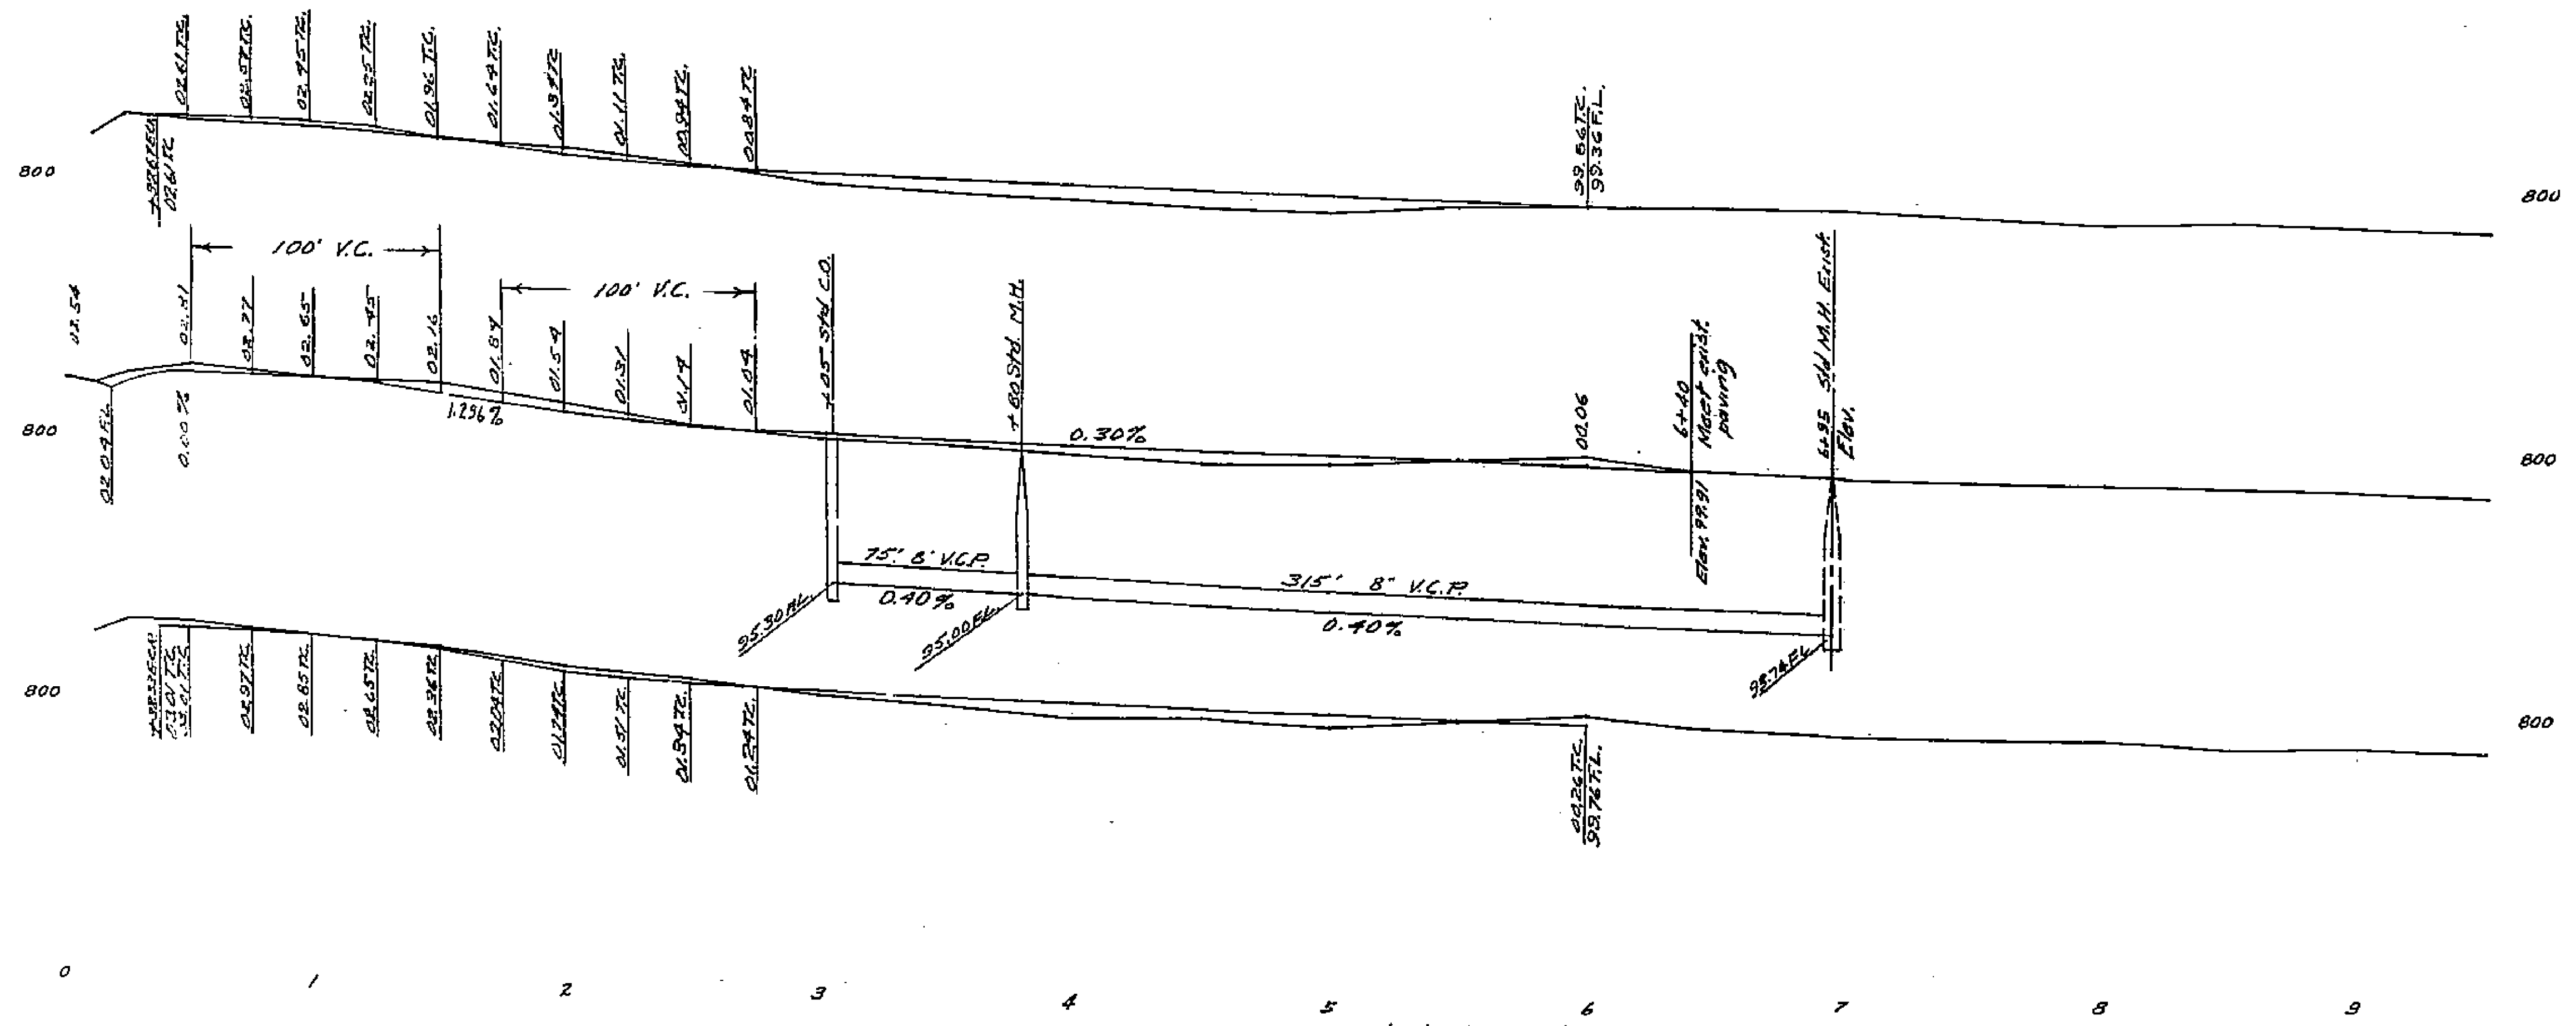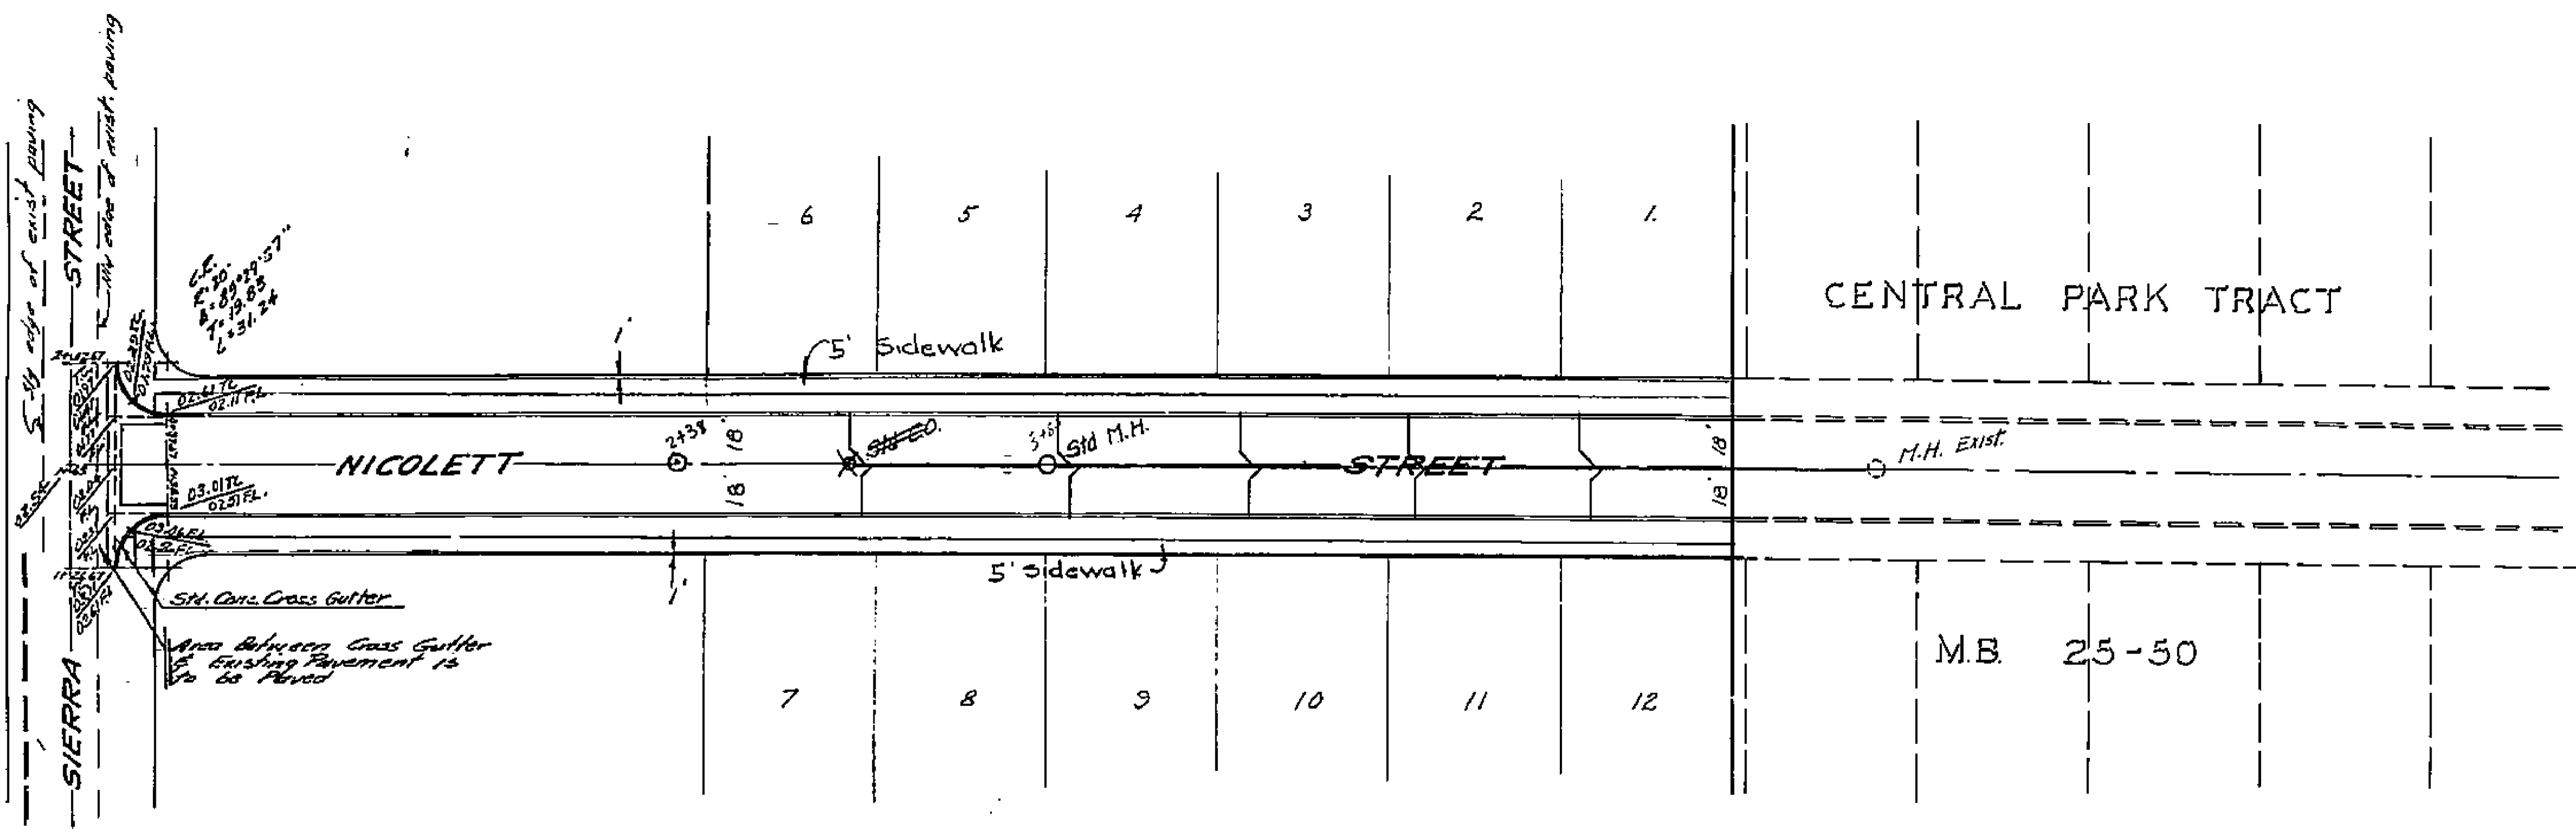

SHEET 2 OF 2 SHEETS

Brush Marks  
Nail in lead; S.M. curb  
Return; Valencia St and Elev. 795.5  
Sierra St.

Approved *M.H. Davis*  
City Engineer

PLAN & PROFILE  
NICOLETT STREET  
EUGENE TERRACE  
December 1954 J.F. DAVIDSON, C.E.  
Scale: Hor 1" = 40'  
Vert 1" = 4'

1093