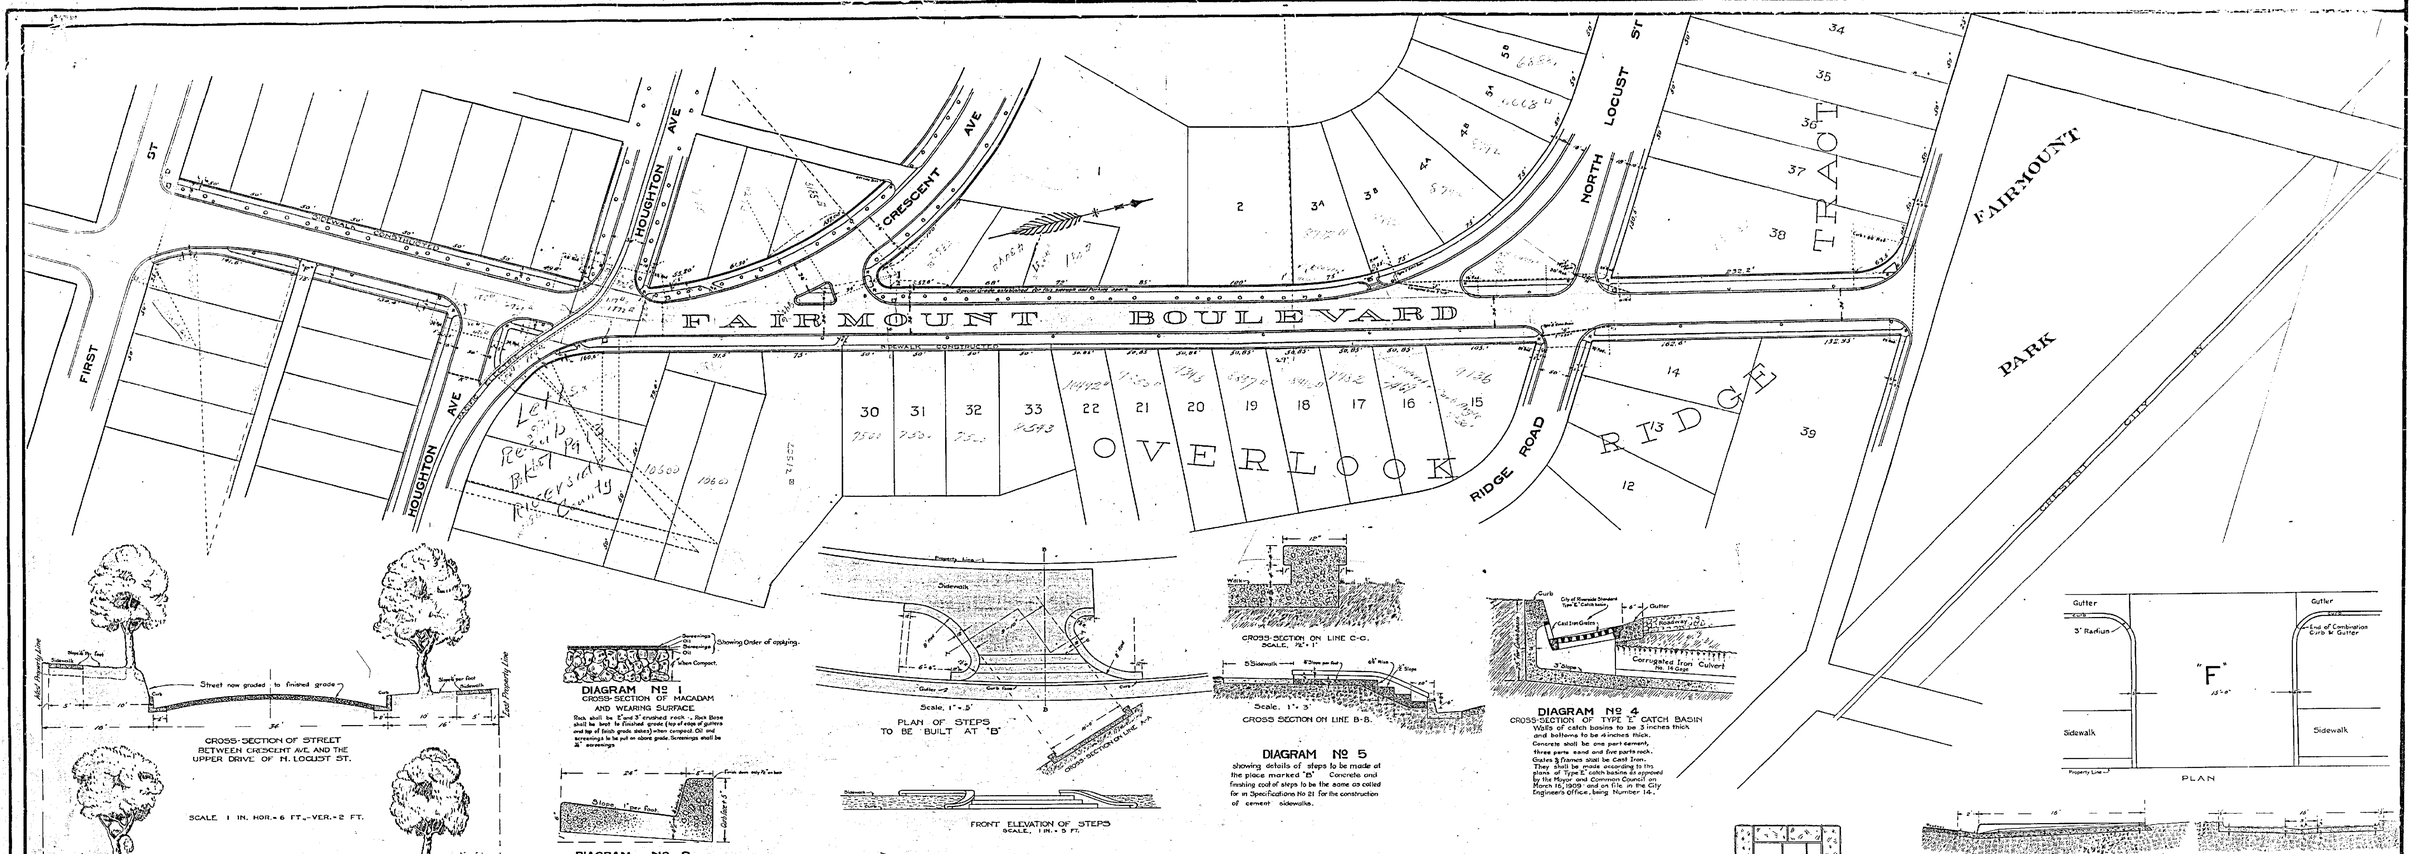

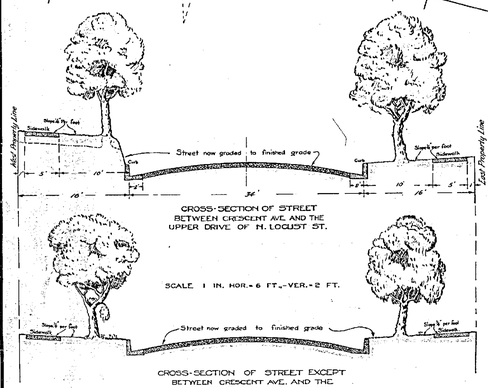

CROSS-SECTION OF STREET
BETWEEN CRESCENT AVE. AND THE
UPPER DRIVE OF N. LOCUST ST.

SCALE 1 IN. HOR.= 6 FT.- VER.= 2 FT.

CROSS-SECTION OF STREET EXCEPT
BETWEEN CRESCENT AVE. AND THE
UPPER DRIVE OF N. LOCUST ST.

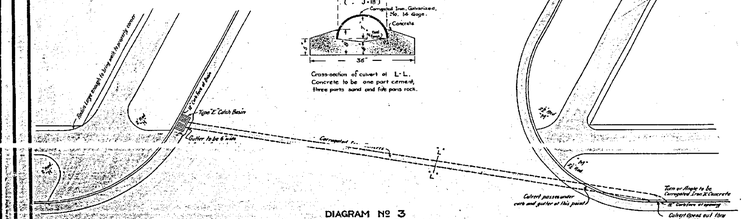

DIAGRAM Nº 3
Showing Layout of culverts G, H, & J, catch basins, and sidewalks for intersections.

DIAGRAM Nº 1
CROSS-SECTION OF MACADAM
AND WEARING SURFACE.

Rock shall be 8" and 3" crushed rock - Rock Base shall be best to finished grade (top of edge of gutters and top of finish grade stakes) when compact. Oil and screenings to be put on above grade. Screenings shall be ½" screenings

DIAGRAM Nº 2
CROSS-SECTION OF COMBINATION
CURB AND GUTTER.
Proportion of materials in the concrete shall be 1 bag of cement, 2½ cu. feet of sand and 5½ cu. feet of rock.

DIAGRAM Nº 5
showing details of steps to be made at the place marked "B" Concrete and finishing coat of steps to be like same as called for in Specifications No 21 for the construction of cement sidewalks.

DIAGRAM Nº 4
Walls of catch basins to be 8 inches thick and bottoms to be 4 inches thick.
Concrete shall be one part cement, three parts sand and five parts rock.
Grates & Frames shall be Cast Iron.
They shall be made according to the plans of Type L catch basins as approved by the Mayor and Common Council on March 16, 1909 and on file in the City Engineer's Office, being Number 14.

DIAGRAM Nº 8
Showing construction of alley opposite termination where shown on the map lettered "F" (Portion between outer edge of gutter line & property line) To be constructed according to Gutter Specifications No 23, excepting paragraphs no. 2 and 3.


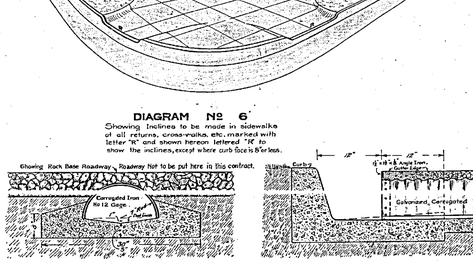

DIAGRAM Nº 6
Showing Inclines to be made in sidewalks at all returns, cross-walks, etc., marked with letter "K" and shown hereon lettered "K" to show the inclines, except where curb face is 8" or less.

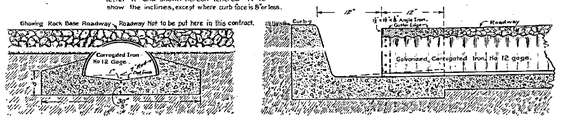

DIAGRAM Nº 7
Showing details of Galvanized Corrugated Iron Culvert to be constructed at the place where culvert is shown on the map lettered "K"

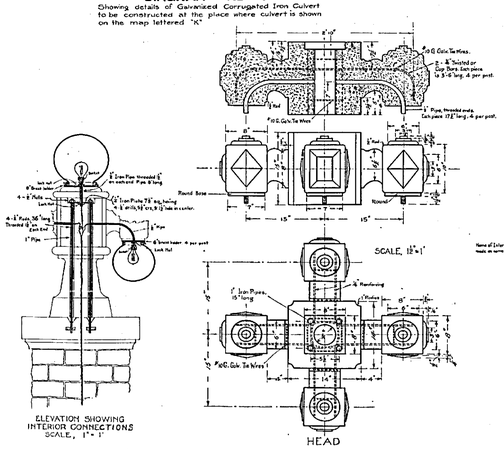

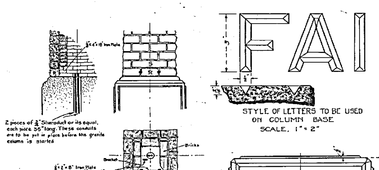
