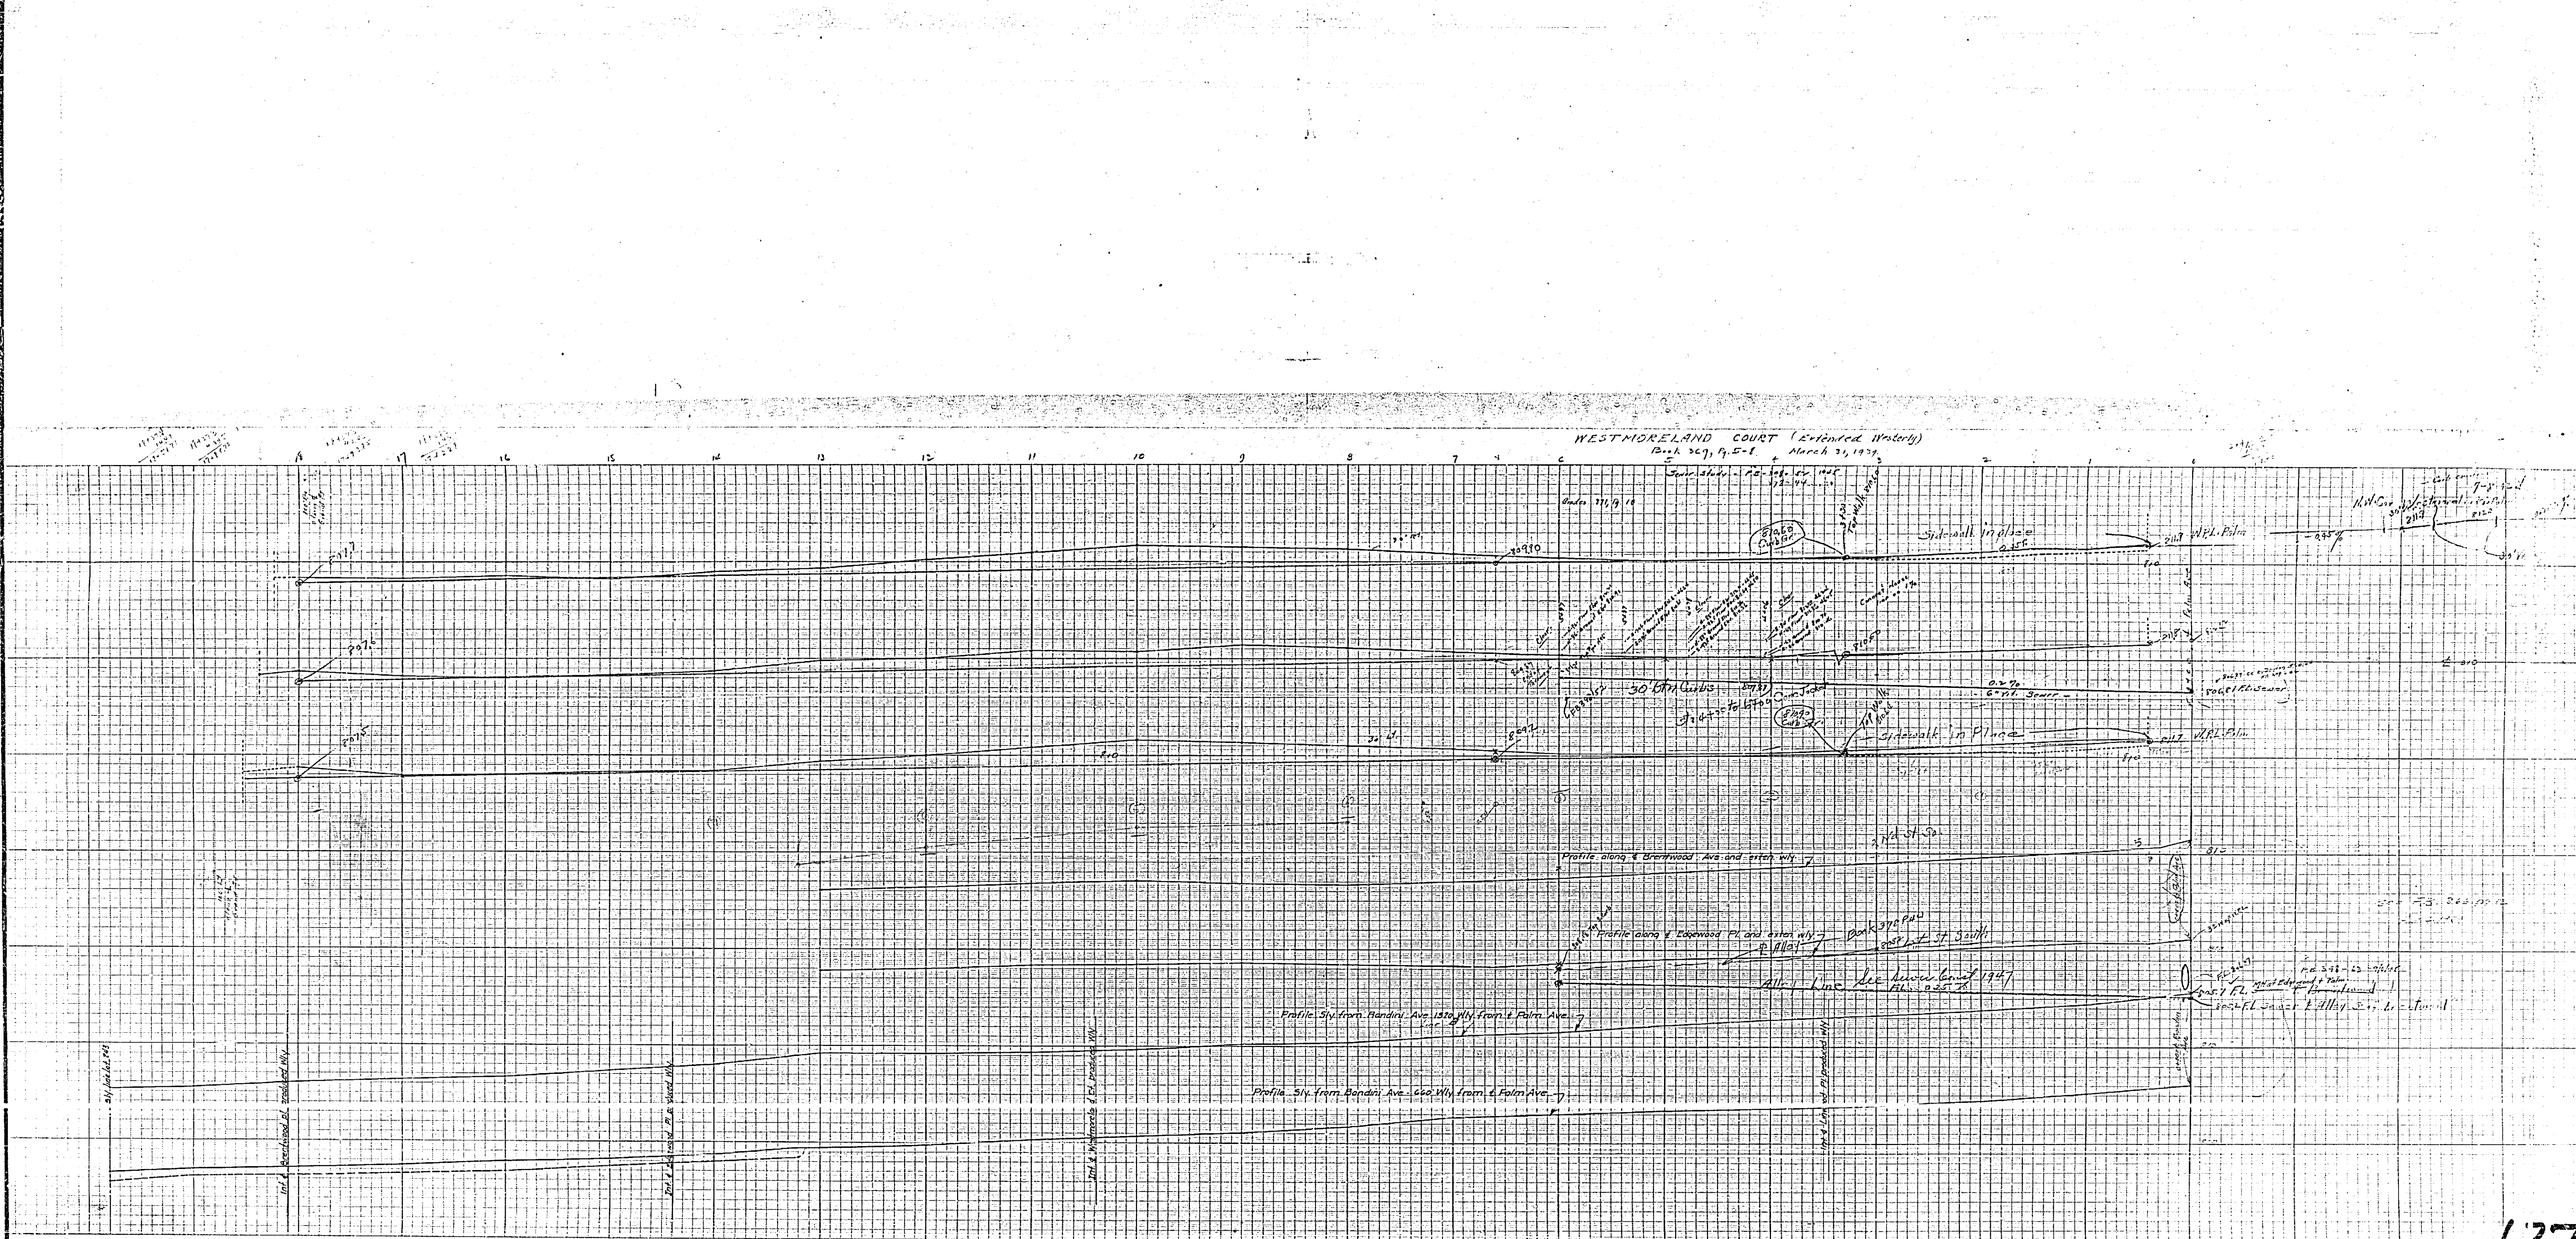WESTMORELAND COURT (Extended Westerly)
Book 309, p. 5-8 March 31, 1939