
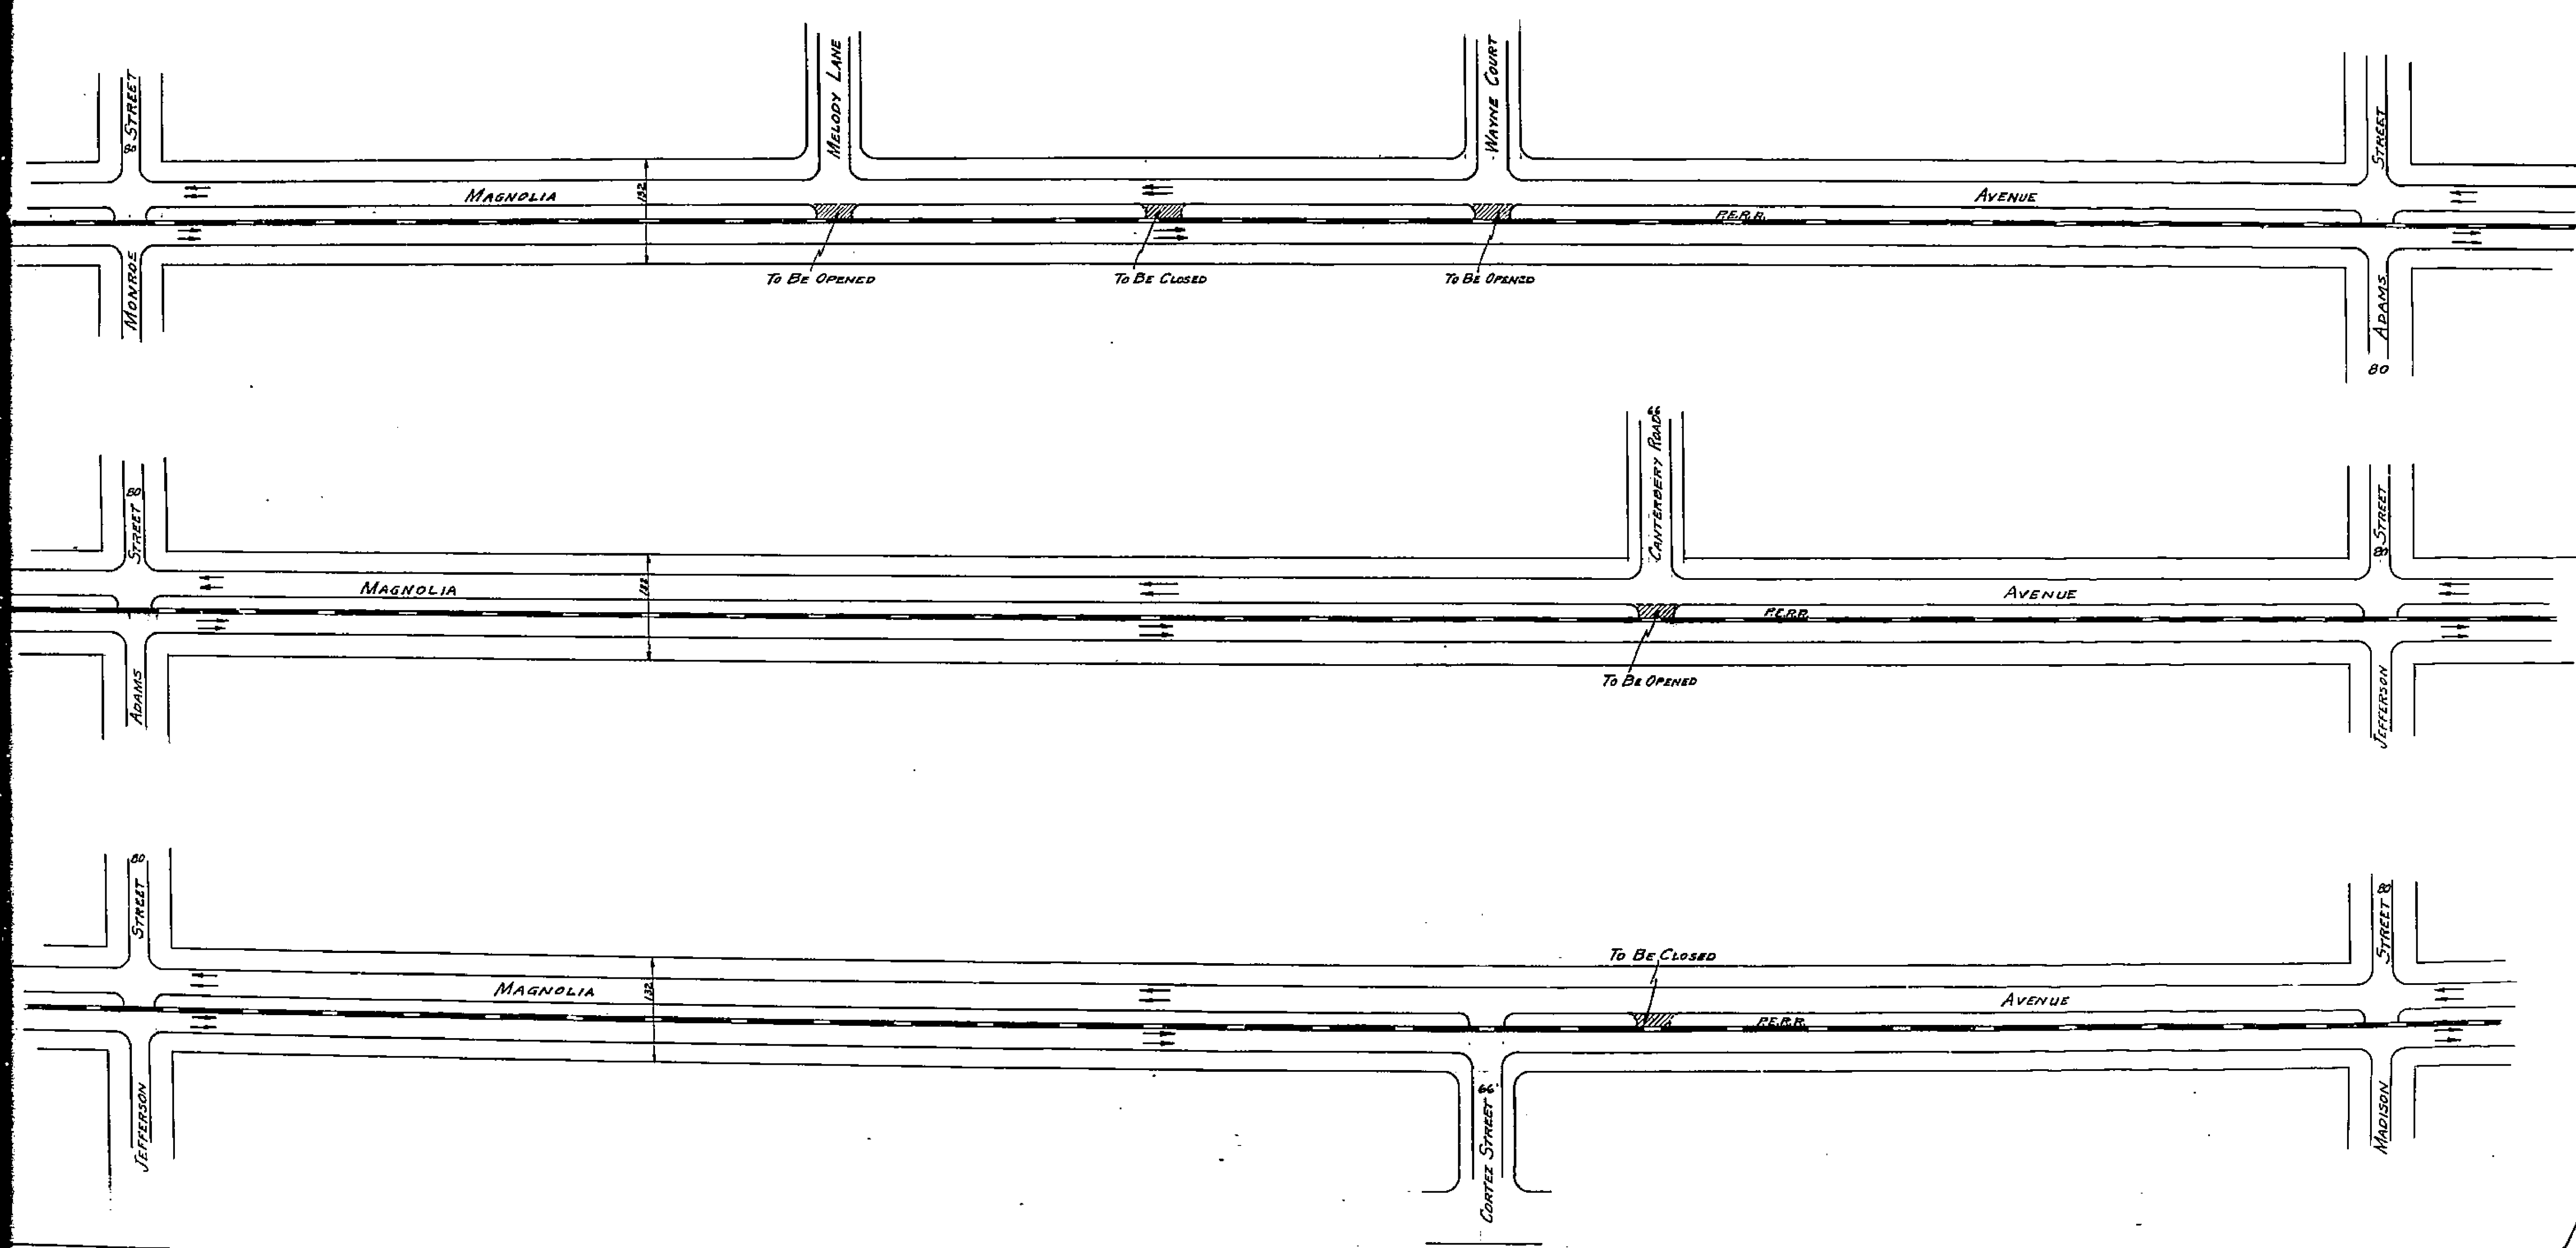
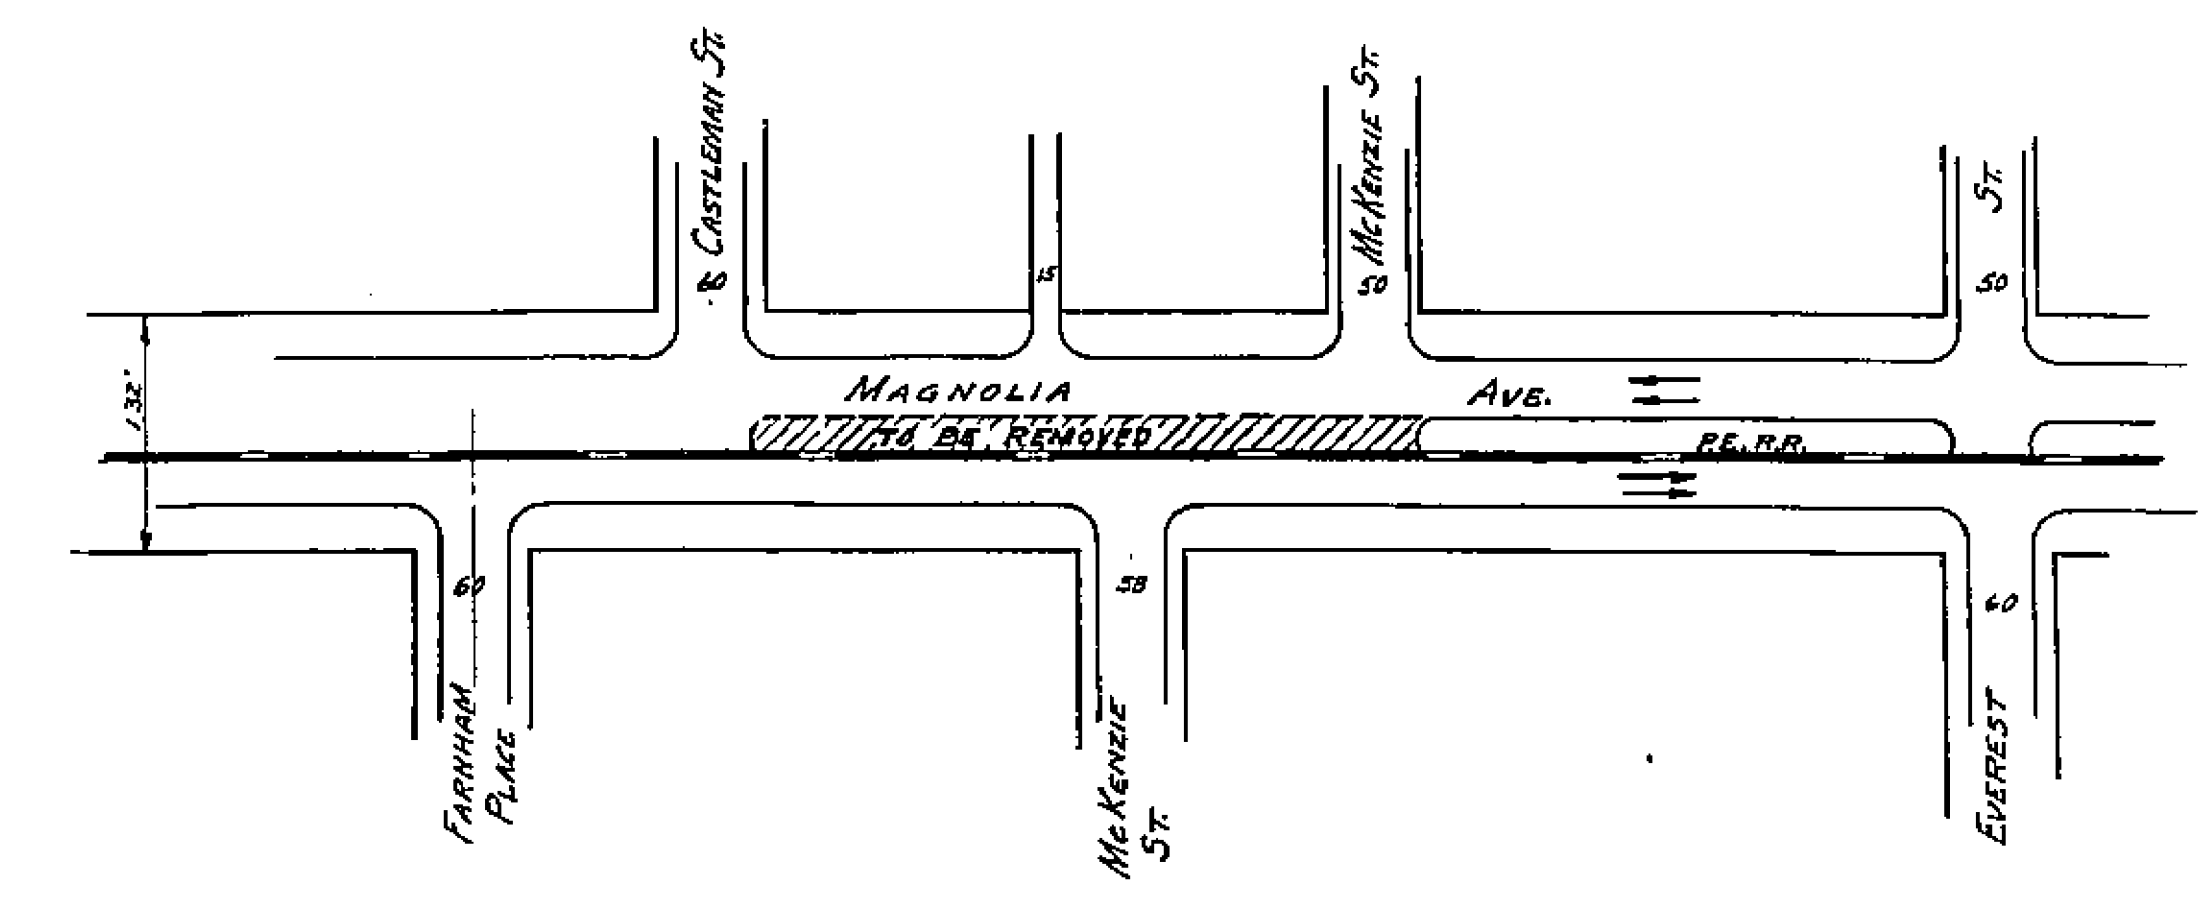


PLAN No. 1488
 SHOWING MEDIAN STRIP TO
 BE OPENED & CLOSED BETWEEN
 VAN BUREN BLVD & MADISON ST.
 OCTOBER 1954

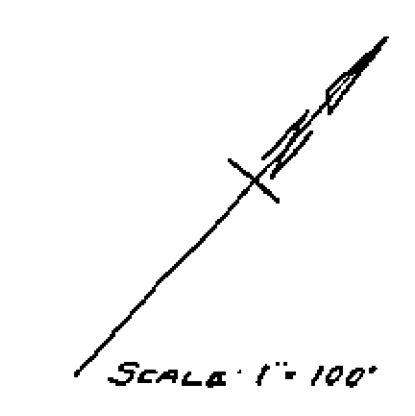

1488