


See Sheet No. 105

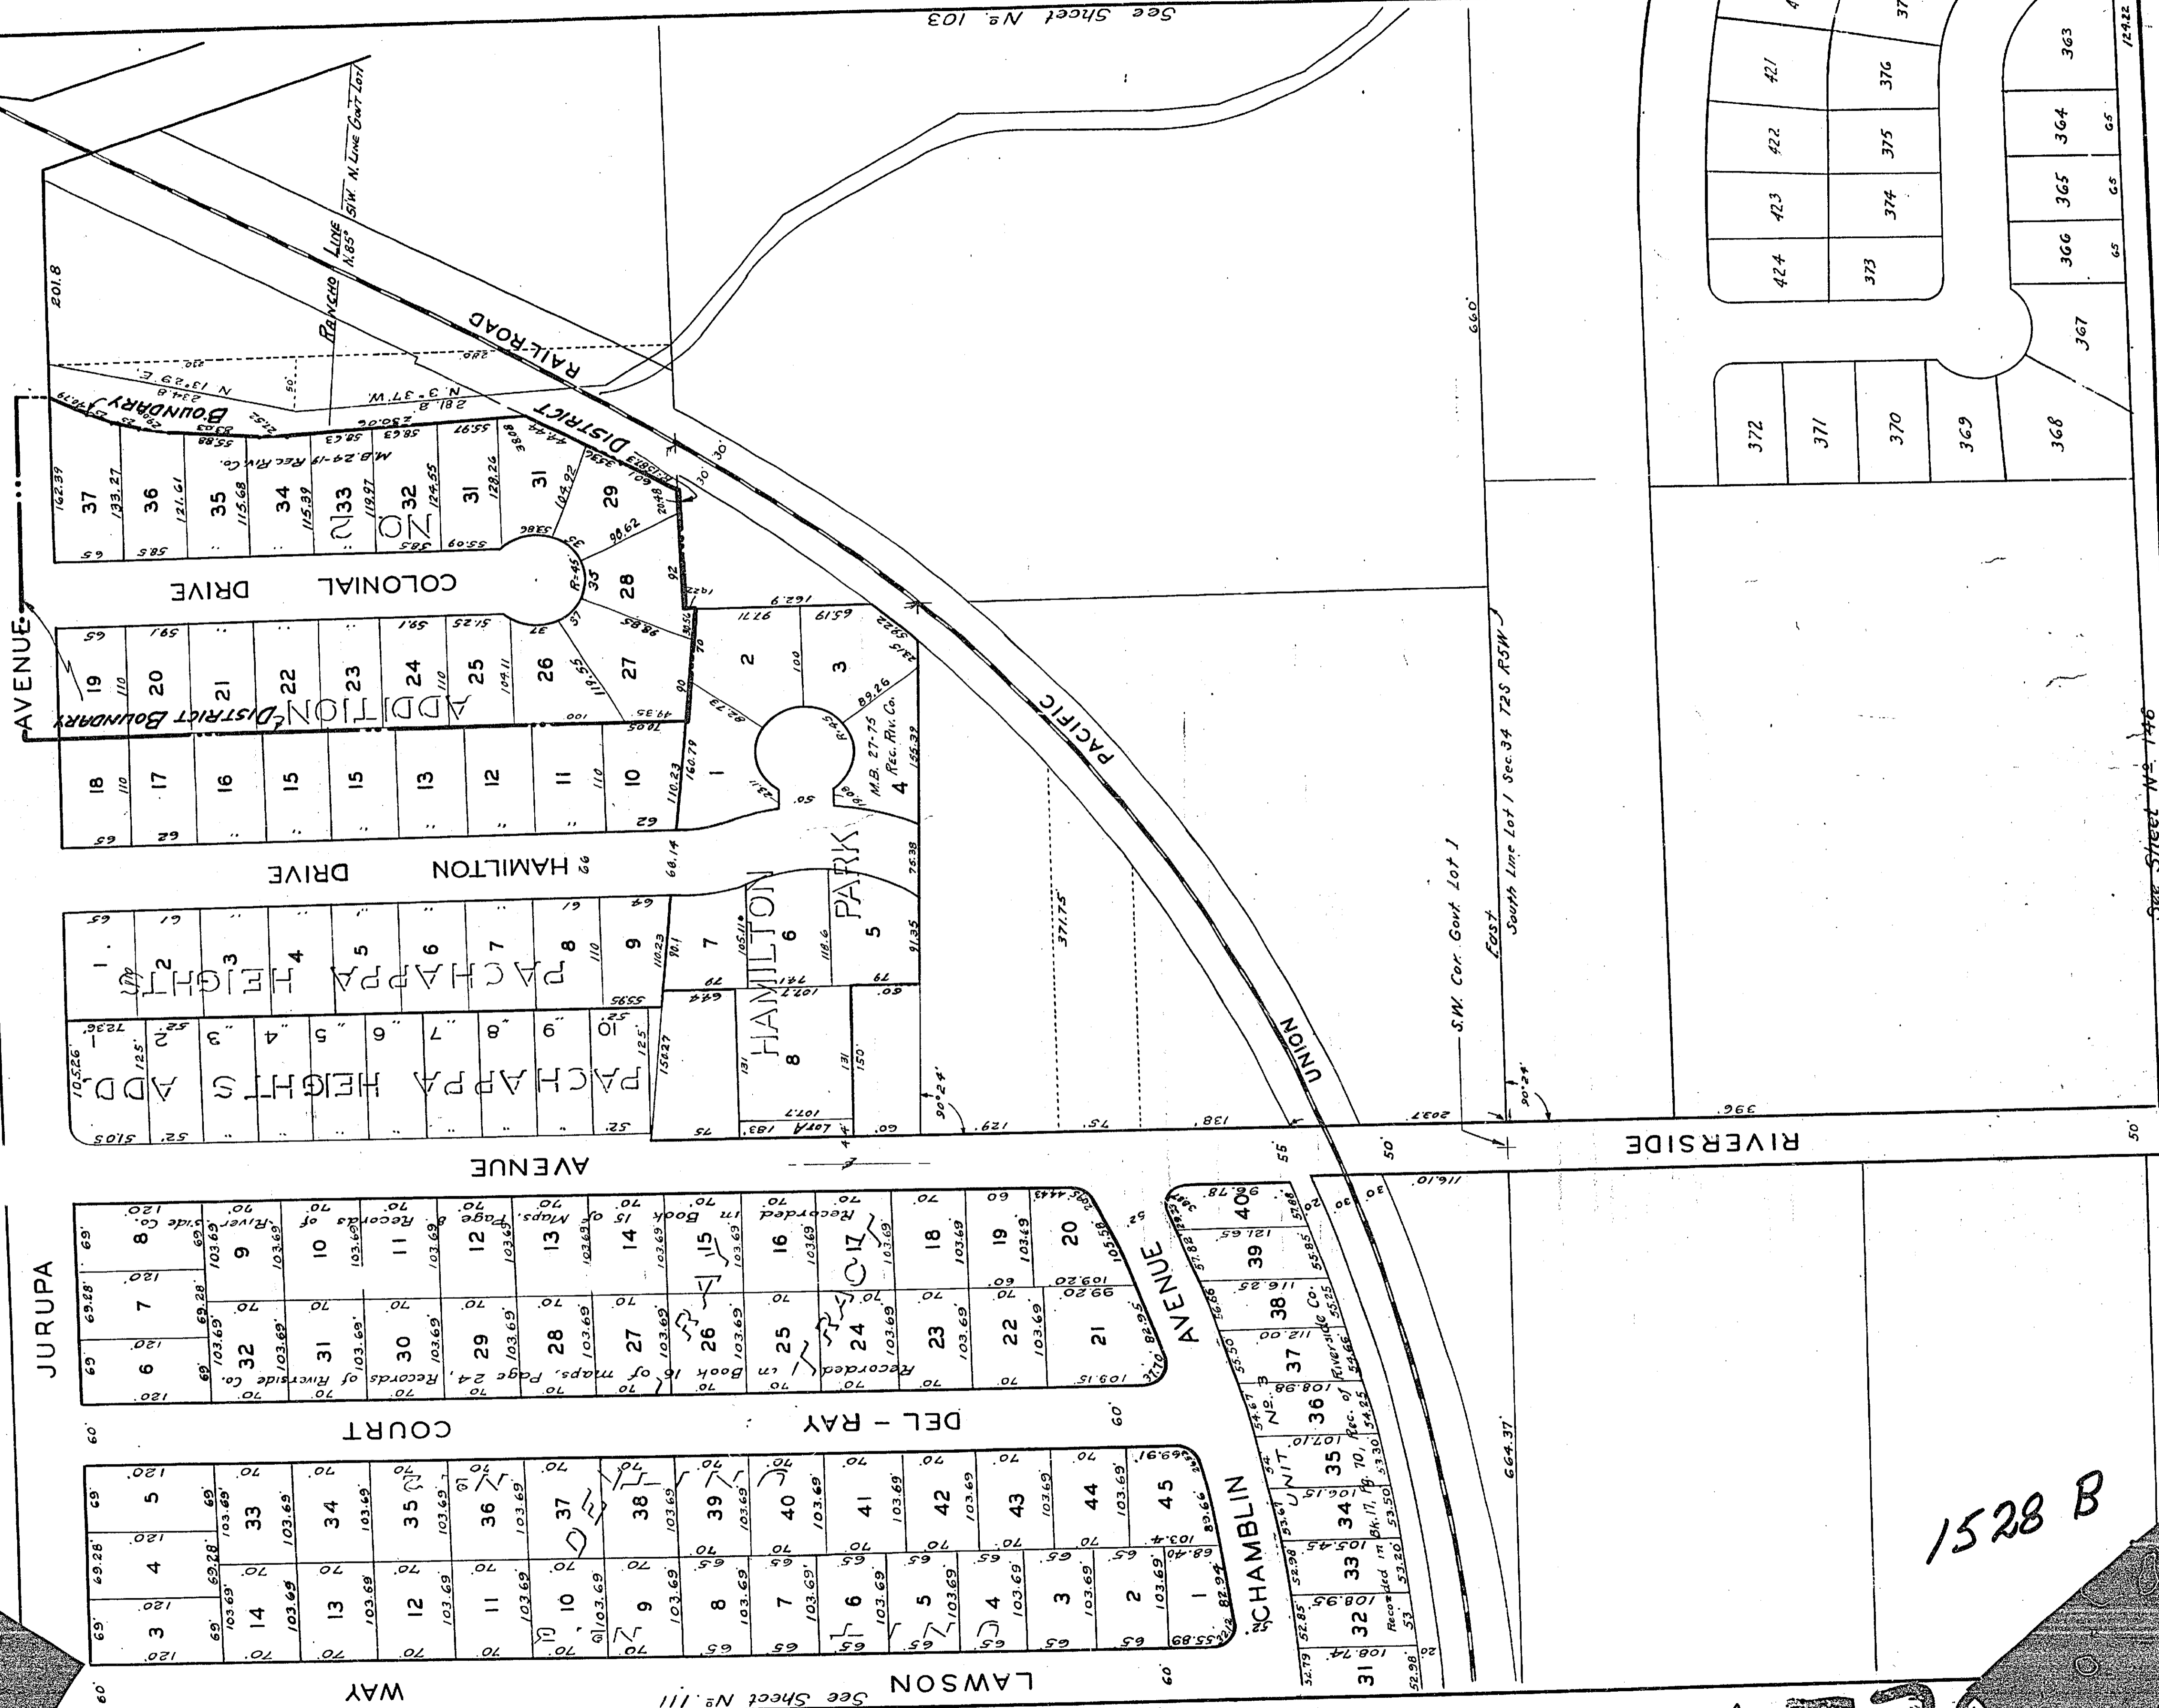

See Sheet No. 103

See Sheet No. 111

See Sheet No. 146

104

1528 B

1528 B