





154

CEDAR STREET EIGHTH ST TO FOURTH ST			
Drawing Number	Sheet Number	Total Sheets	Field Book
154	1	2	376
Drawn	Checked	Approved	

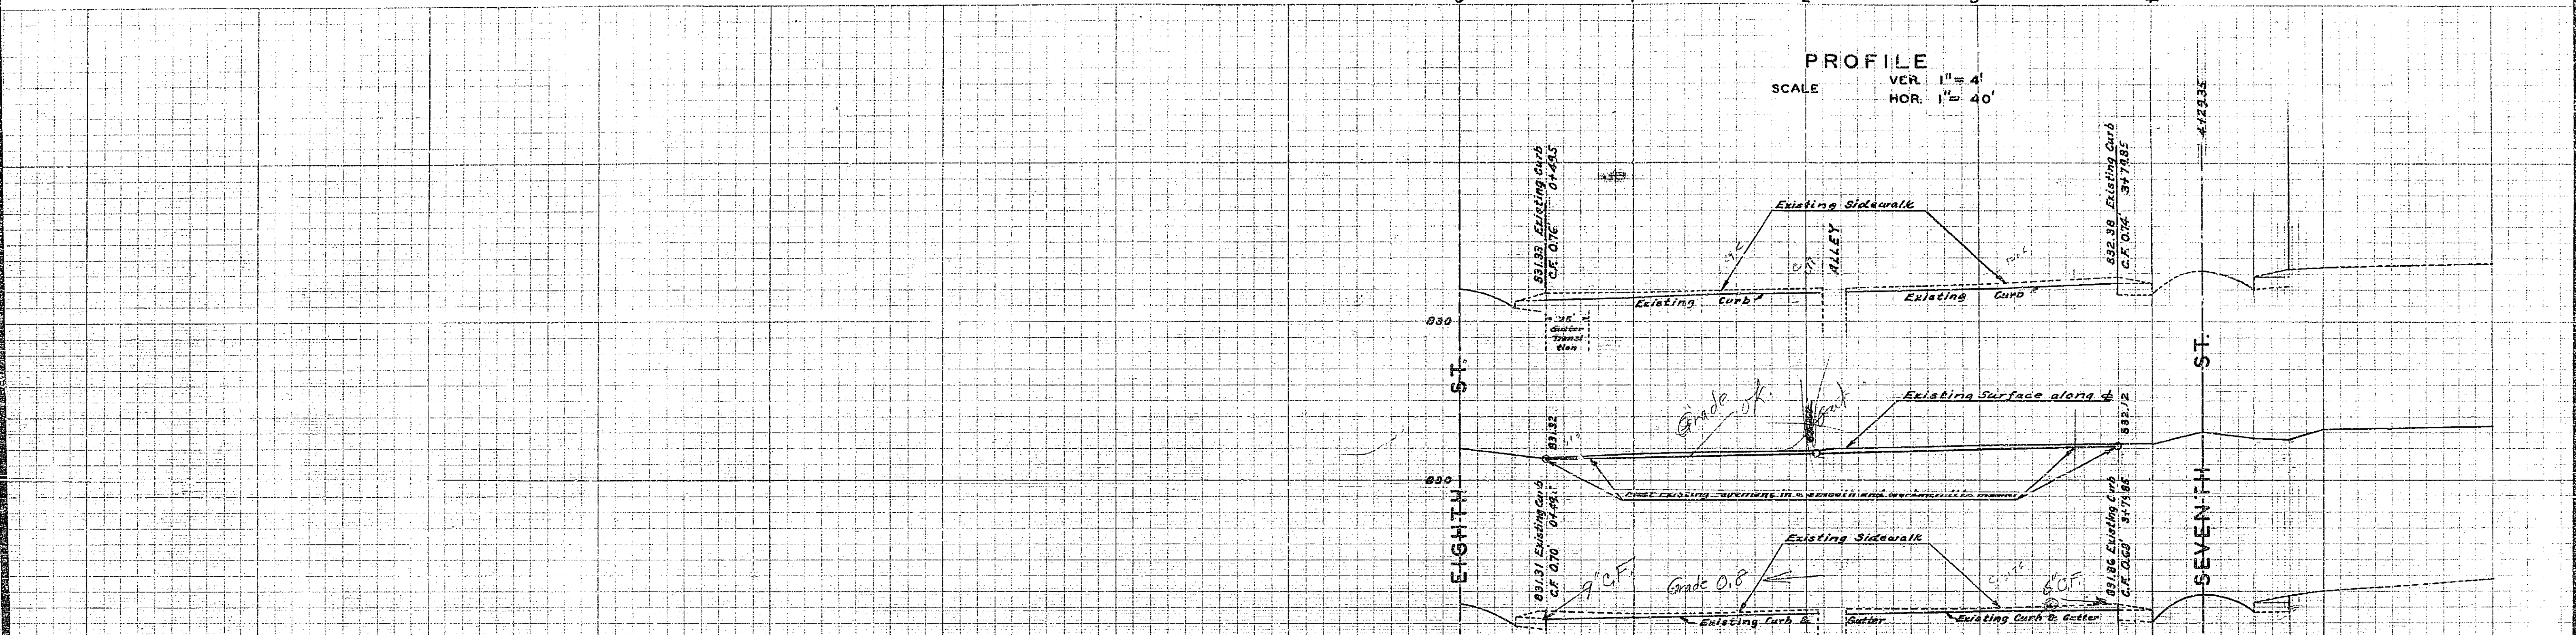

PLANS AND PROFILES
 OF THE PROPOSED IMPROVEMENT OF
CEDAR STREET
 BETWEEN EIGHTH ST. & FOURTH ST.

ENGINEER DEPT. RIVERSIDE CALIF. 1939.
 CITY (U.S.G.S.) DATUM PLANE
 FIELD BOOK 376 PAGES 18-37

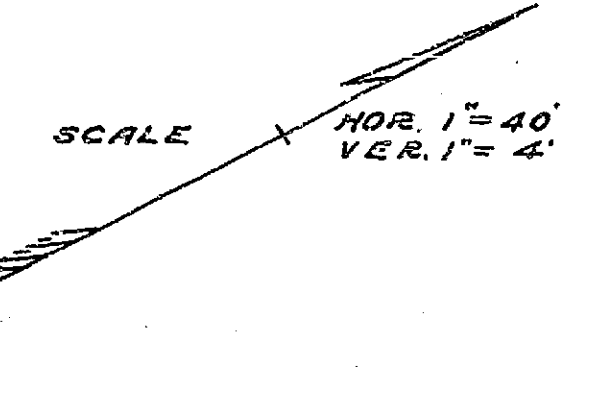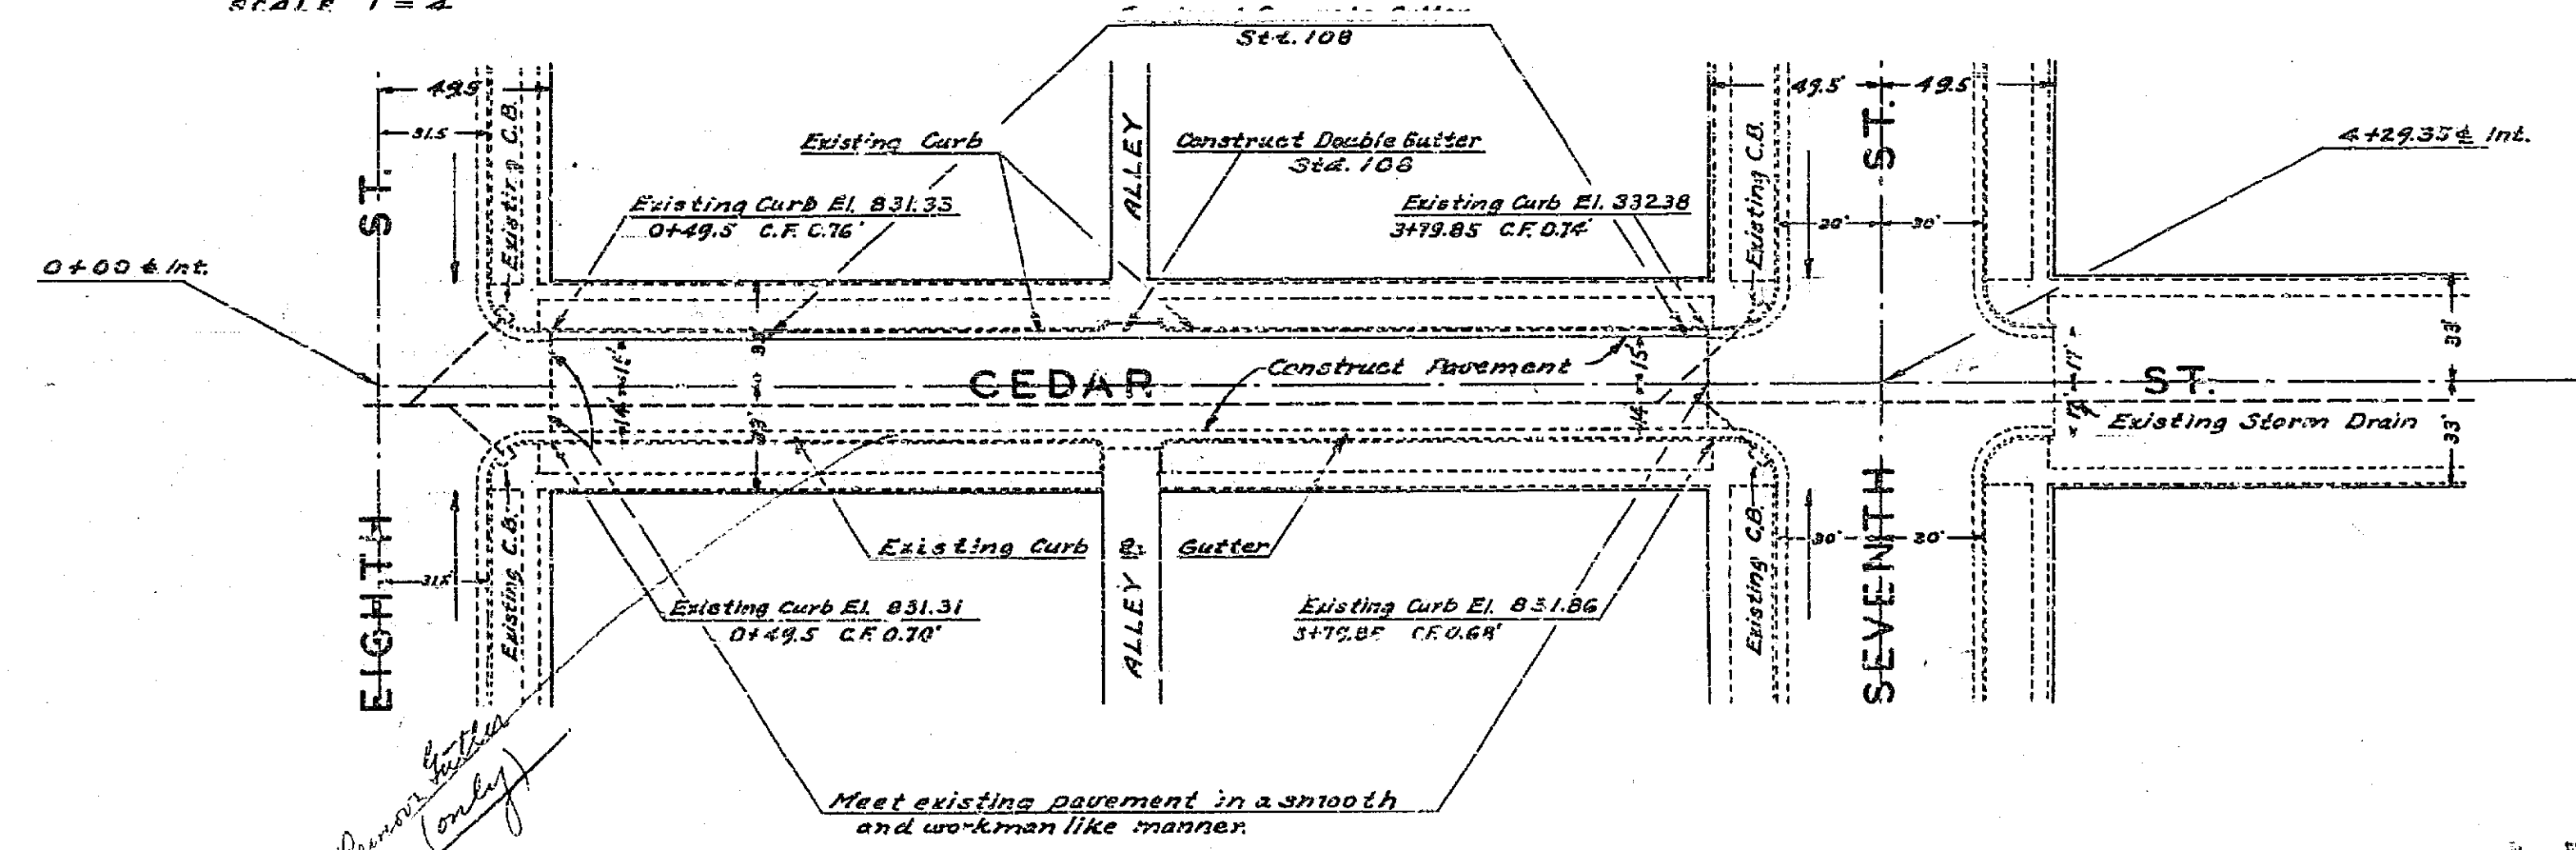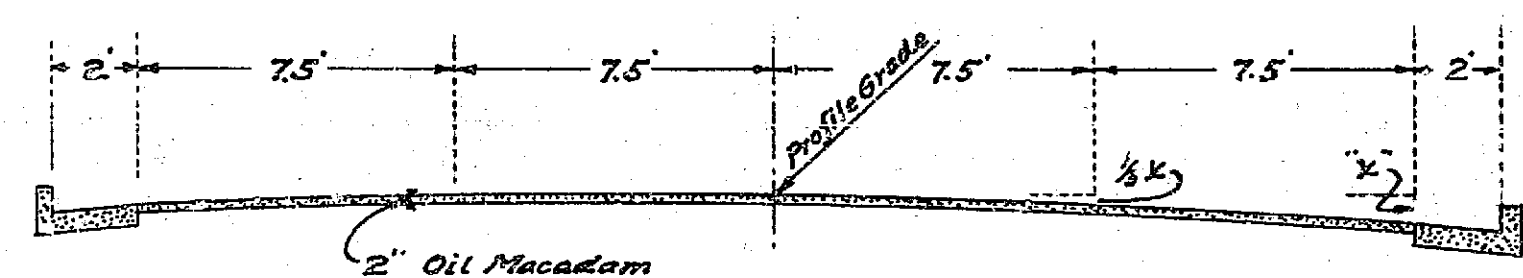

APPROVED _____
 CITY ENGINEER.


APPROVED AND ADOPTED BY THE MAYOR
 AND COUNCIL OF THE CITY OF RIVERSIDE.
 THIS DAY OF 1939.
 CITY CLERK, CITY OF RIVERSIDE.

154

154


154

CEDAR STREET			
EIGHTH ST. TO FOURTH ST.			
Drawing Number	Sheet Total	Field Sheets	Book
154	2	2	376
Drawn	Checked	Approved	

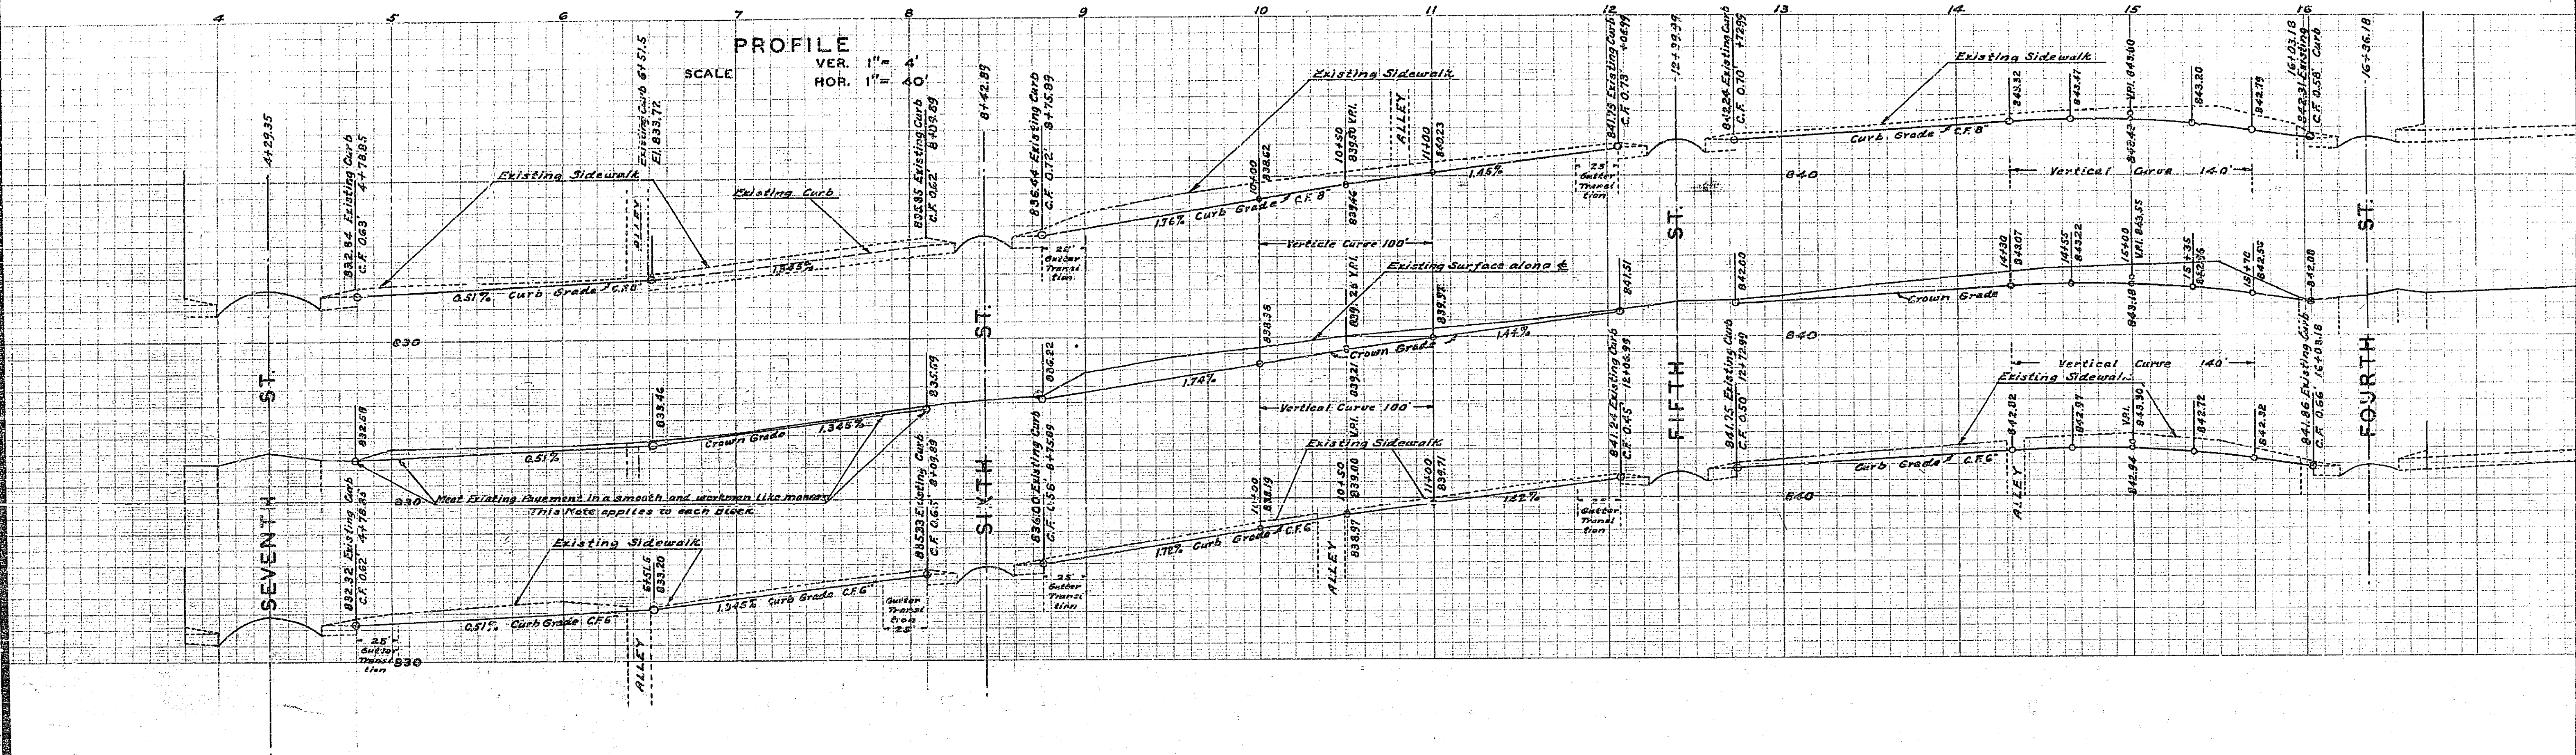

PLAN

SCALE 1" = 40'

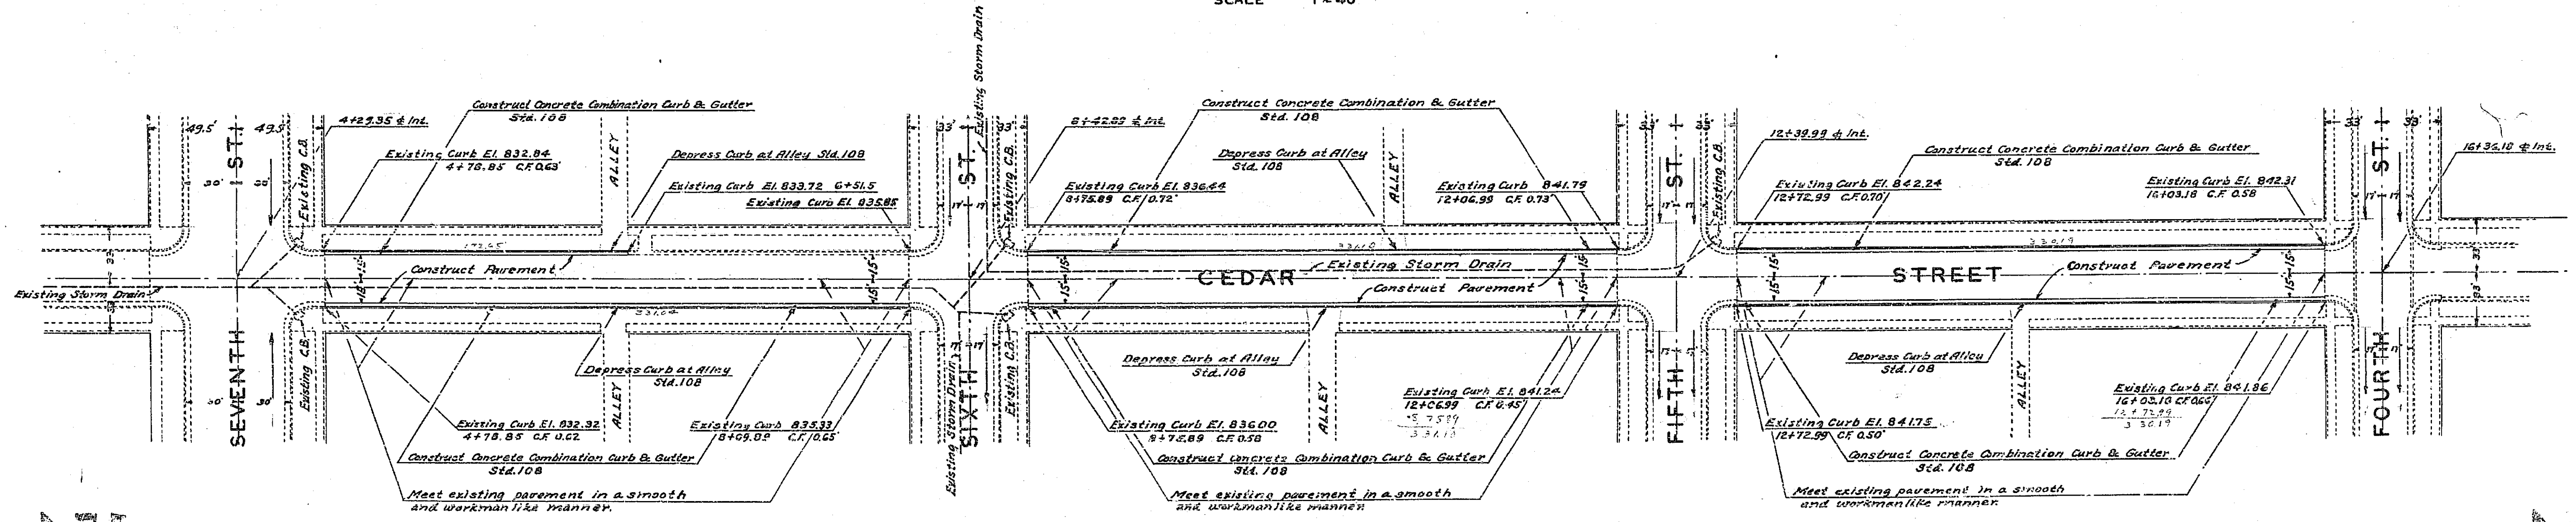

151