


WILLY BLK. 2, MERRYFIELD ADD.	
HOUGHTON AVE. TO FIRST ST.	
Drawing No. 161	Sheet No. 321
Drawn by	Checked by


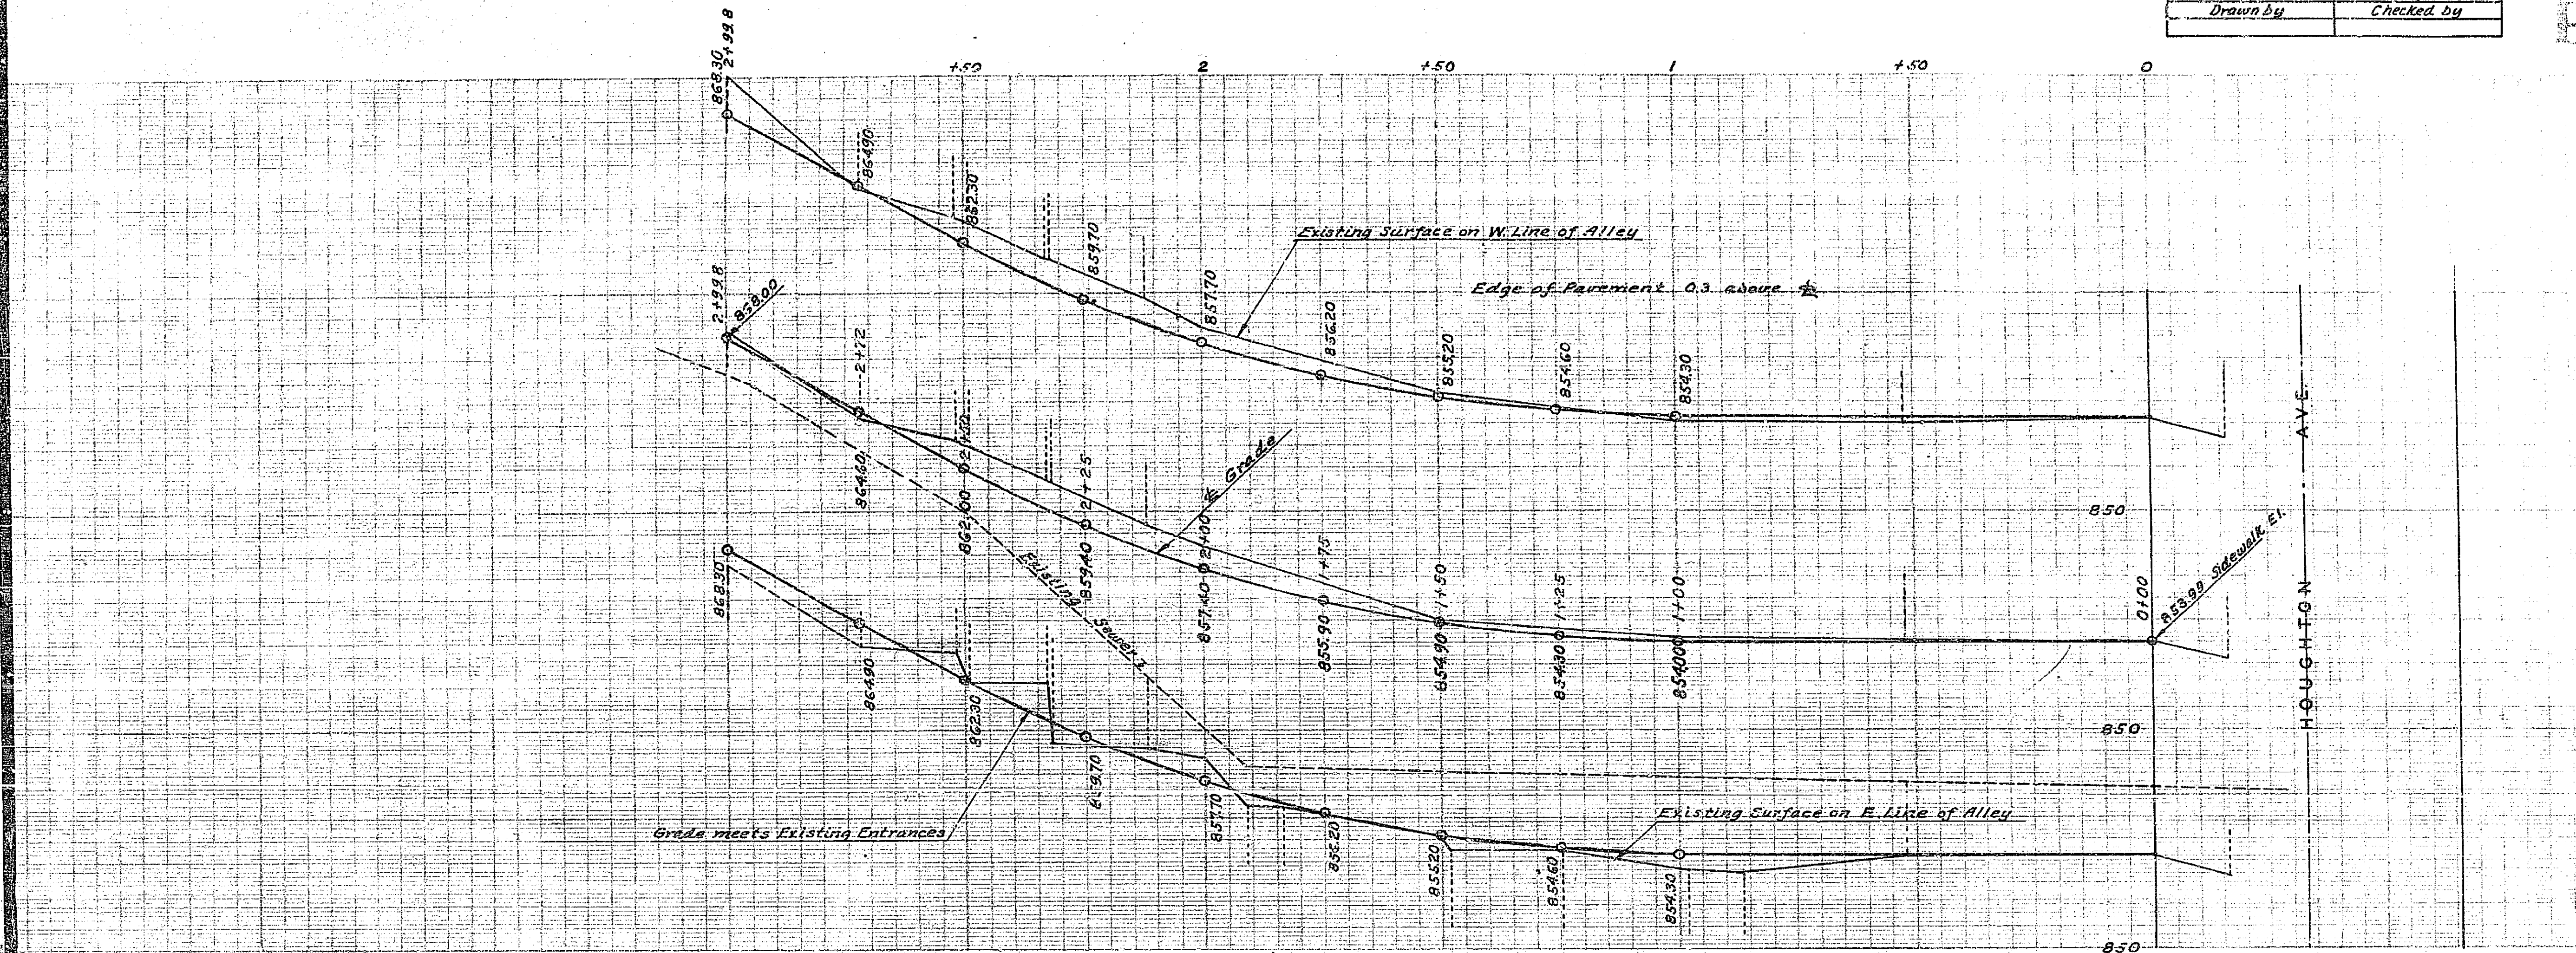


PLAN AND PROFILE


OF THE PROPOSED IMPROVEMENT OF
ALLEY BLK. 2 MERRYFIELD ADD.

BETWEEN FIRST ST. & HOUGHTON AVE.

ENGINEER DEPT. RIVERSIDE CALIF. 1936.
 CITY (U.S.G.S.) DATUM PLANE
 FIELD BOOK 321 PAGES 4-8
 Constructed by St. Dept. 1937

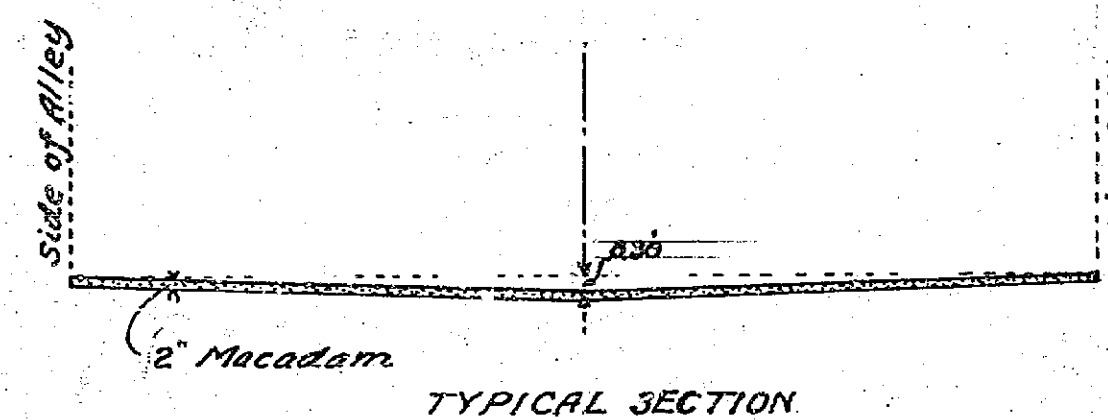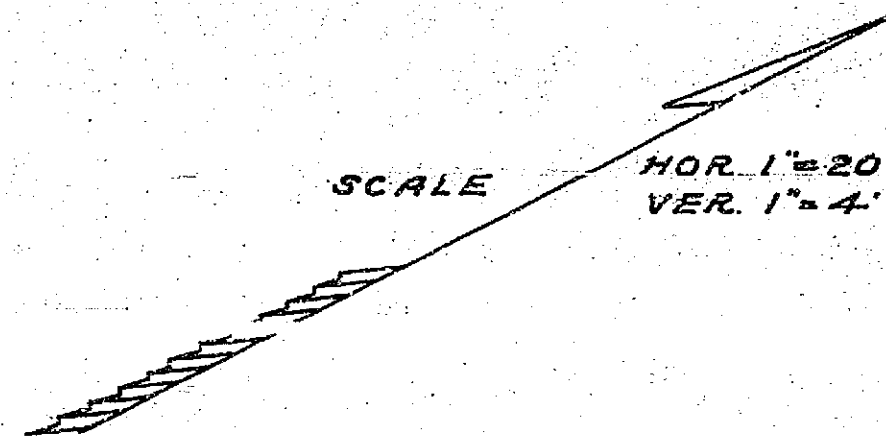

APPROVED.....
 CITY ENGINEER.

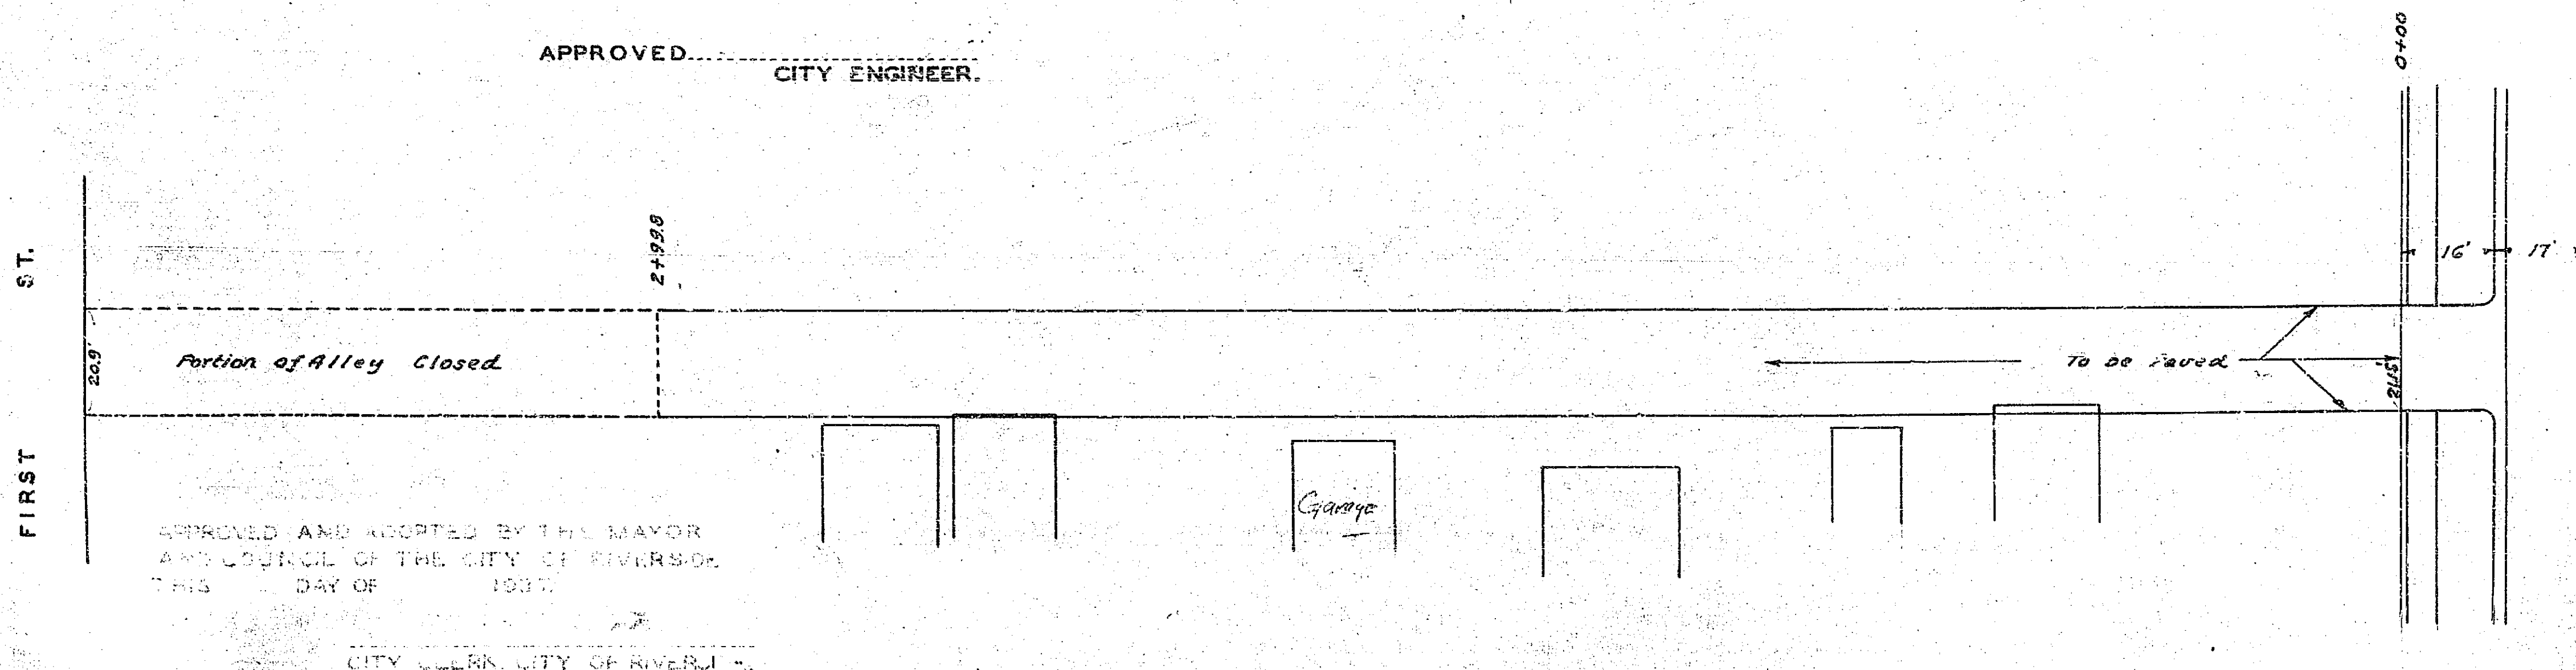

APPROVED AND ADOPTED BY THE MAYOR
 AND COUNCIL OF THE CITY OF RIVERSIDE
 THIS DAY OF 1937

CITY CLERK, CITY OF RIVERSIDE

161-B