

185-V

85 V 25


MAP OF STATION GROUNDS AT RIVERSIDE

Santa Fe Ry

RIVERSIDE R.S. & L.A.R.Y.

SCALE 200 FEET TO ONE INCH.

Corrected to March 4th '89

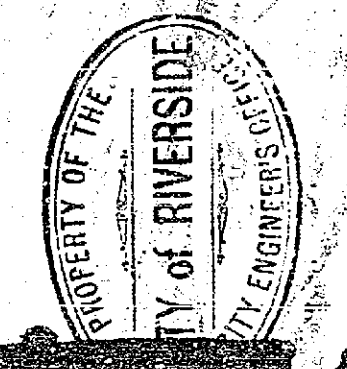

162-A

