


SCALE: 1" = 40'

PLAN & PROFILE
NO. 169-C

LIME ST. UNDERPASS

RIVERSIDE, CALIFORNIA

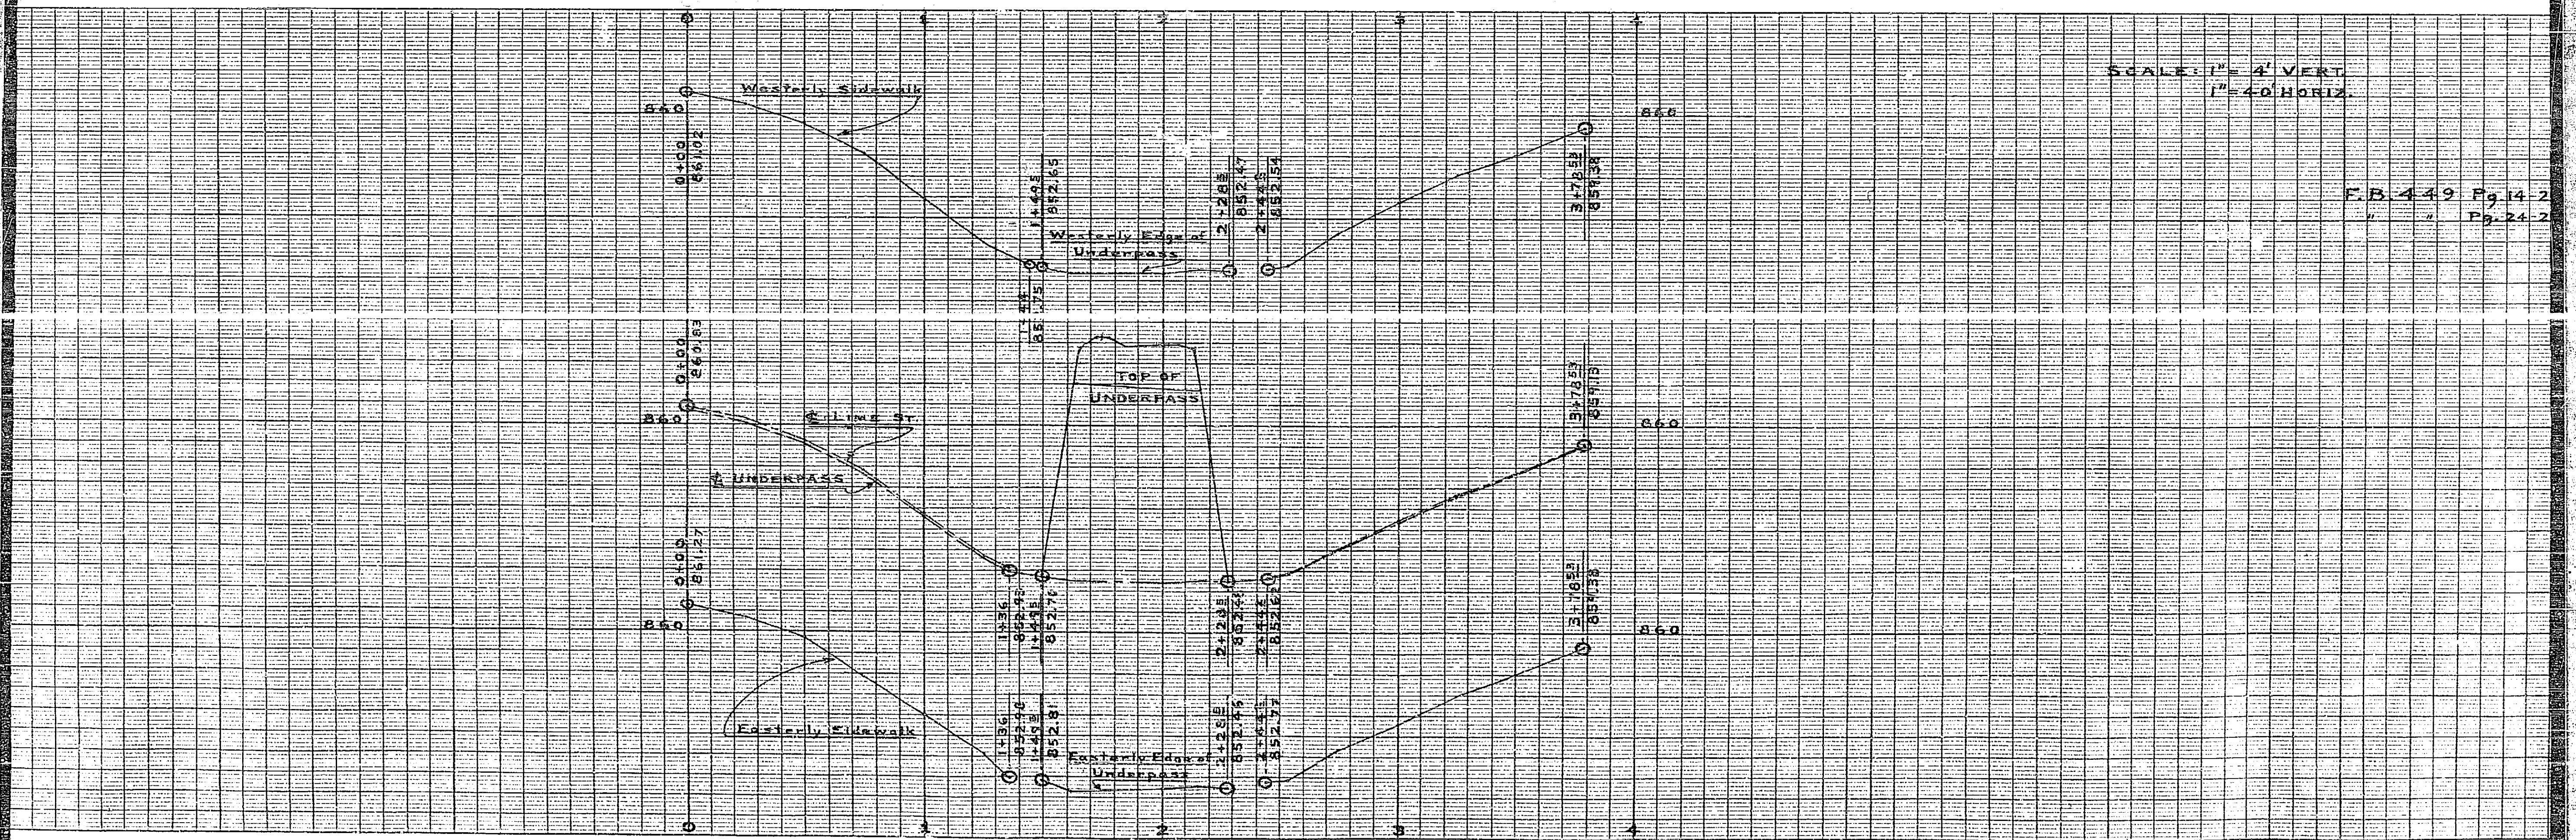

SCALE: 1" = 4' VERT
1" = 40' HORIZ

F.B. 449 Pg. 14-2
" " Pg. 24-2

"CLEARPRINT" PROFILE PLAN PLATE A
"CLEARPRINT PAPER CO."
MADE IN U.S.A.

"CLEARPRINT" PROFILE PLAN PLATE A
"CLEARPRINT PAPER CO."
MADE IN U.S.A.

169-C

169-C sheet #1 2-11

2-11

