


**SCHEMATIC STUDY OF PROPOSED MALL FOR DOWNTOWN RIVERSIDE**



← → FRAME 1 of 2


1729

UNDERGROUND UTILITIES  
NOTED 1/12/60 BY MITCHELL

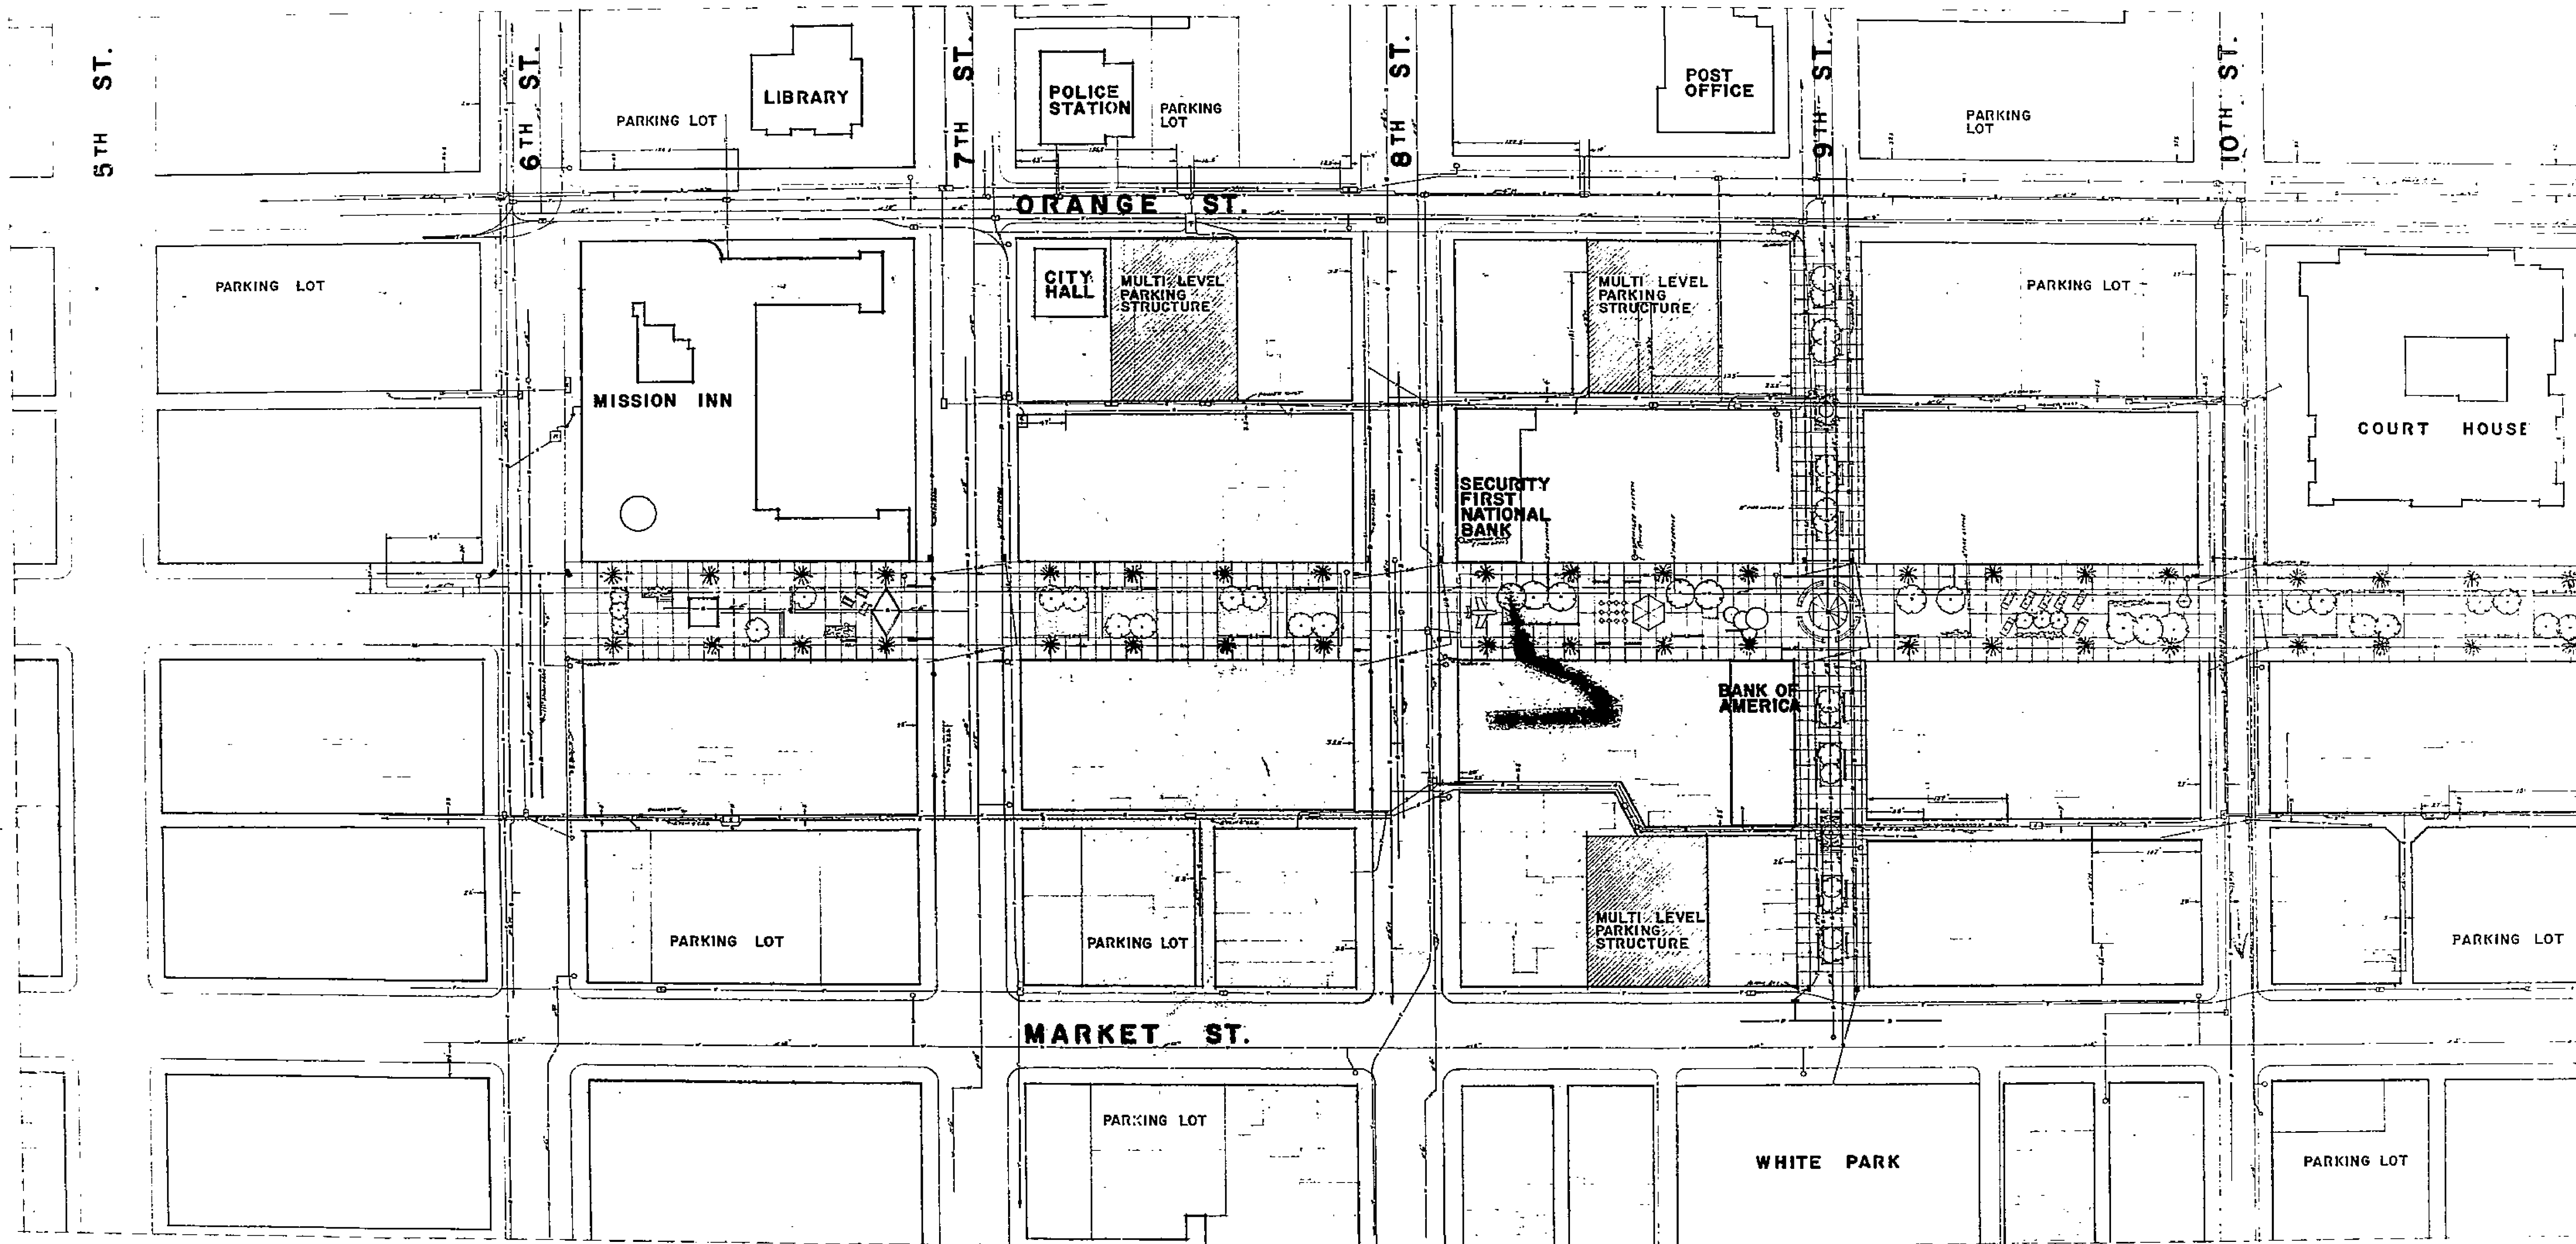

**SCHEMATIC STUDY OF PROPOSED MALL FOR DOWNTOWN RIVERSIDE**

UNDERGROUND UTILITIES  
POSTED 1/12/60 BY MITCHELL

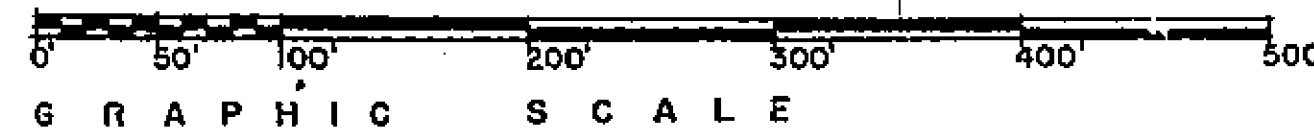

GRAPHIC SCALE

FRAME 2 of 2

